
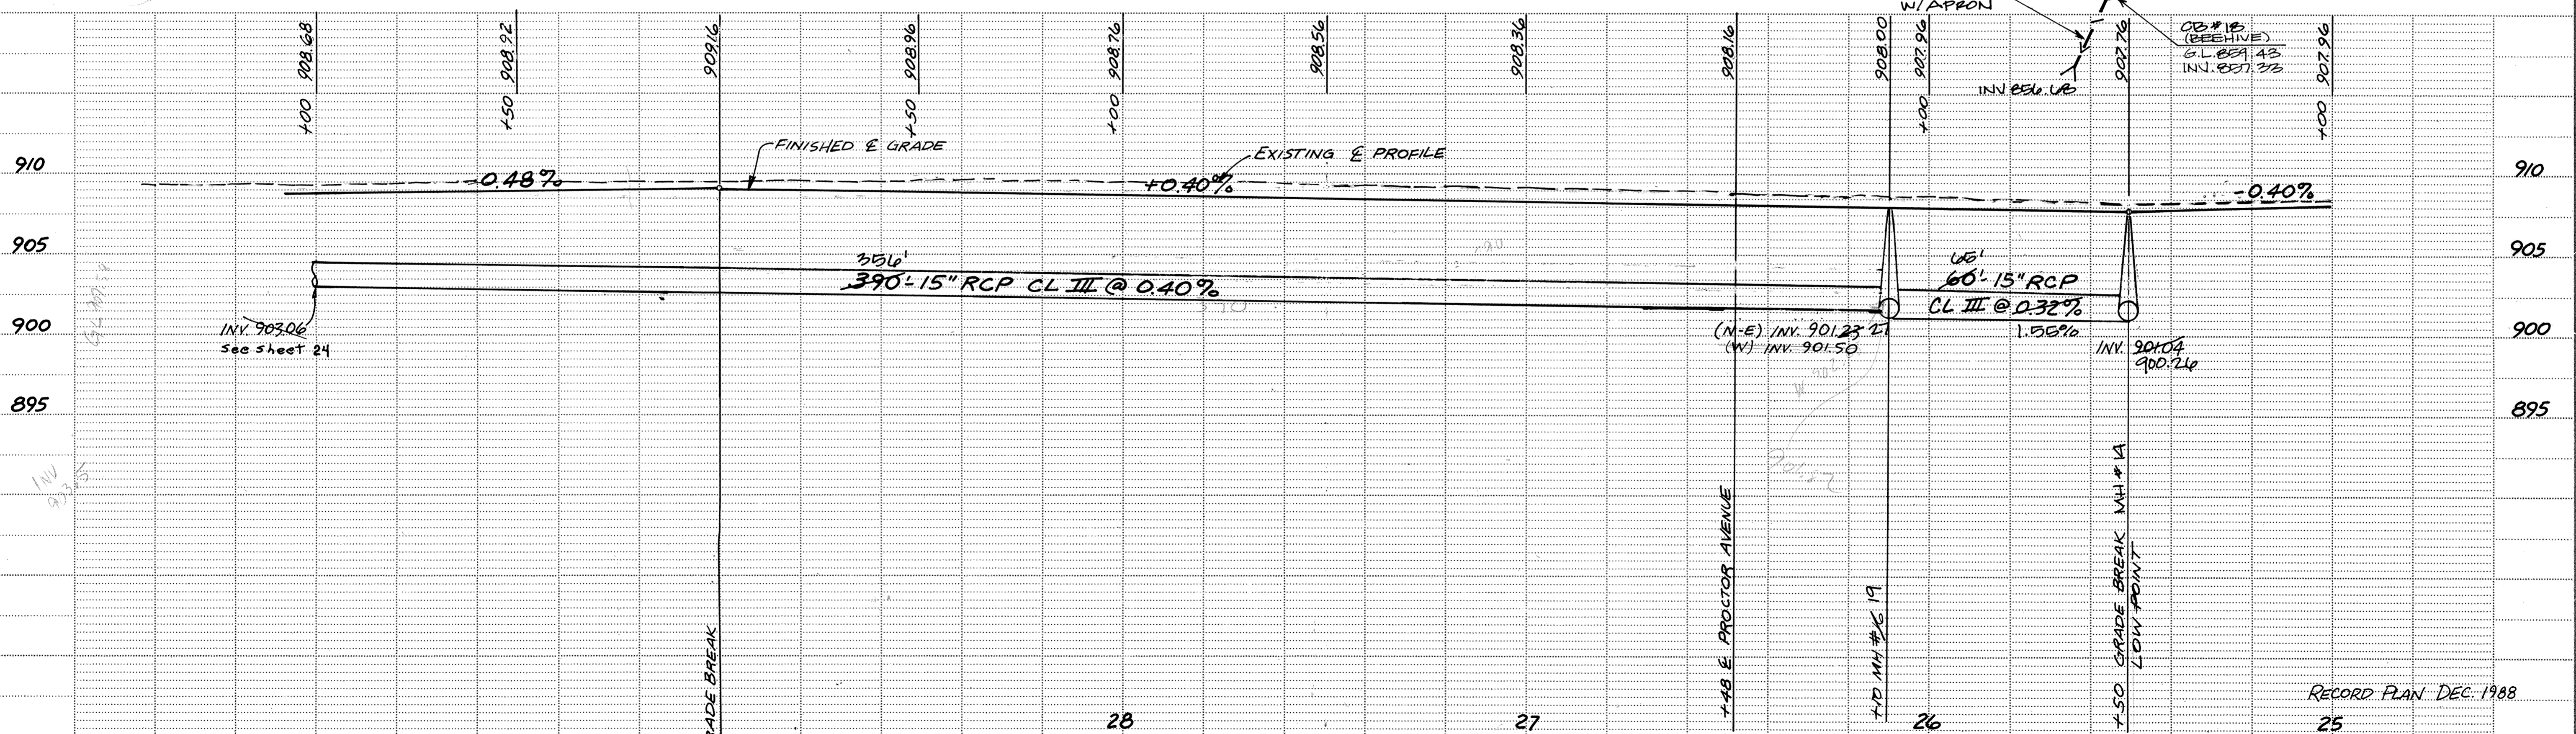


MAIN STREET

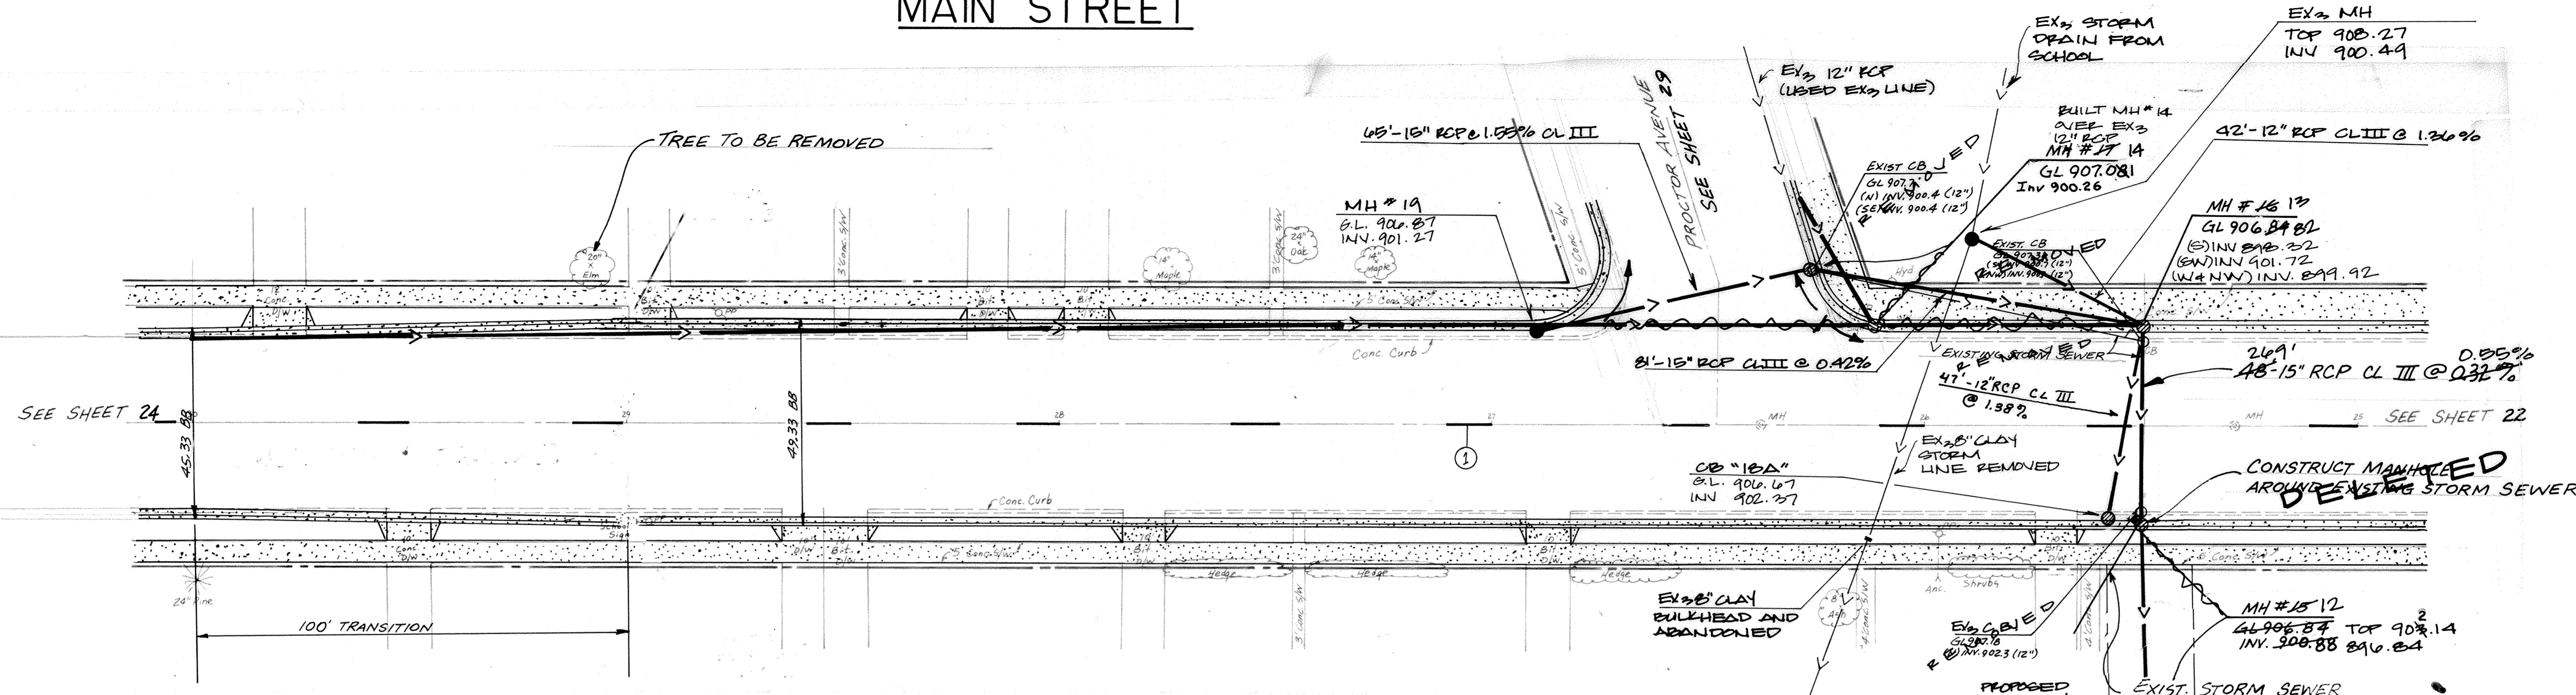

Maier Stewart & Associates Inc. CONSULTING ENGINEERS 1959 SLOAN PLACE (612) 774-6021 ST. PAUL, MINNESOTA 55117	DATE 3/5/88	DESCRIPTION Street Grades, Storm Sewer	DESIGNED CHECKED DRAWN <i>MRJ</i>	CITY OF ELK RIVER STREET CONSTRUCTION MAIN STREET
	GRAPHIC SCALE 0 HORIZ. 20 0 VERT. 5	DATE OCT 1987	SHEET 23 OF 42 SHEETS	PROJECT NO. 230-014

DRAWING NUMBER
 MAINS.87
 23
 252