
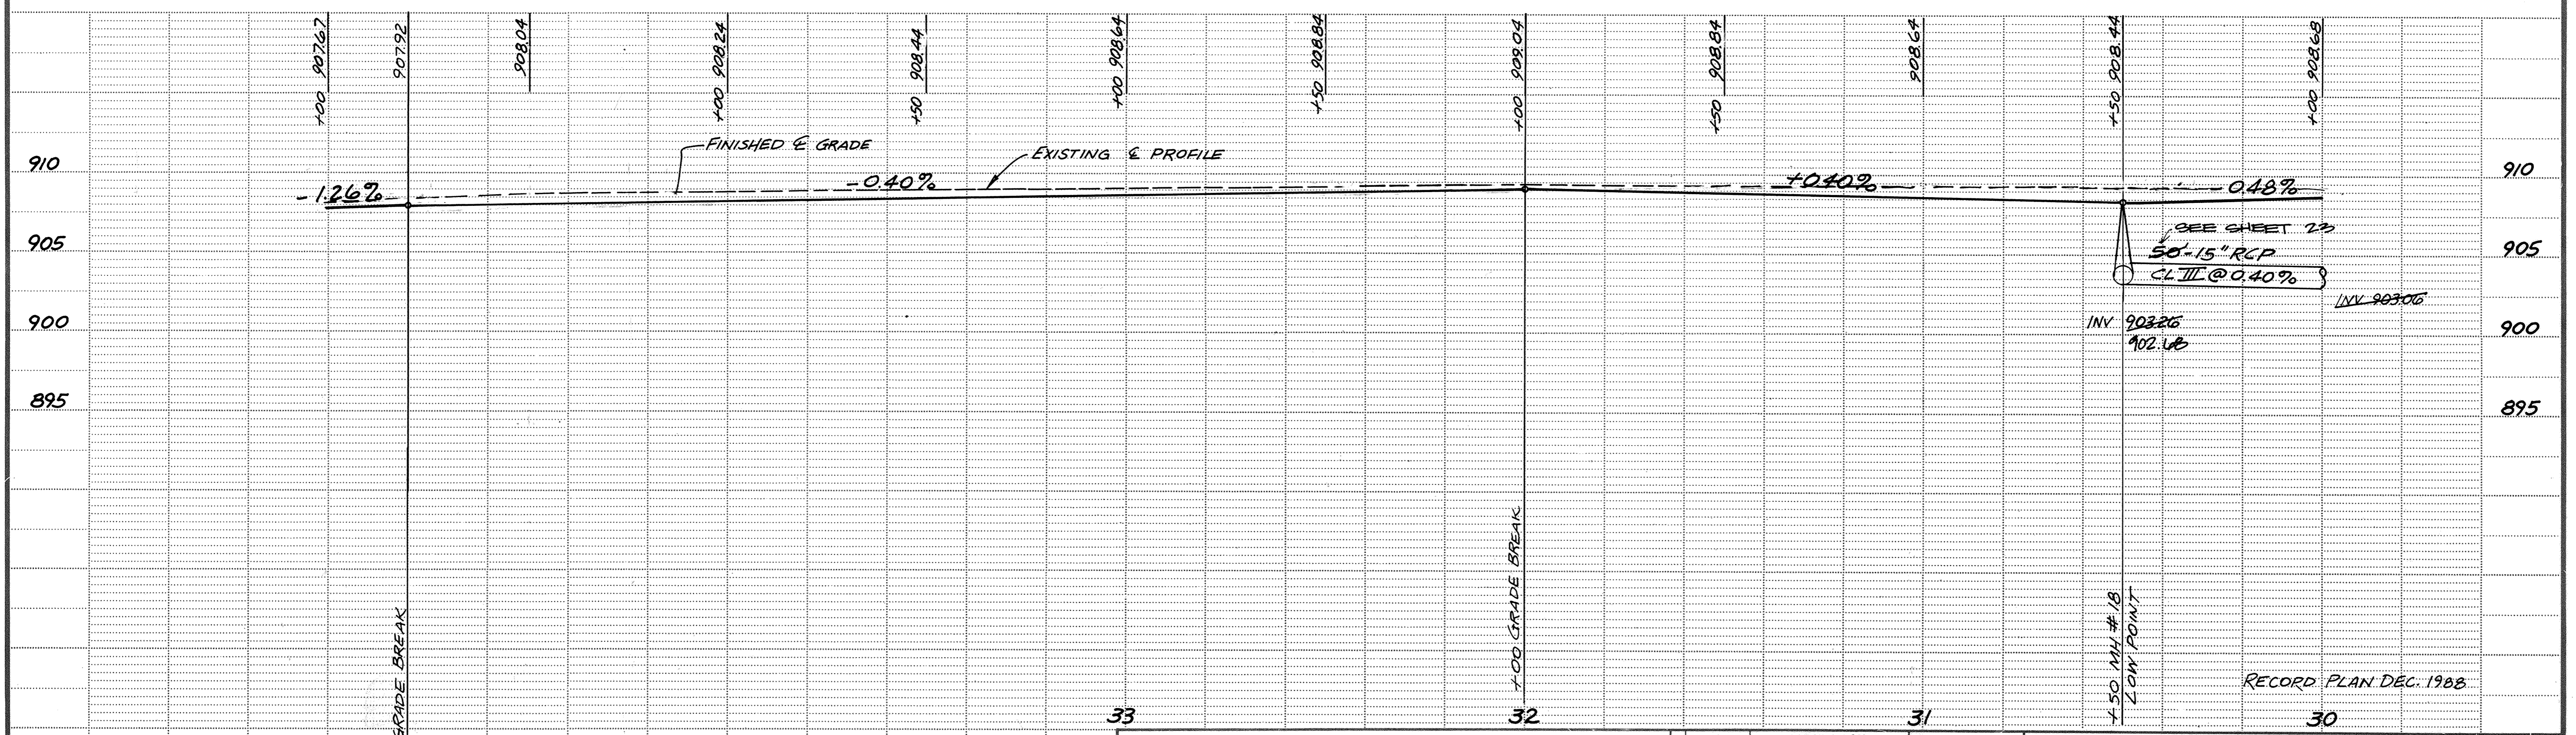


MAIN STREET

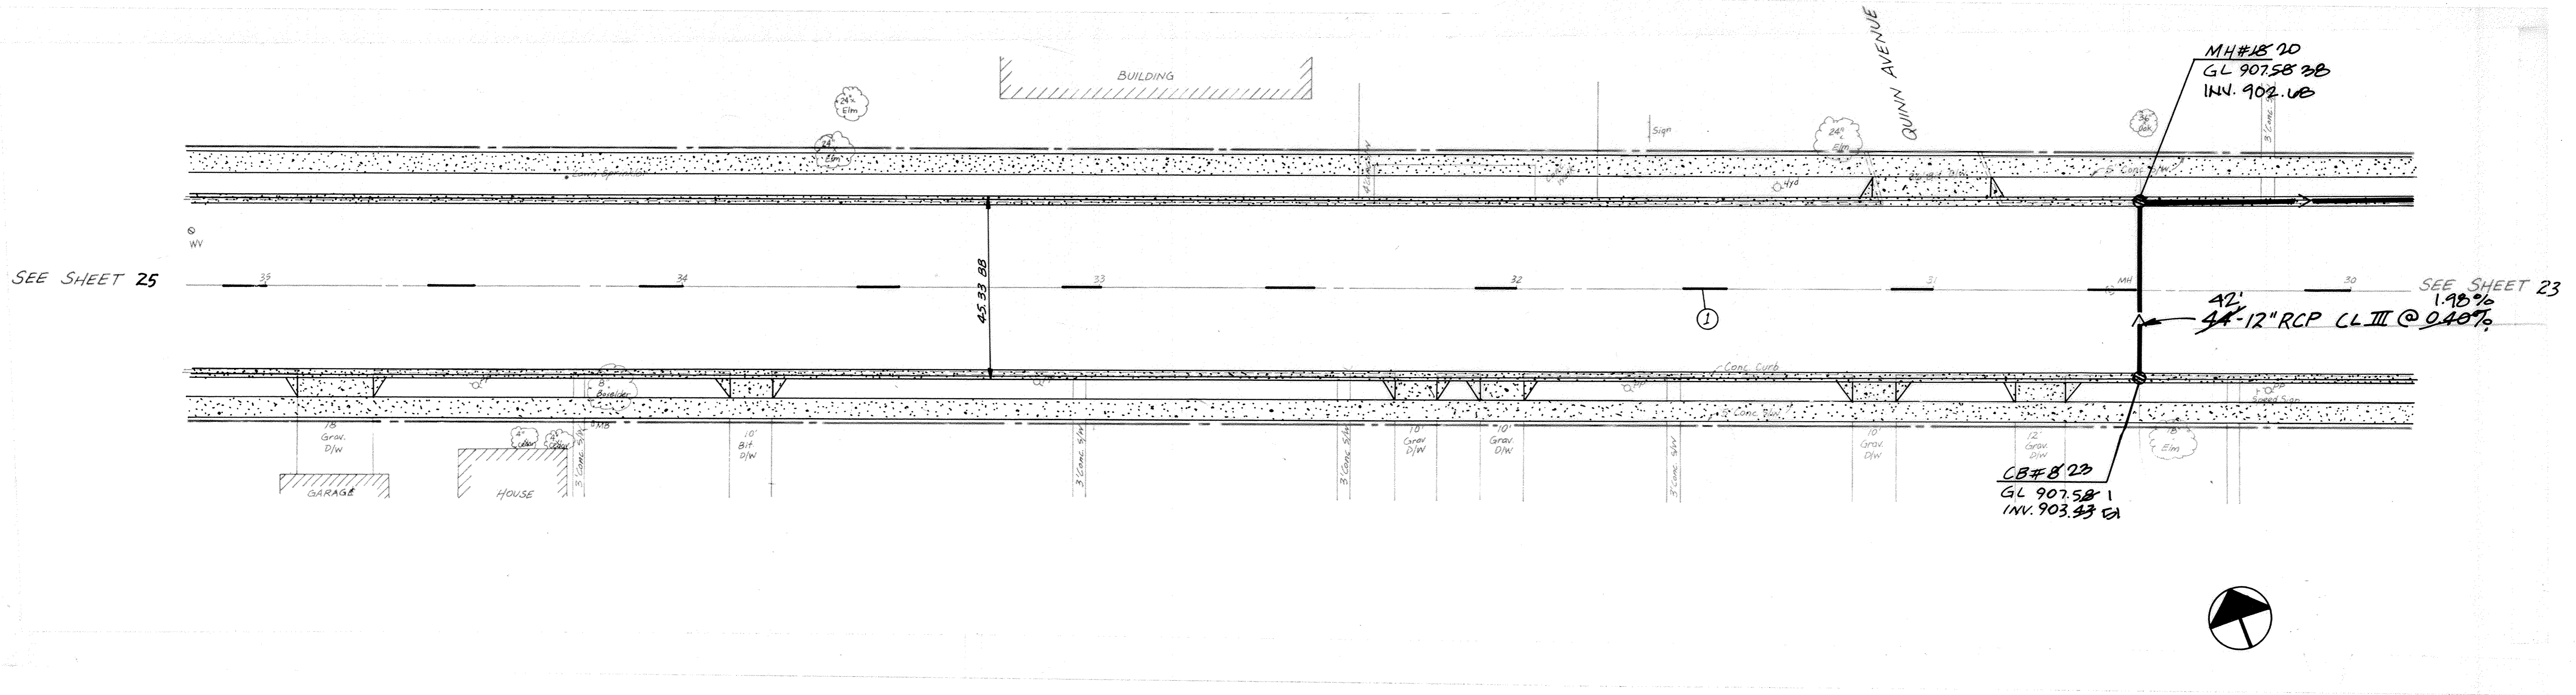

MSA CONSULTING ENGINEERS
Maier Stewart & Associates Inc.
 1959 SLOAN PLACE (612) 774-6021 ST. PAUL, MINNESOTA 55117

DATE	3/5/88	DESCRIPTION	Street Grades/Storm Sew.
DESIGNED		CHECKED	
DRAWN	NRJ	GRAPHIC SCALE	HORIZ. 20 VERT. 5

CITY OF ELK RIVER
STREET CONSTRUCTION
MAIN STREET

DATE OCT 1987 SHEET 24 OF 42 SHEETS PROJECT NO. 230-014

DRAWING NUMBER MAINS 87 24