
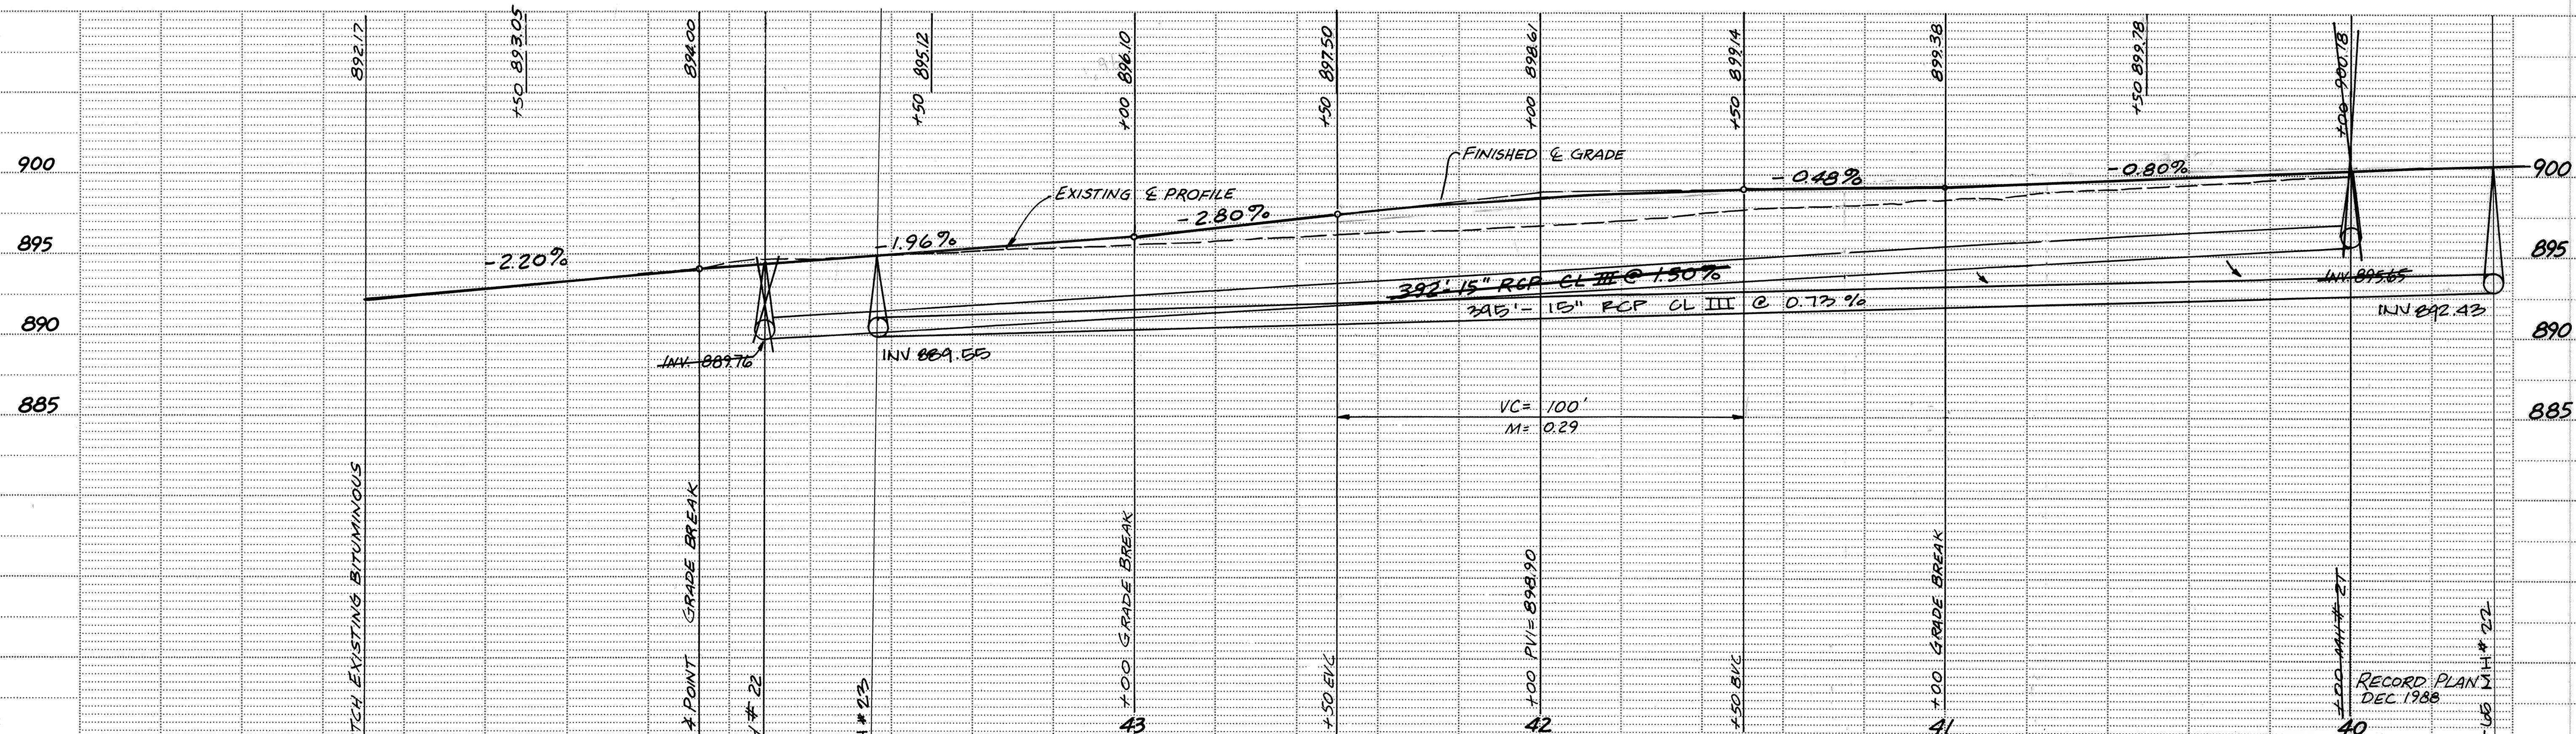


MAIN STREET

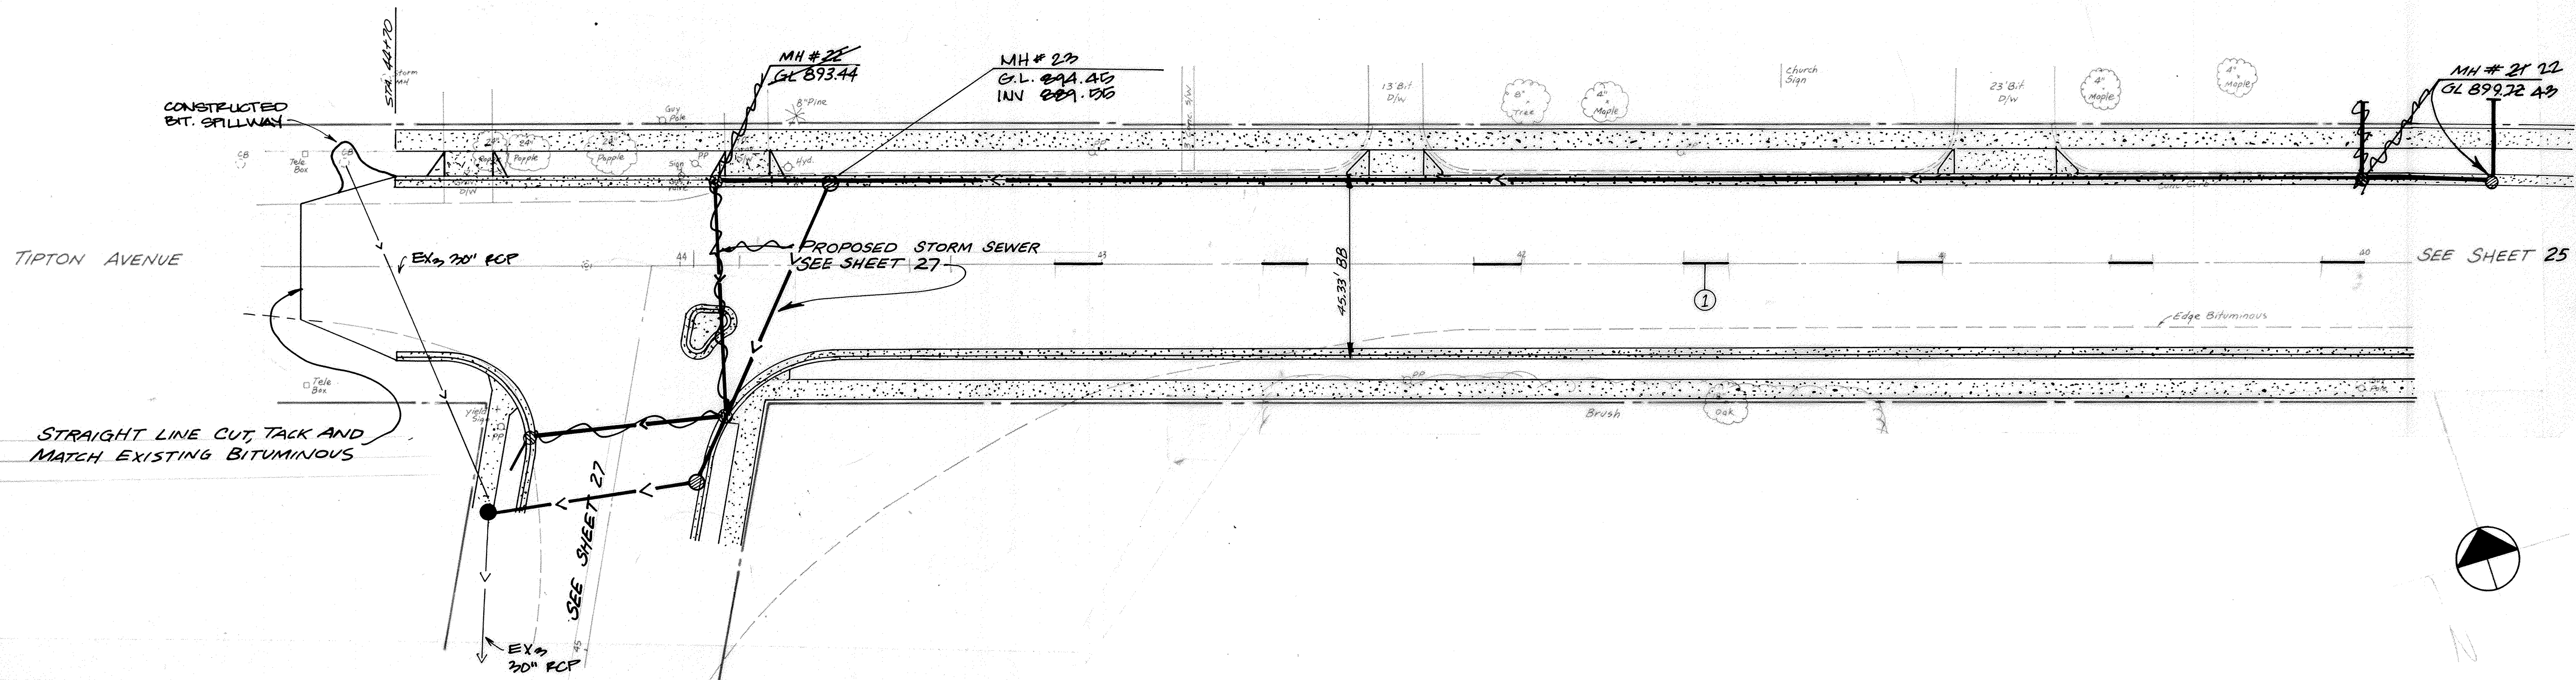

CONSULTING ENGINEERS
Maier Stewart & Associates Inc.

1959 SLOAN PLACE (612)774-6021 ST. PAUL, MINNESOTA 55117

DATE	DESCRIPTION	DESIGNED
3/5/88	Street Grades	CHECKED
		DRAWN MR
		GRAPHIC SCALE
		0 HORIZ. 20'
		0 VERT. 5'

CITY OF ELK RIVER		
STREET CONSTRUCTION		
MAIN STREET		
DATE OCT/87	SHEET 26 OF 42 SHEETS	PROJECT NO. 230-04

SAP 204-113-04

249