
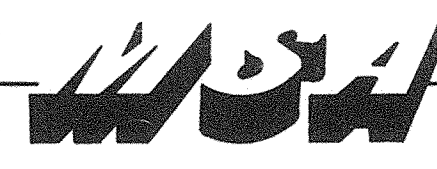
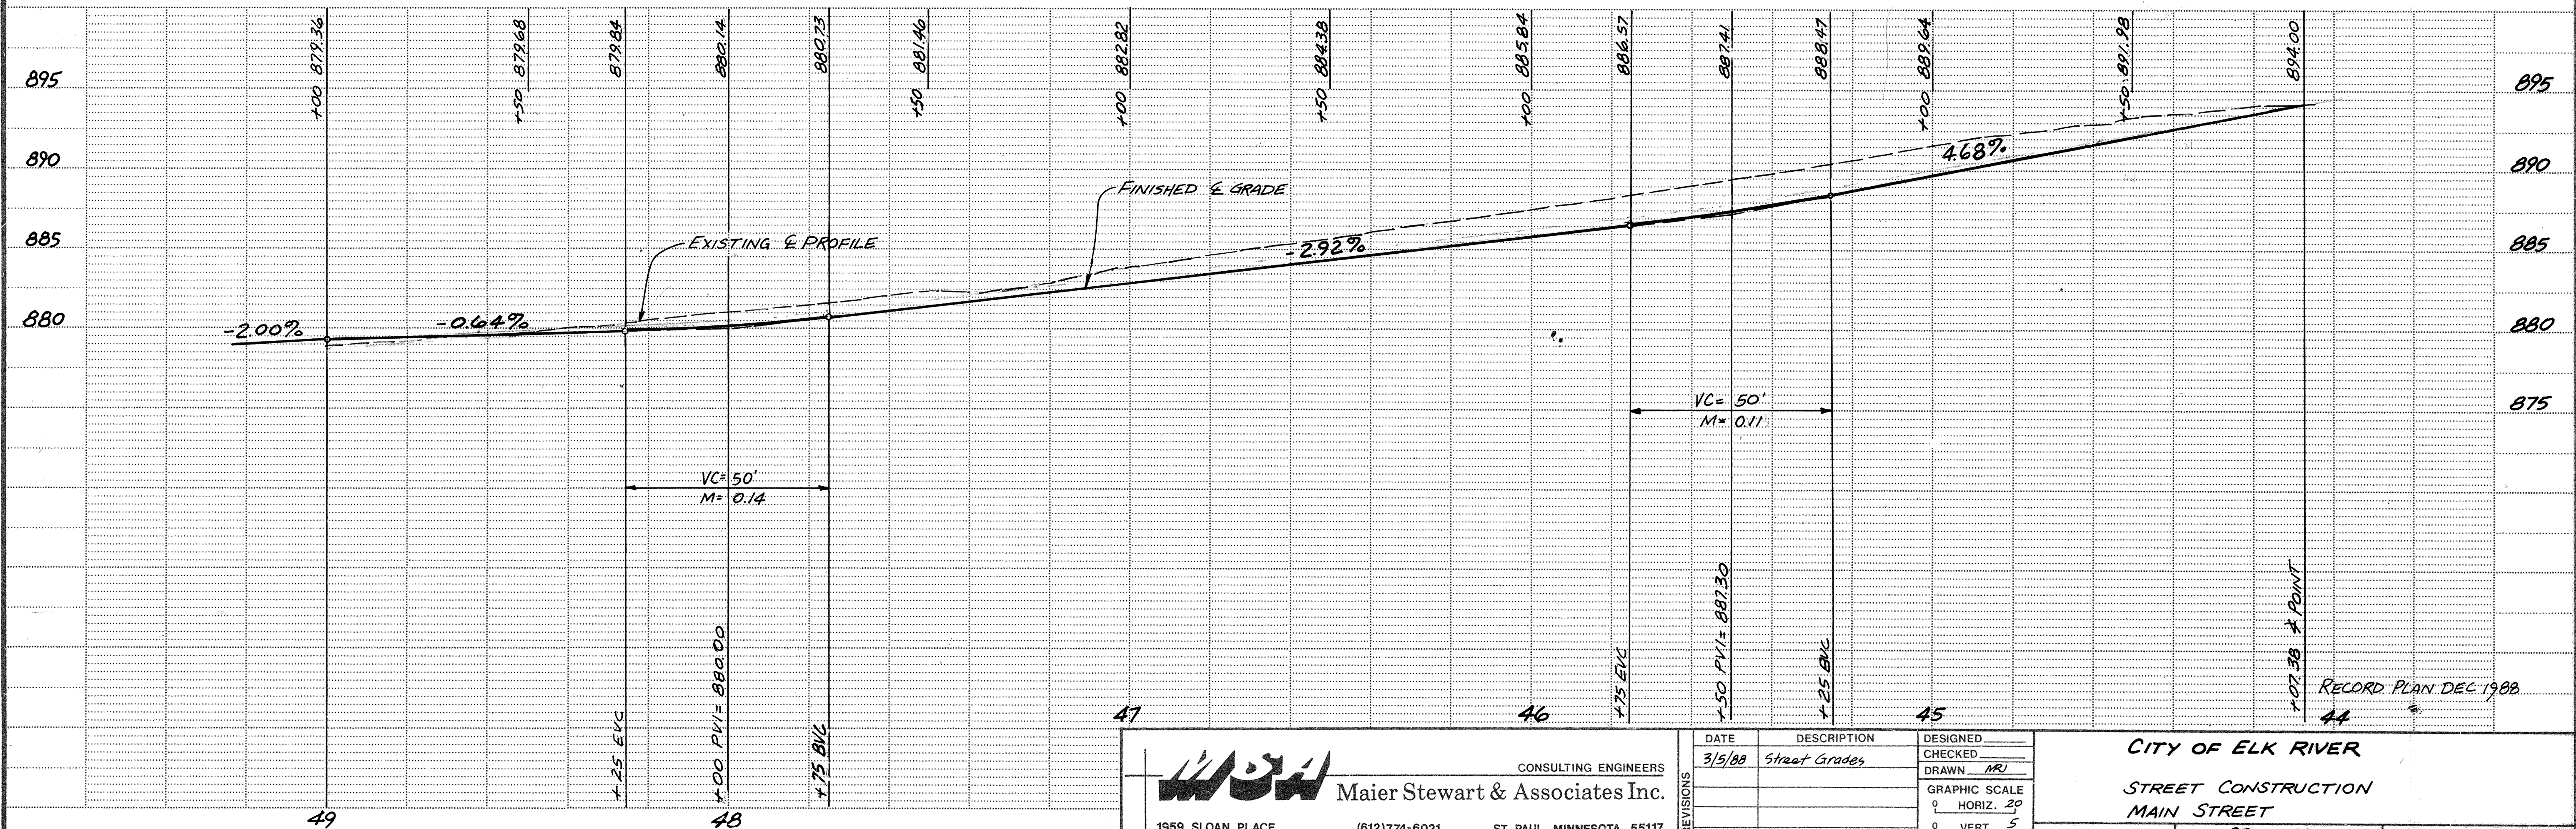


MAIN STREET

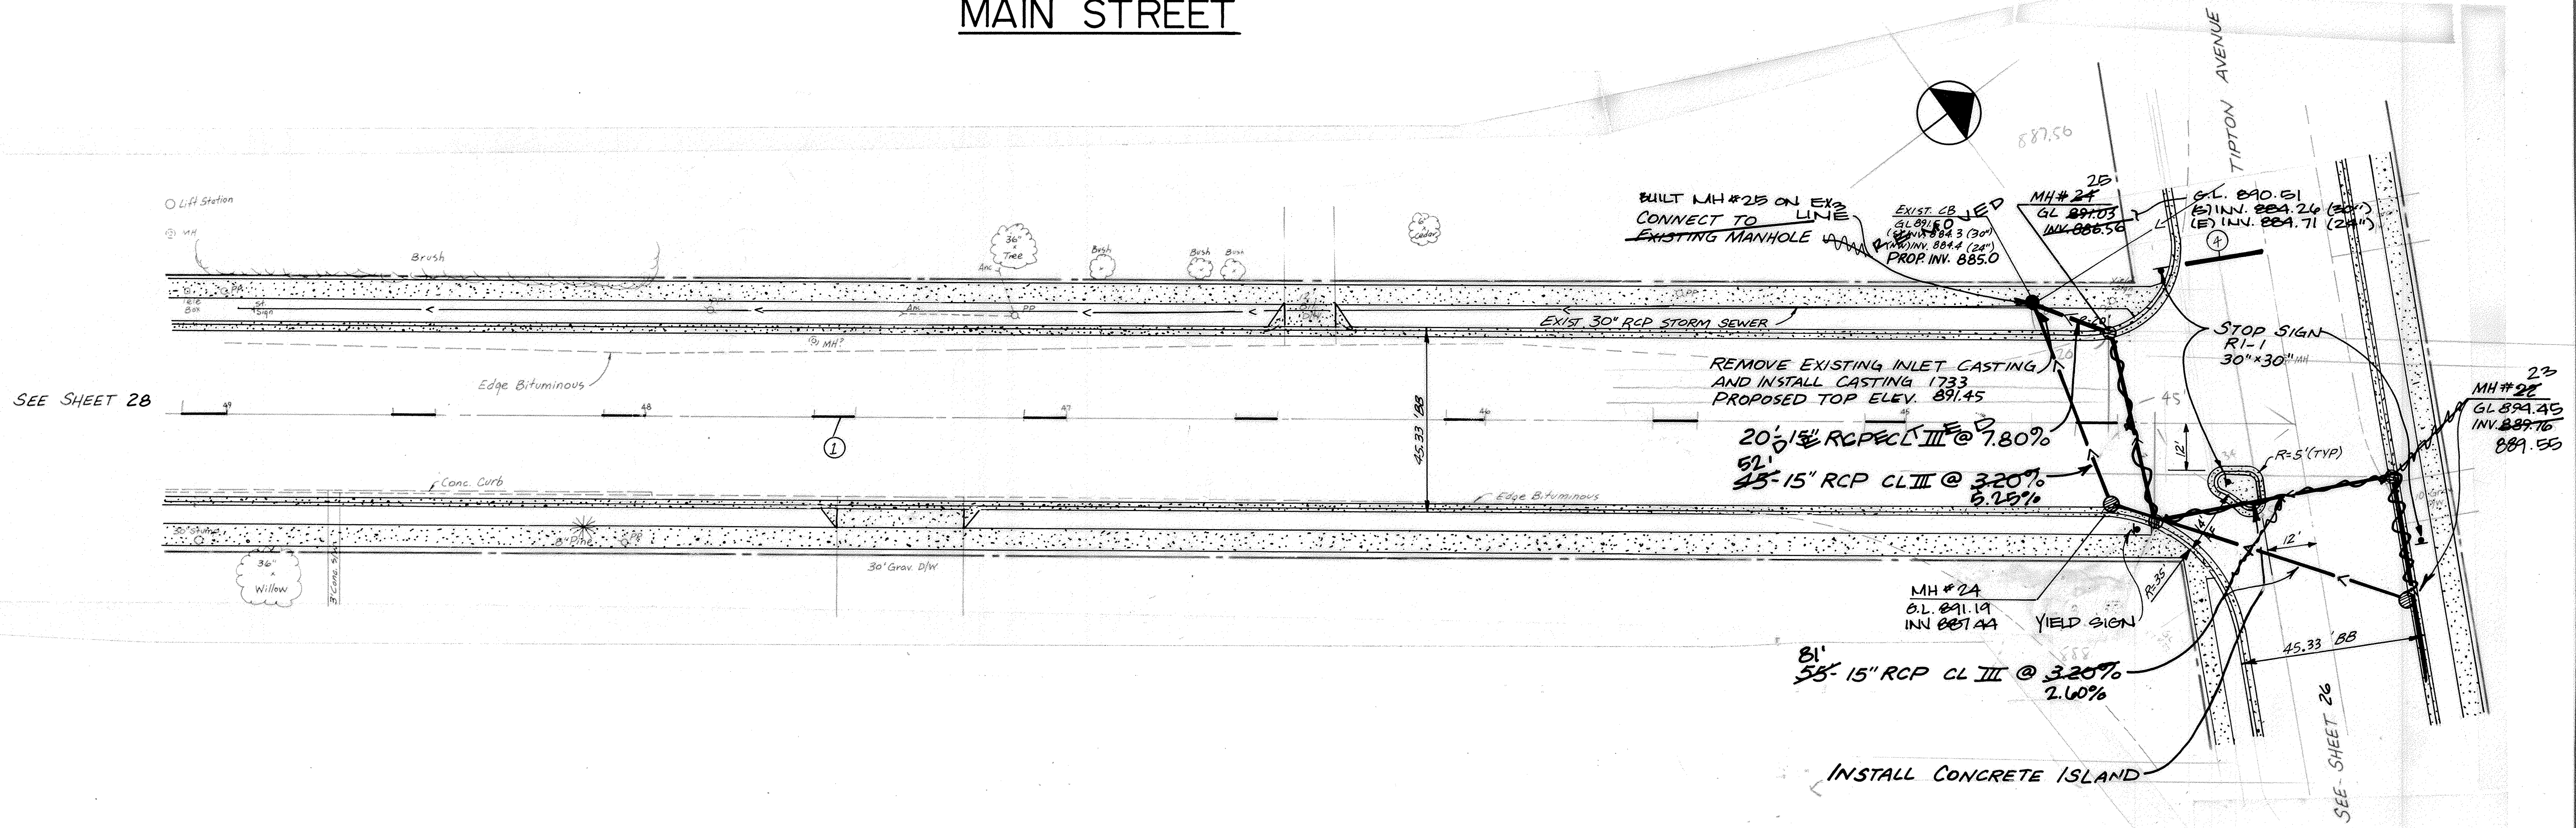

CONSULTING ENGINEERS
Maier Stewart & Associates Inc.

1959 SLOAN PLACE (612) 774-6021 ST. PAUL, MINNESOTA 55117

REVISIONS	DATE	DESCRIPTION	DESIGNED	CHECKED	DRAWN	GRAPHIC SCALE	CITY OF ELK RIVER		
	3/5/88	Street Grades			NRJ	0' HORIZ. 20' 0' VERT. 5'	STREET CONSTRUCTION MAIN STREET		
							DATE OCT 1987	SHEET 27 OF 42 SHEETS	PROJECT NO. 230-0/4