
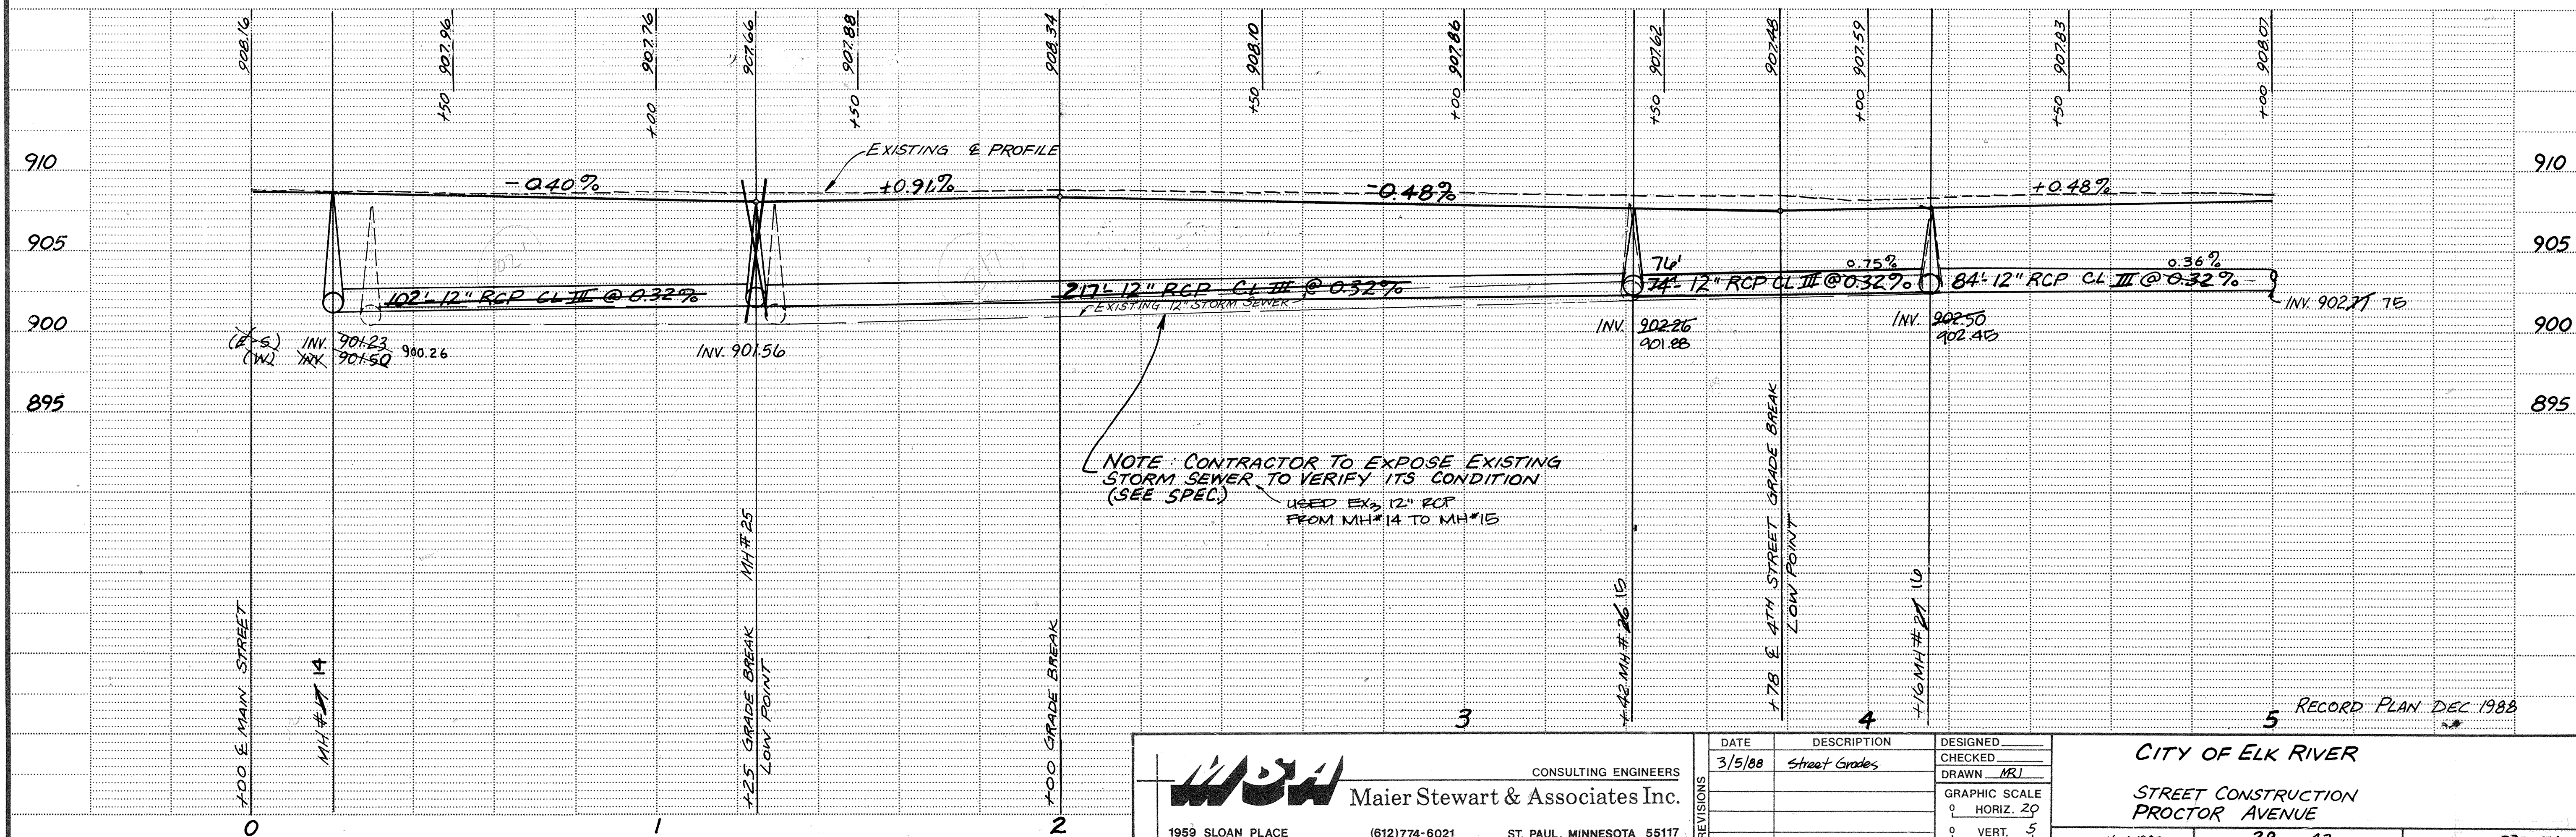


PROCTOR AVENUE

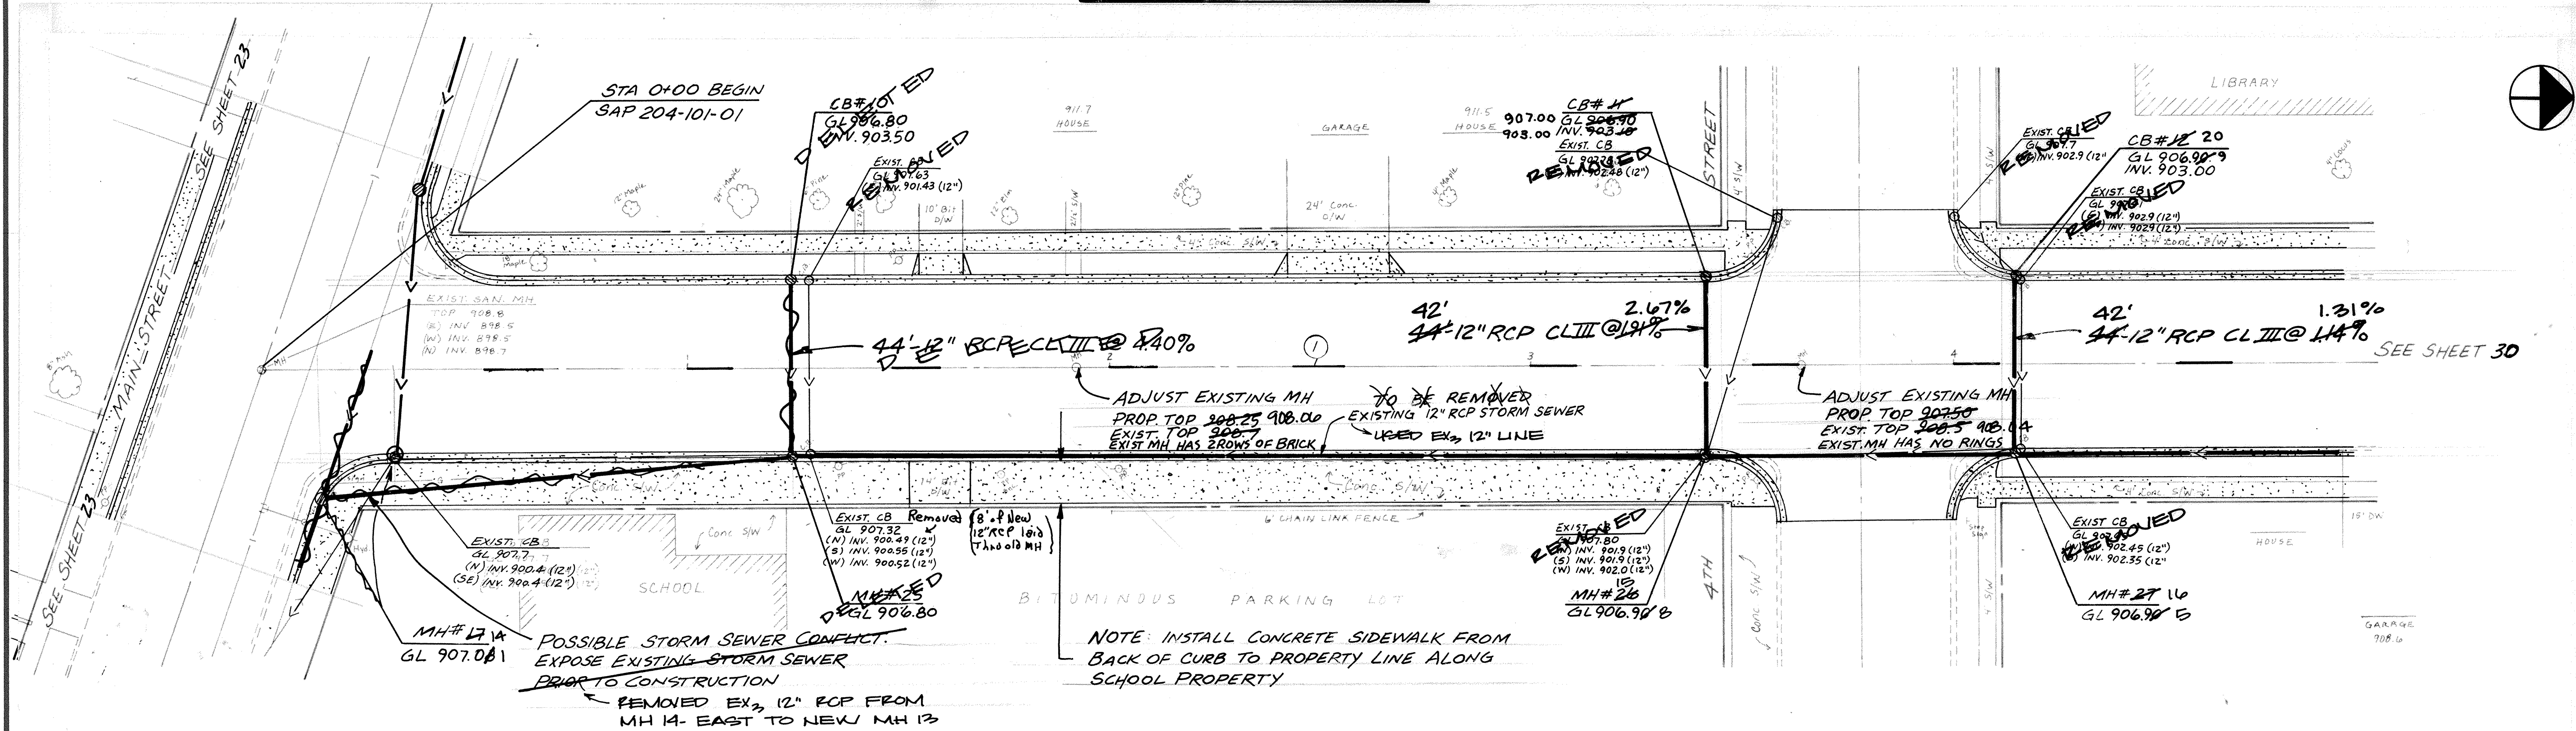

CONSULTING ENGINEERS
Maier Stewart & Associates Inc.

1959 SLOAN PLACE (612)774-6021 ST. PAUL, MINNESOTA 55117

DATE	DESCRIPTION	DESIGNED
3/5/88	Street Grades	CHECKED
		DRAWN MRL
		GRAPHIC SCALE
		0 HORIZ. 20'
		0 VERT. 5'

CITY OF ELK RIVER

STREET CONSTRUCTION
PROCTOR AVENUE

DATE NOV 1987 SHEET 29 OF 42 SHEETS PROJECT NO. 230-014

SAP 204-101-01

246

DRAWING NUMBER

DRAWING NUMBER

DRAWING NUMBER

DRAWING NUMBER
MAINS 87
29