
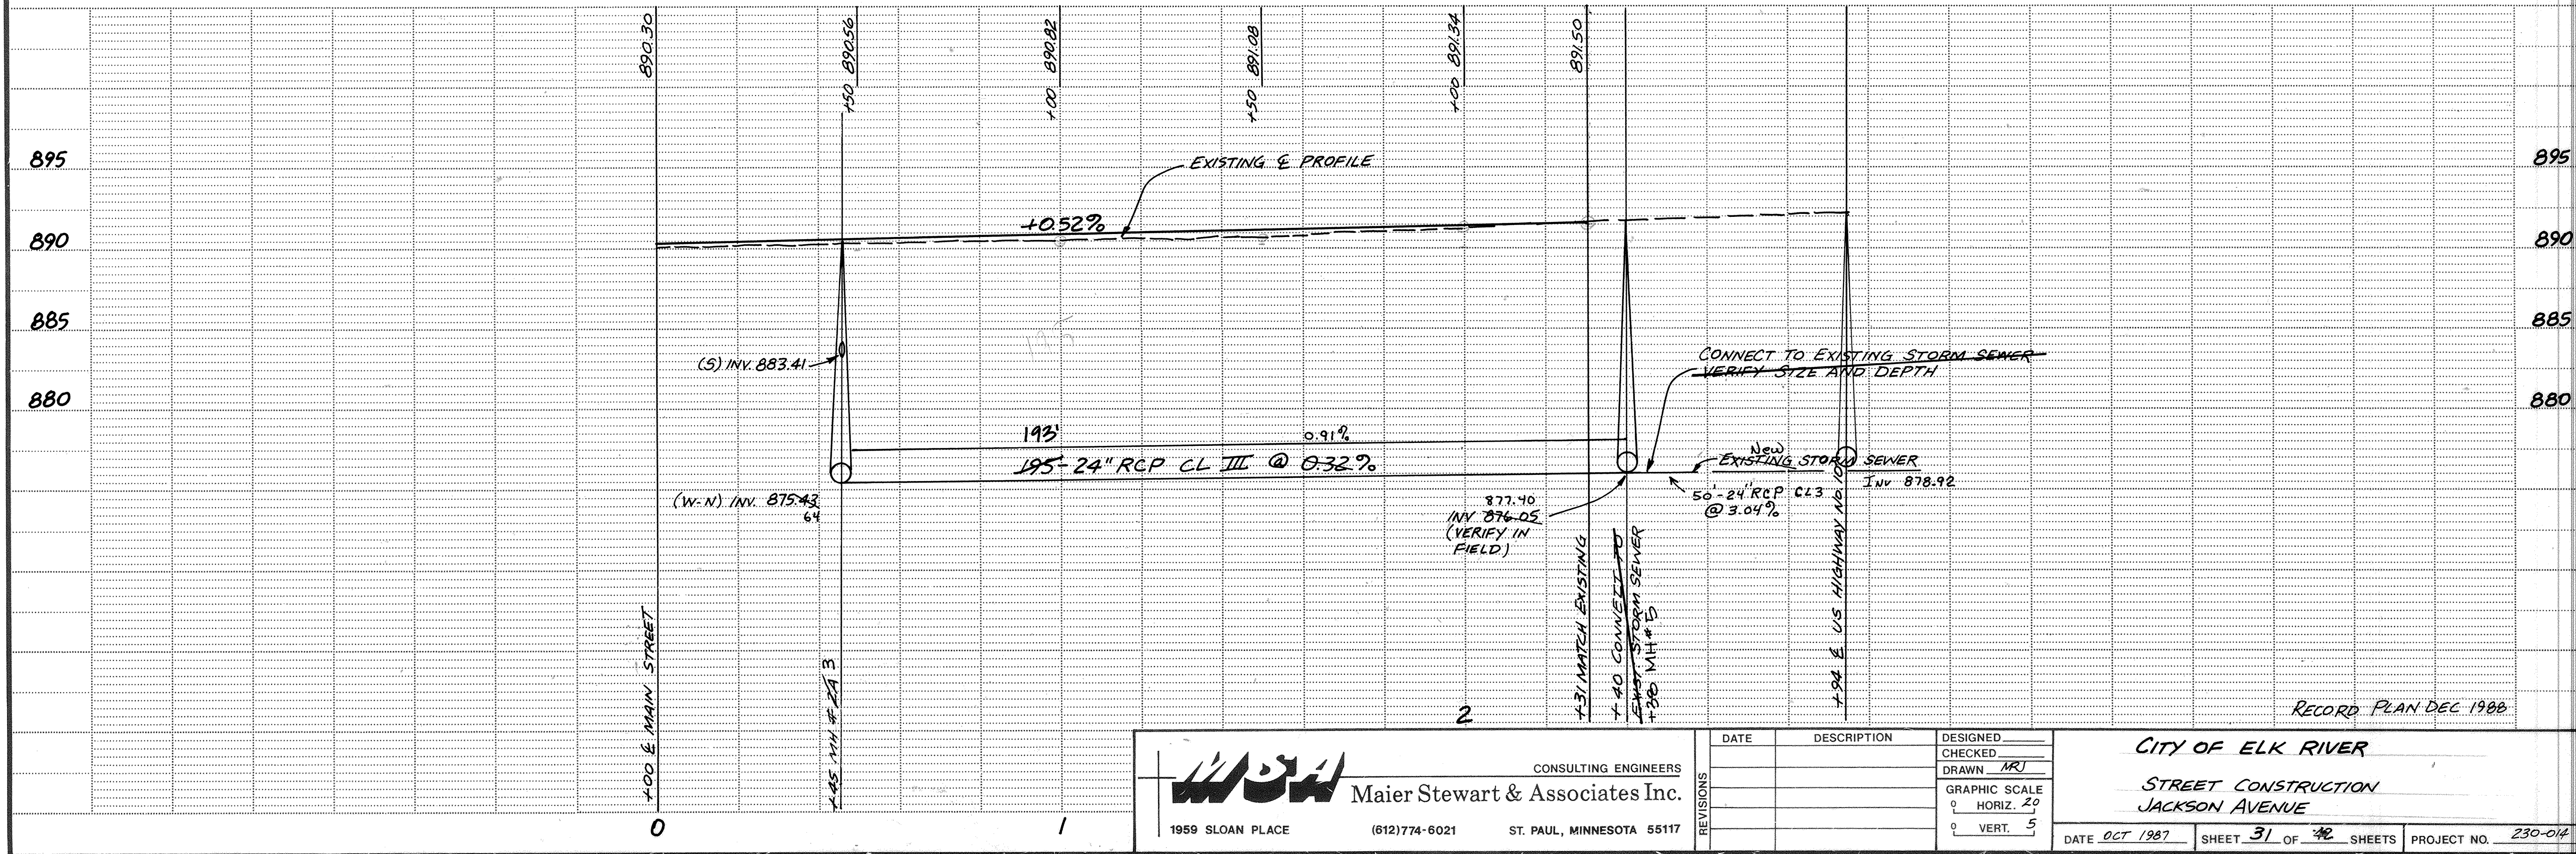


JACKSON AVENUE

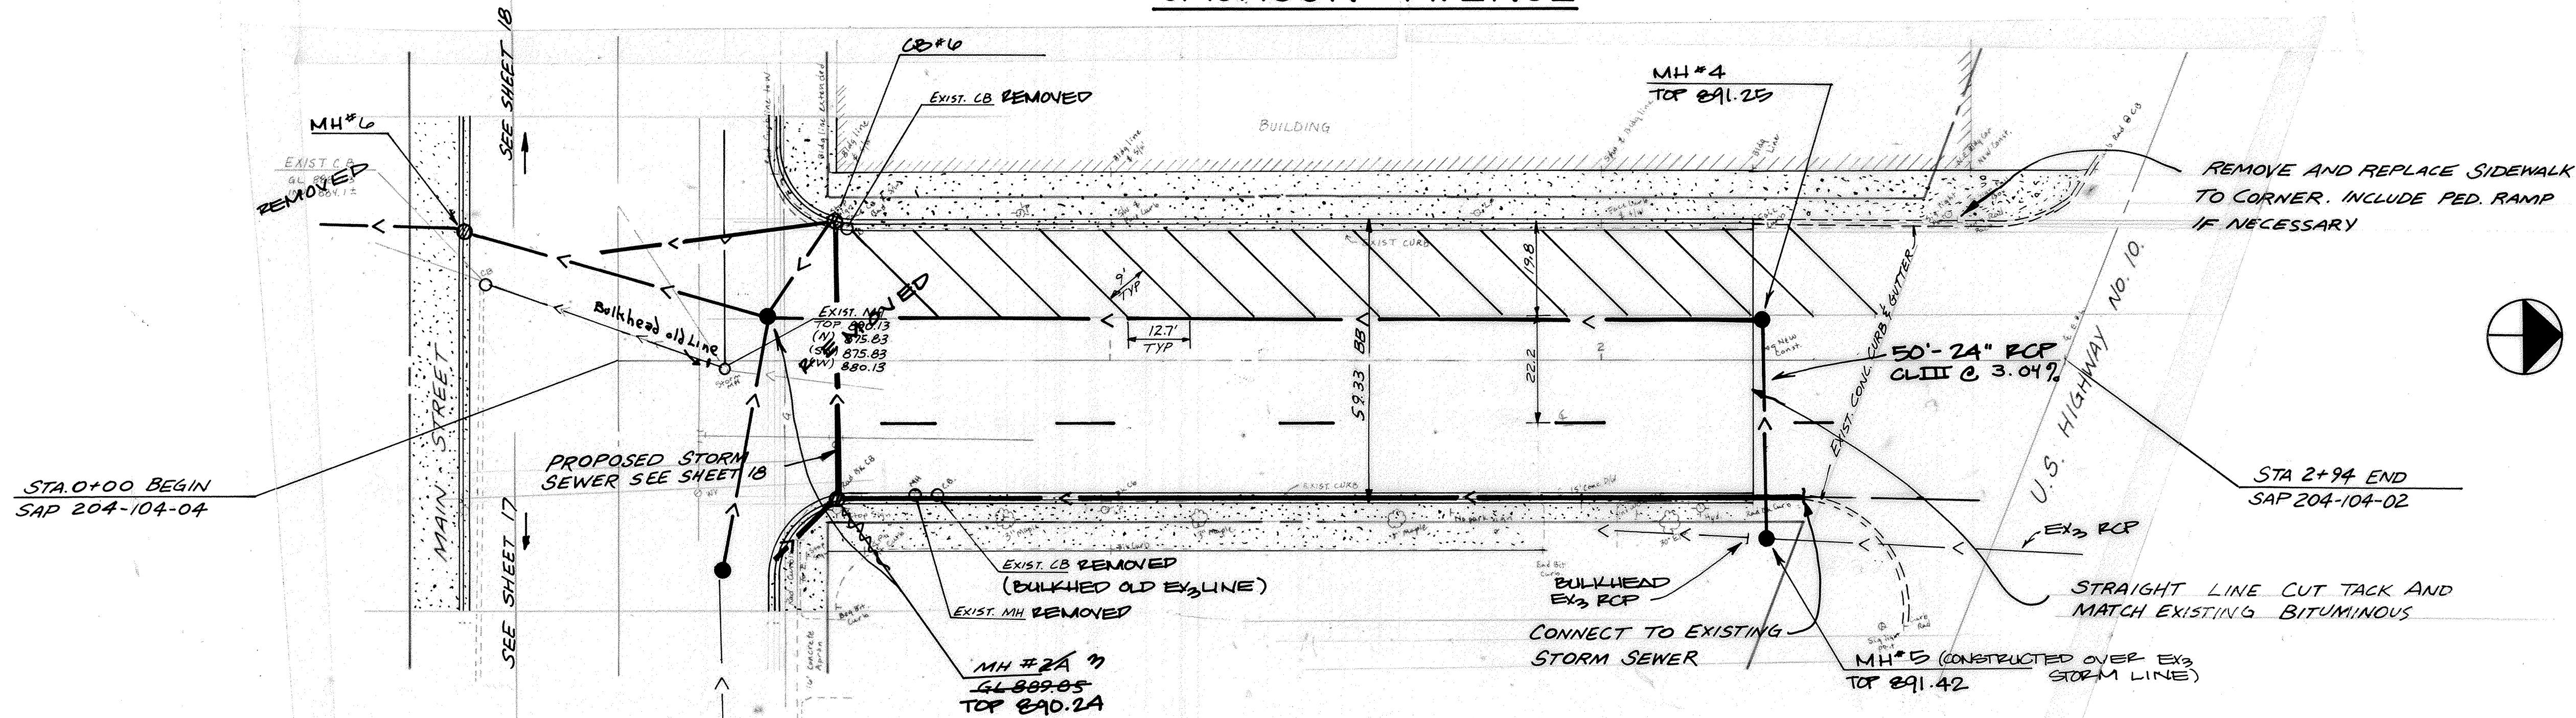

Maier Stewart & Associates Inc. CONSULTING ENGINEERS 1959 SLOAN PLACE (612) 774-6021 ST. PAUL, MINNESOTA 55117		CITY OF ELK RIVER STREET CONSTRUCTION JACKSON AVENUE	
DATE	DESCRIPTION	DESIGNED	CHECKED
		DRAWN	MRJ
GRAPHIC SCALE		VERT. 5	
HORIZ. 20			
REVISIONS			
DATE OCT 1987		SHEET 31 OF 42 SHEETS PROJECT NO. 230-014	
SAP 204-104-02		244	