


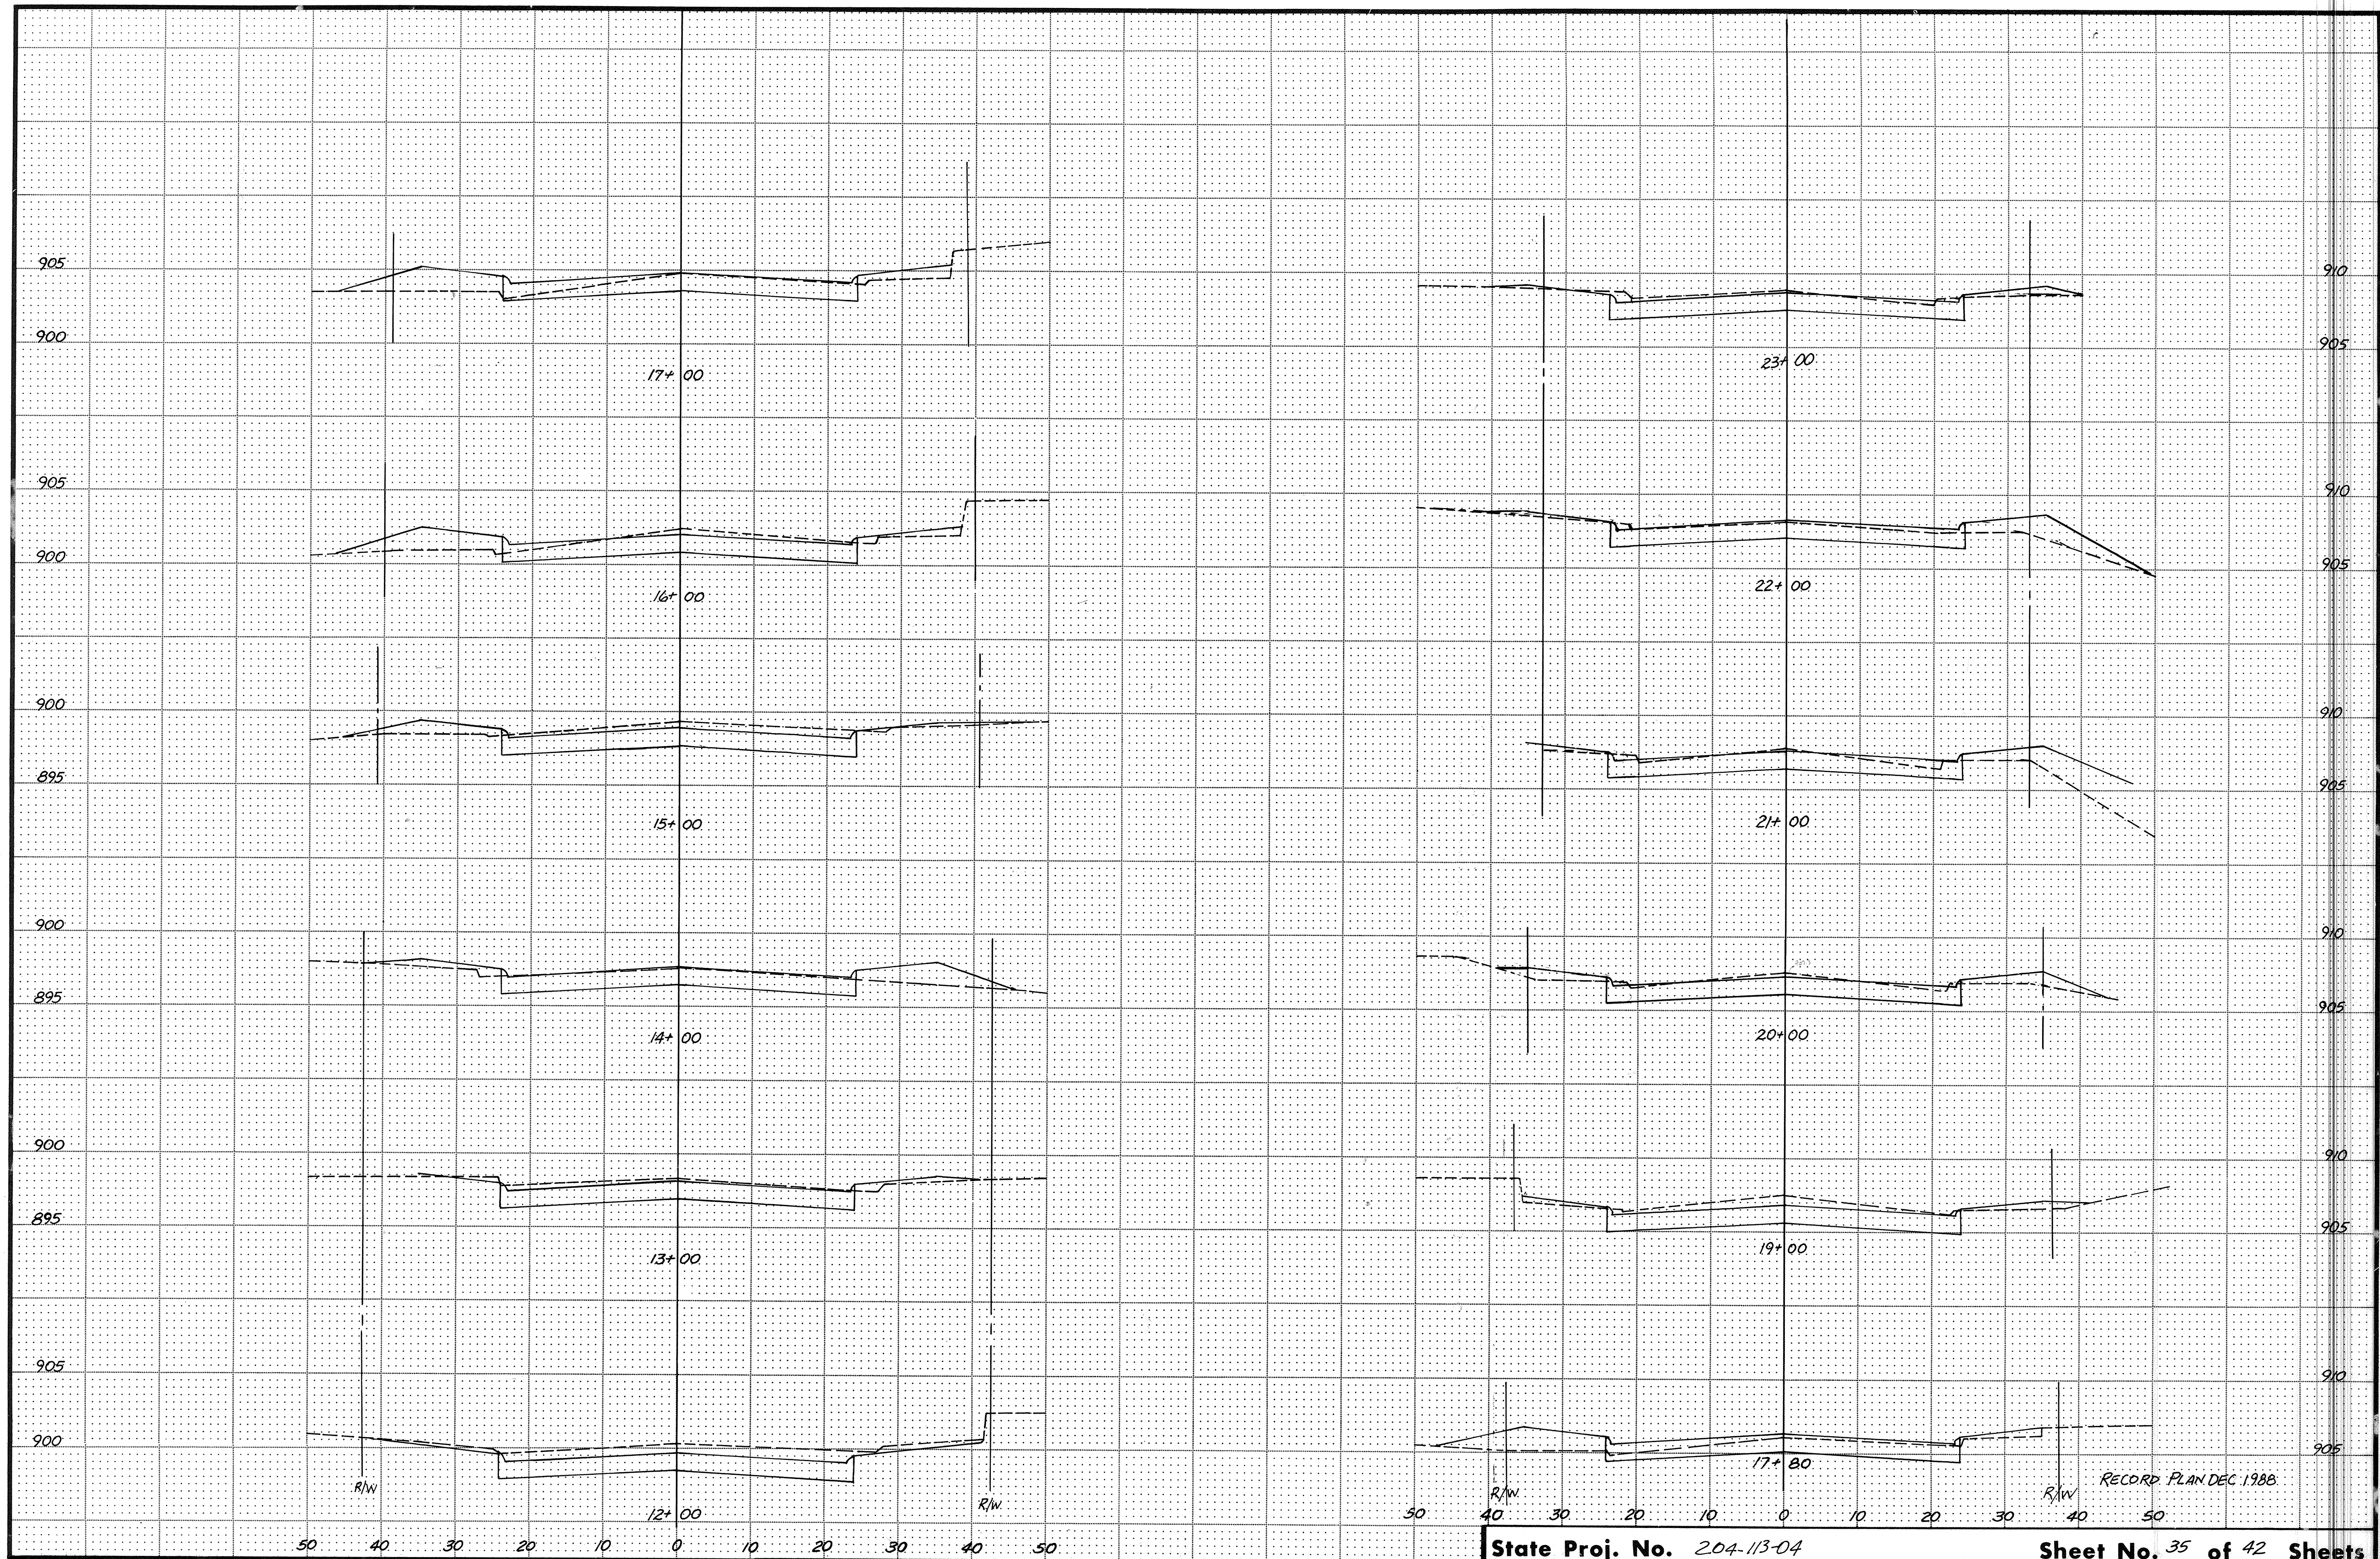

State Proj. No. 204-113-04

Sheet No. 35 of 42 Sheets

SCALE HORIZ. 1"=10'
VERT. 1"=5'

MAIN STREET

240 230-014

RECORD PLAN DEC 1988