



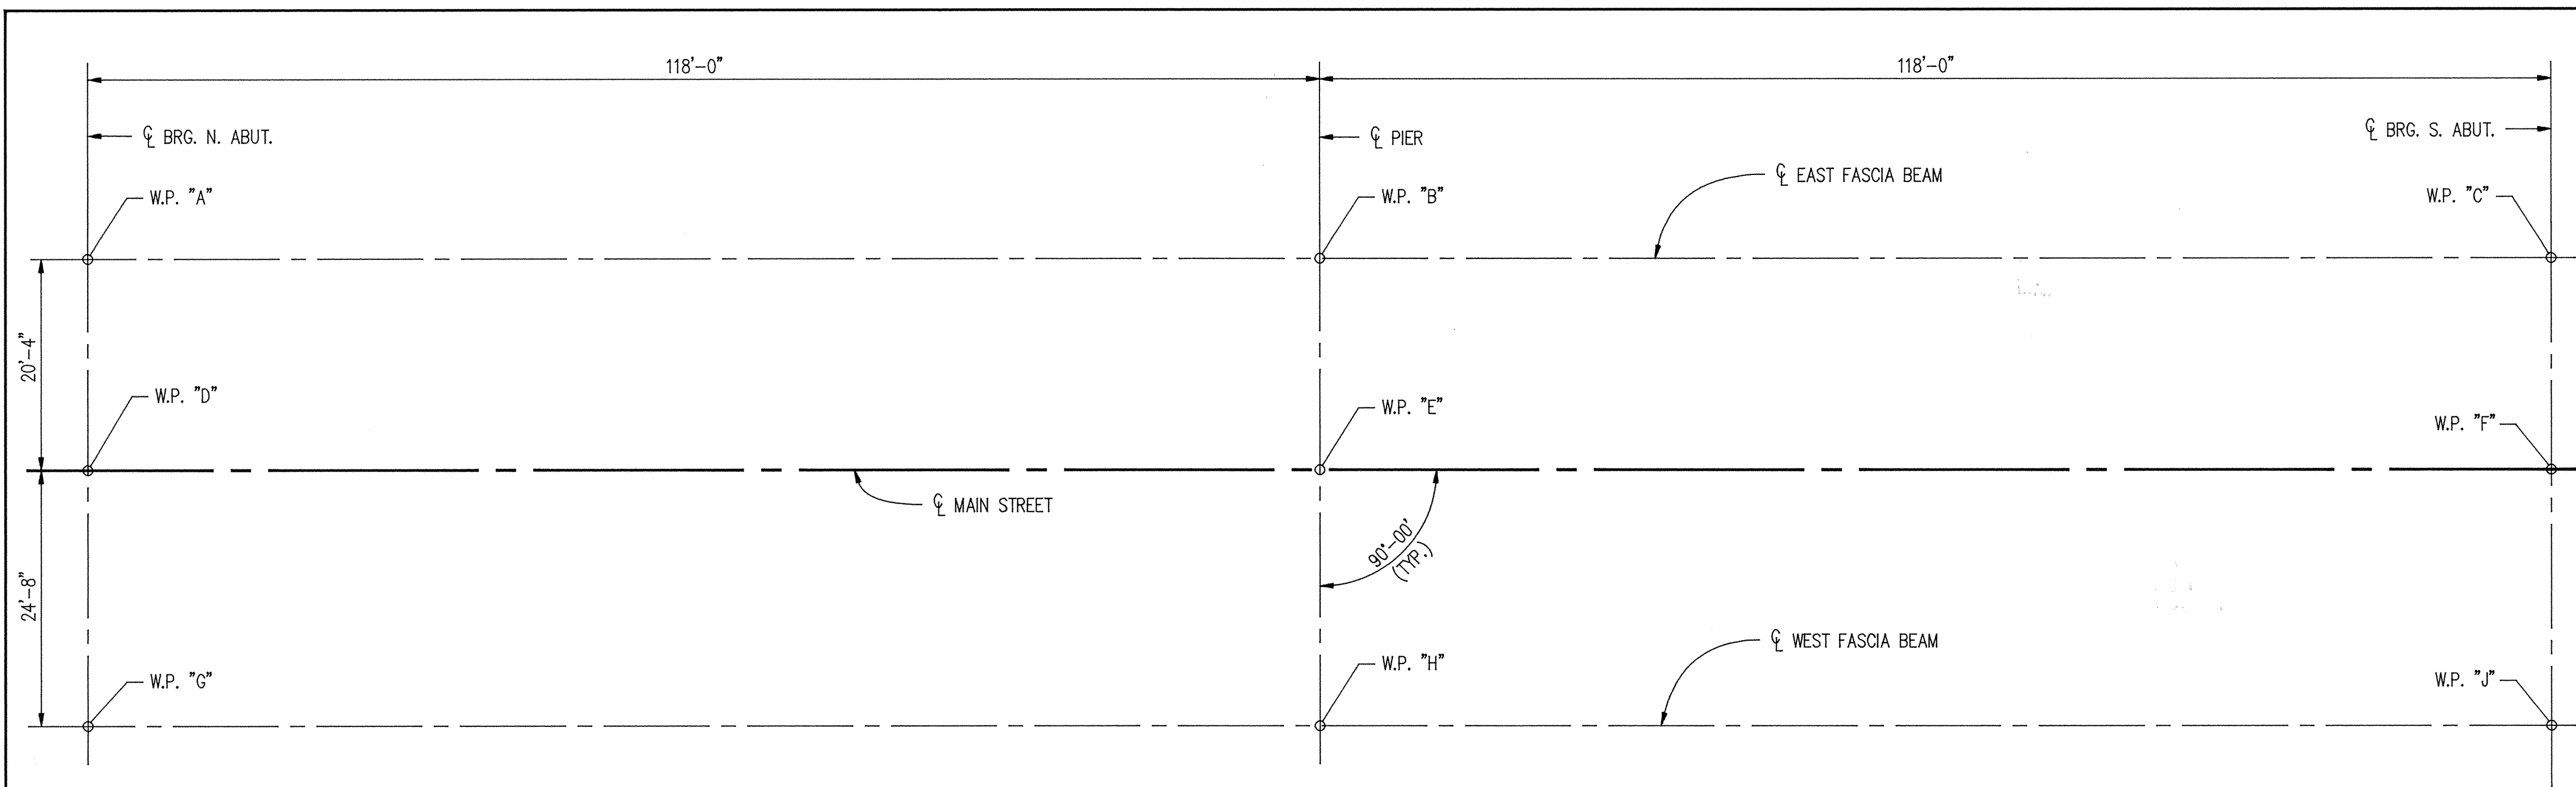

BRIDGE LAYOUT

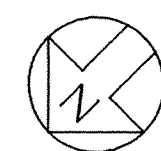


TOP OF ROADWAY TO BRIDGE SEAT		
	ABUTS.	PIER
SLAB THICKNESS	9"	9"
STOOL HEIGHT	3"	3"
BEAM HEIGHT	72"	72"
BEARING HEIGHT	6 1/4"	3 3/4"
TOTAL, INCHES	90 1/4"	87 3/4"
TOTAL, FEET	7.52	7.31


PREFORMED JOINT FILLER LIST			
TYPE	NO.	SIZE	LOCATION
SPEC. 3702	11	1" x 11" x 2'-3 1/2"	RAILING DEFLECTION JOINTS (CORK)
SPEC. 3702	6	1" x 1'-6 1/4" x 1'-5"	RAILING DEFLECTION JOINTS (CORK)

DIMENSIONS BETWEEN WORKING POINTS											ELEVATIONS			
POINT	STATION	A	B	C	D	E	F	G	H	J	TOP OF RDWY.	TOP OF RDWY. TO BR. SEAT	TOP OF BR. SEAT	POINT
A	2+91.42	_____									876.70	7.52	869.18	A
B	4+09.42	118.00	_____								877.29	7.31	869.98	B
C	5+27.42		118.00	_____							877.88	7.52	870.36	C
D	2+91.42	20.33			_____						877.11			D
E	4+09.42	119.74	20.33		118.00	_____					877.70			E
F	5+27.42		119.74	20.33		118.00	_____				878.29			F
G	2+91.42		126.29	240.25	24.67			_____			*876.67	7.52	869.15	G
H	4+09.42	126.29		126.29	120.55	24.67		118.00	_____		*877.25	7.31	869.94	H
J	5+27.42	240.25	126.29			120.55	24.67		118.00	_____	*877.85	7.52	870.33	J

* - ELEVATION IS AT GUTTER LINE

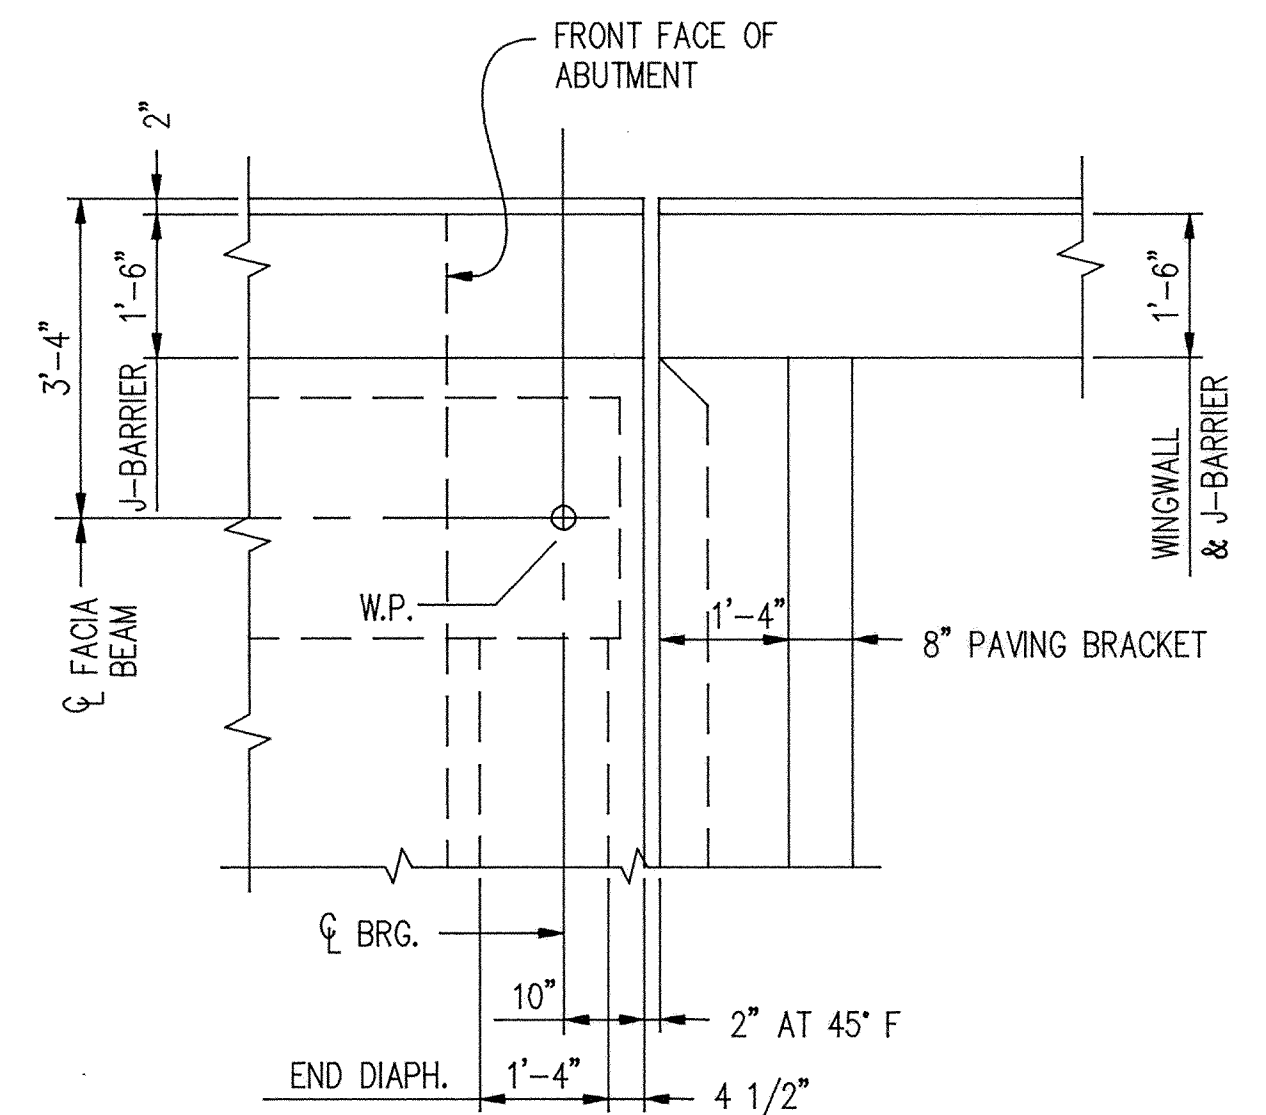


S.E. CORNER

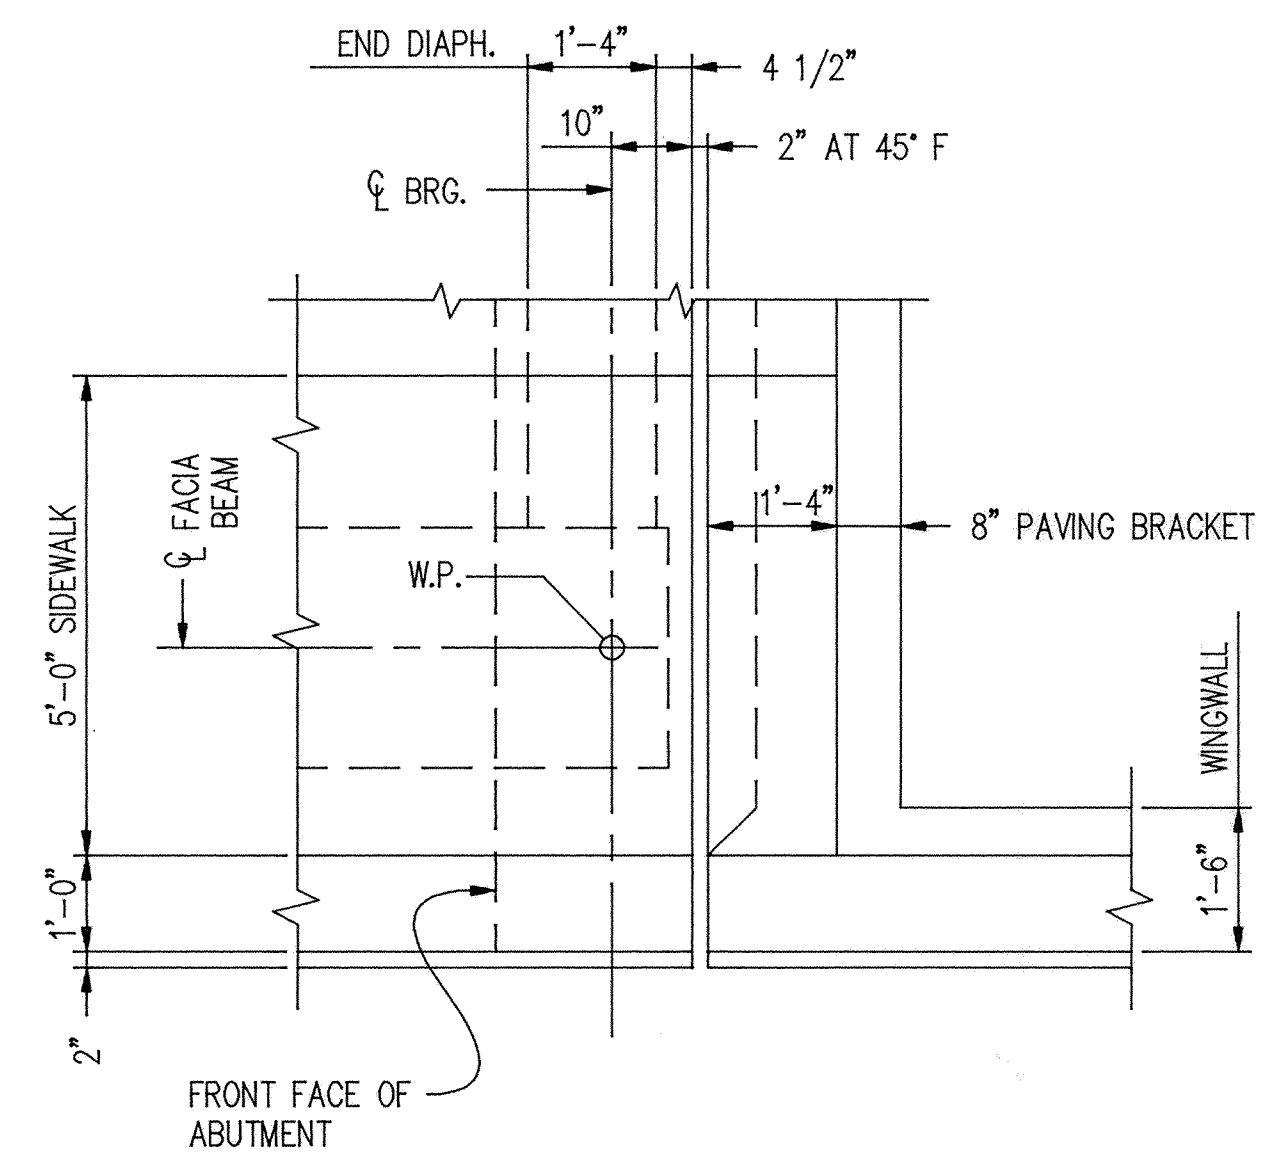

S.W. CORNER

CORNER DETAILS

① CUT 2 FROM 1.

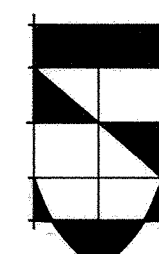

Larson
ENGINEERING OF MINNESOTA
3524 LABORE ROAD
WHITE BEAR LAKE, MN. 55110
612-481-9120

S.P. 204-113-03

BRIDGE LAYOUT

DES : RLD	DR : GLA	APPROVED :	Bridge No. 71517
CHK : DRM	CHK : DRM	7-2-92	
Sheet No. 2 of 24 Sheets			

RECORD PLAN OCT. 1993