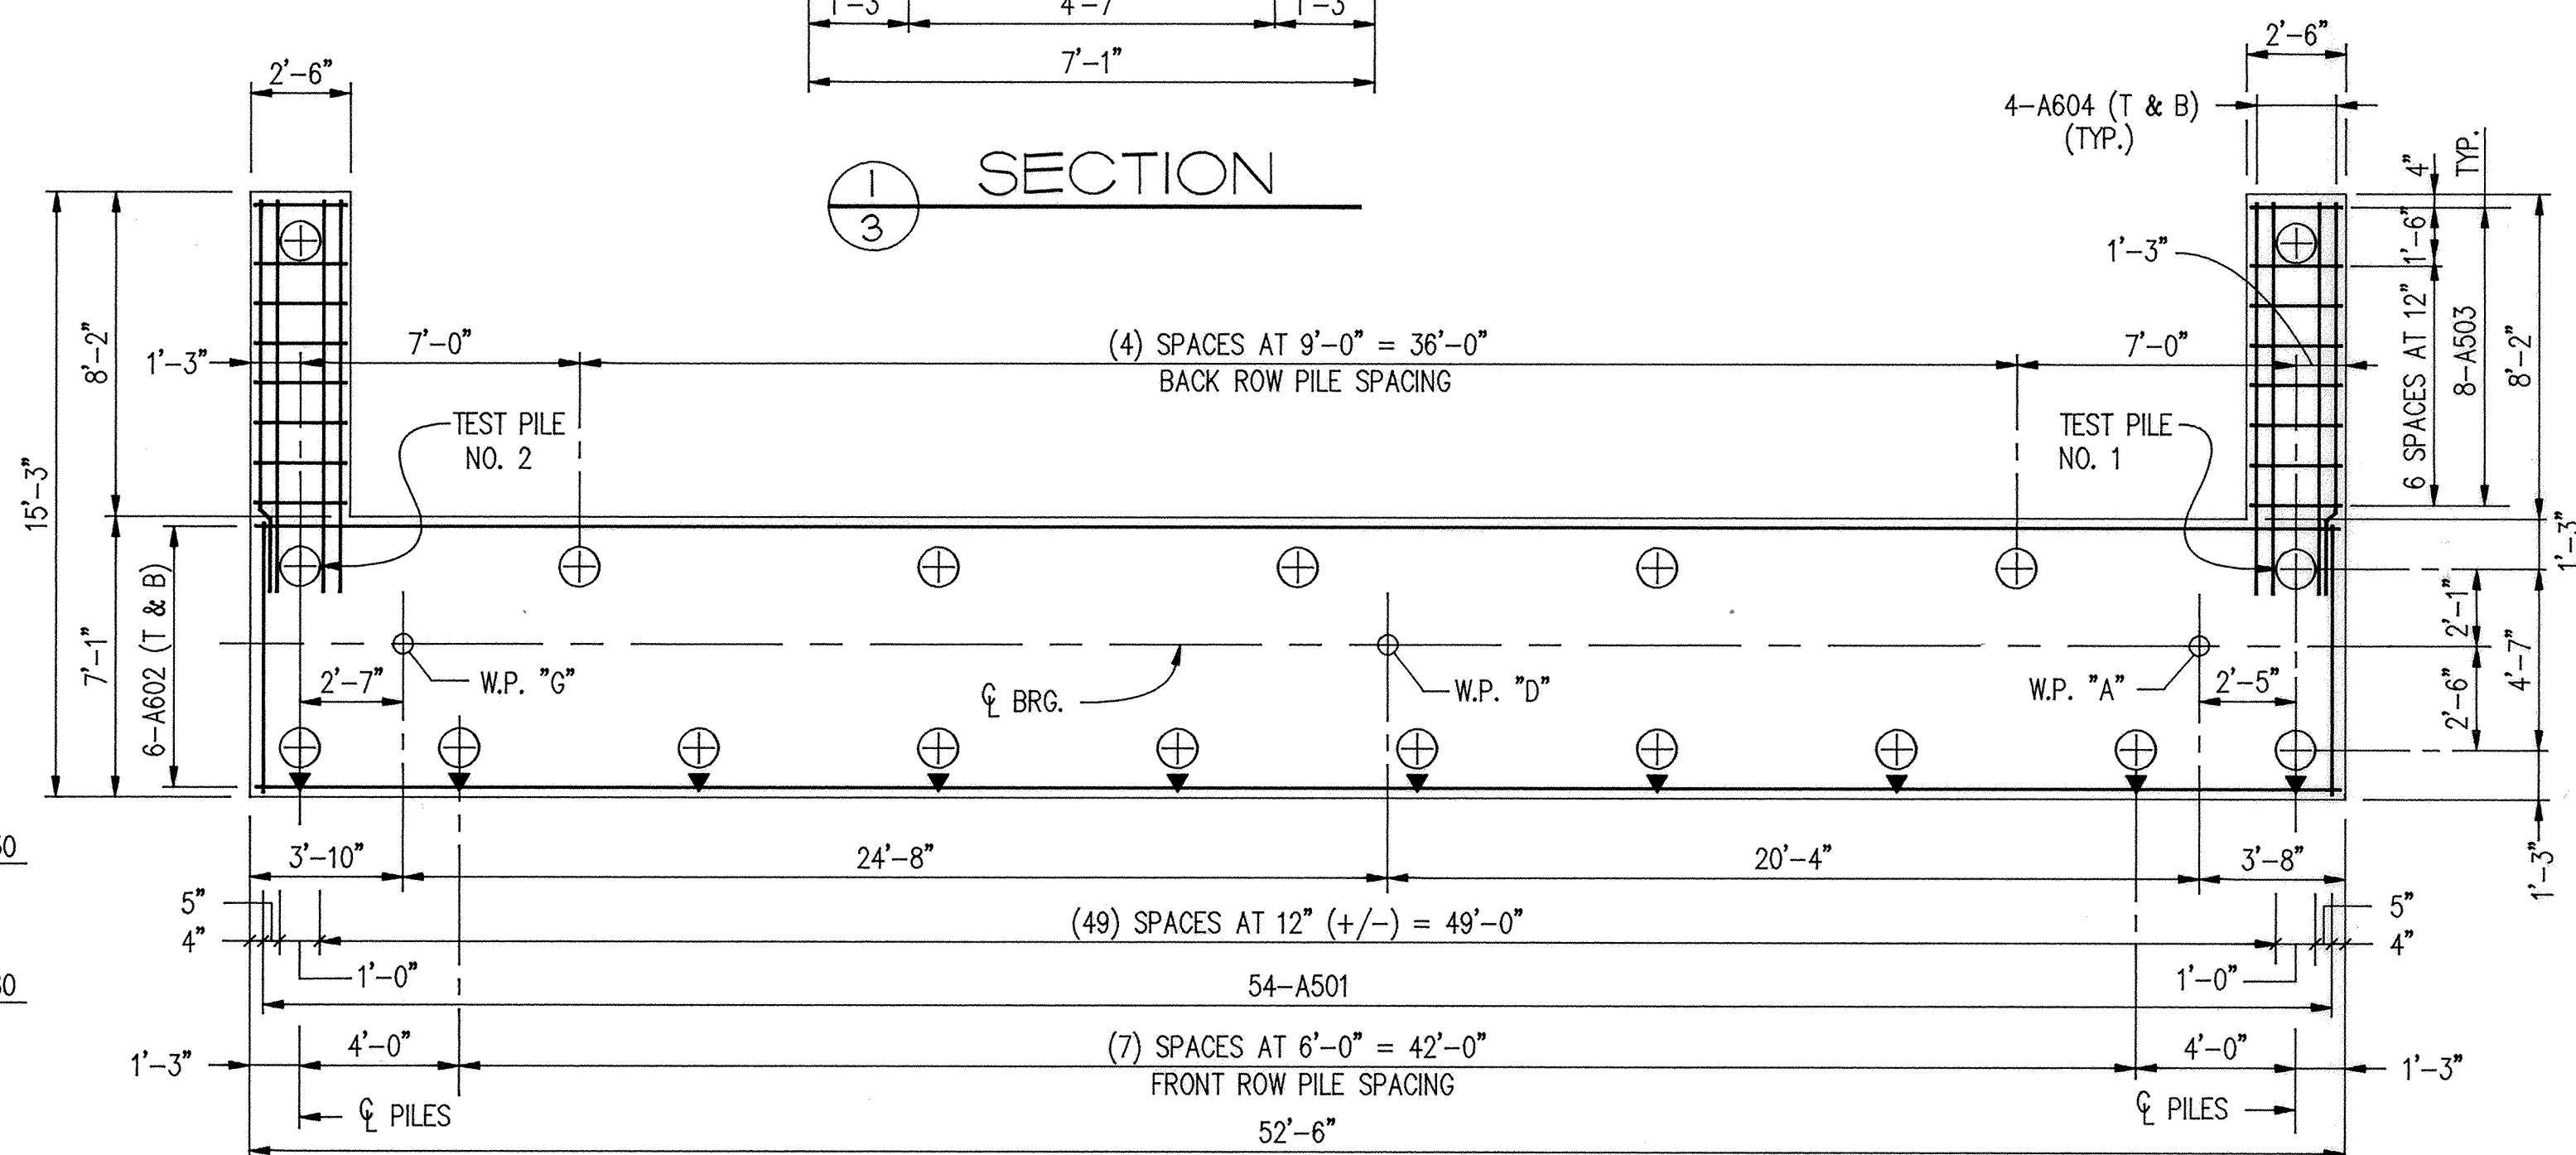
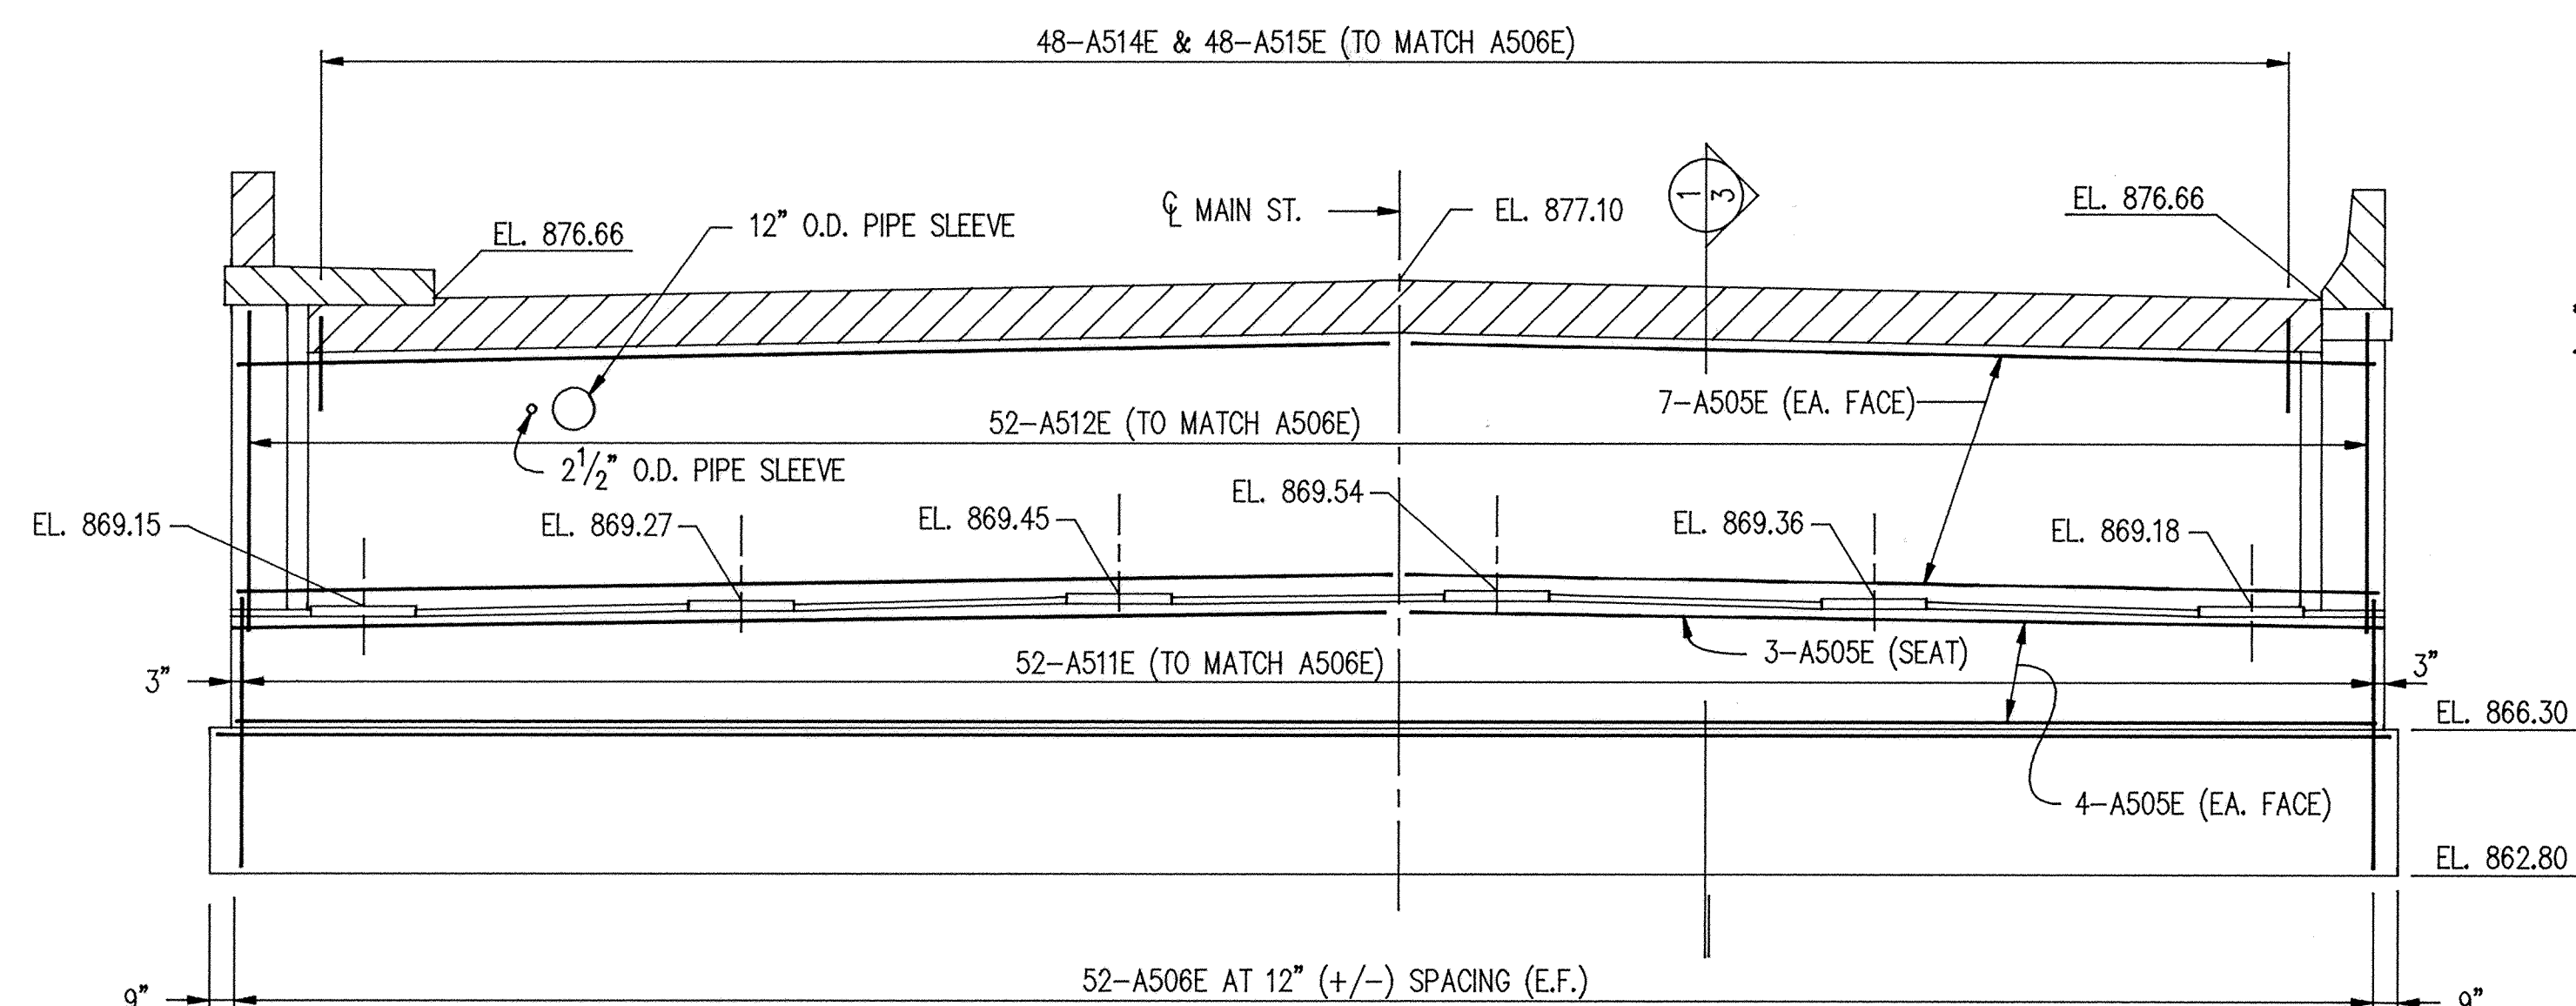
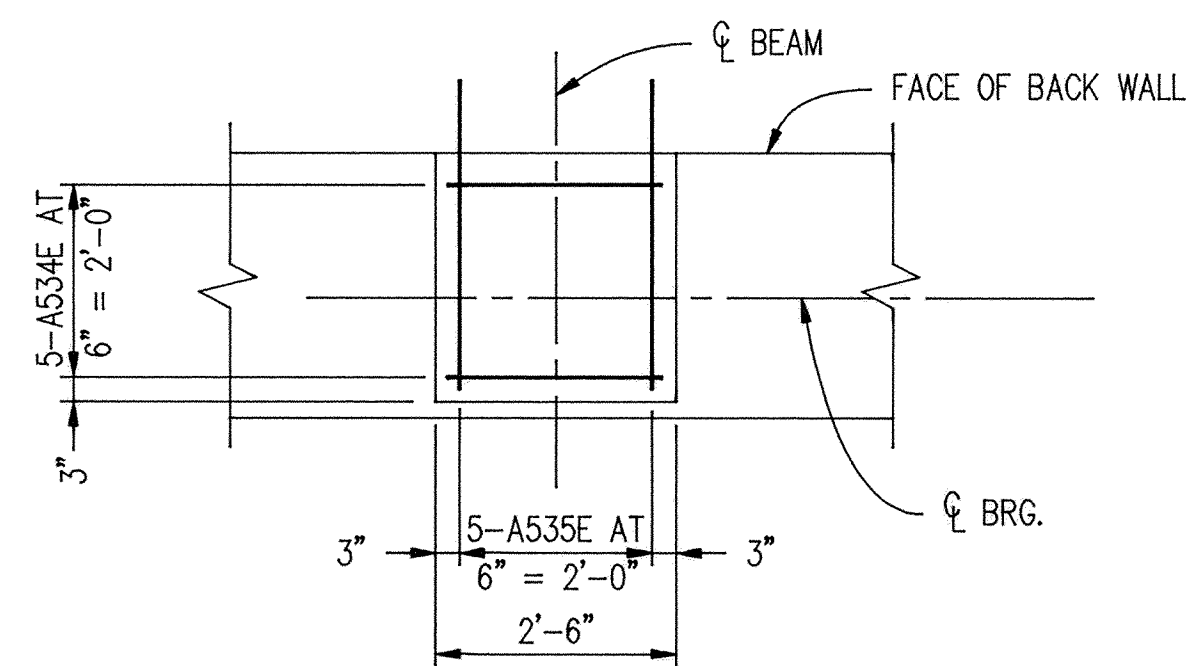
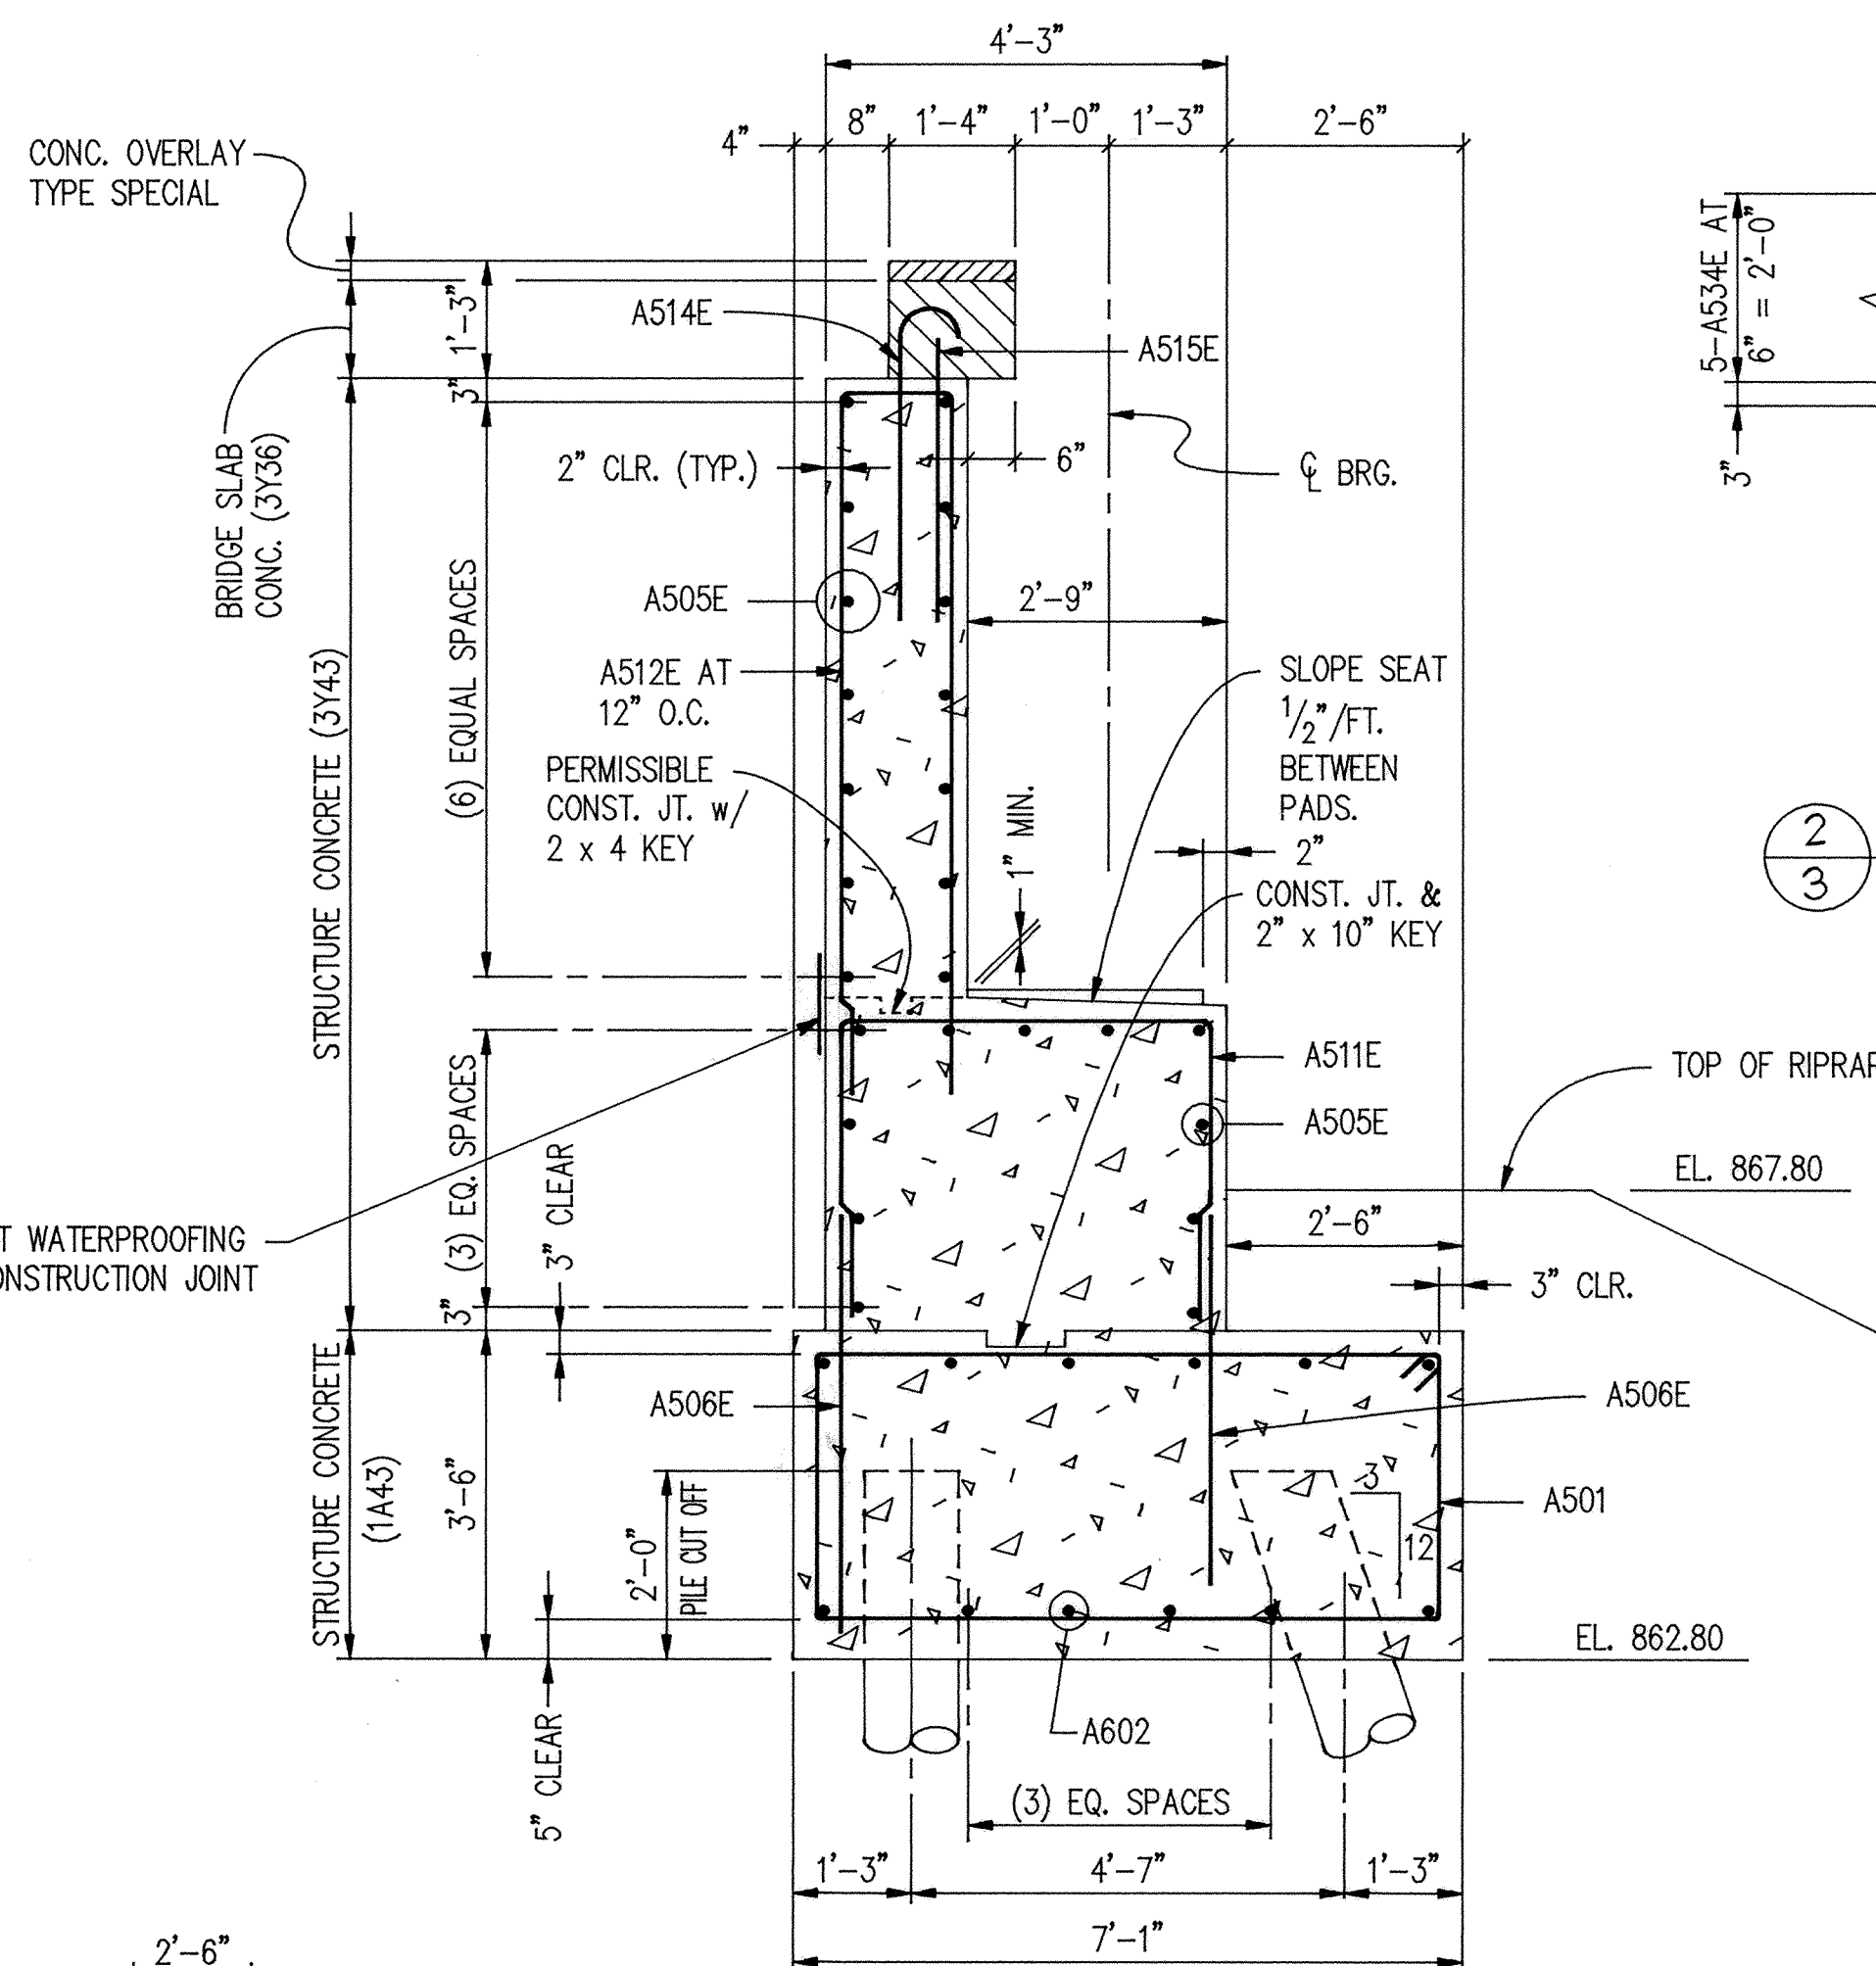
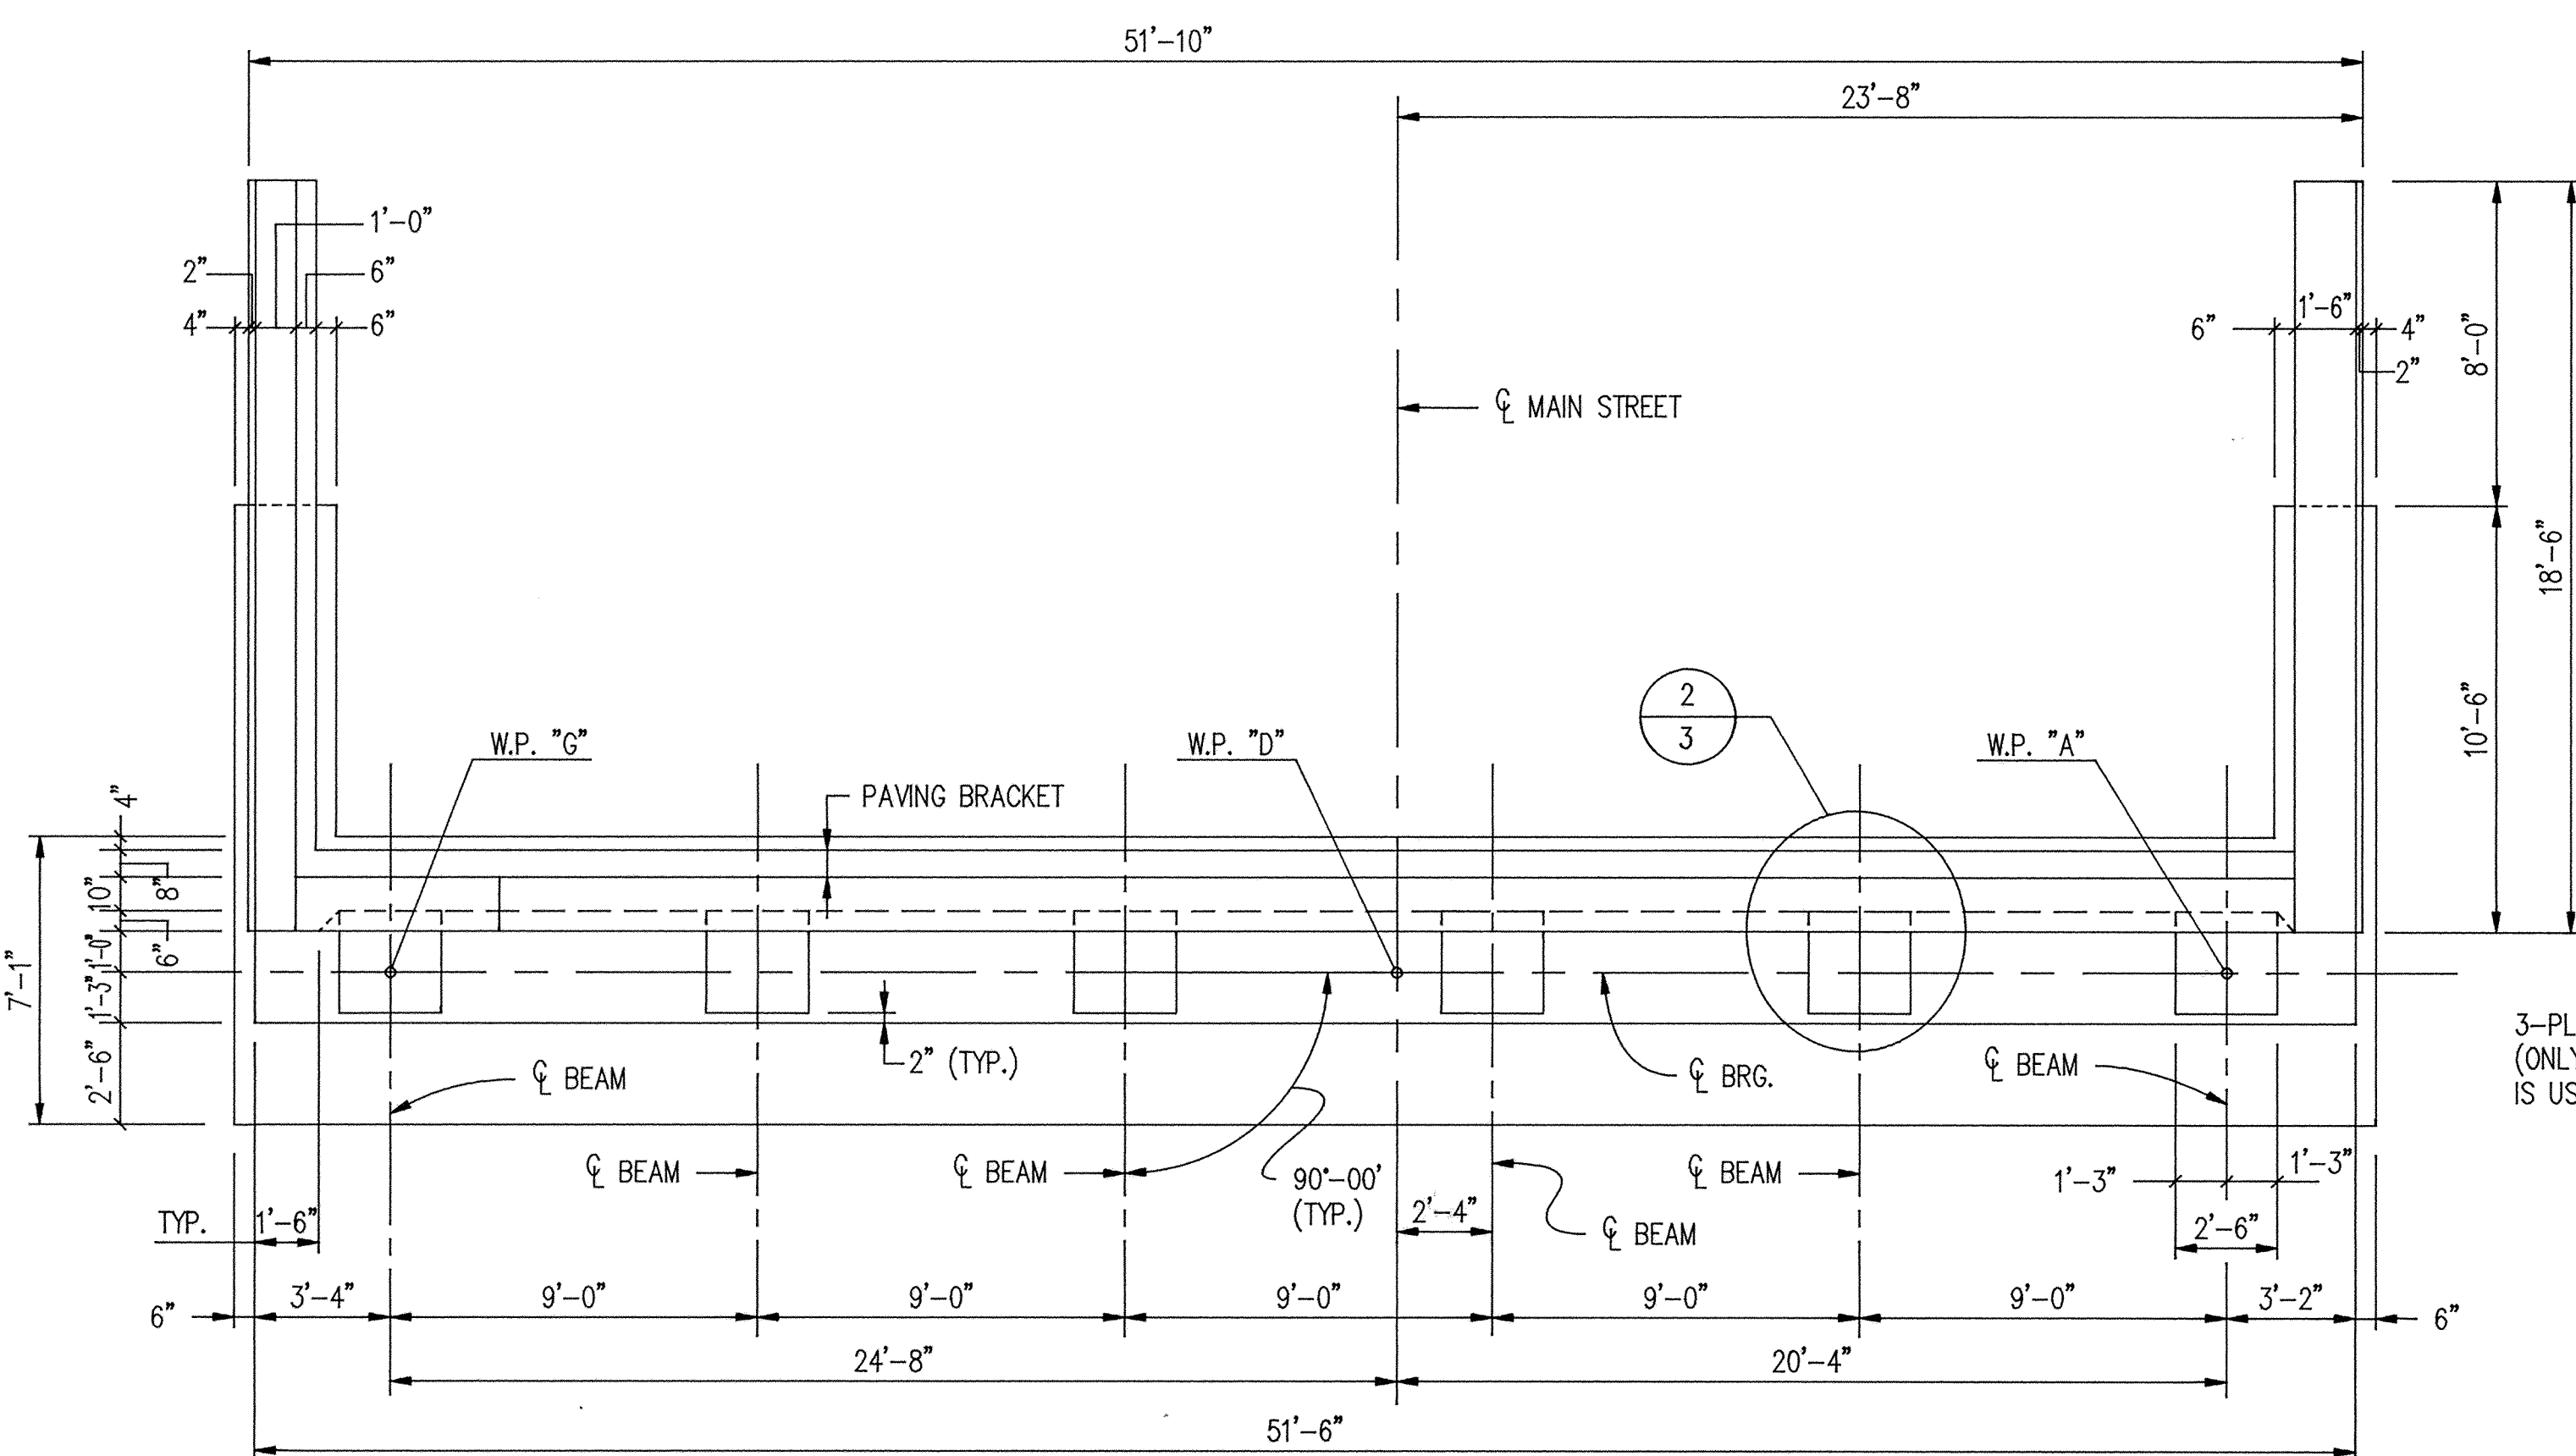


Larson
ENGINEERING OF MINNESOTA
3524 LABORE ROAD
WHITE BEAR LAKE, MN. 55110
612-481-9120

S.P. 204-113-03

NORTH ABUTMENT

DES : DRM	DR : GLA	APPROVED :
CHK : RLD	CHK : RLD	7-2-92
Sheet No. 3 of 24 Sheets		

RECORD PLAN OCT. 1993

Bridge No.	71517
------------	-------