


1
12 RAILING ELEVATION
CONCRETE RAILING (TYPE J)
LOOKING EAST

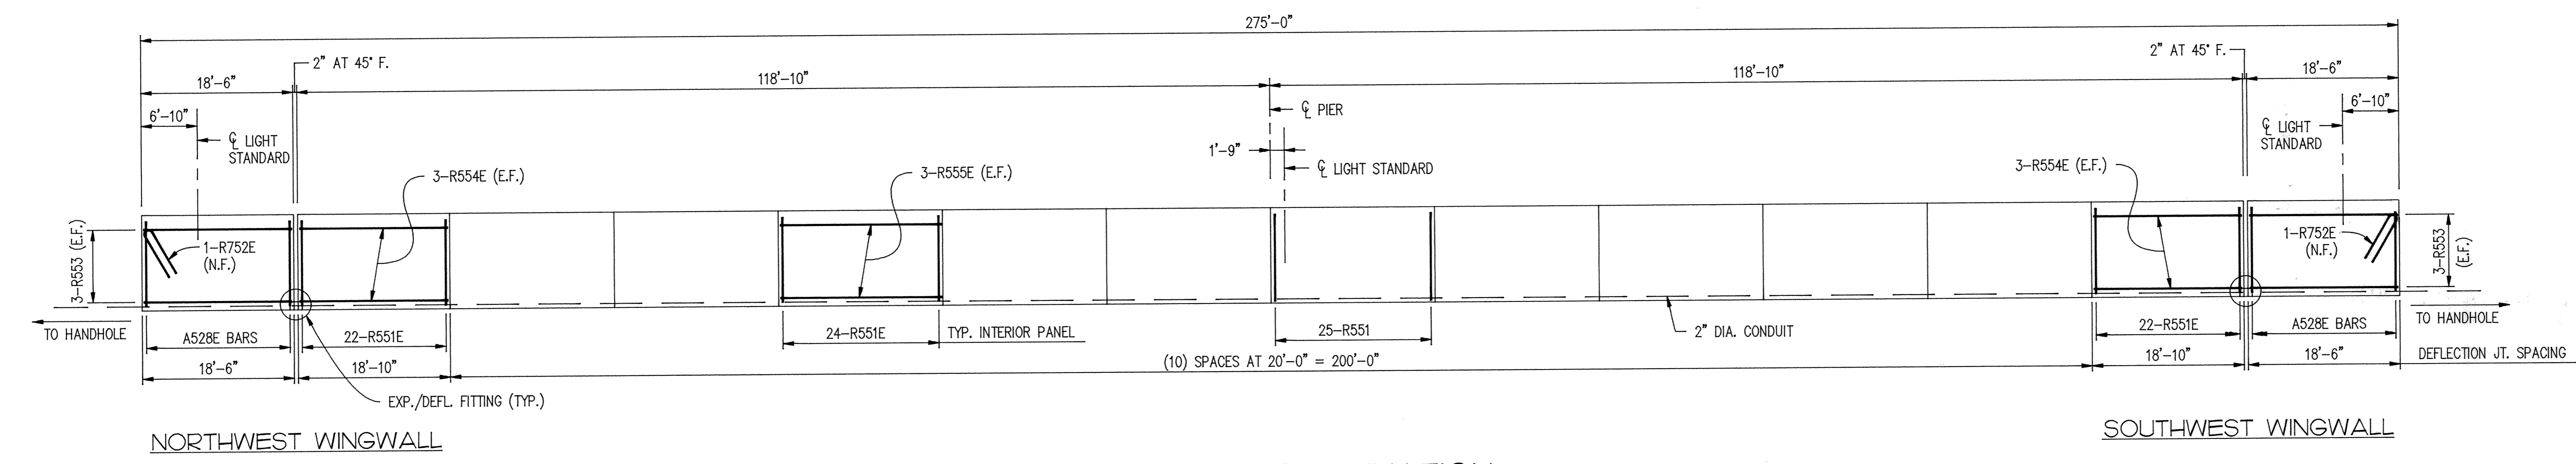

2
12 RAILING ELEVATION
CONCRETE PARAPET & METAL RAILING
LOOKING EAST - METAL RAILING NOT SHOWN

- NOTES :
- ① SEE SHEET 13 & SHEET 14 FOR RAILING DETAILS.
 - ② SEE SHEET 22 FOR CONDUIT SYSTEM DETAILS.

Larson
ENGINEERING OF MINNESOTA
3524 LABORE ROAD
WHITE BEAR LAKE, MN. 55110
612-481-9120

S.P. 204-113-03
RAILING ELEVATIONS

DES : RLD	DR : GLA	APPROVED :	RECORD PLAN OCT. 1993
CHK : DRM	CHK : DRM	7-2-92	Bridge No.
Sheet No. 12 of 24 Sheets			71517