


CONTROLLER CABINET

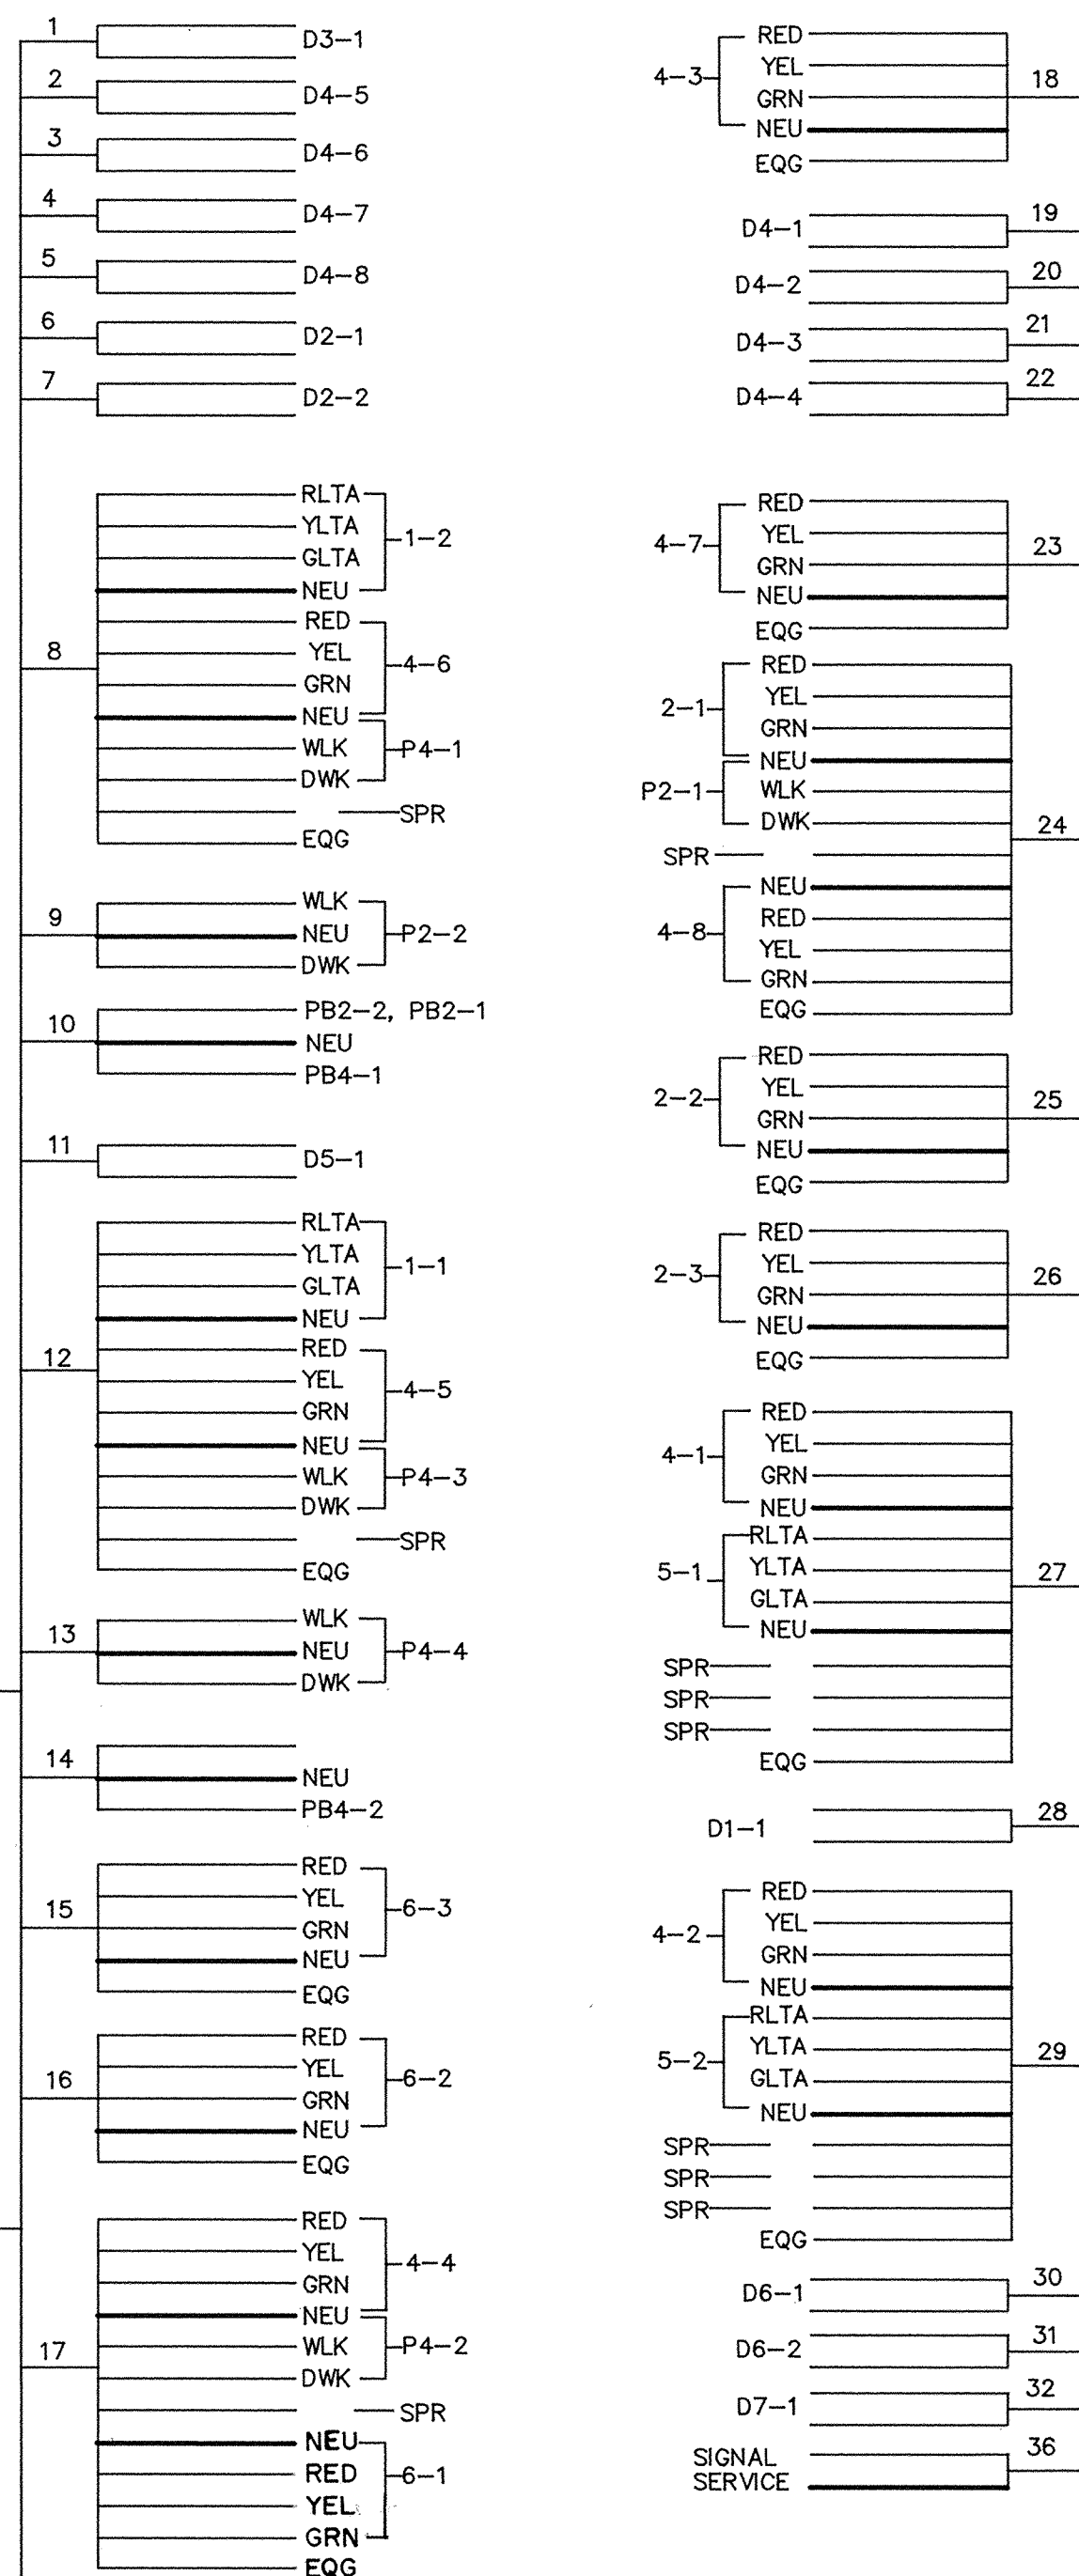

PAD MOUNTED SERVICE
EQUIPMENT
SIGNAL SERVICE

STREET LIGHT 33
STREET LIGHT 34
N.B. FLASHER 35

RECORD PLAN
JUNE 1994

TYPICAL CONDUCTOR COLOR CODE					
R	BLK	R	3/C #12	WH	3/C #4
O	WH	BLK		BLK	ARMORED
BL	R	CLR	2/C #14	SHIELD	CABLE
WH	BLK				
R/BLK	WH	BLK	2-1/C #6	R	
O/BLK	BLK	WH		O	
BL/BLK	WH	BLK	5/C #12	BLK	
WH/BLK	R	WH		WH	
BLK/WH	WH	G	2-1/C #10	G	
G/BLK					
G					

NOTE: ALL TERMINAL BLOCK
CONNECTIONS SHALL BE
ARRANGED AS SPECIFIED.

I HEREBY CERTIFY THAT THIS PLAN, SPECIFICATION, OR
REPORT WAS PREPARED BY ME OR UNDER MY DIRECT
SUPERVISION AND THAT I AM A DULY REGISTERED
PROFESSIONAL ENGINEER UNDER THE LAWS OF THE
STATE OF MINNESOTA

Jim Johnson
DATE 1/9/92 REG. NO. 12651

MSA
9800 SHELARD PARKWAY
1959 SLOAN PLACE

CONSULTING ENGINEERS

Maier Stewart & Associates Inc.
(612) 546-0432 MINNEAPOLIS, MINNESOTA 55441
(612) 774-6021 ST. PAUL, MINNESOTA 55117

DATE	DESCRIPTION	DESIGNED	CHECKED
1/29/92	MAJOR TRAFFIC ENGINEERING REVIEW COMMENTS	JEJ	JEJ
3/9/92	FINAL CORRECTIONS D. HANSEN / C. THORNTON	JEJ	JEJ
REVISIONS		DRAWN	
		JEJ	GG
		GRAPHIC SCALE	
		0 HORIZ. NONE	
		0 VERT.	

CITY OF ELK RIVER TEMPORARY TRAFFIC CONTROL SIGNAL SYSTEM MAIN STREET AT TH 169 PROPOSED FIELD WIRING DIAGRAM S.A.P. 204-113-05			
DATE	JAN 1992	SHEET	11A OF 17 SHEETS
PROJECT NO.	230-099		