


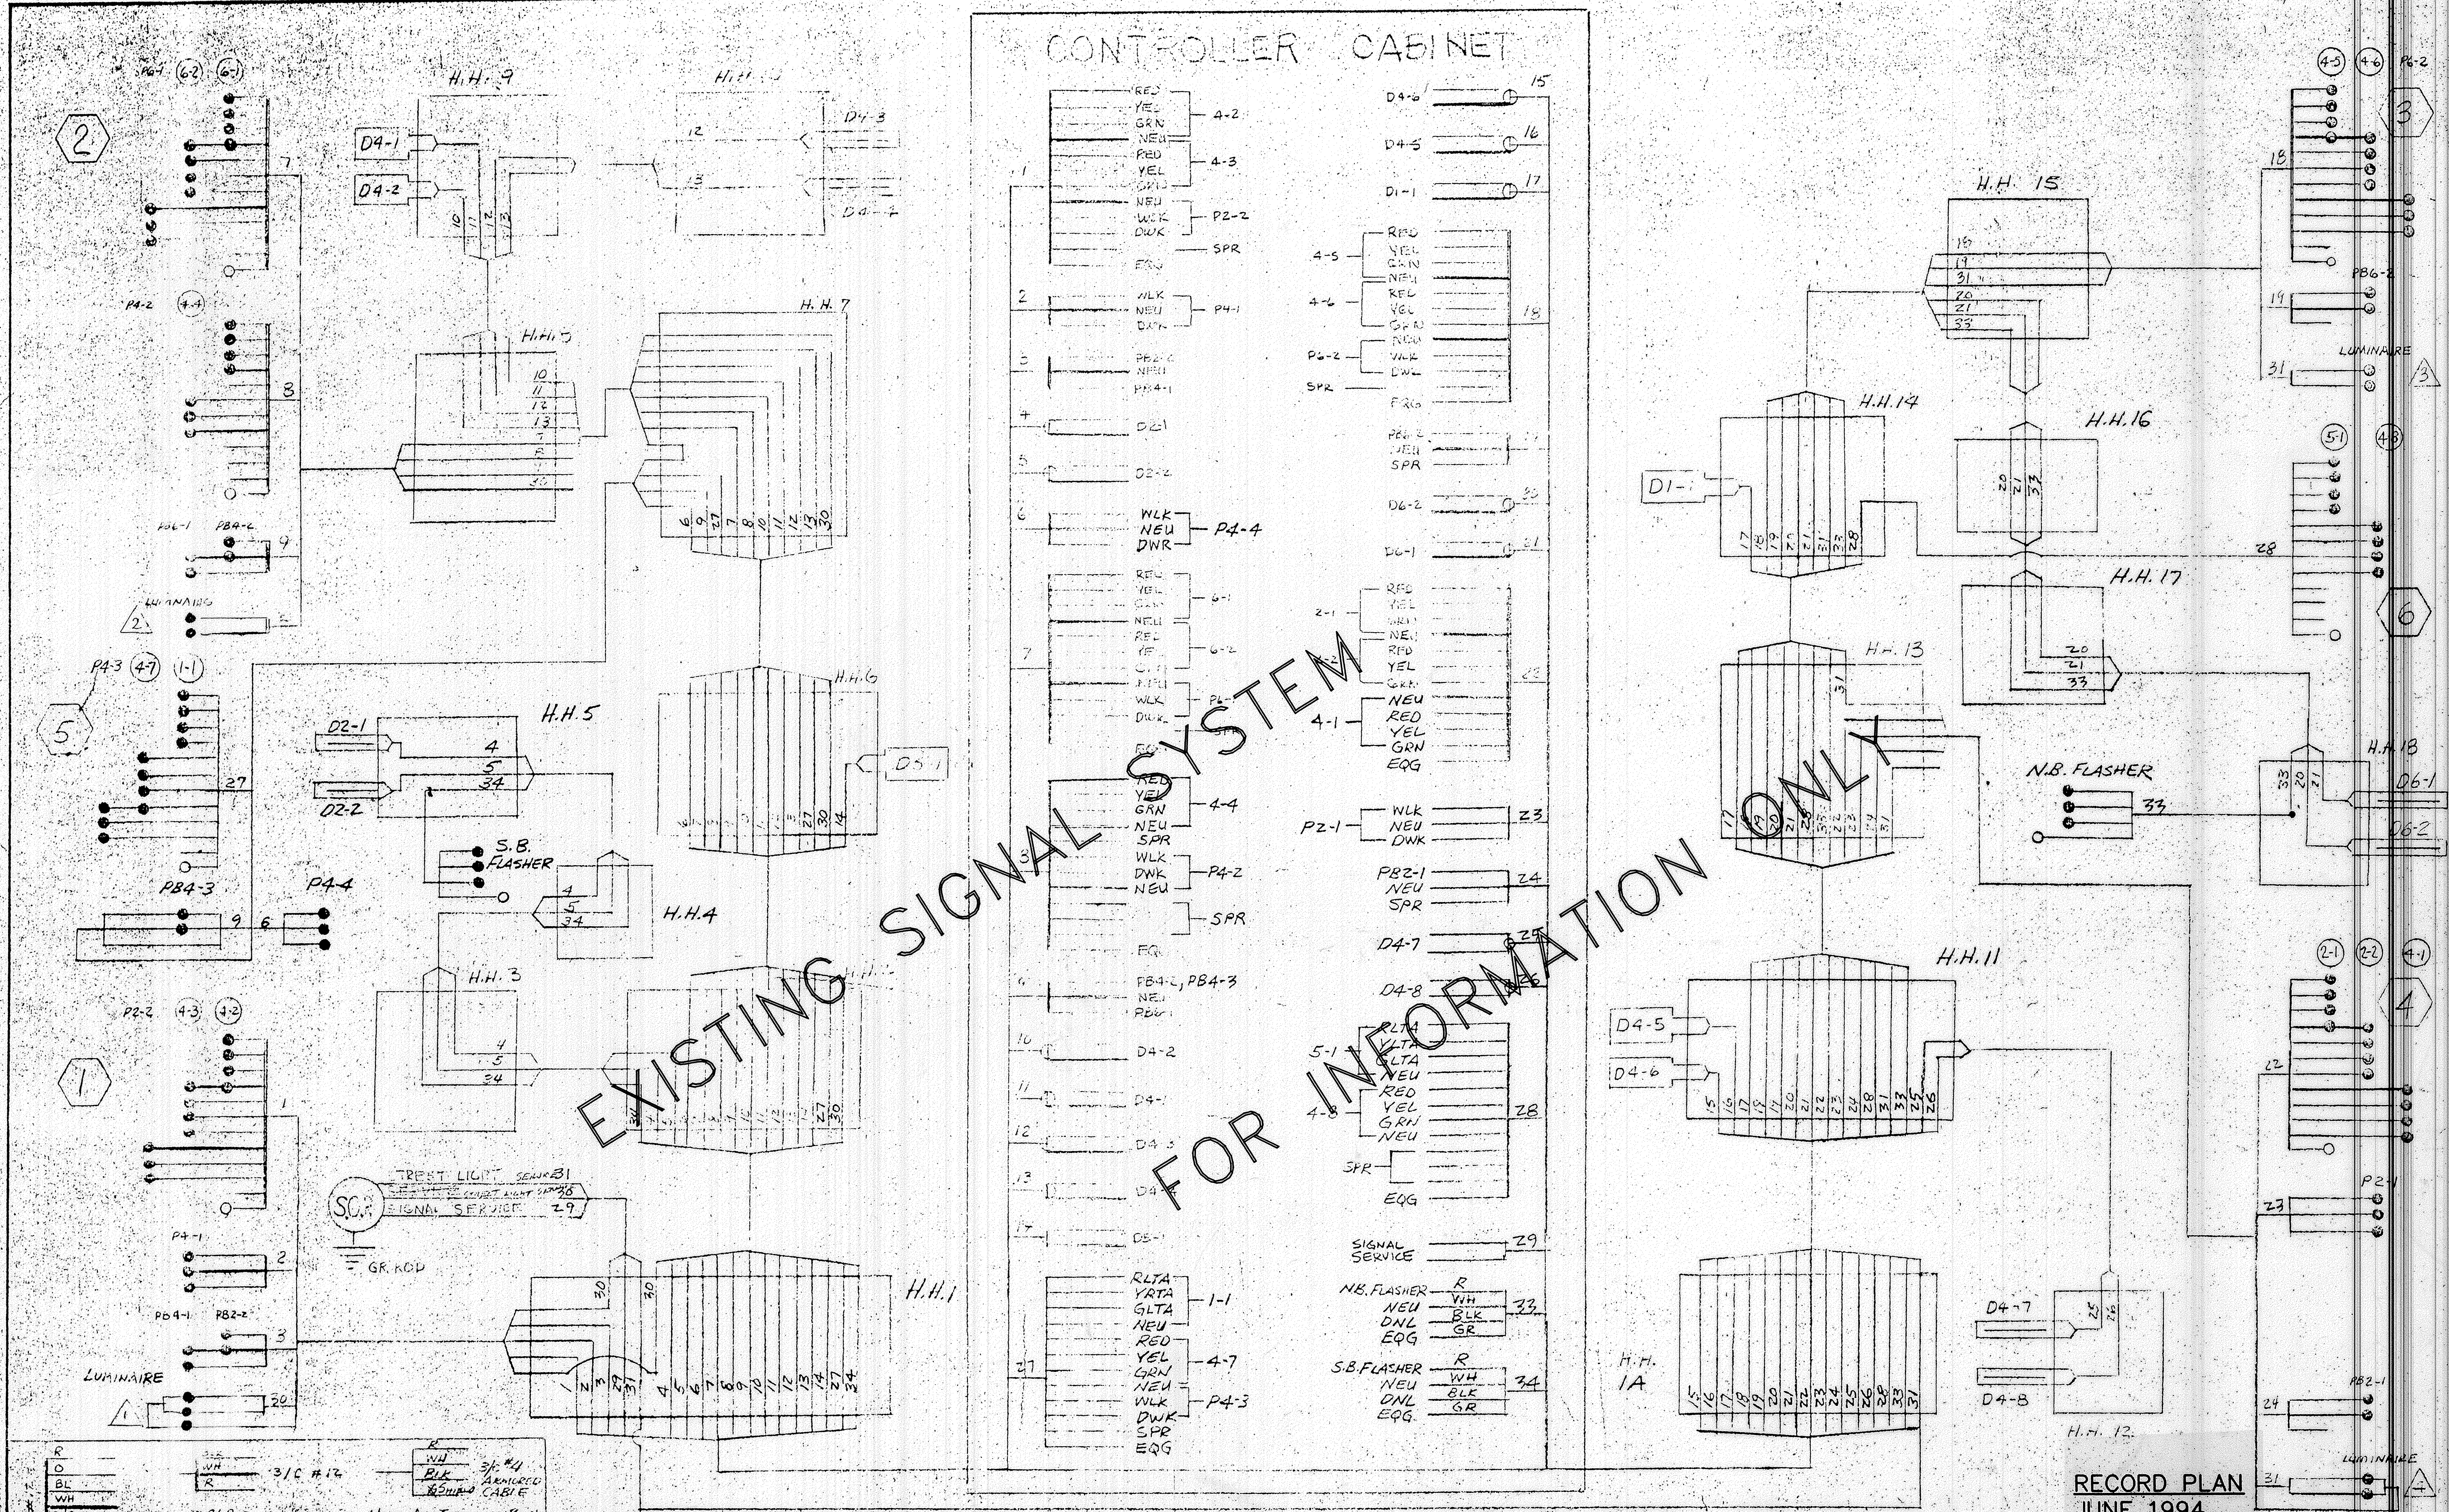

R	3/4 #12	WH	3/4 #14
D	3/4 #12	BLK	3/4 #14
BL	3/4 #12	WH	3/4 #14
WH	3/4 #12	BLK	3/4 #14
R/BLK	3/4 #12	WH	3/4 #14
O/BLK	3/4 #12	BLK	3/4 #14
BL/BLK	3/4 #12	WH	3/4 #14
WH/BLK	3/4 #12	BLK	3/4 #14
BLK/WH	3/4 #12	WH	3/4 #14
G/BLK	3/4 #12	BLK	3/4 #14
G	3/4 #12	WH	3/4 #14

NOTE: ALL TERMINAL BLOCK CONNECTIONS SHALL BE ARRANGED AS SPECIFIED.

TYPICAL CONDUCTOR COLOR CODE

RECORD PLAN
JUNE 1994

CITY OF ELK RIVER
FIELD WIRING DIAGRAM

DESIGNED BY: [Signature]

CHECKED BY: [Signature]

DRAWN BY: [Signature]

DATE: 10/17/83

MINN. REG. NO. 12651

CONSULTING ENGINEERS
diversified inc.

REVISIONS

NO.	DESCRIPTION
1	AS SHOWN

GRAPHIC SCALE

0' HORIZ

0' VERT

DATE: 5/26/83

SHEET: 12A OF 17

FILE NO: 963