
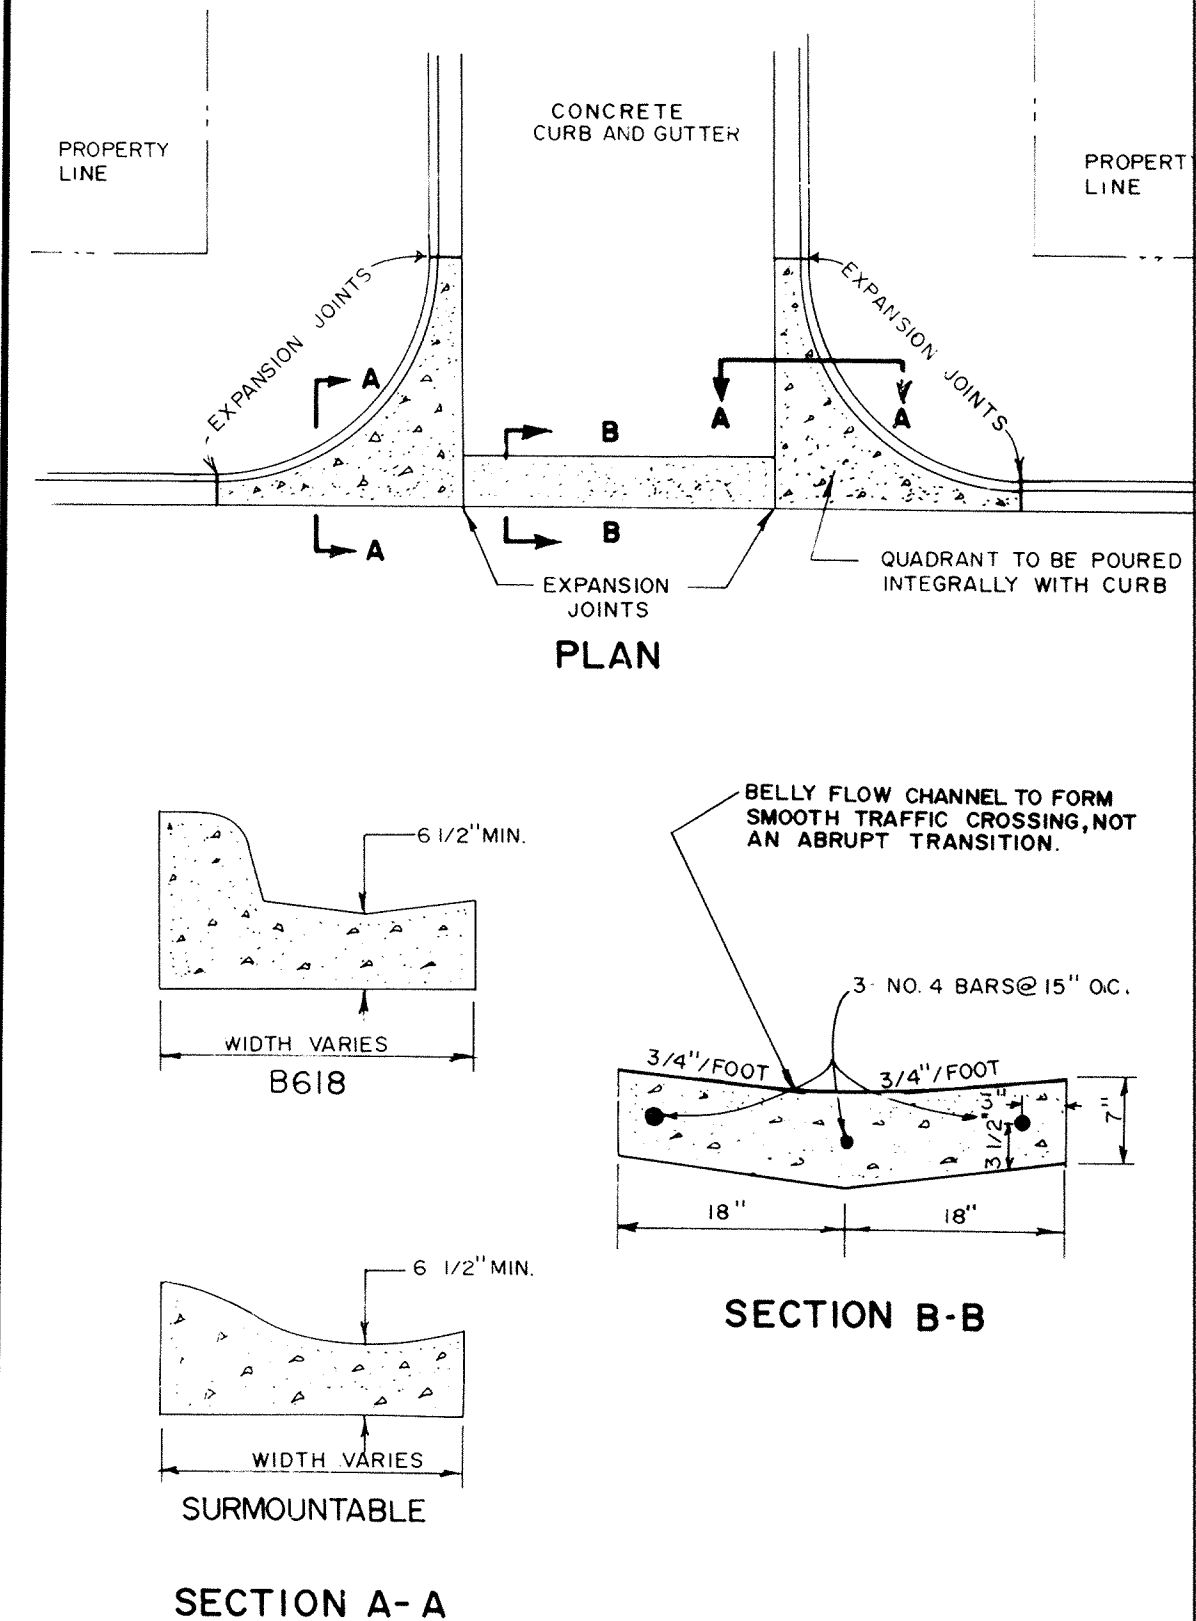
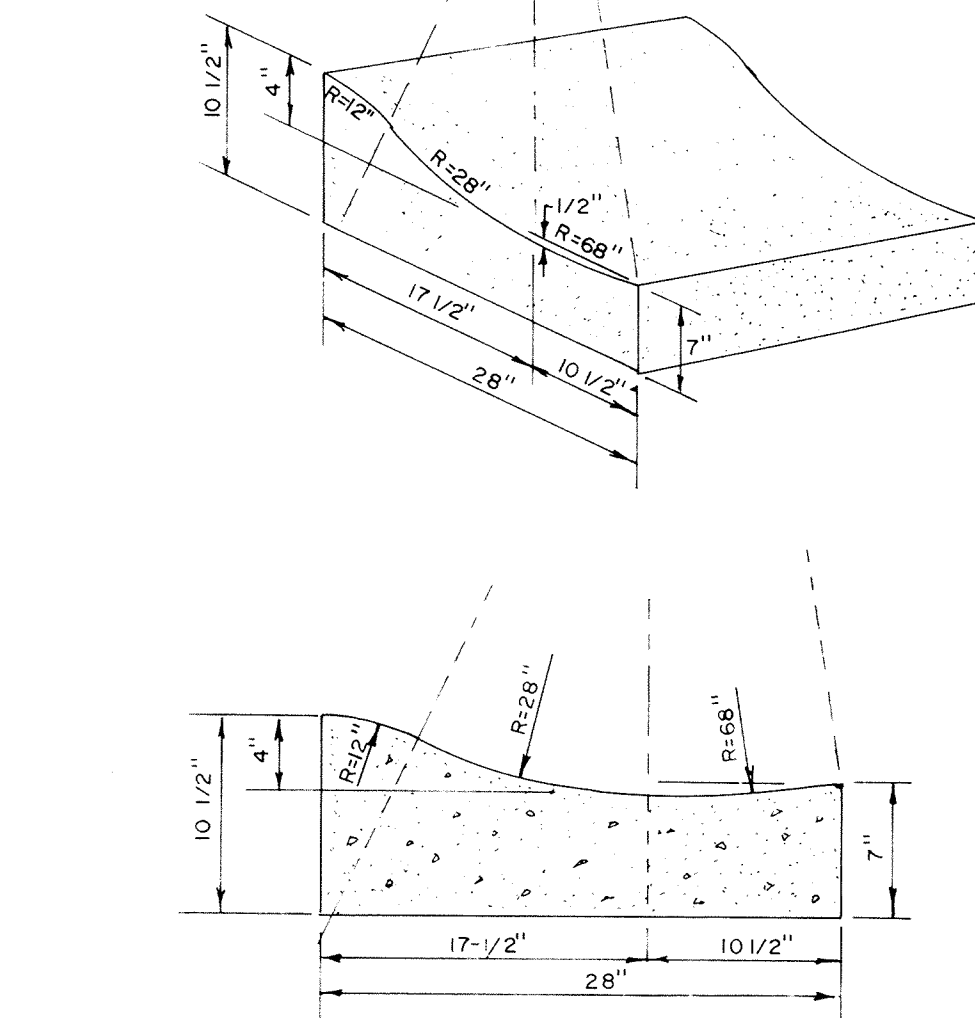
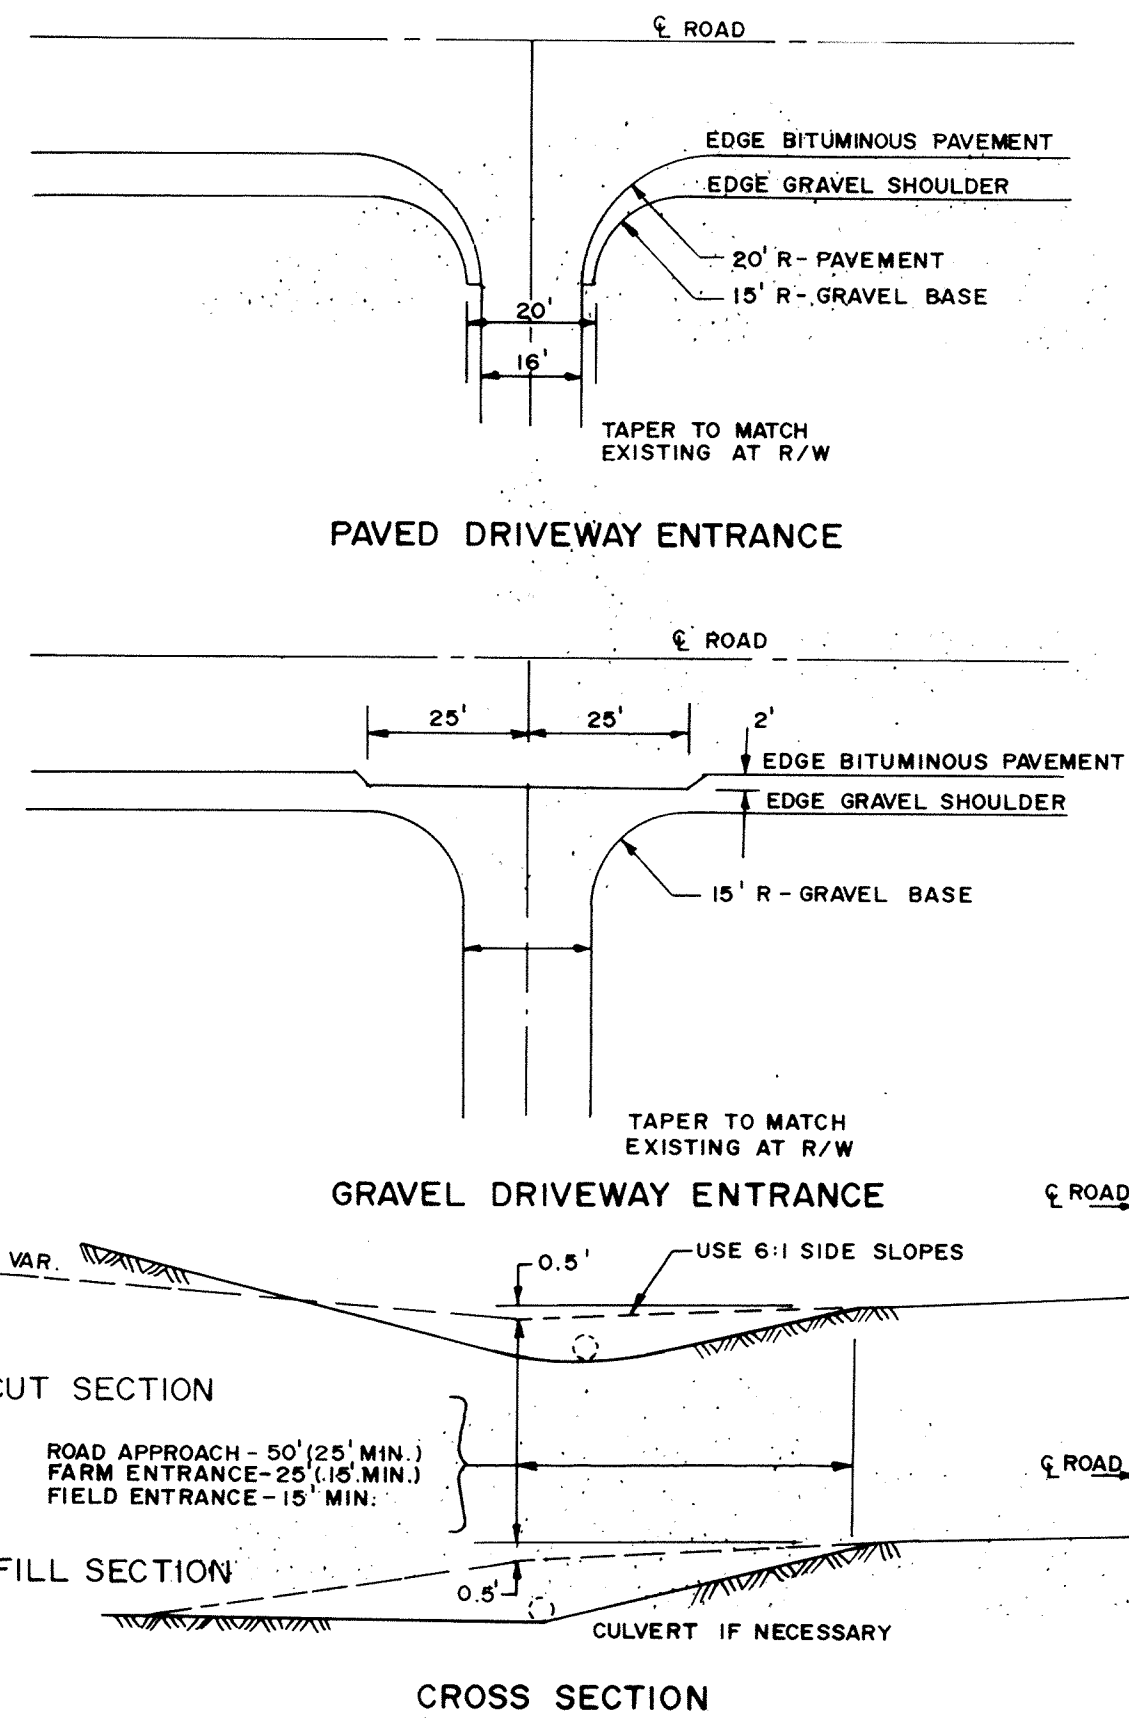
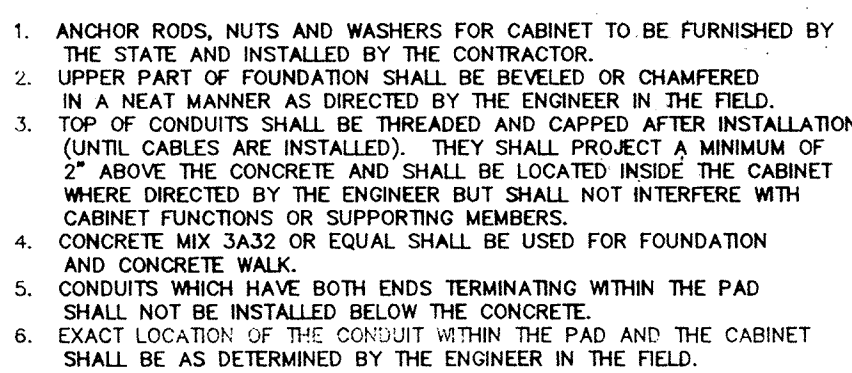
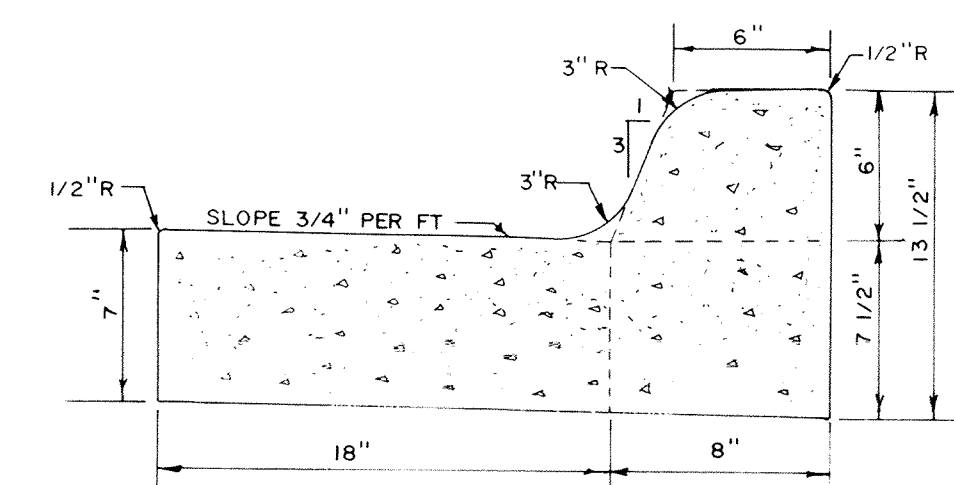
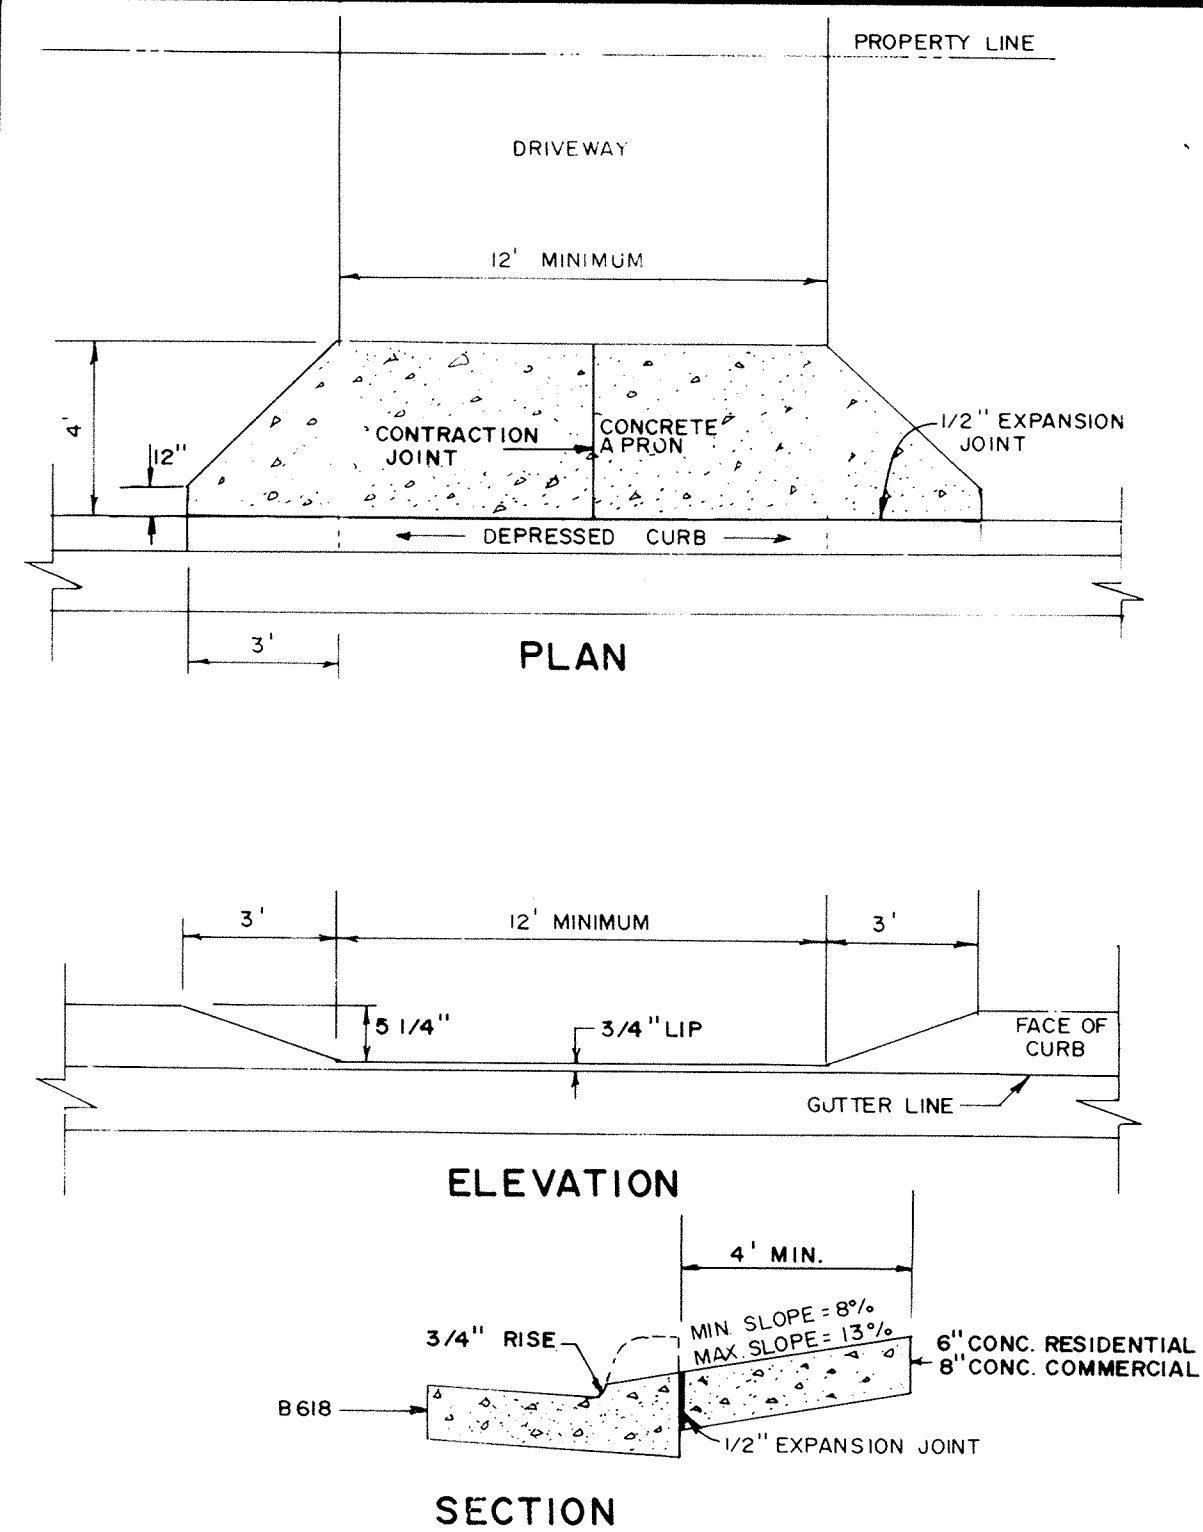
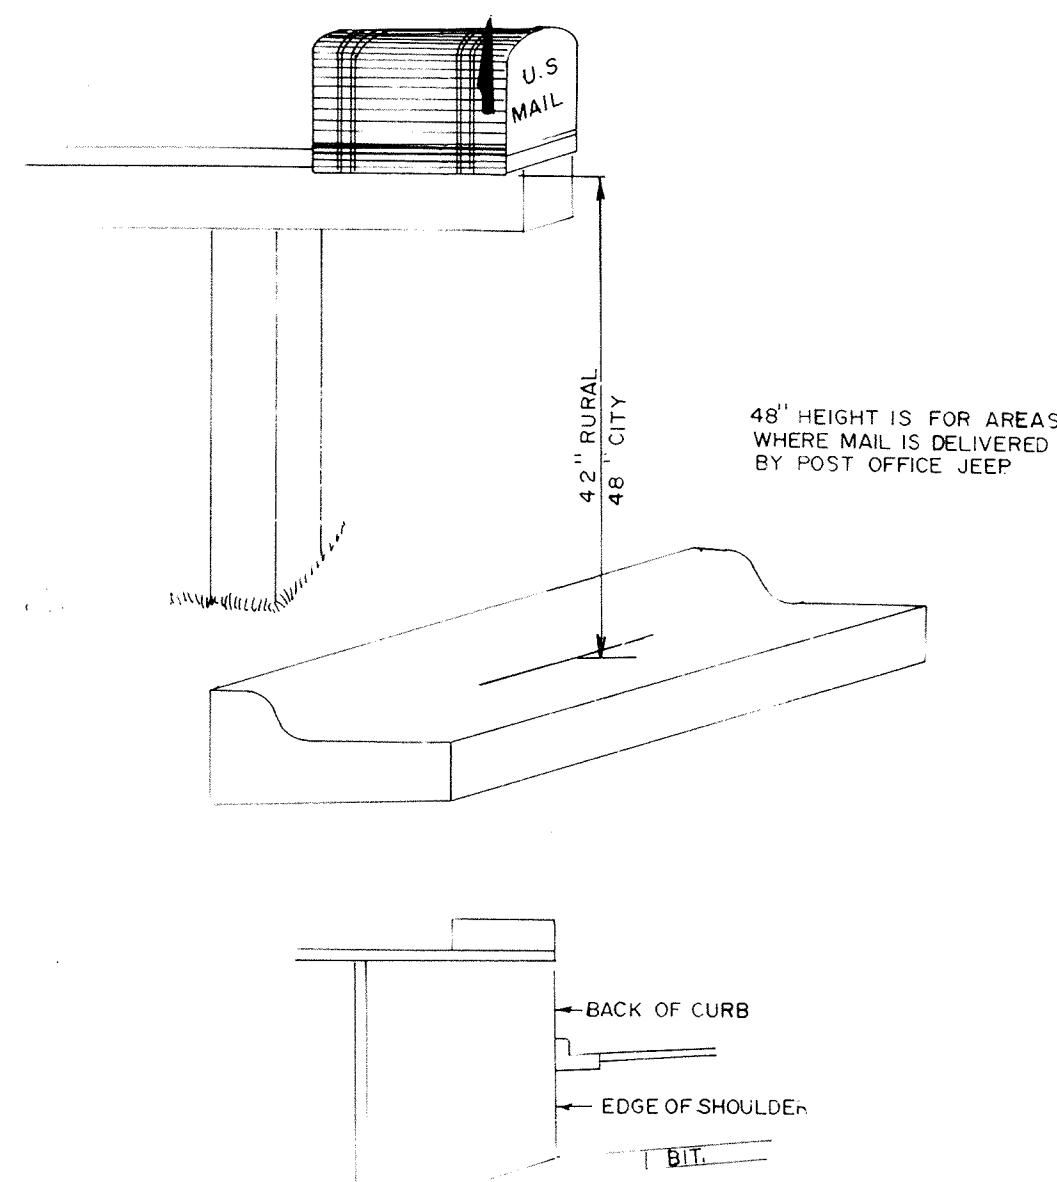


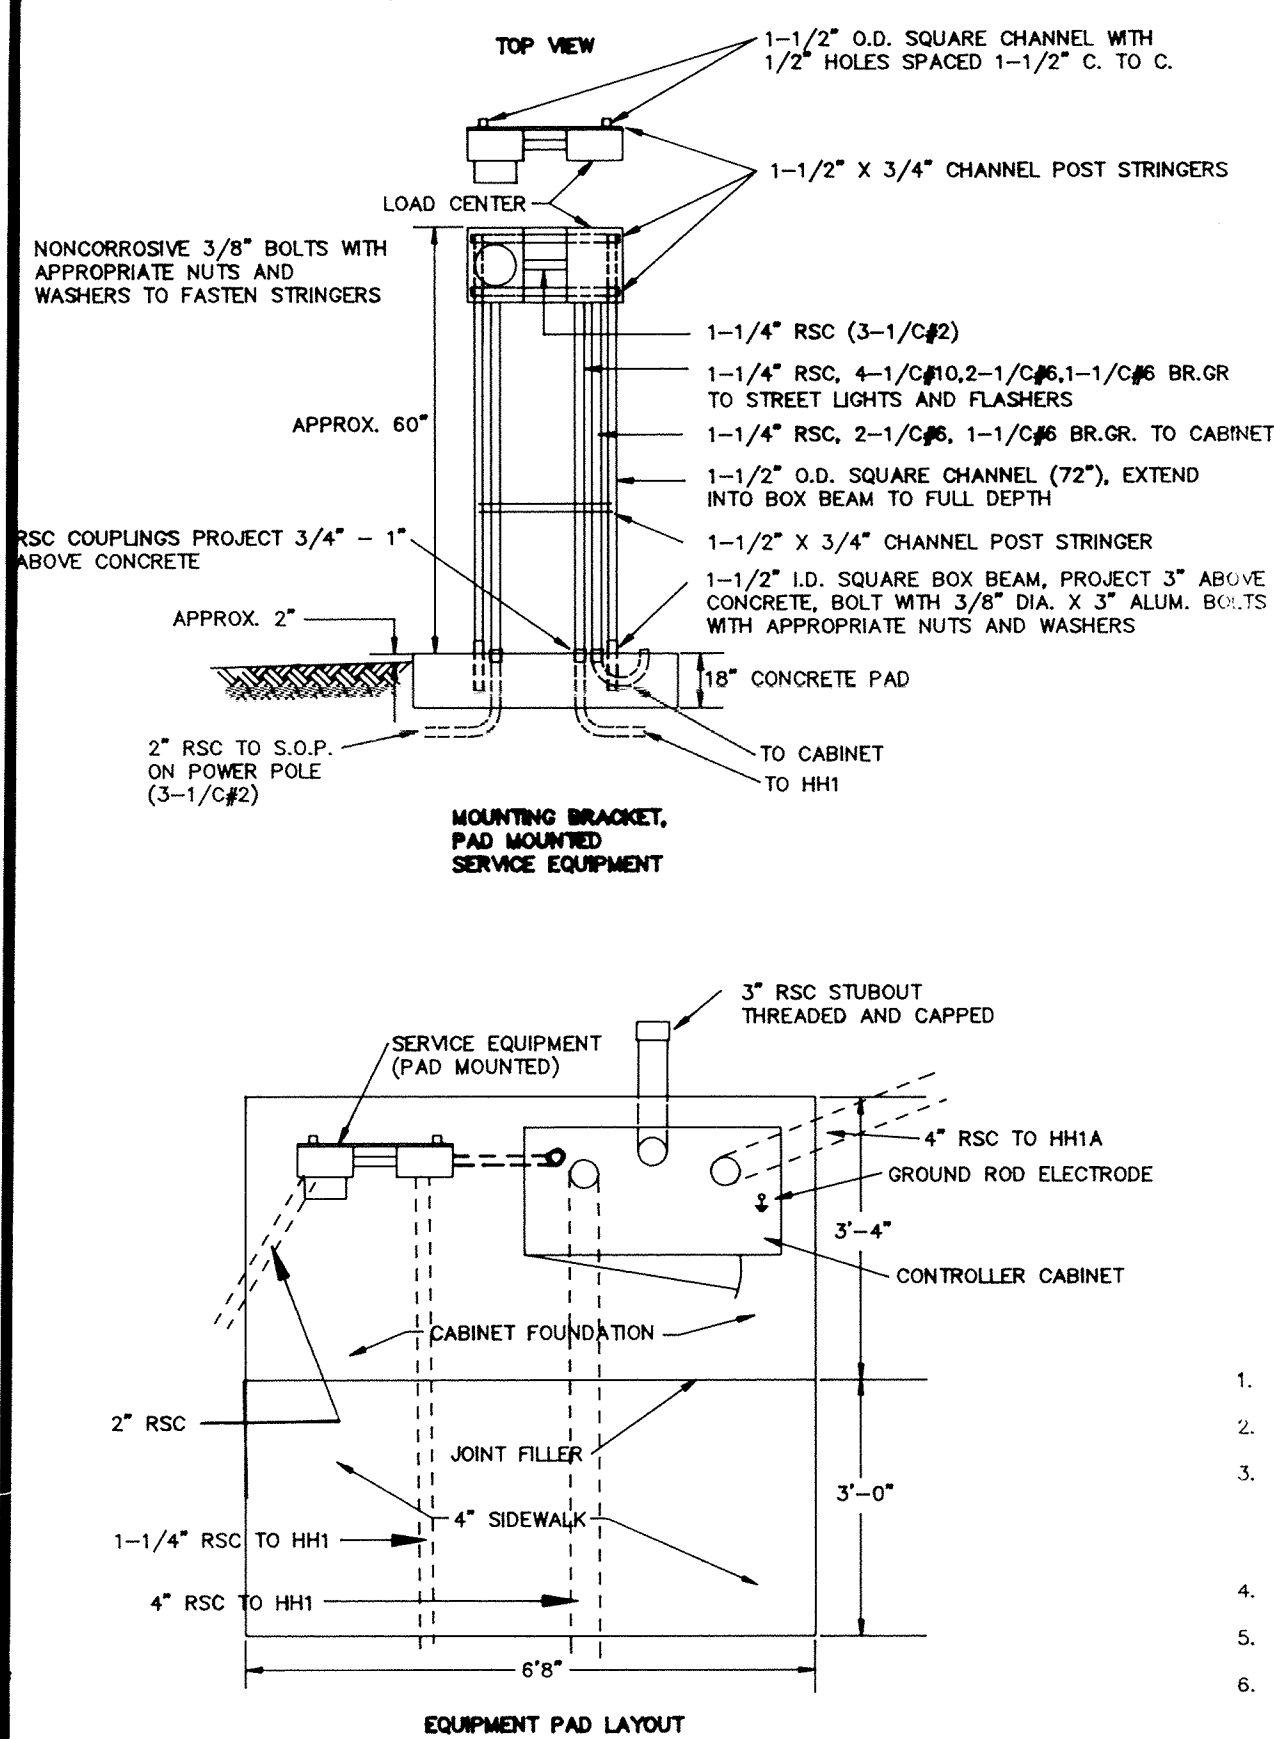

RECORD PLAN
JUNE 1994

لغة

CONSULTING ENGINEERS
Maier Stewart & Associates Inc.

1959 SLOAN PLACE (612) 774-6021 ST. PAUL, MINNESOTA 55117

REVISIONS	DATE	DESCRIPTION	DESIGNED <u>PEB</u>
			CHECKED <u>MEI</u>
			DRAWN <u>MR</u>
			GRAPHIC SCALE
			0 <u> </u> HORIZ. <u>NON</u>
			0 <u> </u> VERT. <u> </u>

CITY OF ELK RIVER			
STREET CONSTRUCTION			
MAIN STREET AT TH 169			
S.A.P. 204-113-05			
STREET CONSTRUCTION DETAILS			
DATE	MARCH, 1991	SHEET	14 OF 17 SHEETS
PROJECT NO.		230-099	