



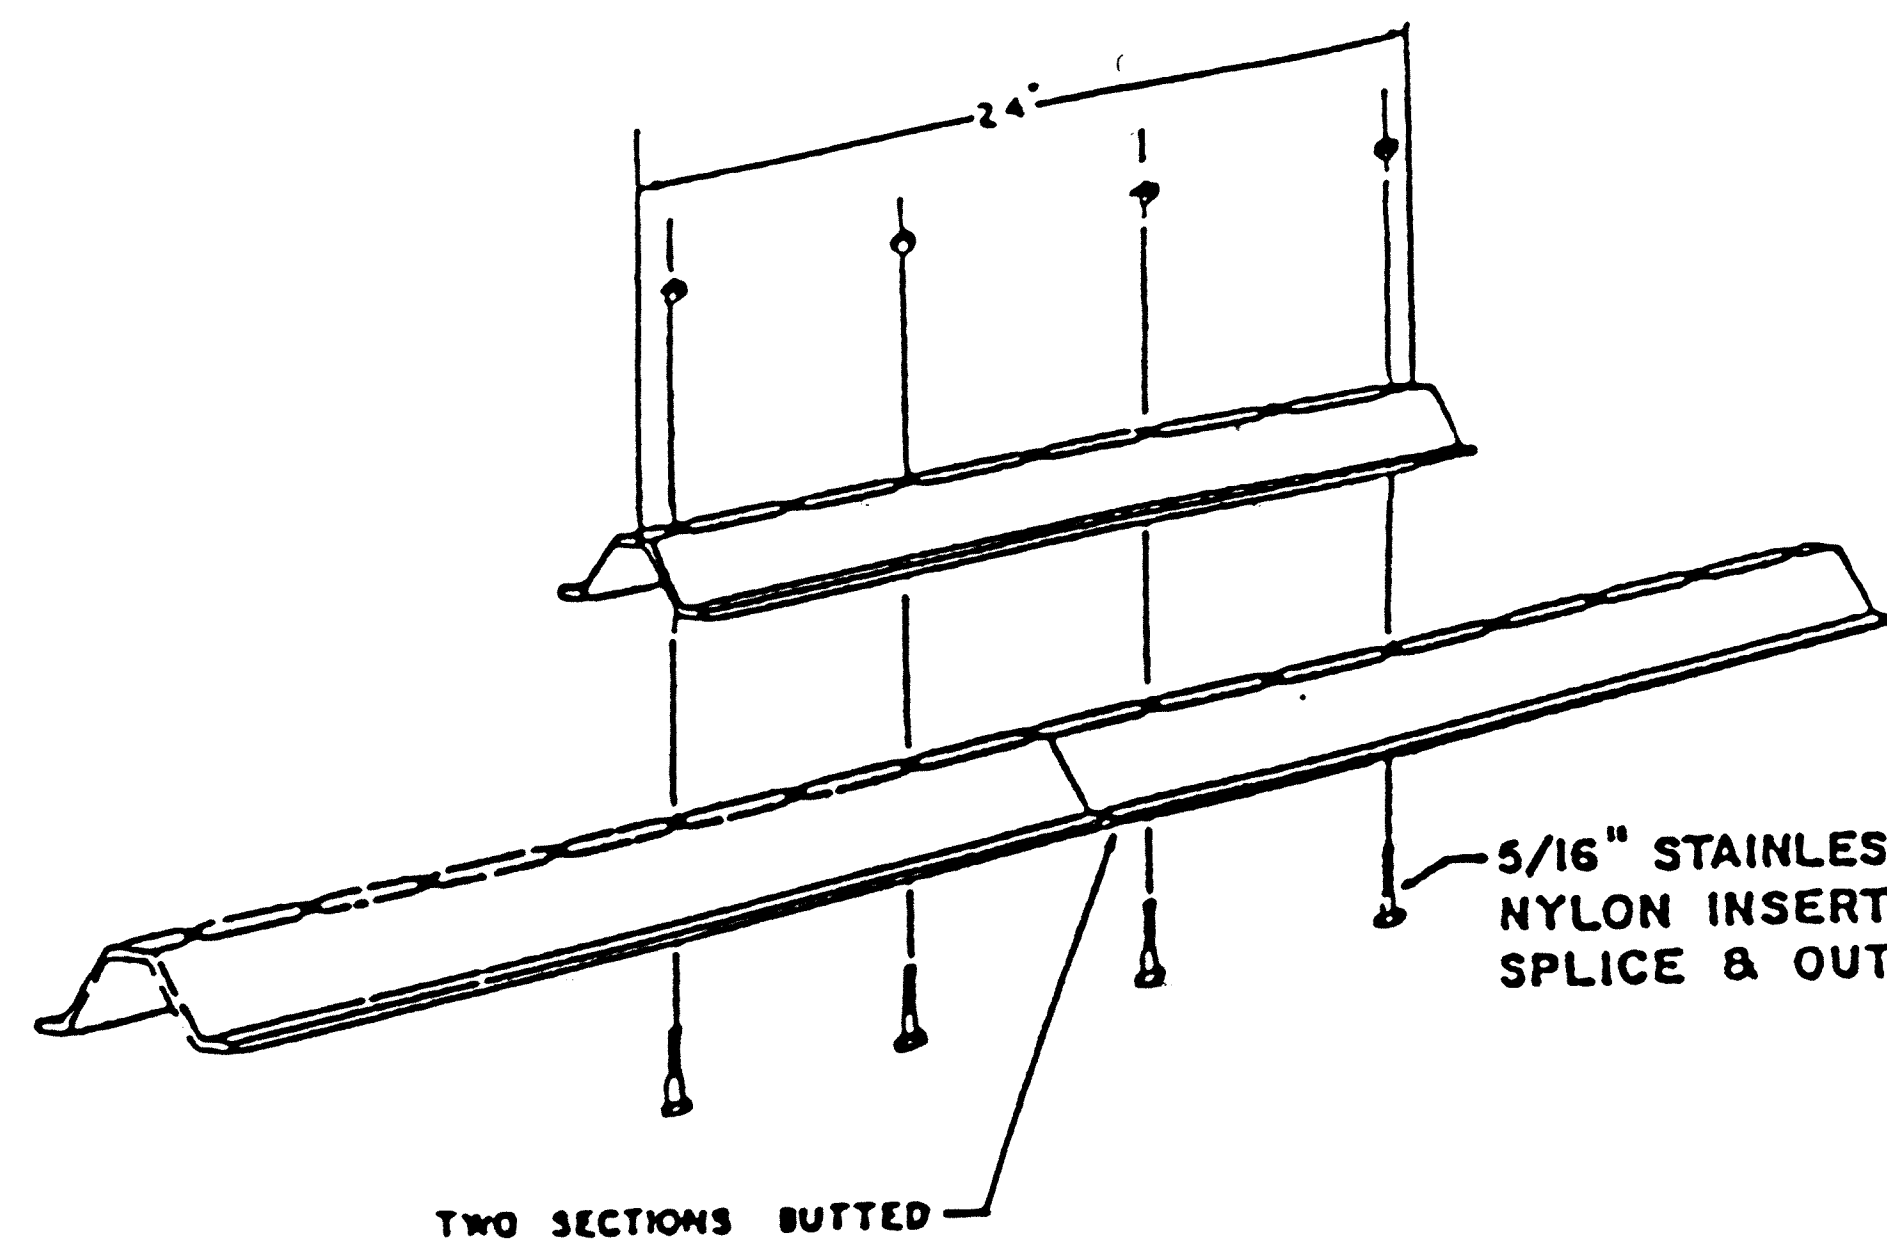


Lateral Brace or Stringer Splice Detail (Exploded View)

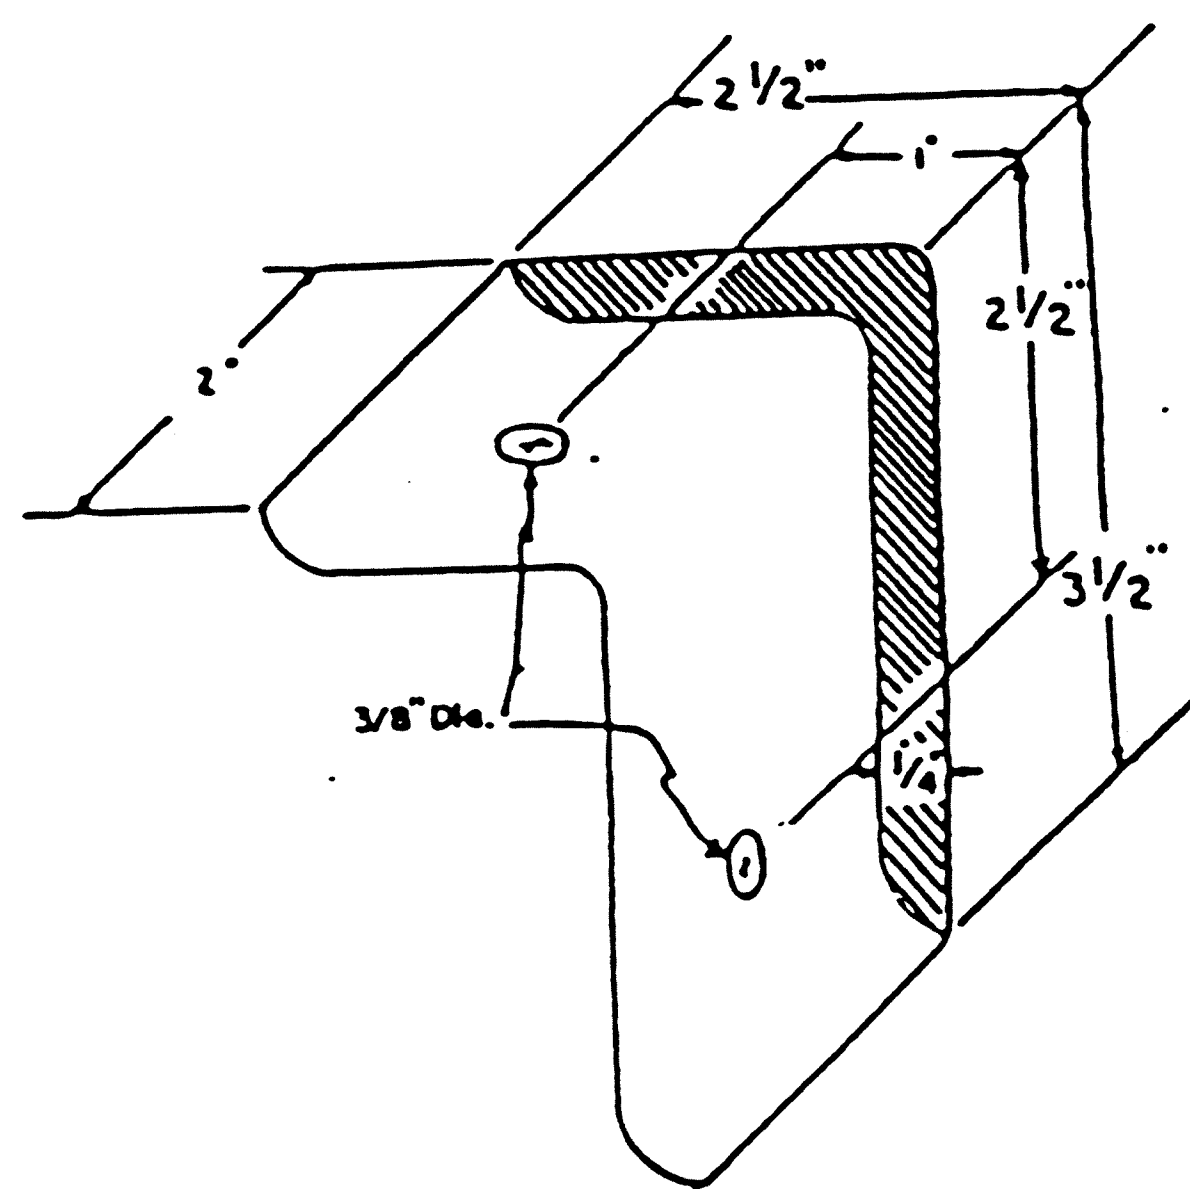


A-Frame Bracket

(Steel Mn/DOT 3306 galvanized per Mn/DOT 3394)

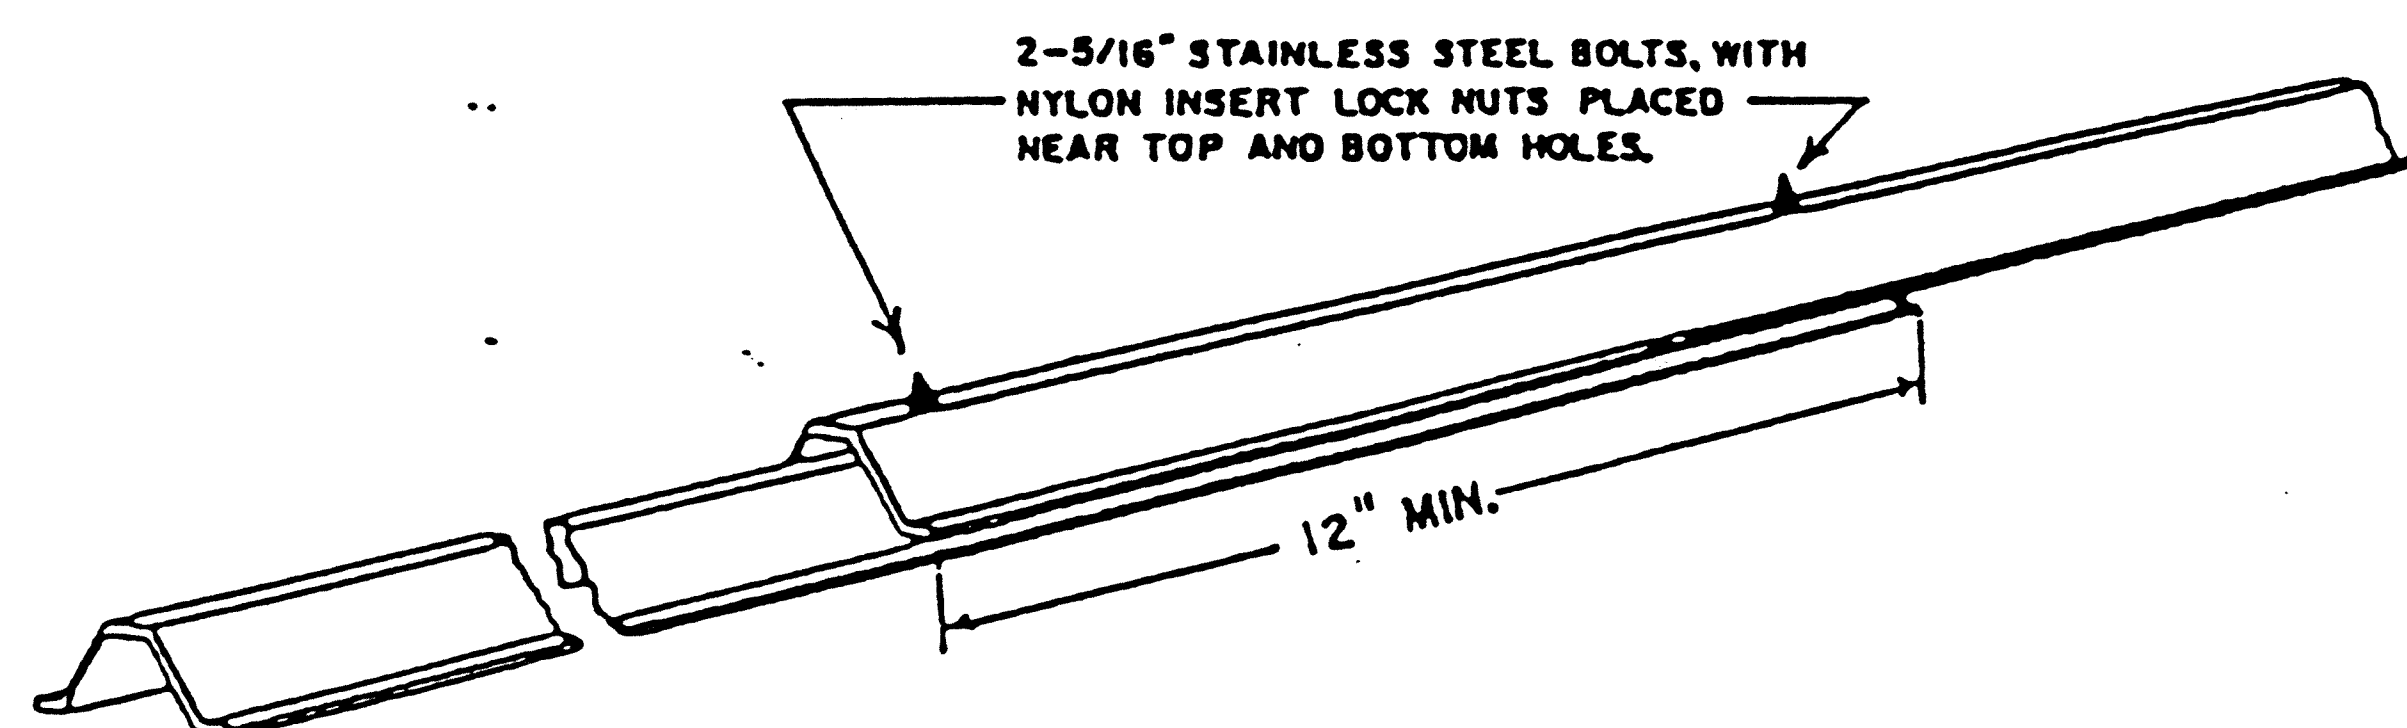


Knee Brace Splice


Rev. 3-23-90

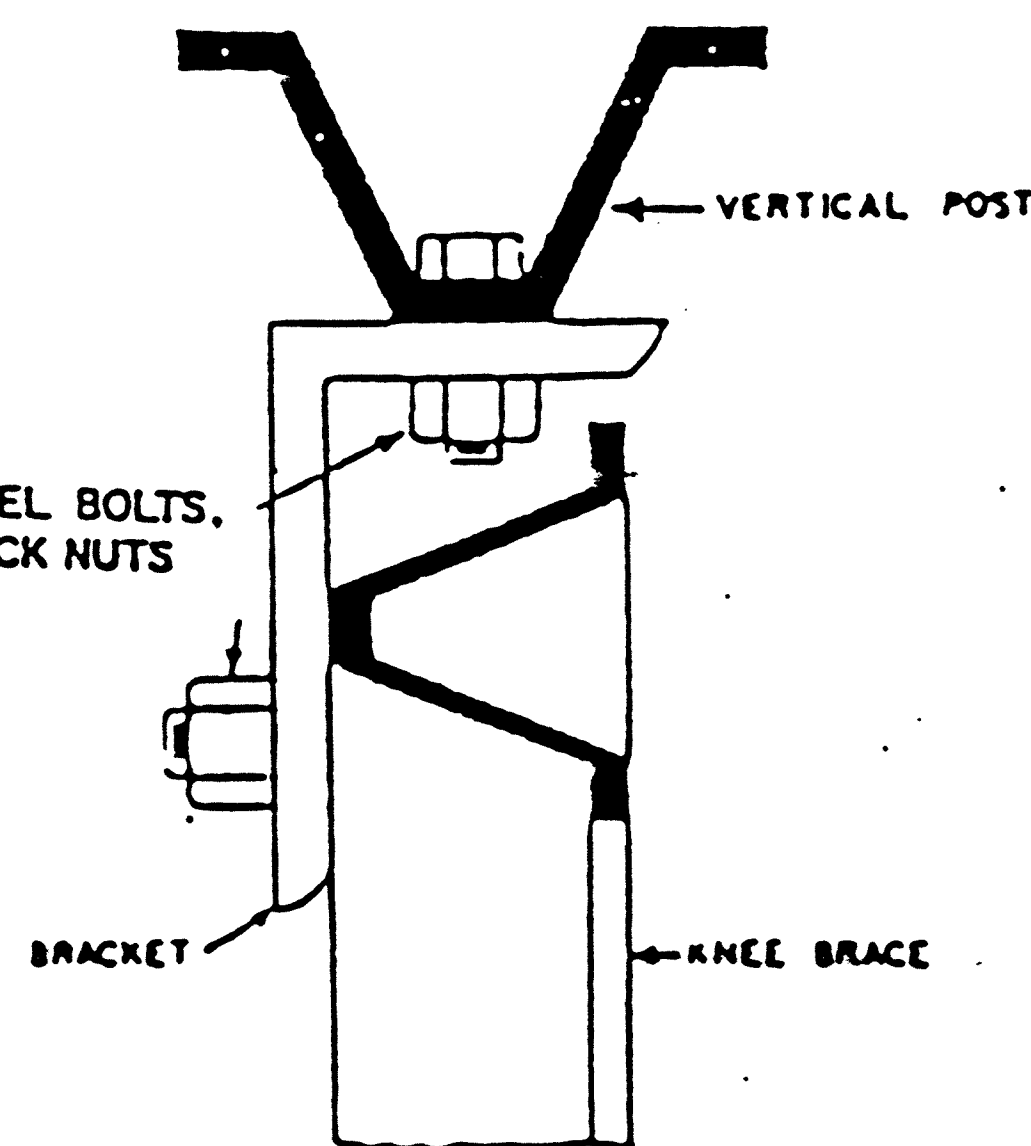

Section A-A

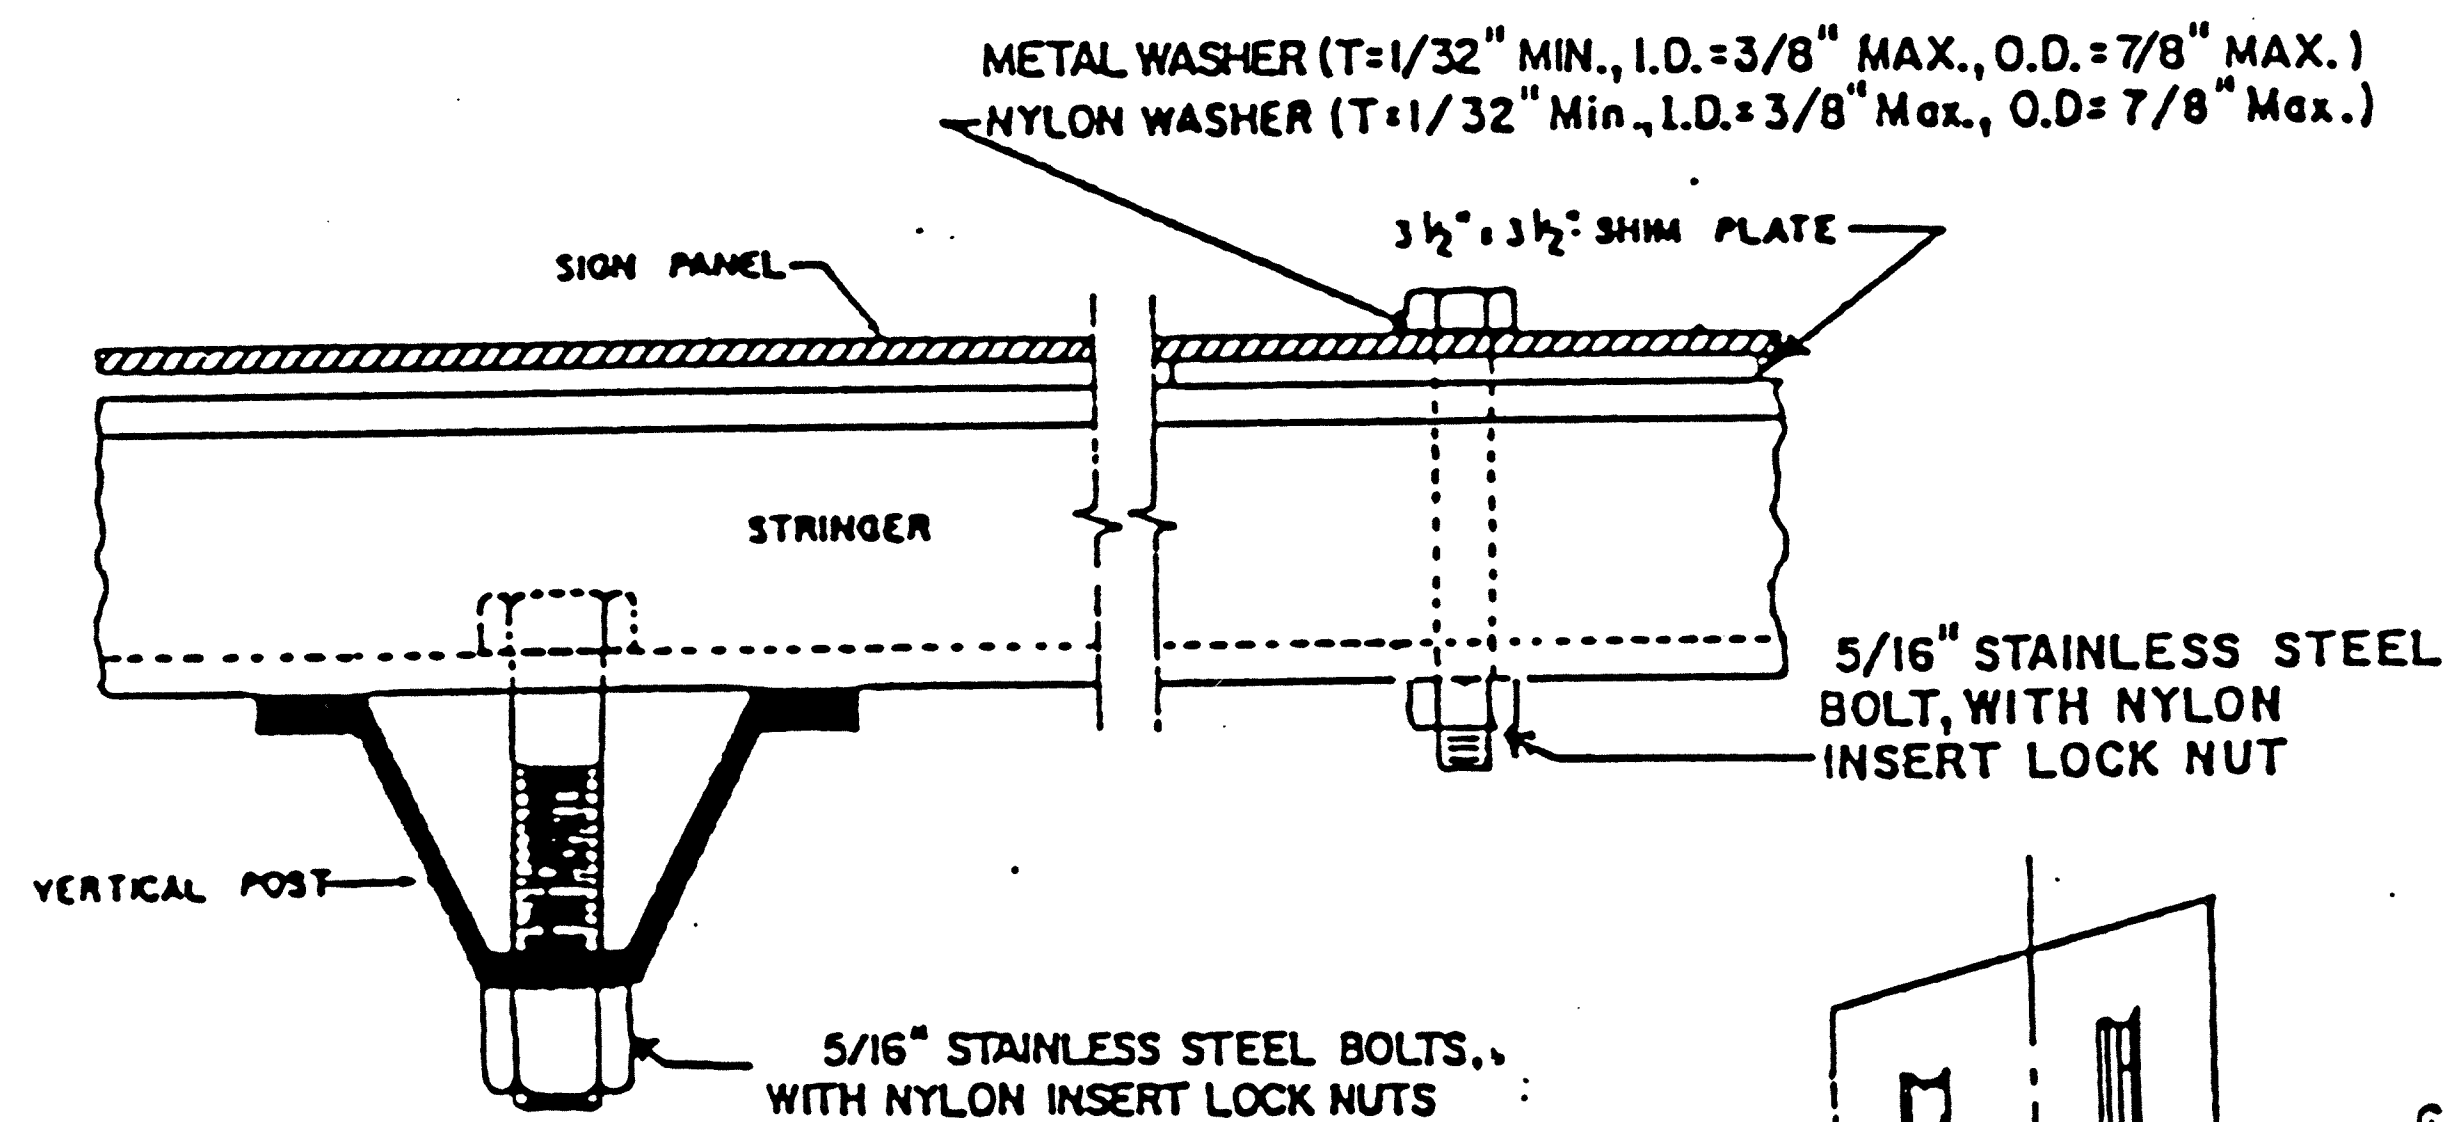


Section B-B

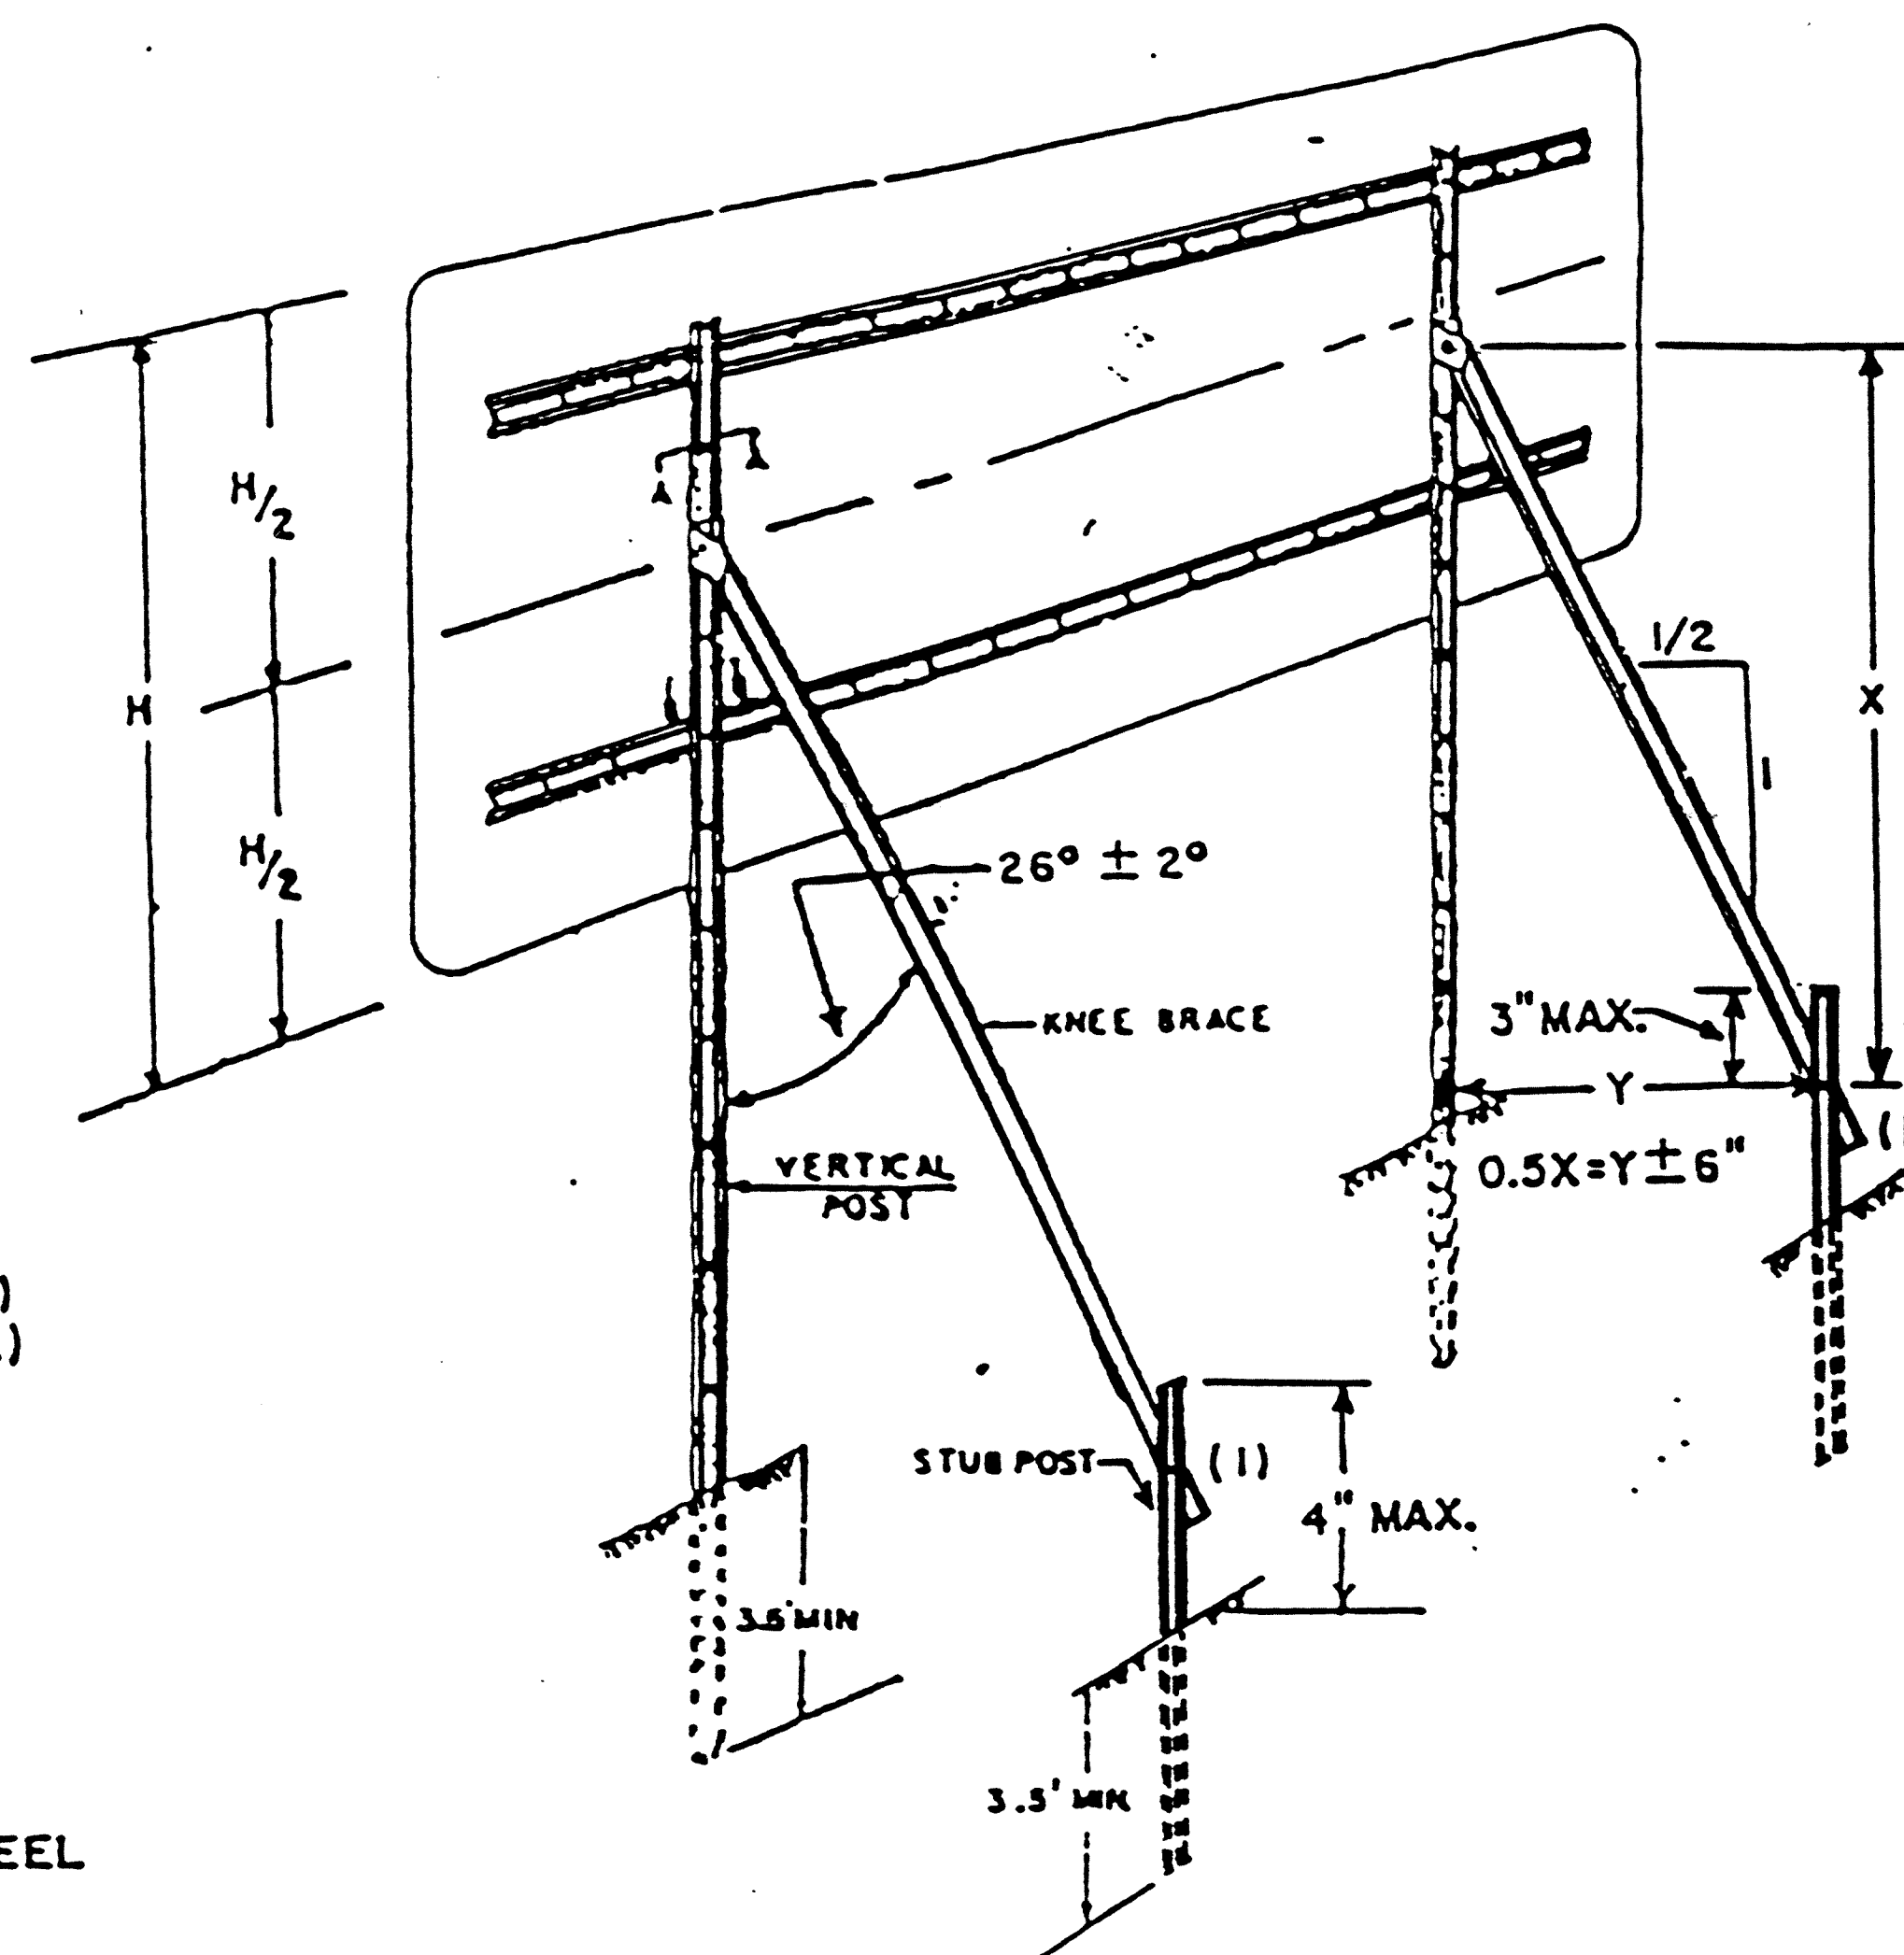

Typical "A-Frame" Installation

(1) Offset stub post 1' forward roadway relative to vertical post.

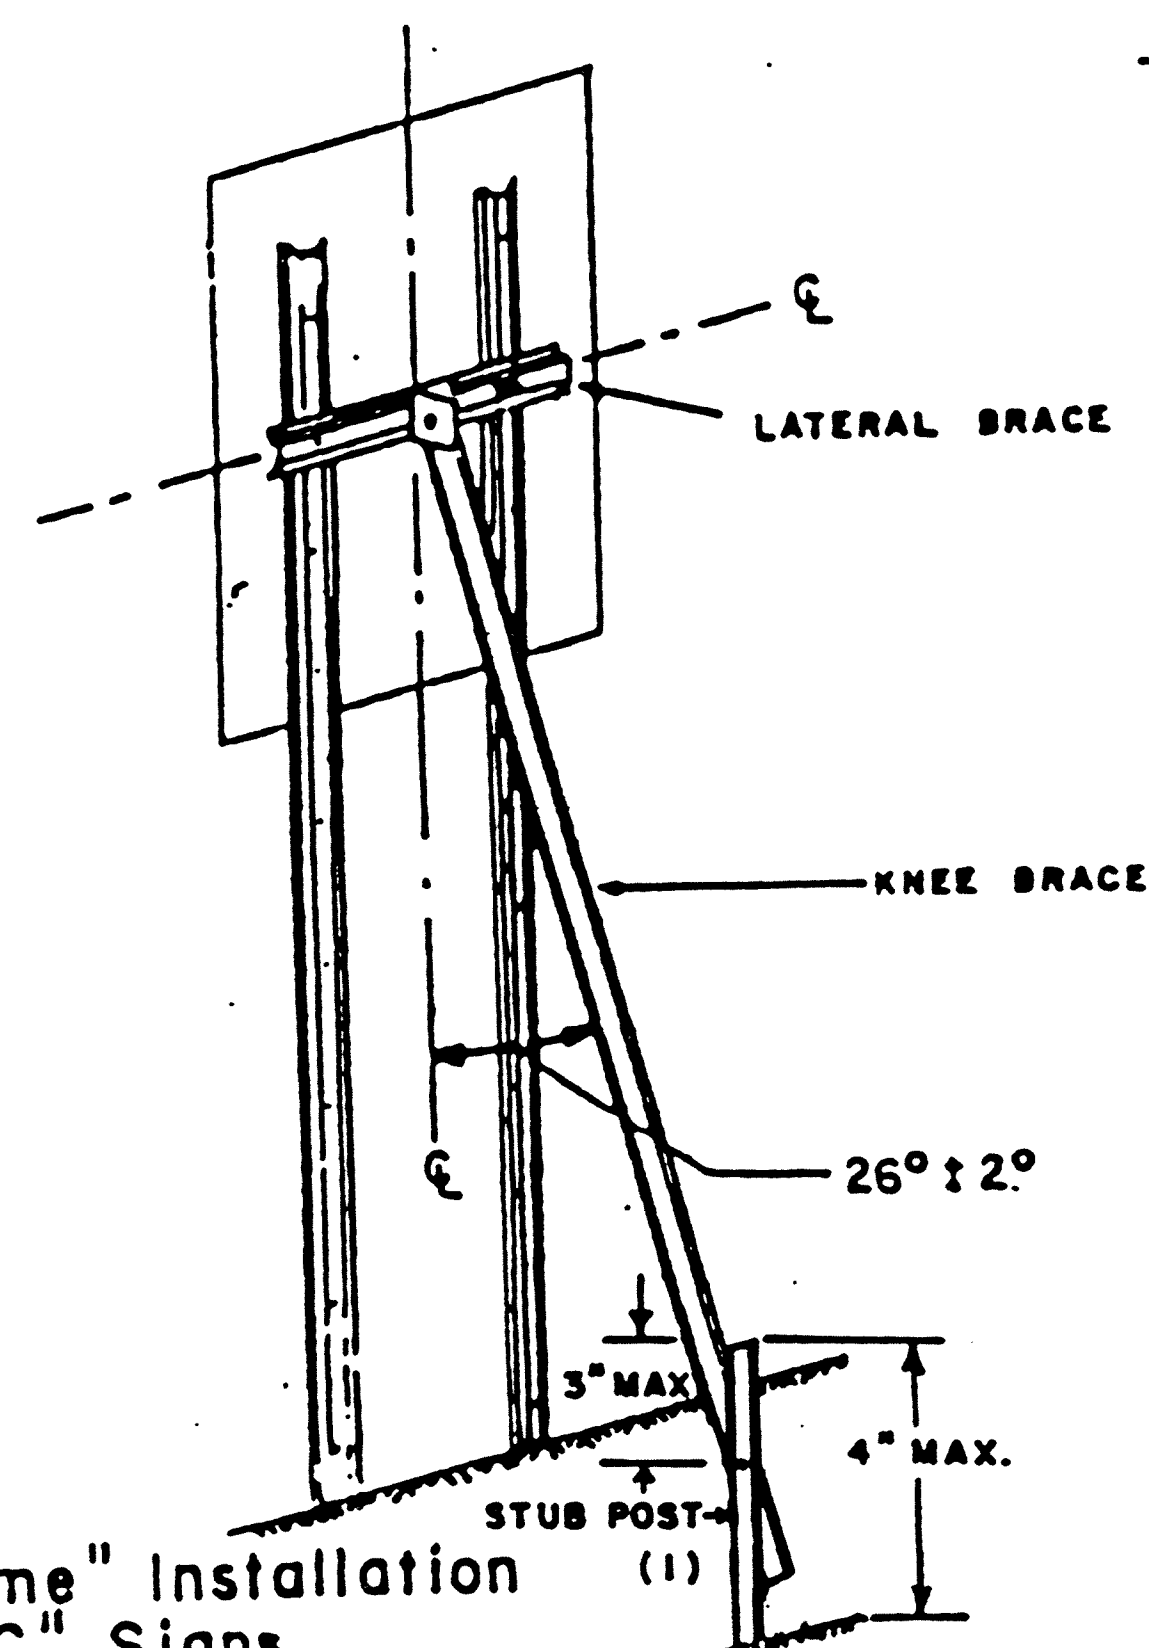

Typical "A-Frame" Installation
Type "C" Signs

"C" & "D" SIGN DETAILS

DESIGN A
Sheet 2 of 3

RECORD PLAN
JUNE 1994

State Proj. No. S.A.P. 204-113-05

Sheet No. 16 of 17 Sheets