




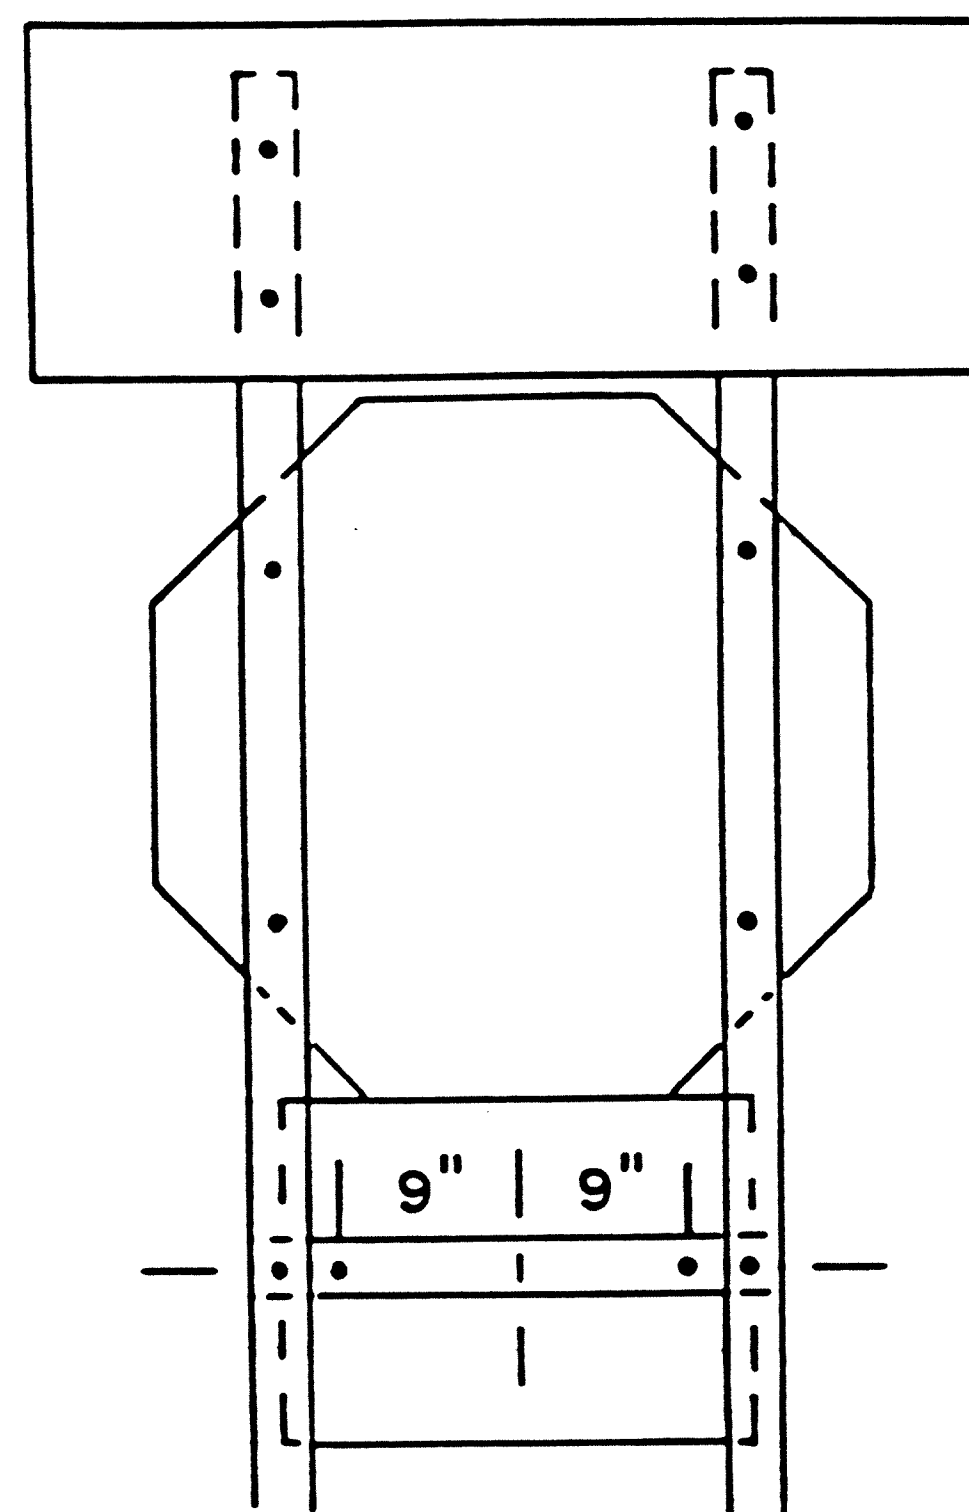


R6-1, R1-1 & (X1-6, R6-3 or R6-3a)
Mounting

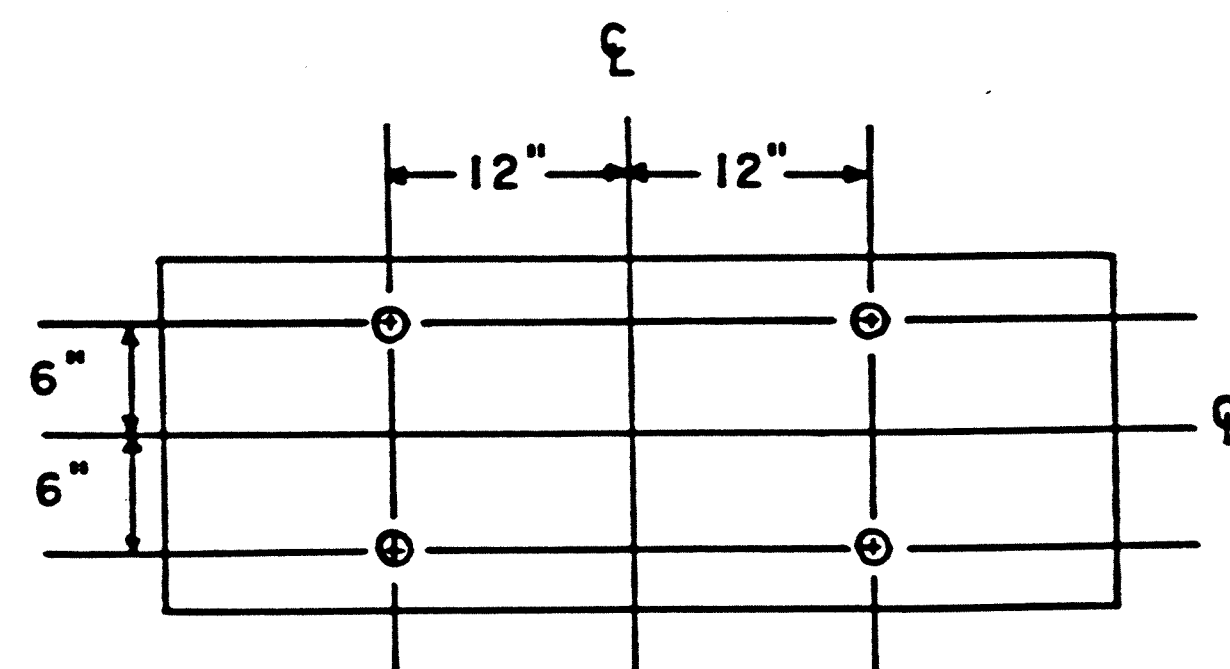


Punching for R6-1 (48" x 18")

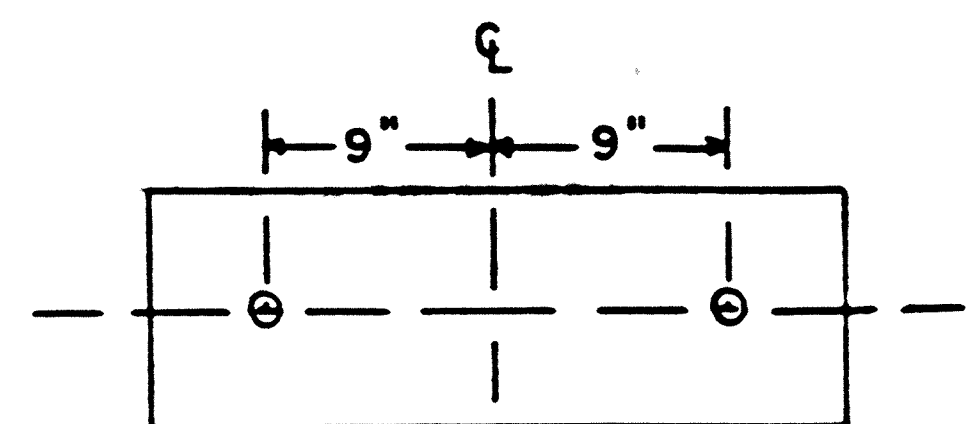


Punching for R6-1 (36" x 12")

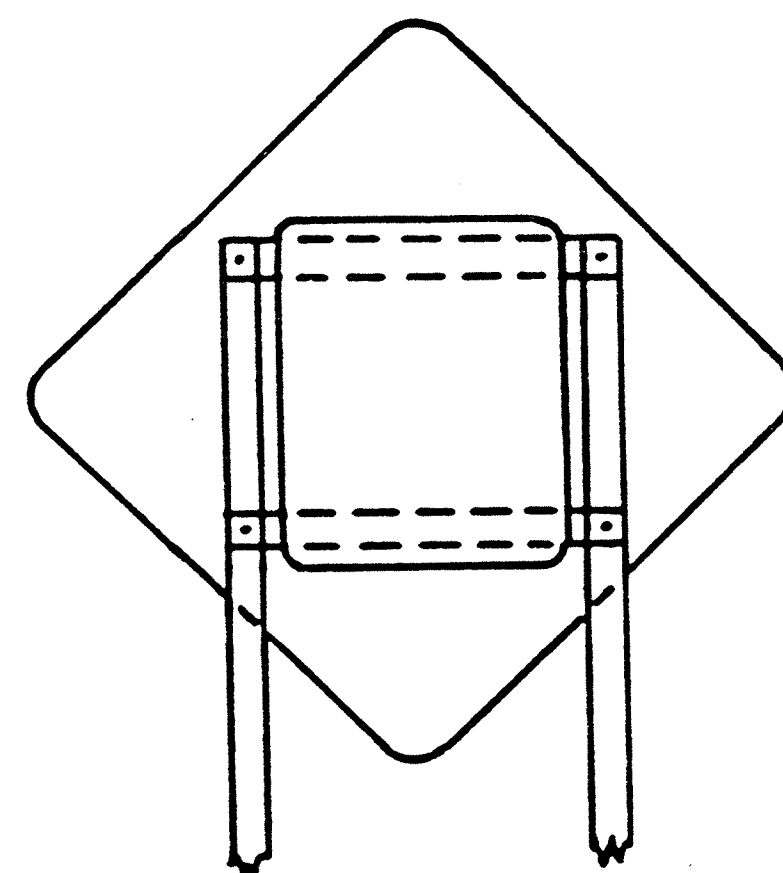


Back to back mounting
of R4-7 and W9-2.

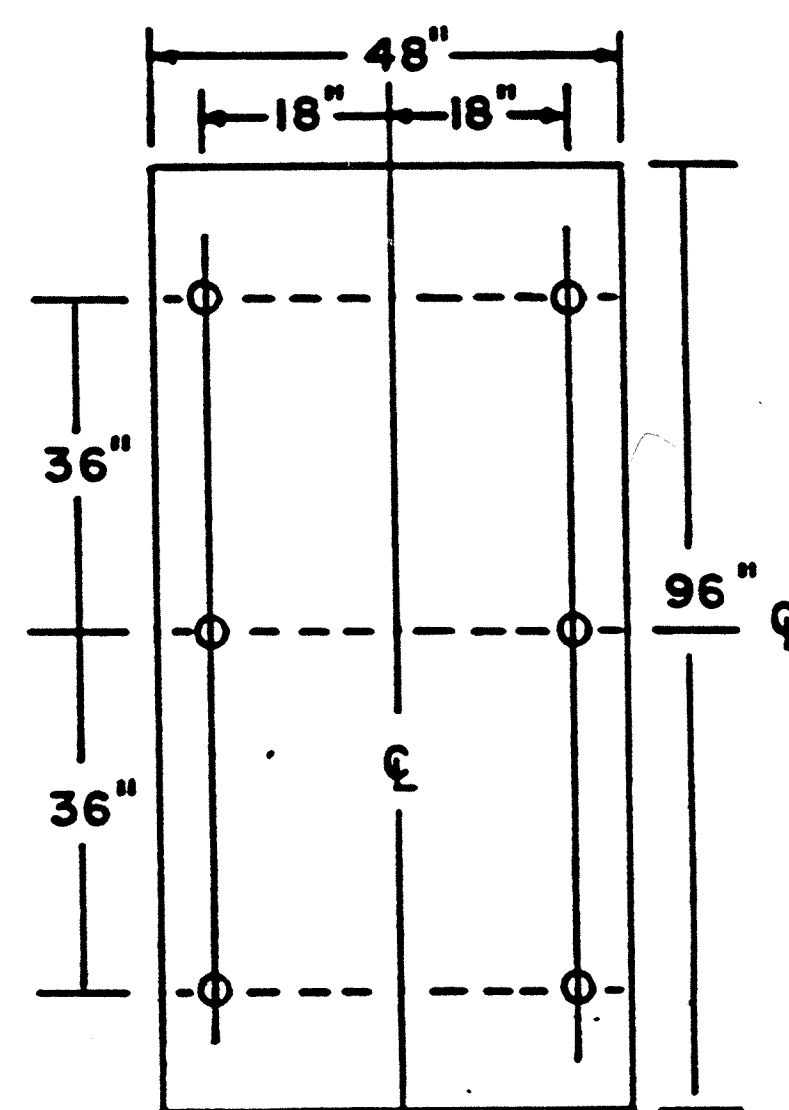

Punching for R2-4a
SPEED LIMIT

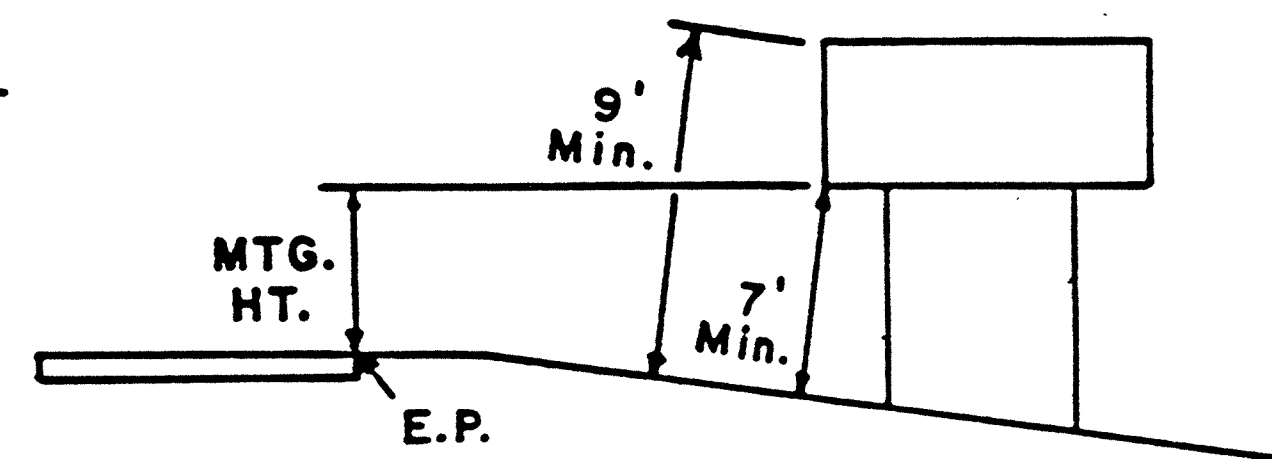

Typical Mounting




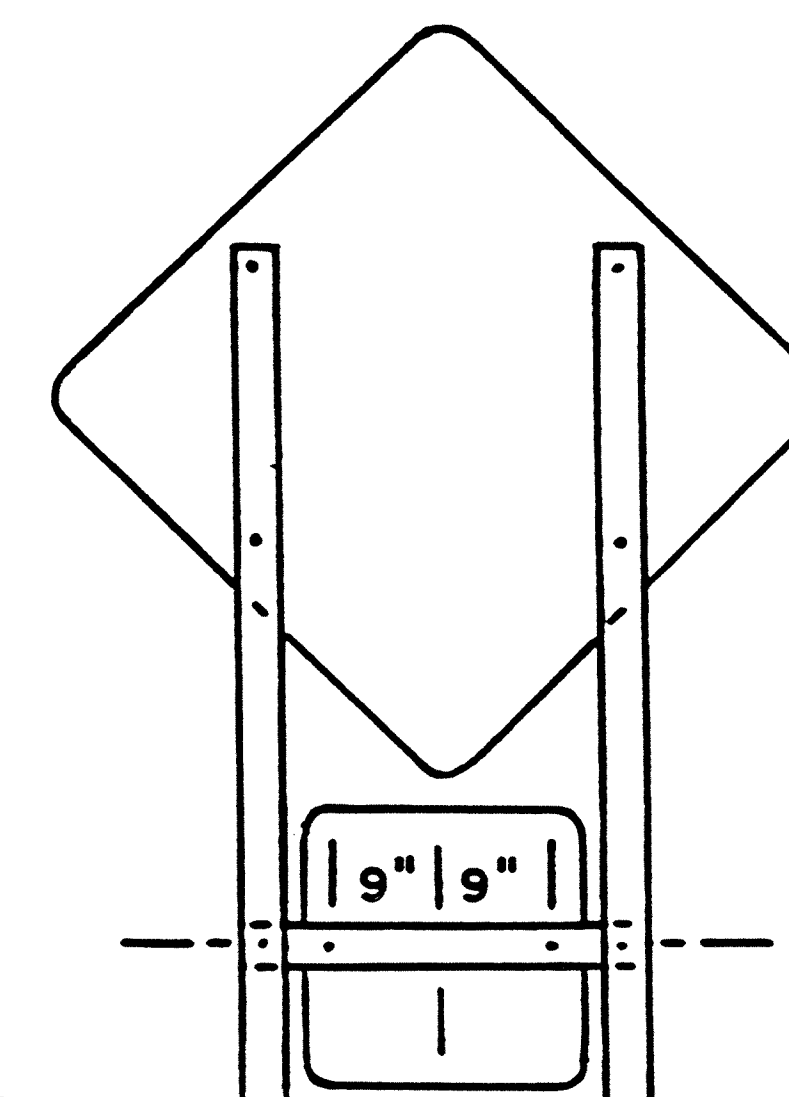


W1-2 & W13-1
W3-1a & W3-2a
Mounting

"C" & "D" SIGN DETAILS

DESIGN A
Sheet 3 of 3 RECORD PLAN
JUNE 1994

Sheet No. 17 of 17 Sheets

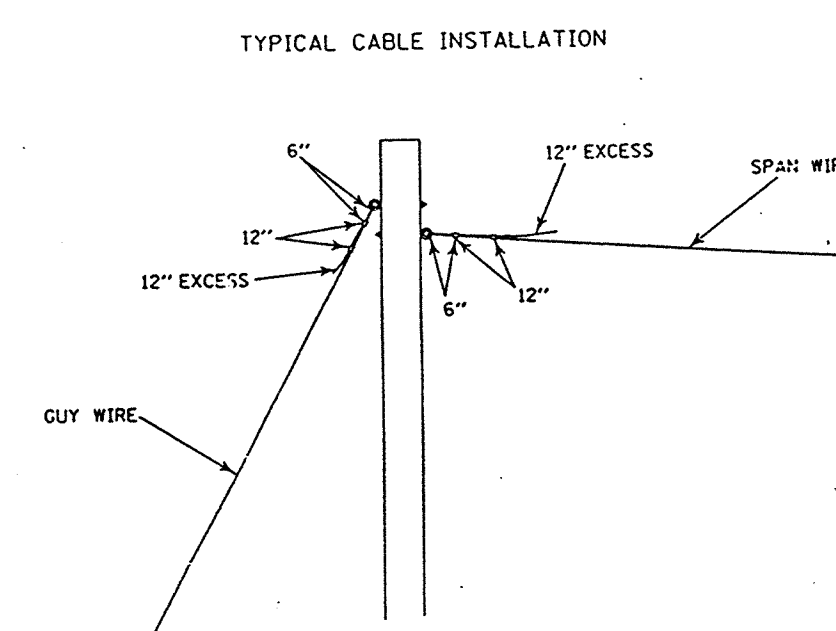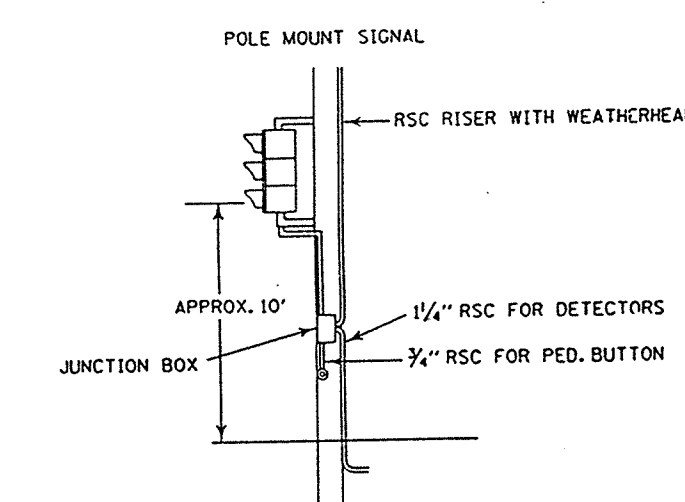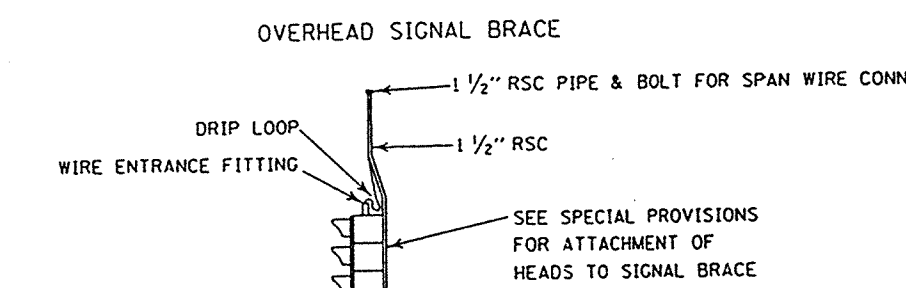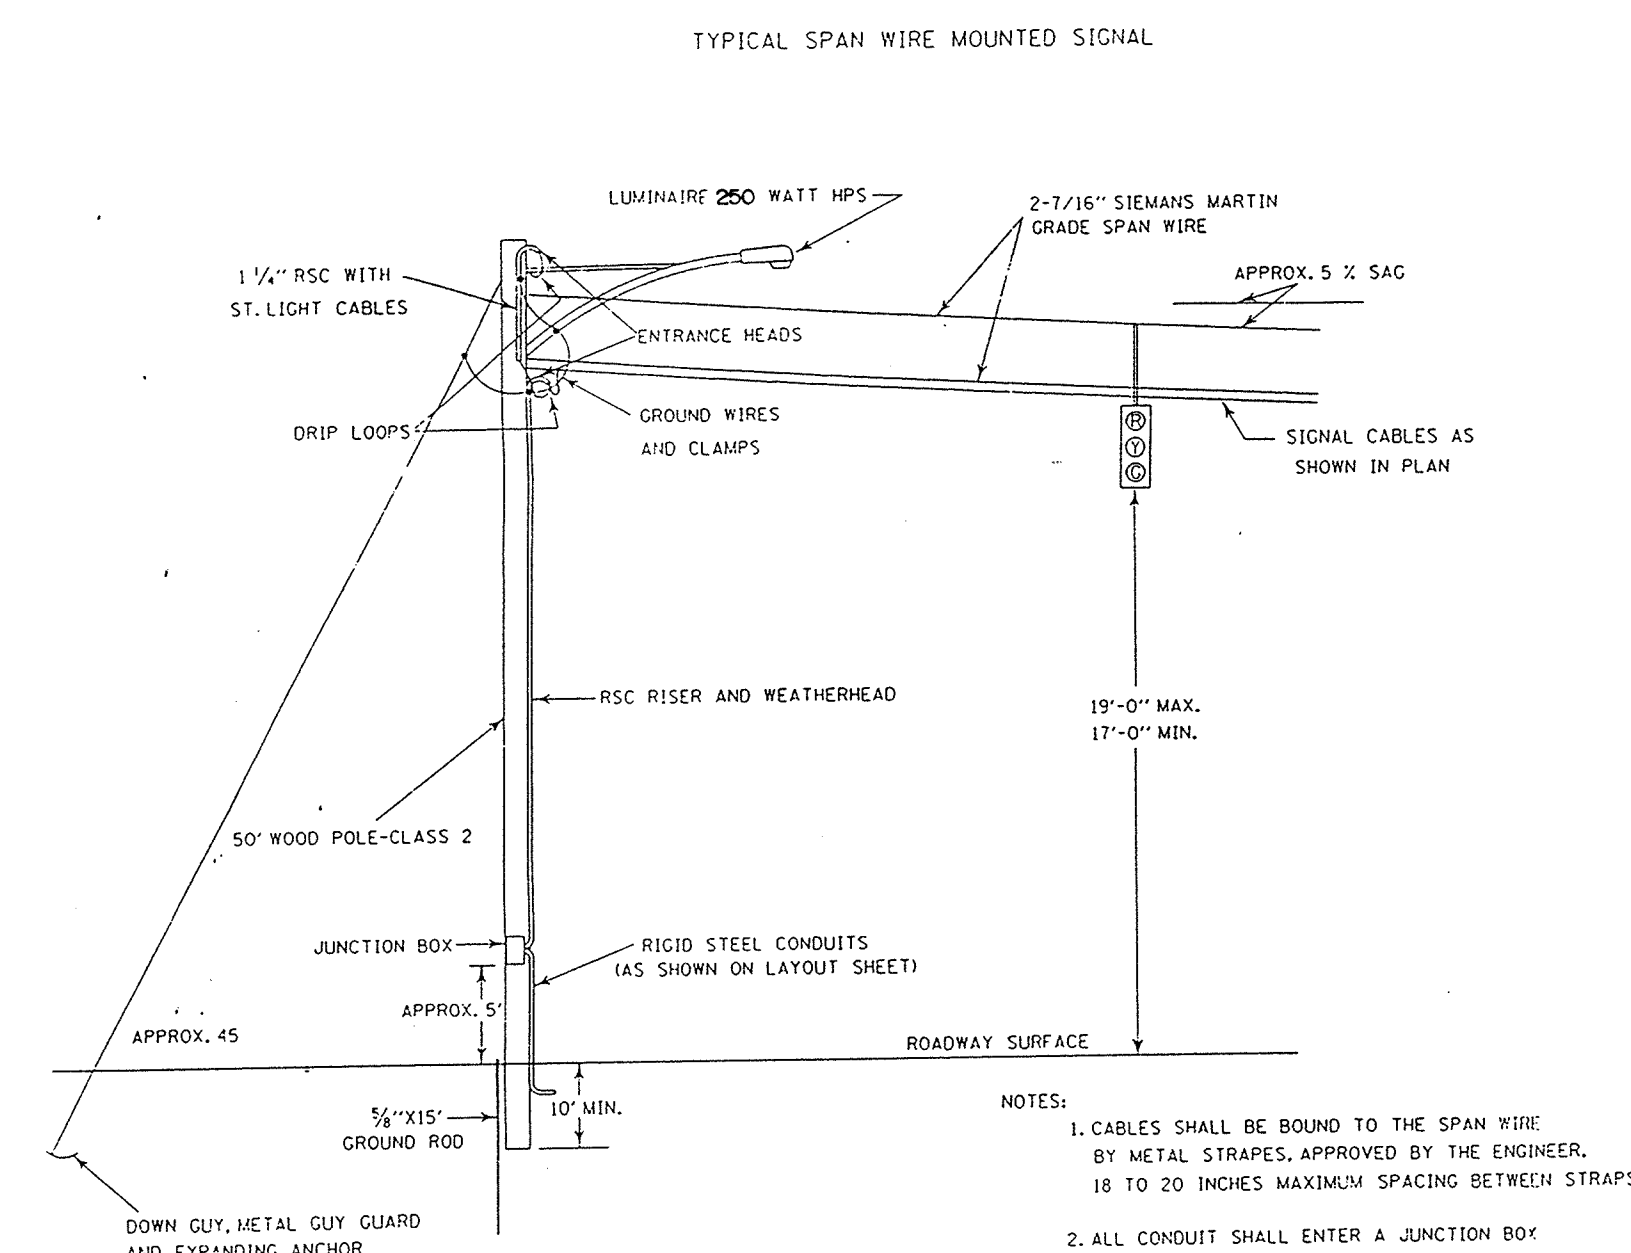

Rev. 3-23-90

State Proj. No. S.A.P. 204-113-05