


MAIN ST. / EVANS AVE. COUNTY DITCH 10

STORM SEWER AND DITCH CONSTRUCTION

I HEREBY CERTIFY THAT THIS PLAN, SPECIFICATION,
OR REPORT WAS PREPARED BY ME OR UNDER MY DIRECT
SUPERVISION AND THAT I AM A DULY REGISTERED
PROFESSIONAL ENGINEER UNDER THE LAWS OF THE
STATE OF MINNESOTA.

Mark V. Swanson
DATE 5/25/95 REG.NO. 19130

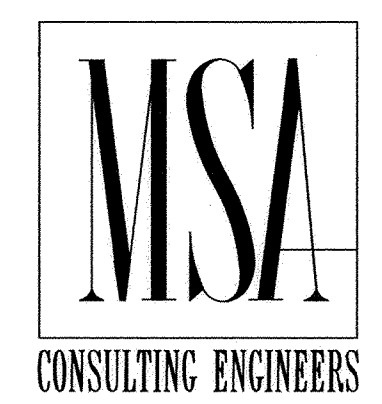

1326 ENERGY PARK DRIVE
ST. PAUL, MINNESOTA 55108
(612) 644-4389

5075 WAYZATA BLVD. SUITE #225
MINNEAPOLIS, MINNESOTA 55416
(612) 546-0432

PREPARED FOR:



MAY 1995 RECORD PLAN SHEET 1 OF 18
JANUARY 1996
CITY MARCH 1996

