
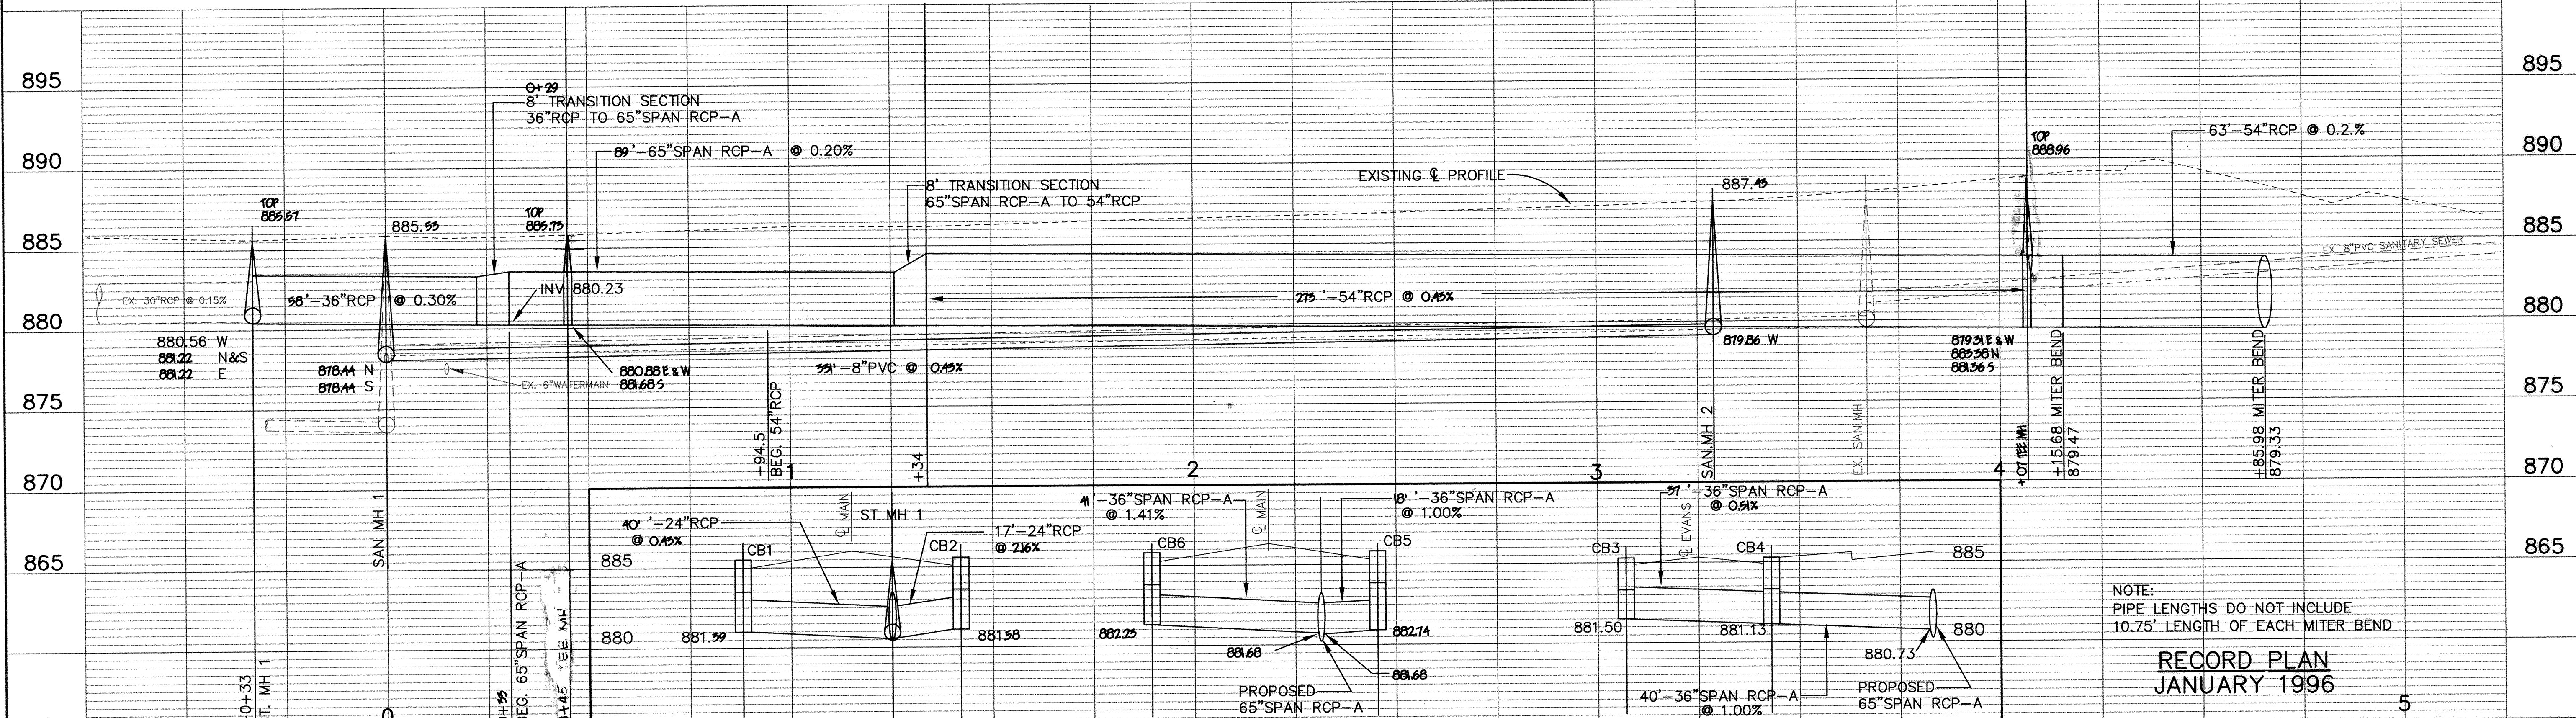
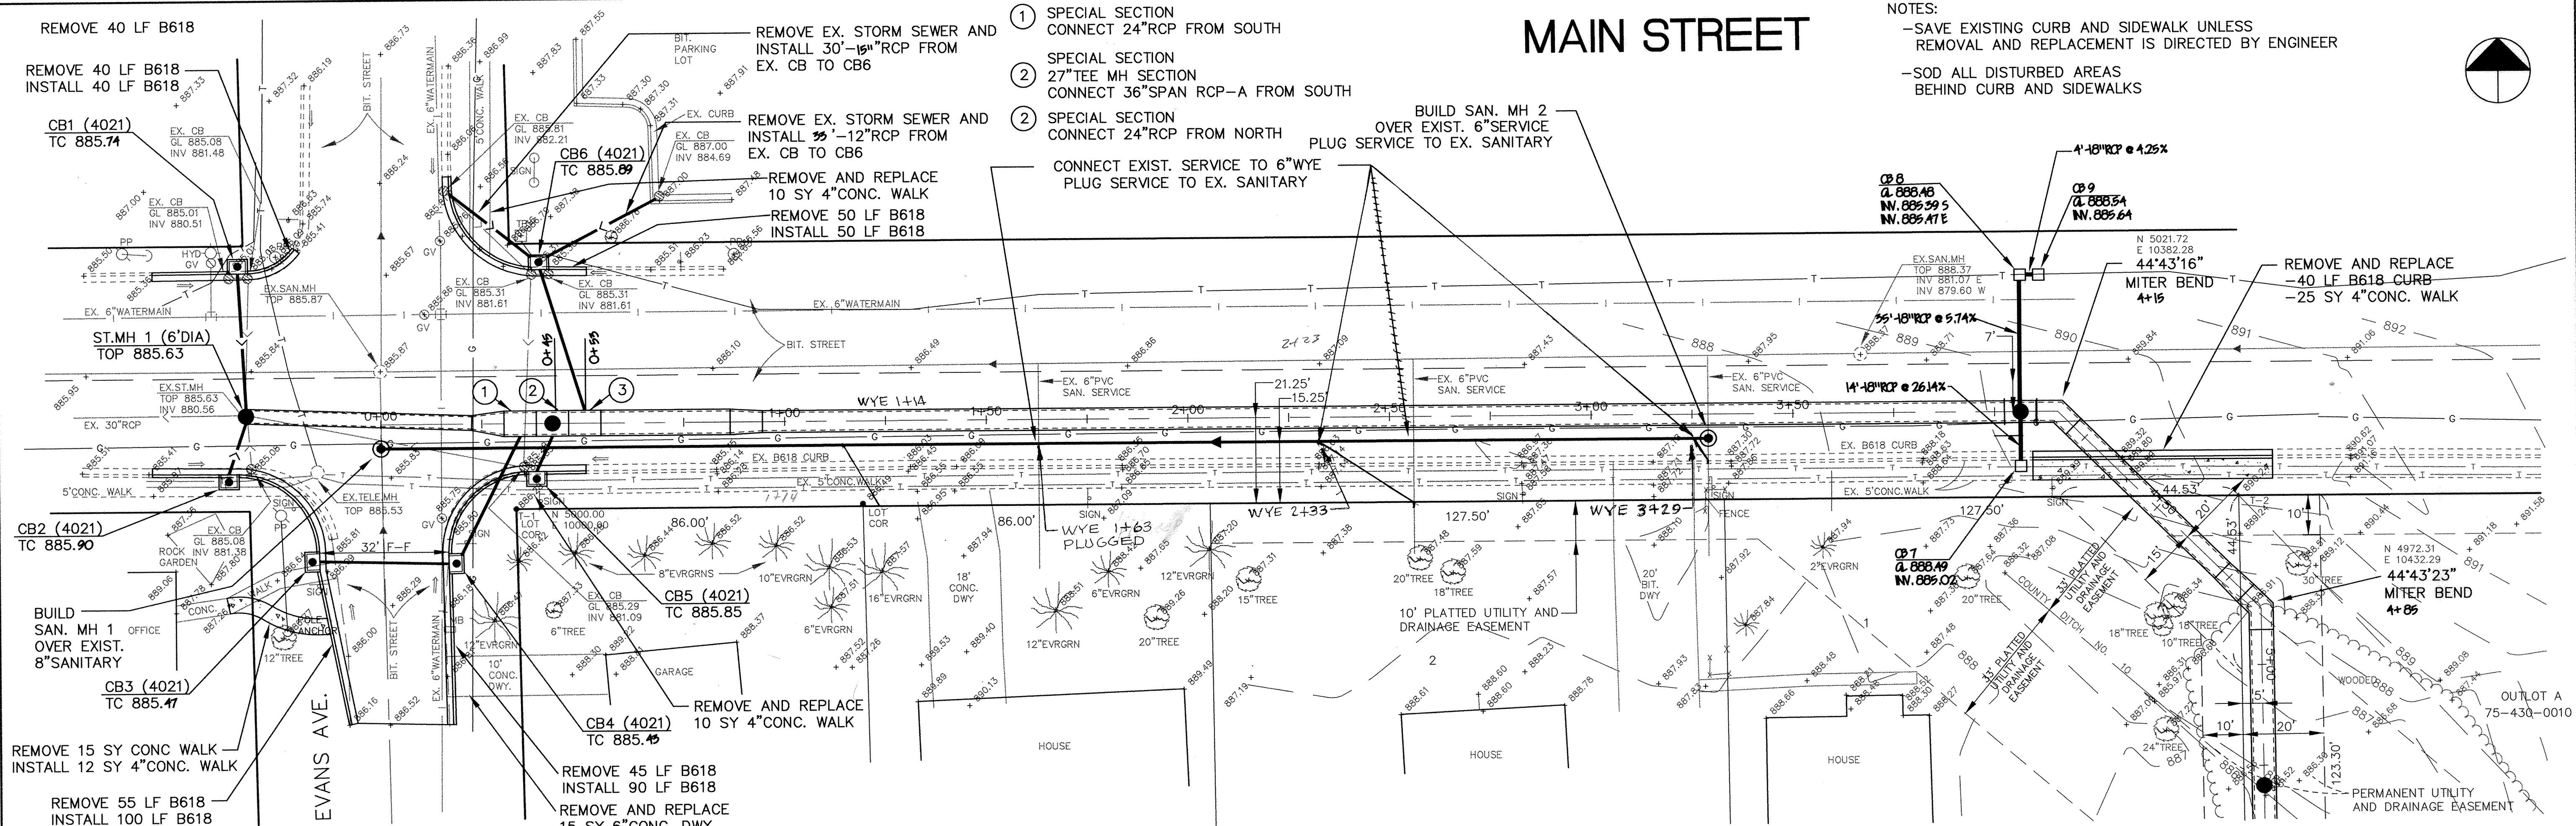


MAIN STREET


NOTES:
-SAVE EXISTING CURB AND SIDEWALK UNLESS
REMOVAL AND REPLACEMENT IS DIRECTED BY ENGINEER
-SOD ALL DISTURBED AREAS
BEHIND CURB AND SIDEWALKS

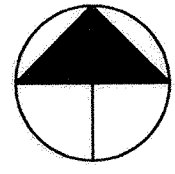

NOTE:
PIPE LENGTHS DO NOT INCLUDE
10.75' LENGTH OF EACH MITER BEND

RECORD PLAN
JANUARY 1996

I HEREBY CERTIFY THAT THIS PLAN, SPECIFICATION,
OR REPORT WAS PREPARED BY ME OR UNDER MY DIRECT
SUPERVISION AND THAT I AM A DULY REGISTERED
PROFESSIONAL ENGINEER UNDER THE LAWS OF THE
STATE OF MINNESOTA.
Mark J. Ansharov
DATE 5/25/95 REG. NO. 19130

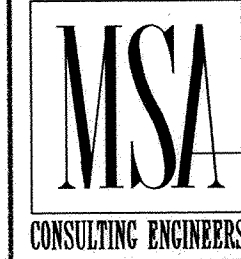

1326 ENERGY PARK DRIVE
ST. PAUL, MINNESOTA 55108
(612) 644-4389
5075 WAYZATA BLVD. SUITE #225
MINNEAPOLIS, MINNESOTA 55416
(612) 546-0432

DATE	DESCRIPTION	DESIGNED
		CHECKED
		DRAWN
		GRAPHIC SCALE
		0 20
		0 VERT. 5

CITY OF ELK RIVER MAIN STREET / EVANS AVENUE STORM SEWER CONSTRUCTION MAIN STREET			
DATE MAY 1995	SHEET 3 OF 18 SHEETS	PROJECT NO. 230-265	

DRAWING NUMBER

DRAWING NUMBER

DRAWING NUMBER

DRAWING NUMBER
MAINS.95