



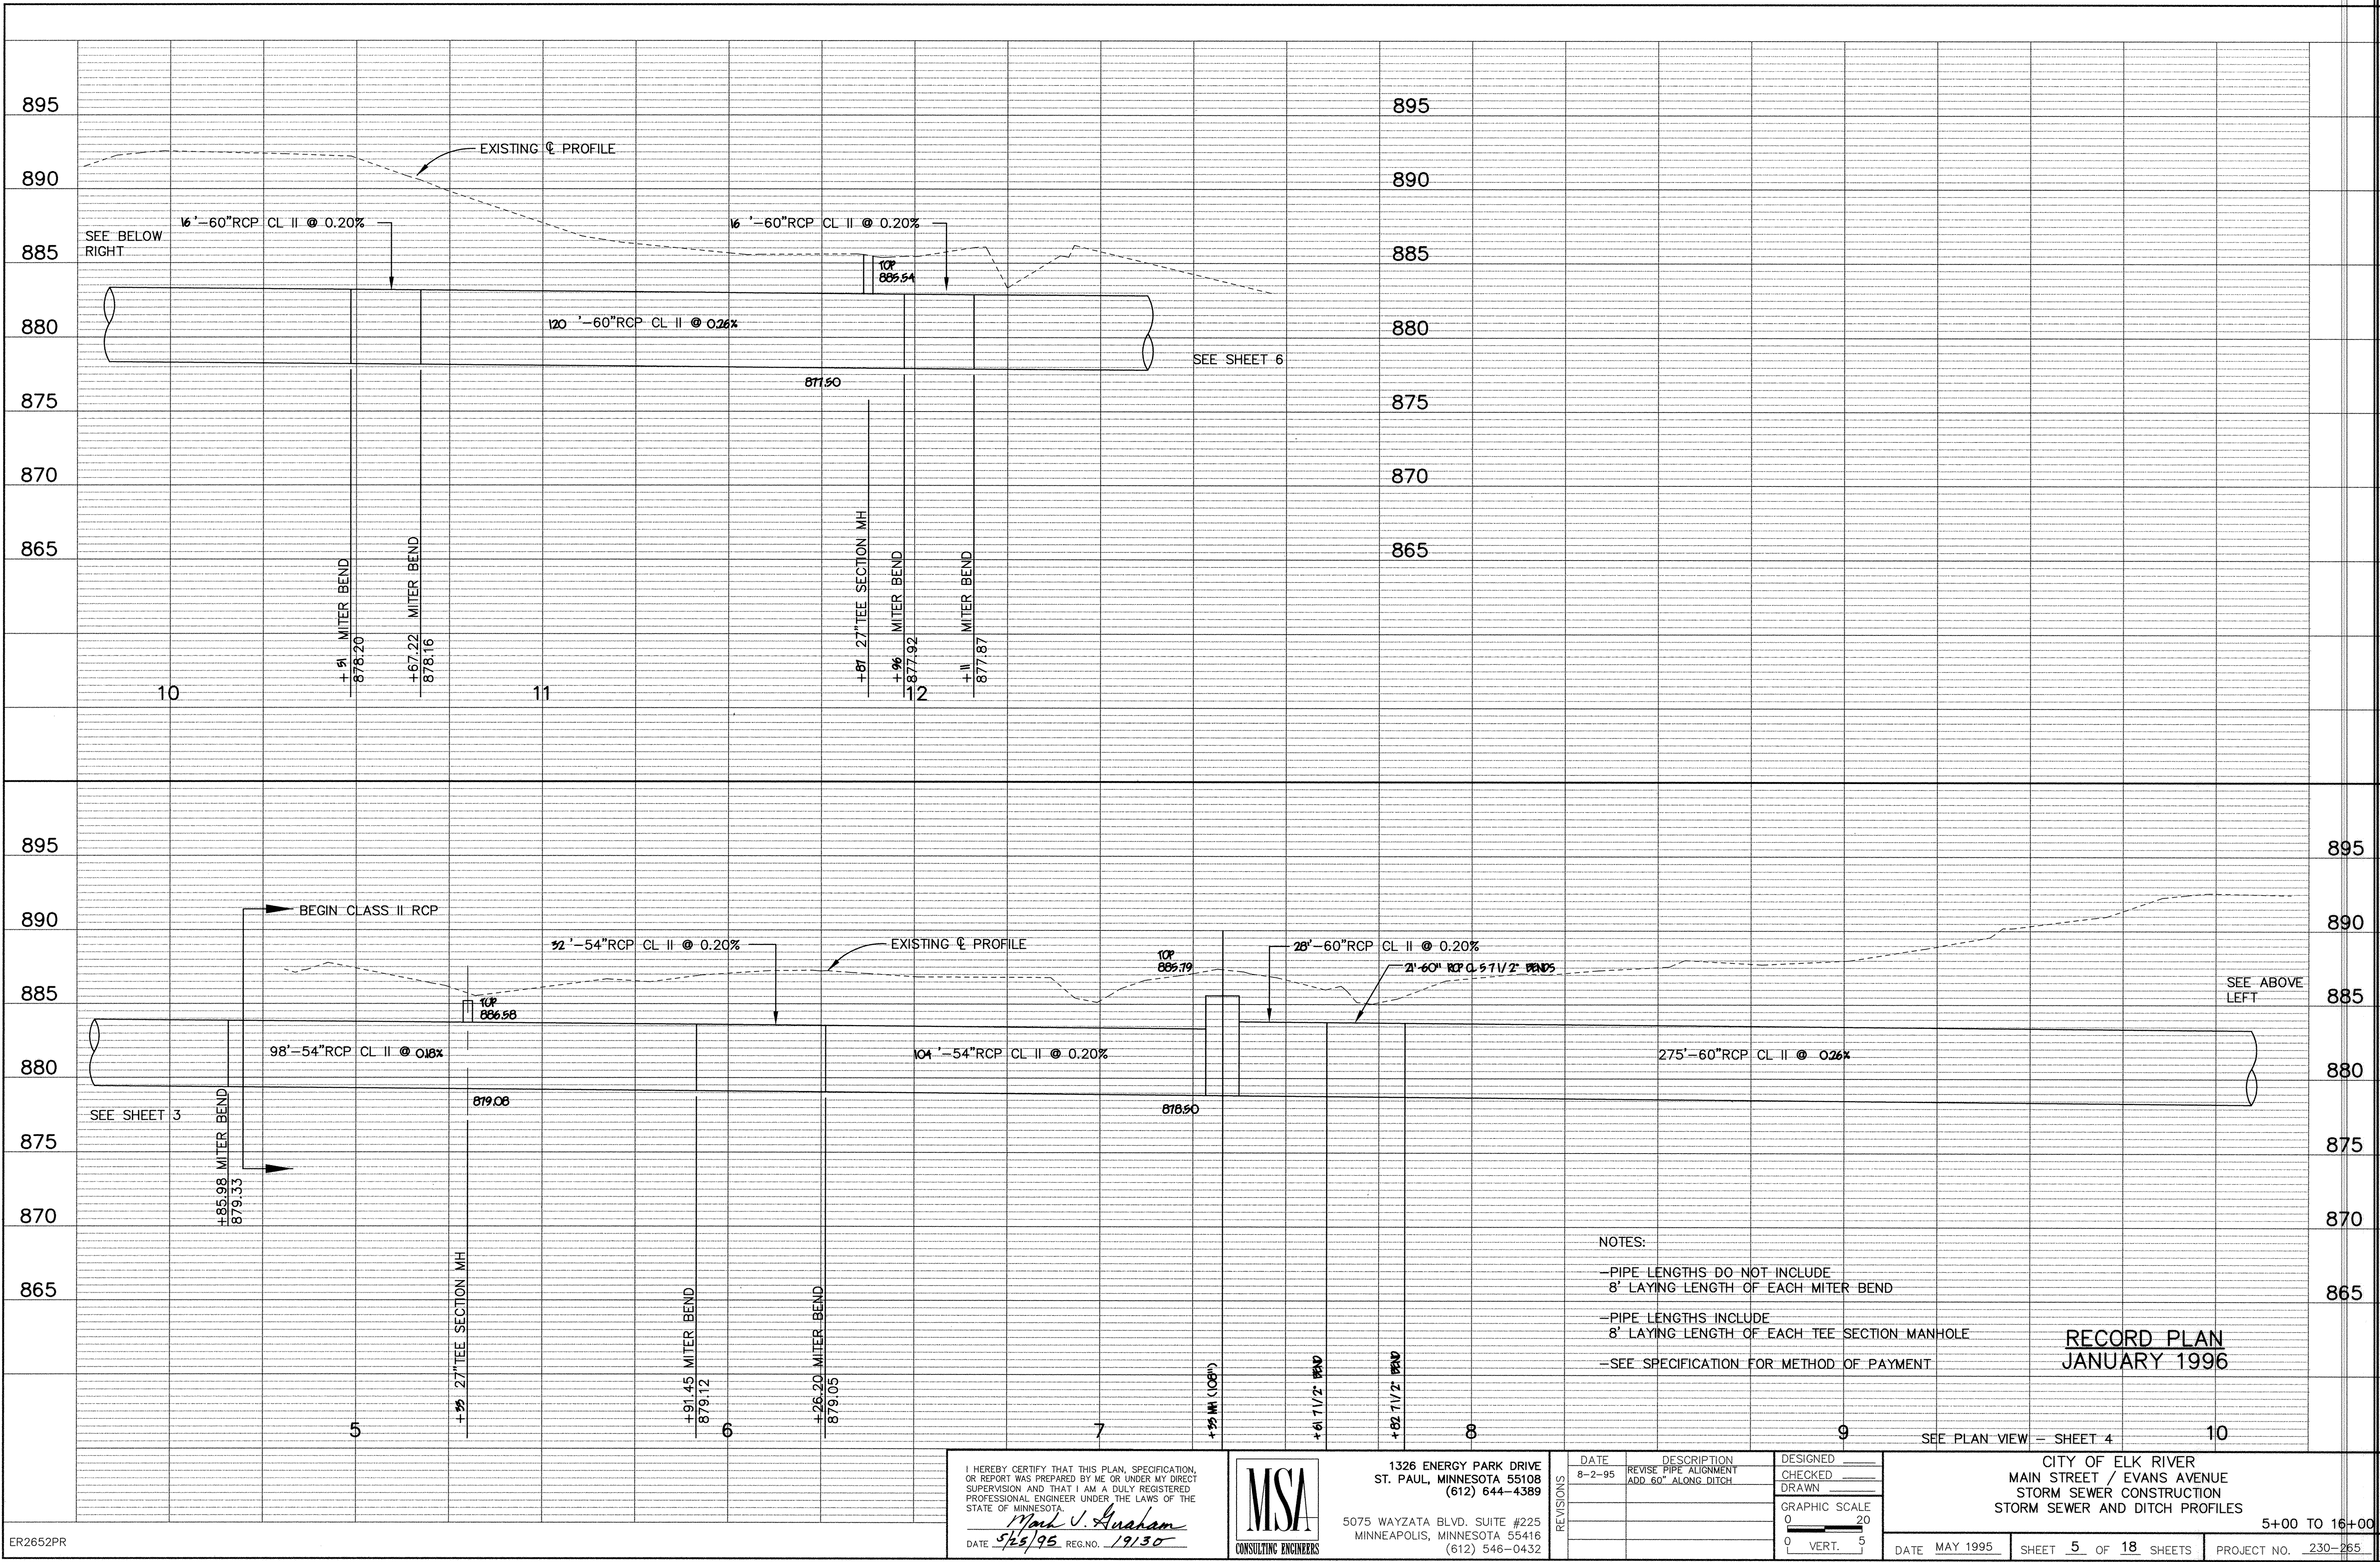

I HEREBY CERTIFY THAT THIS PLAN, SPECIFICATION, OR REPORT WAS PREPARED BY ME OR UNDER MY DIRECT SUPERVISION AND THAT I AM A DULY REGISTERED PROFESSIONAL ENGINEER UNDER THE LAWS OF THE STATE OF MINNESOTA.

Mark J. Quaham

DATE 5/25/95 REG. NO. 19130

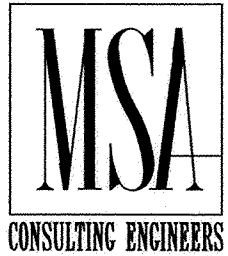

1326 ENERGY PARK DRIVE
ST. PAUL, MINNESOTA 55108
(612) 644-4389

5075 WAYZATA BLVD. SUITE #225
MINNEAPOLIS, MINNESOTA 55416
(612) 546-0432

DATE	DESCRIPTION	DESIGNED
8-2-95	REVISE PIPE ALIGNMENT ADD 60" ALONG DITCH	CHECKED
		DRAWN

GRAPHIC SCALE
0 20
0 VERT. 5

CITY OF ELK RIVER
MAIN STREET / EVANS AVENUE
STORM SEWER CONSTRUCTION
STORM SEWER AND DITCH PROFILES

5+00 TO 16+00

DATE MAY 1995 SHEET 5 OF 18 SHEETS PROJECT NO. 230-265