

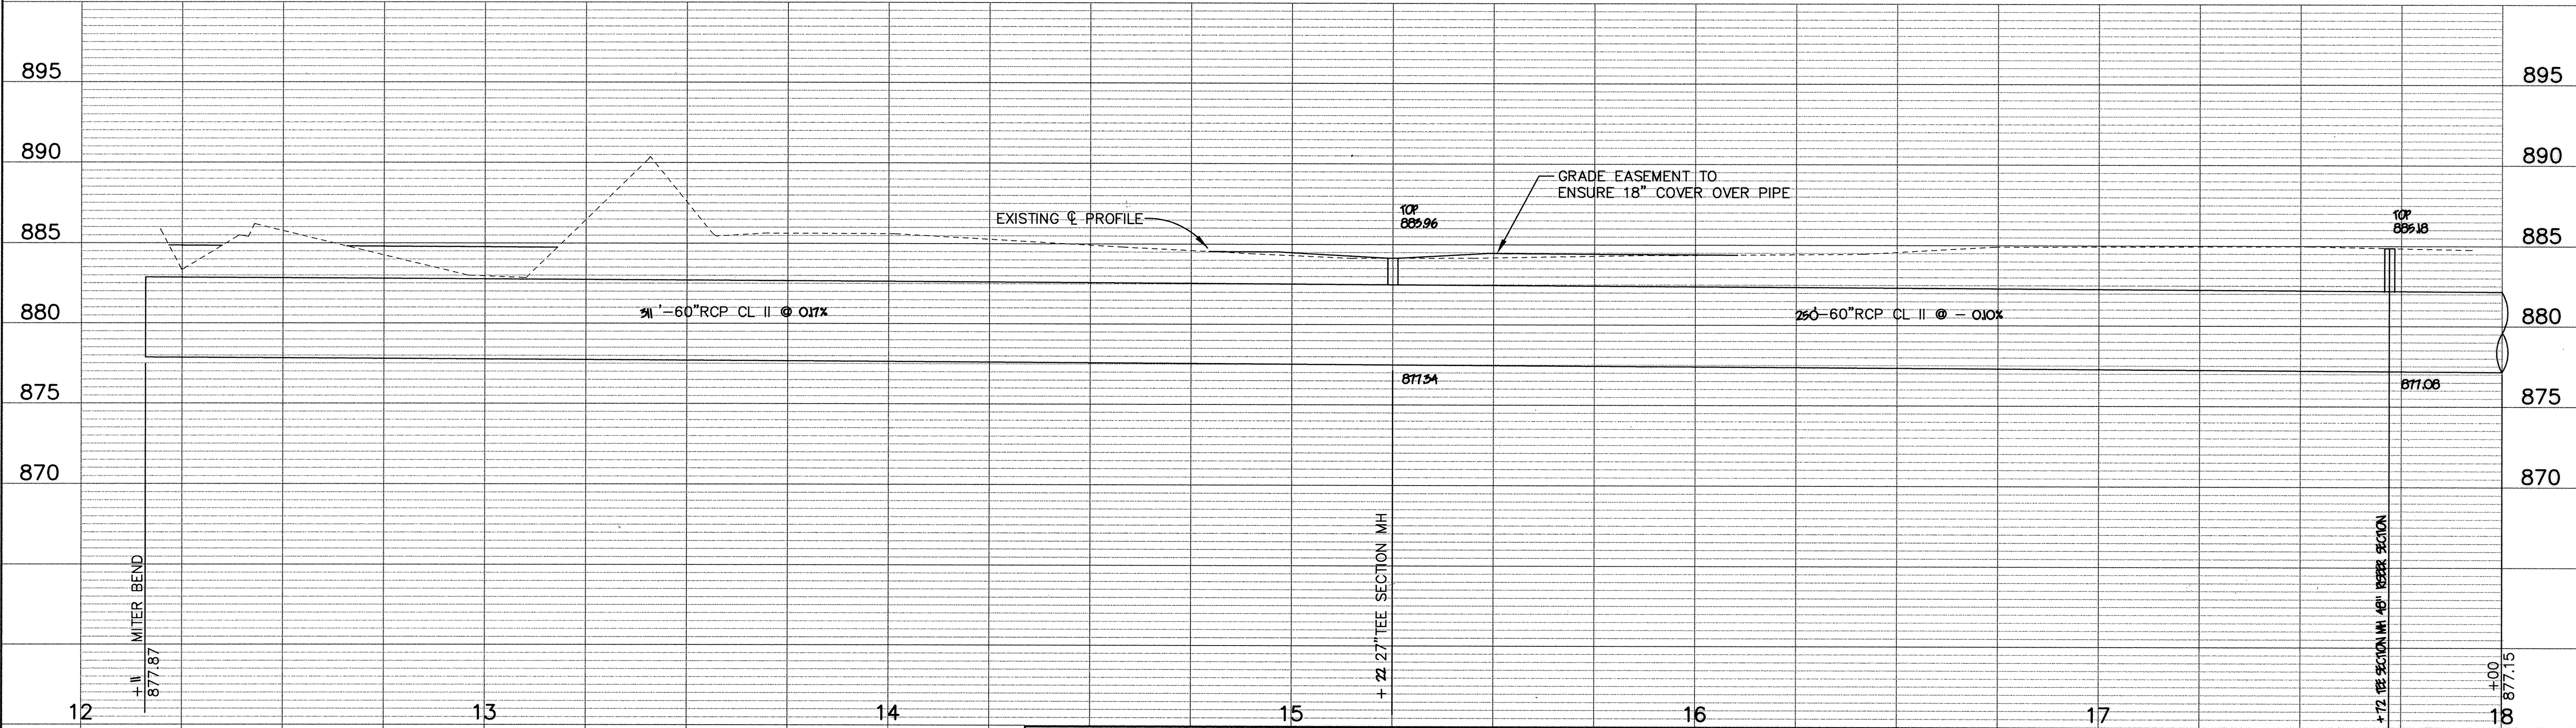


## EASEMENT ALONG HOHLEN / U.P.A. PROPERTY

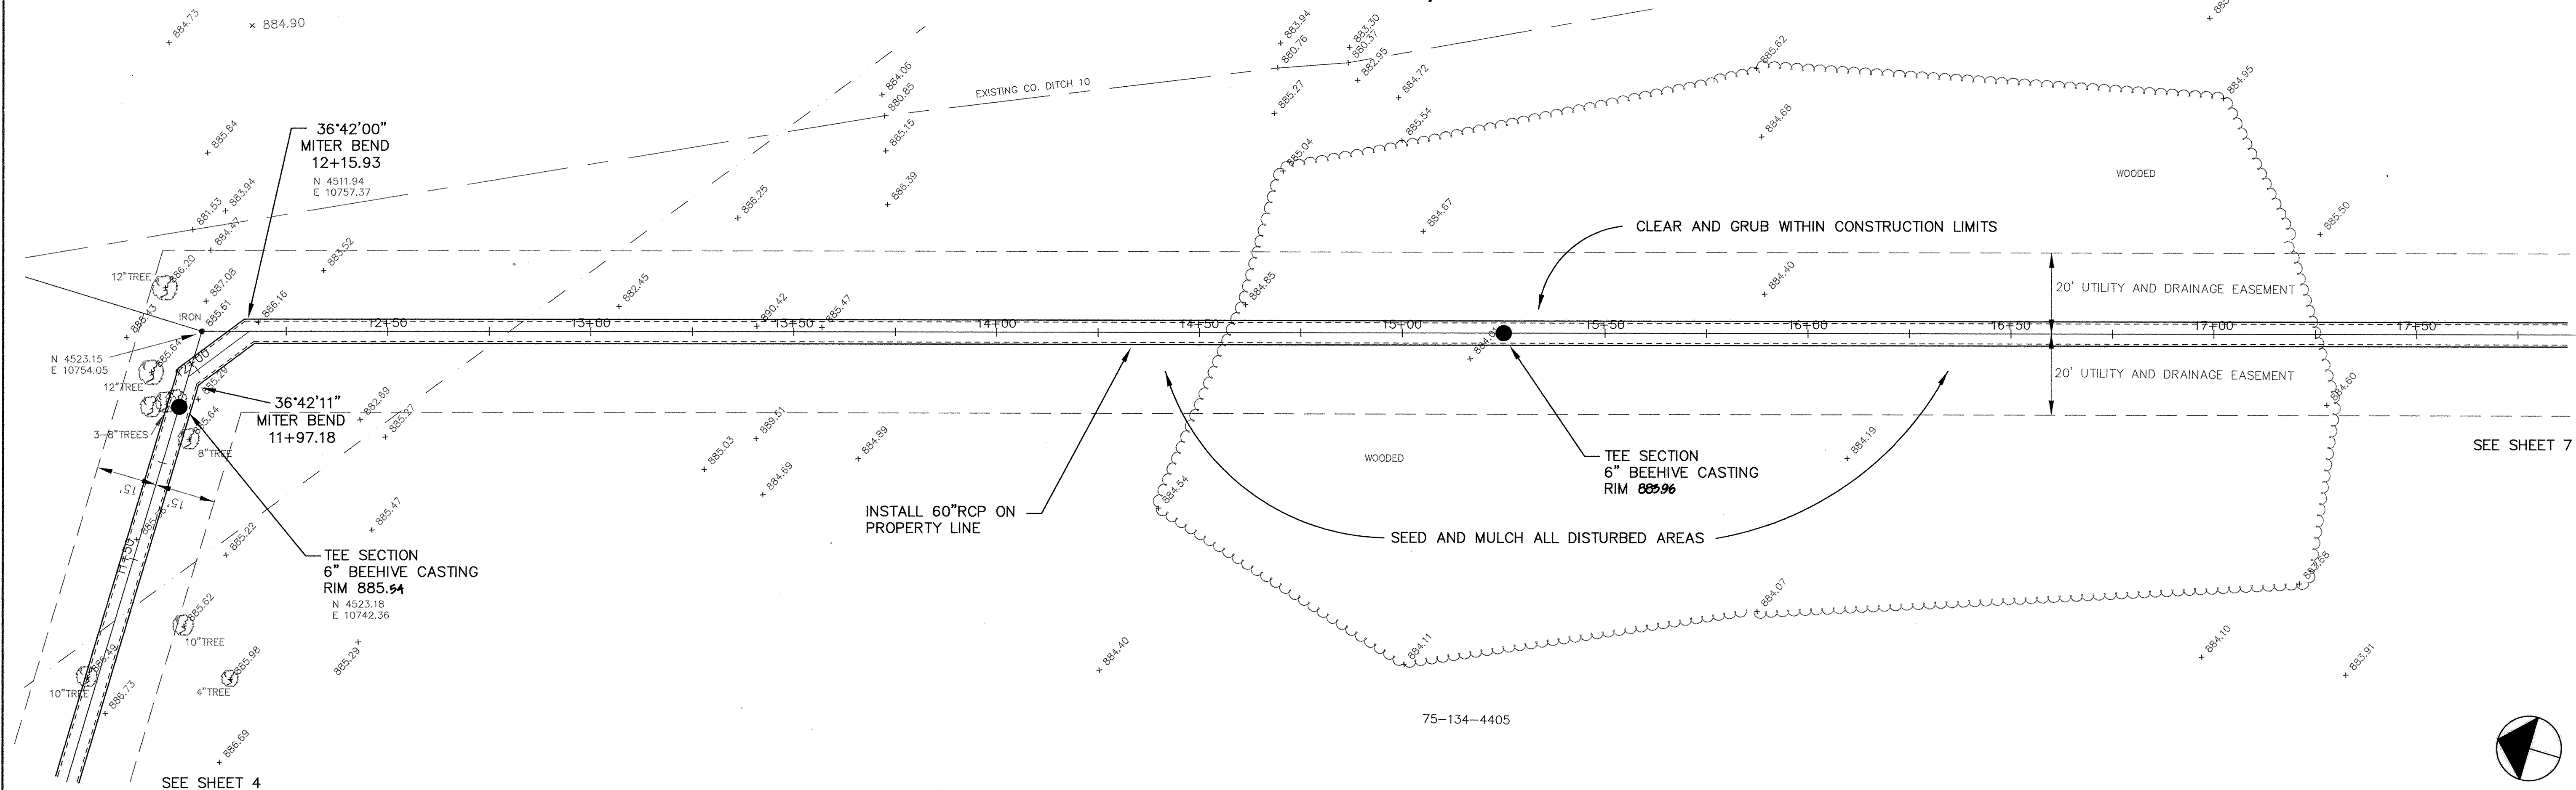

I HEREBY CERTIFY THAT THIS PLAN, SPECIFICATION, OR REPORT WAS PREPARED BY ME OR UNDER MY DIRECT SUPERVISION AND THAT I AM A DULY REGISTERED PROFESSIONAL ENGINEER UNDER THE LAWS OF THE STATE OF MINNESOTA.

*Mark J. Graham*  
DATE 5/25/95 REG. NO. 19130

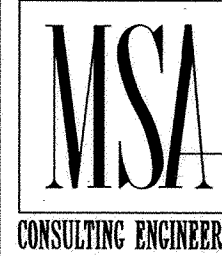

1326 ENERGY PARK DRIVE  
ST. PAUL, MINNESOTA 55108  
(612) 644-4389

5075 WAYZATA BLVD. SUITE #225  
MINNEAPOLIS, MINNESOTA 55416  
(612) 546-0432

| REVISIONS | DATE   | DESCRIPTION                                     | DESIGNED                         |
|-----------|--------|-------------------------------------------------|----------------------------------|
|           | 8-2-95 | REVISE PIPE ALIGNMENT<br>ADD 60"RCP ALONG DITCH | CHECKED<br>DRAWN                 |
|           |        |                                                 | GRAPHIC SCALE<br>0 20<br>VERT. 5 |

|               |                      |                     |
|---------------|----------------------|---------------------|
| DATE MAY 1995 | SHEET 6 OF 18 SHEETS | PROJECT NO. 230-265 |
|---------------|----------------------|---------------------|