

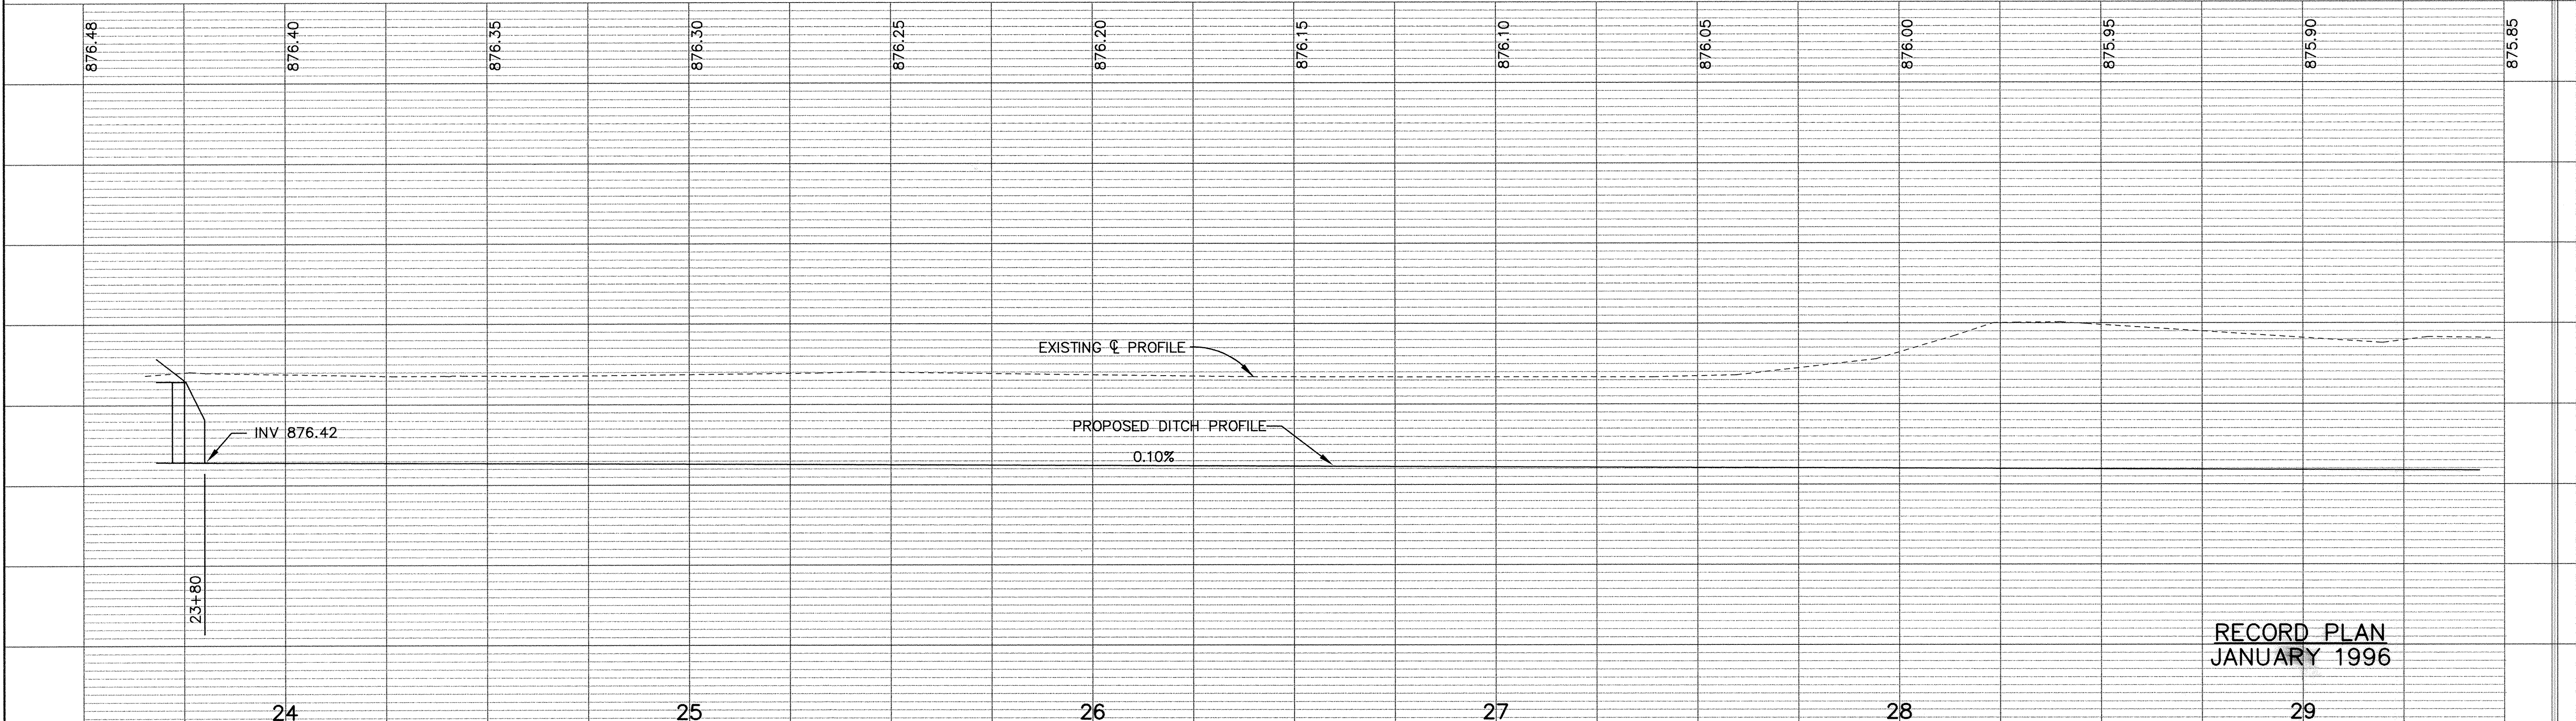


T.H. 169 RIGHT OF WAY

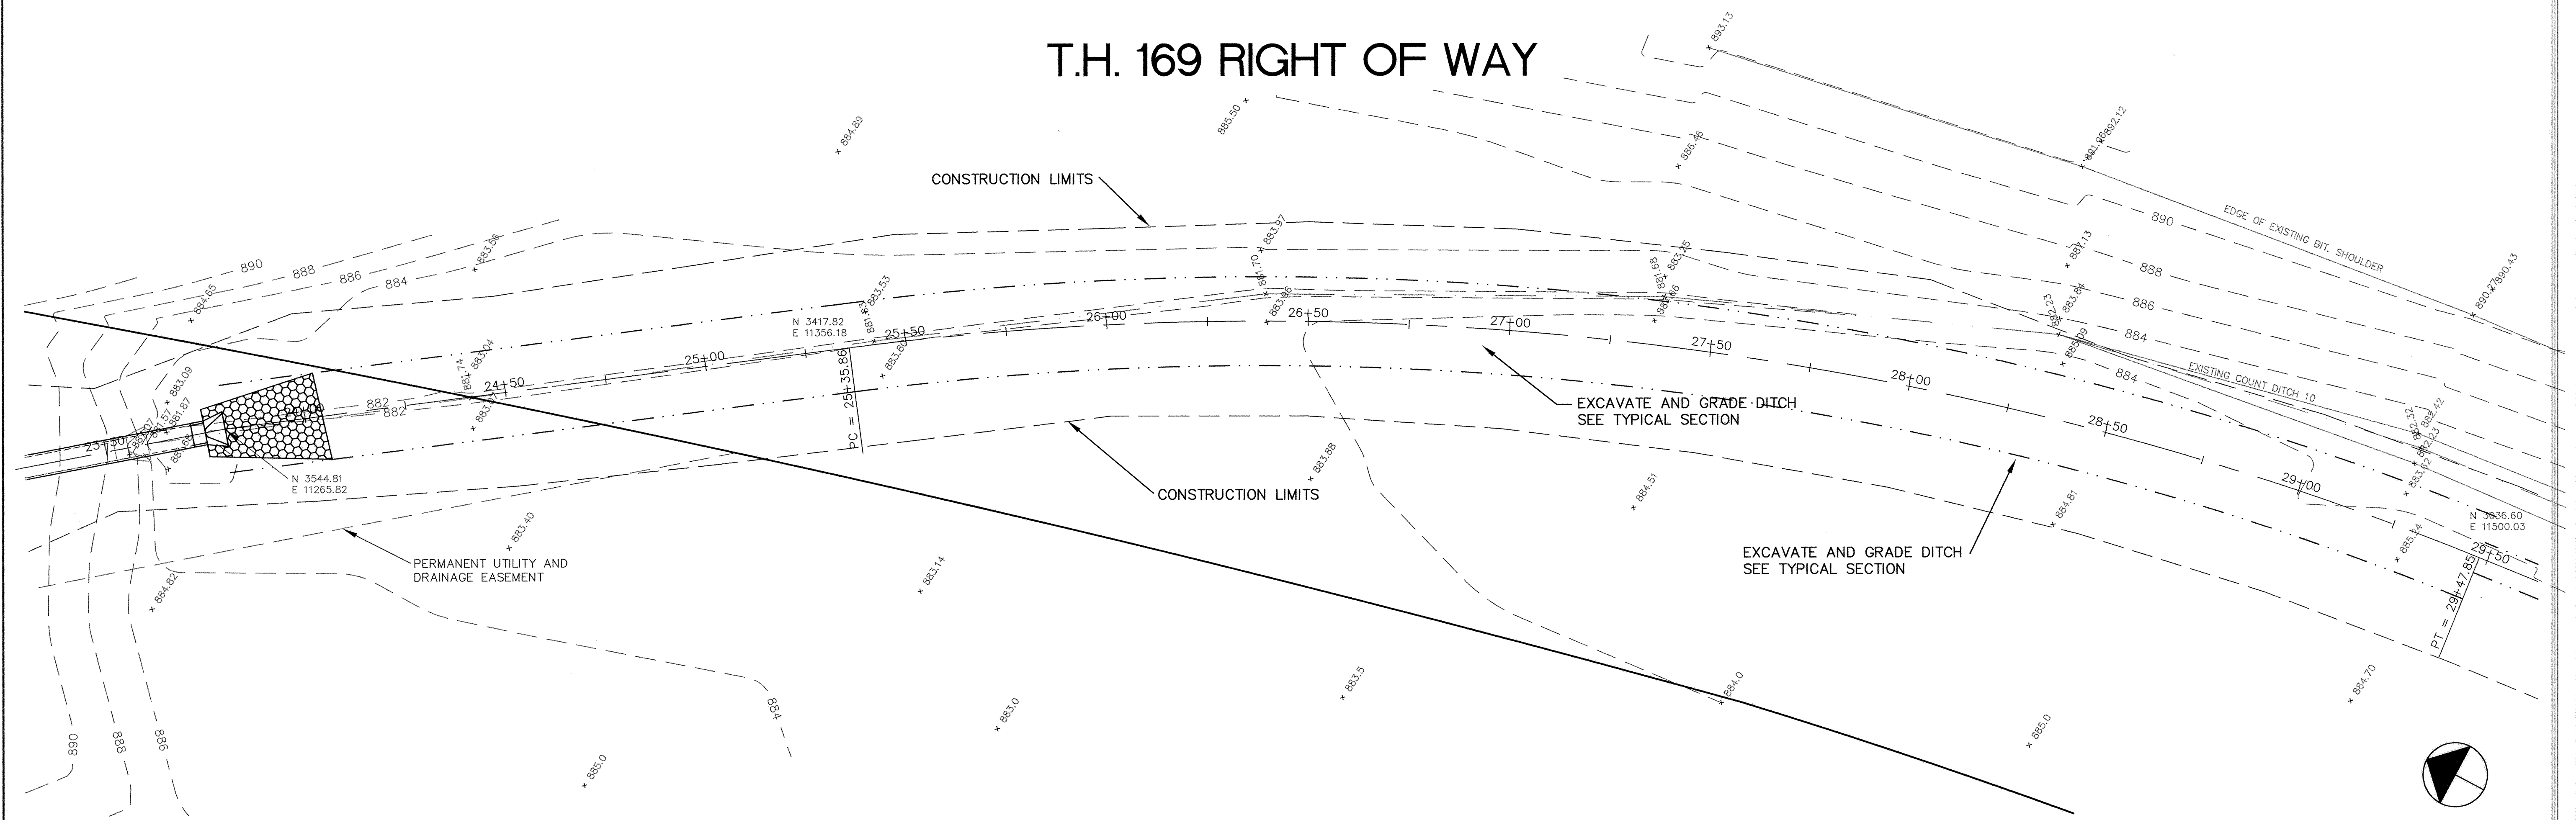

RECORD PLAN
JANUARY 1996

I HEREBY CERTIFY THAT THIS PLAN, SPECIFICATION, OR REPORT WAS PREPARED BY ME OR UNDER MY DIRECT SUPERVISION AND THAT I AM A DULY REGISTERED PROFESSIONAL ENGINEER UNDER THE LAWS OF THE STATE OF MINNESOTA.
Mark V. Guahan
DATE 5/25/95 REG. NO. 19130

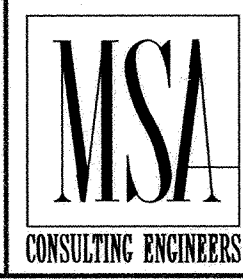

1326 ENERGY PARK DRIVE
ST. PAUL, MINNESOTA 55108
(612) 644-4389
5075 WAYZATA BLVD. SUITE #225
MINNEAPOLIS, MINNESOTA 55416
(612) 546-0432

DATE	DESCRIPTION	DESIGNED
		CHECKED
		DRAWN
		GRAPHIC SCALE
		0 20
		0 VERT. 5

CITY OF ELK RIVER MAIN STREET / EVANS AVENUE STORM SEWER CONSTRUCTION T.H. 169 RIGHT OF WAY			
DATE MAY 1995	SHEET 8 OF 18 SHEETS	PROJECT NO. 230-265	