



T.H. 169

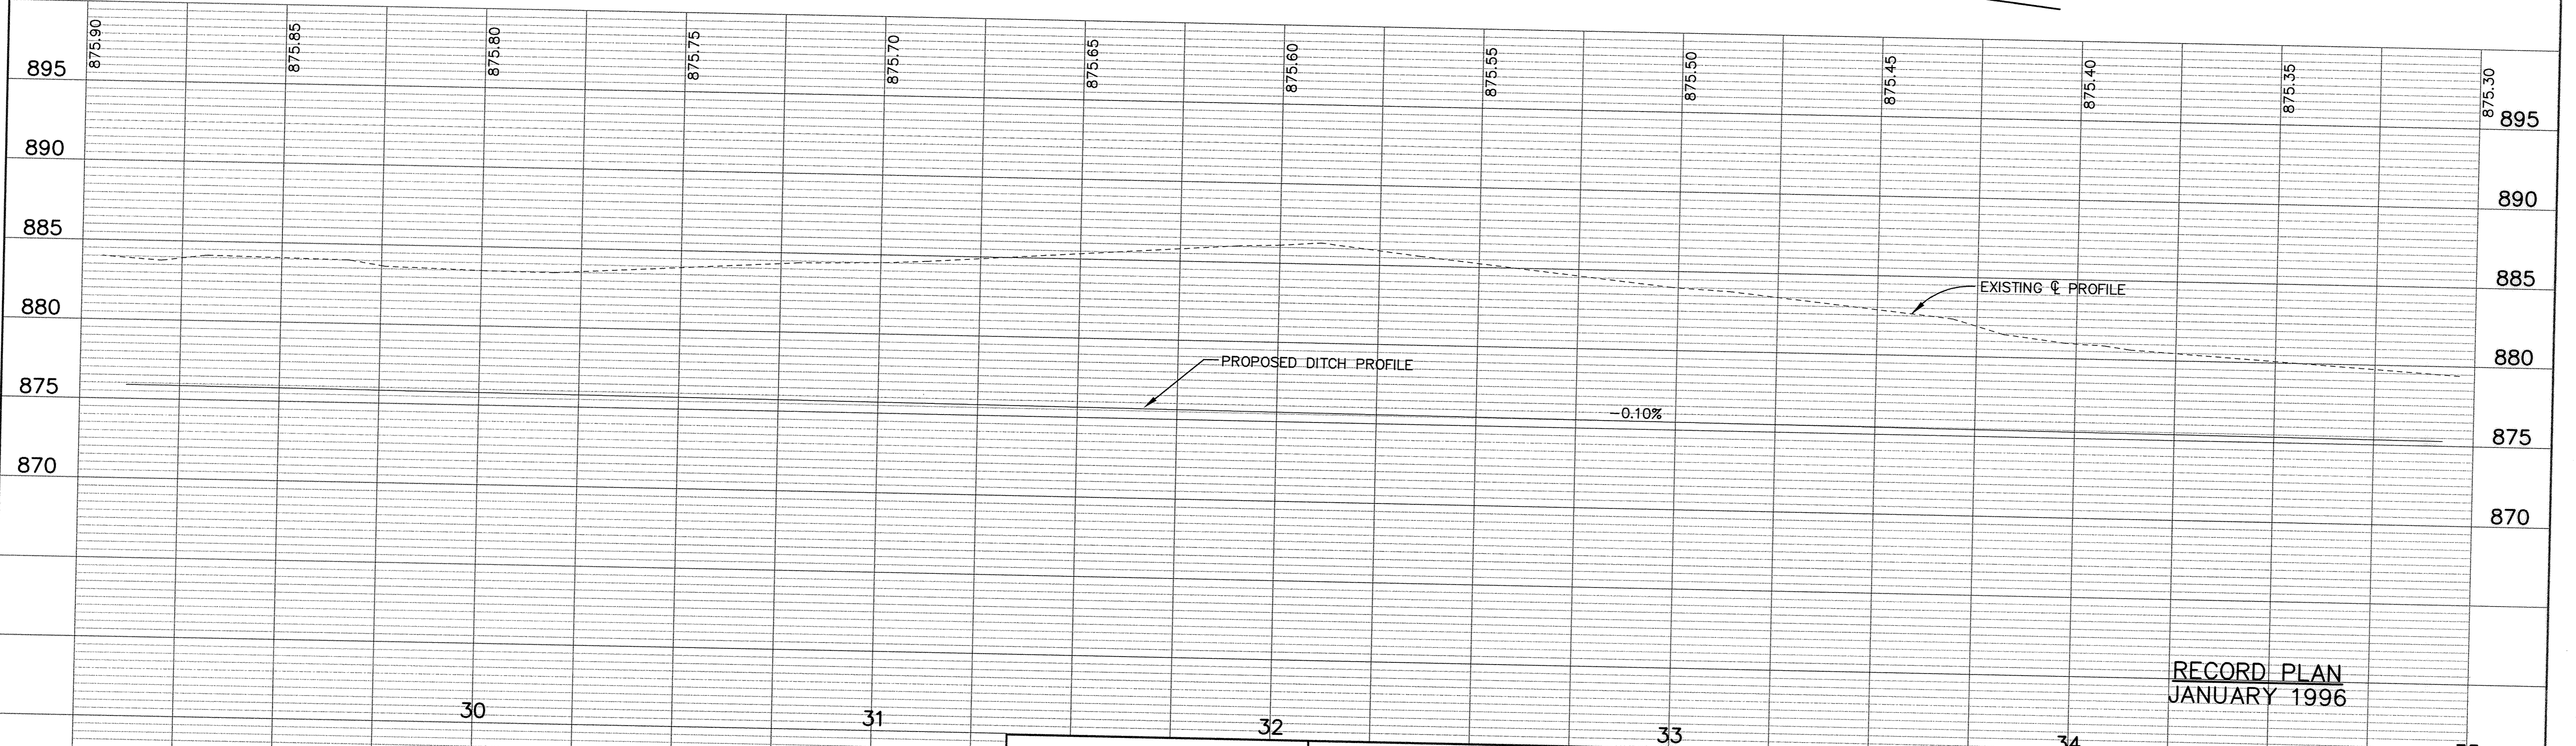

RECORD PLAN
JANUARY 1996

I HEREBY CERTIFY THAT THIS PLAN, SPECIFICATION, OR REPORT WAS PREPARED BY ME OR UNDER MY DIRECT SUPERVISION AND THAT I AM A DULY REGISTERED PROFESSIONAL ENGINEER UNDER THE LAWS OF THE STATE OF MINNESOTA.
Mark J. Abraham
DATE 5/25/95 REG. NO. 17130

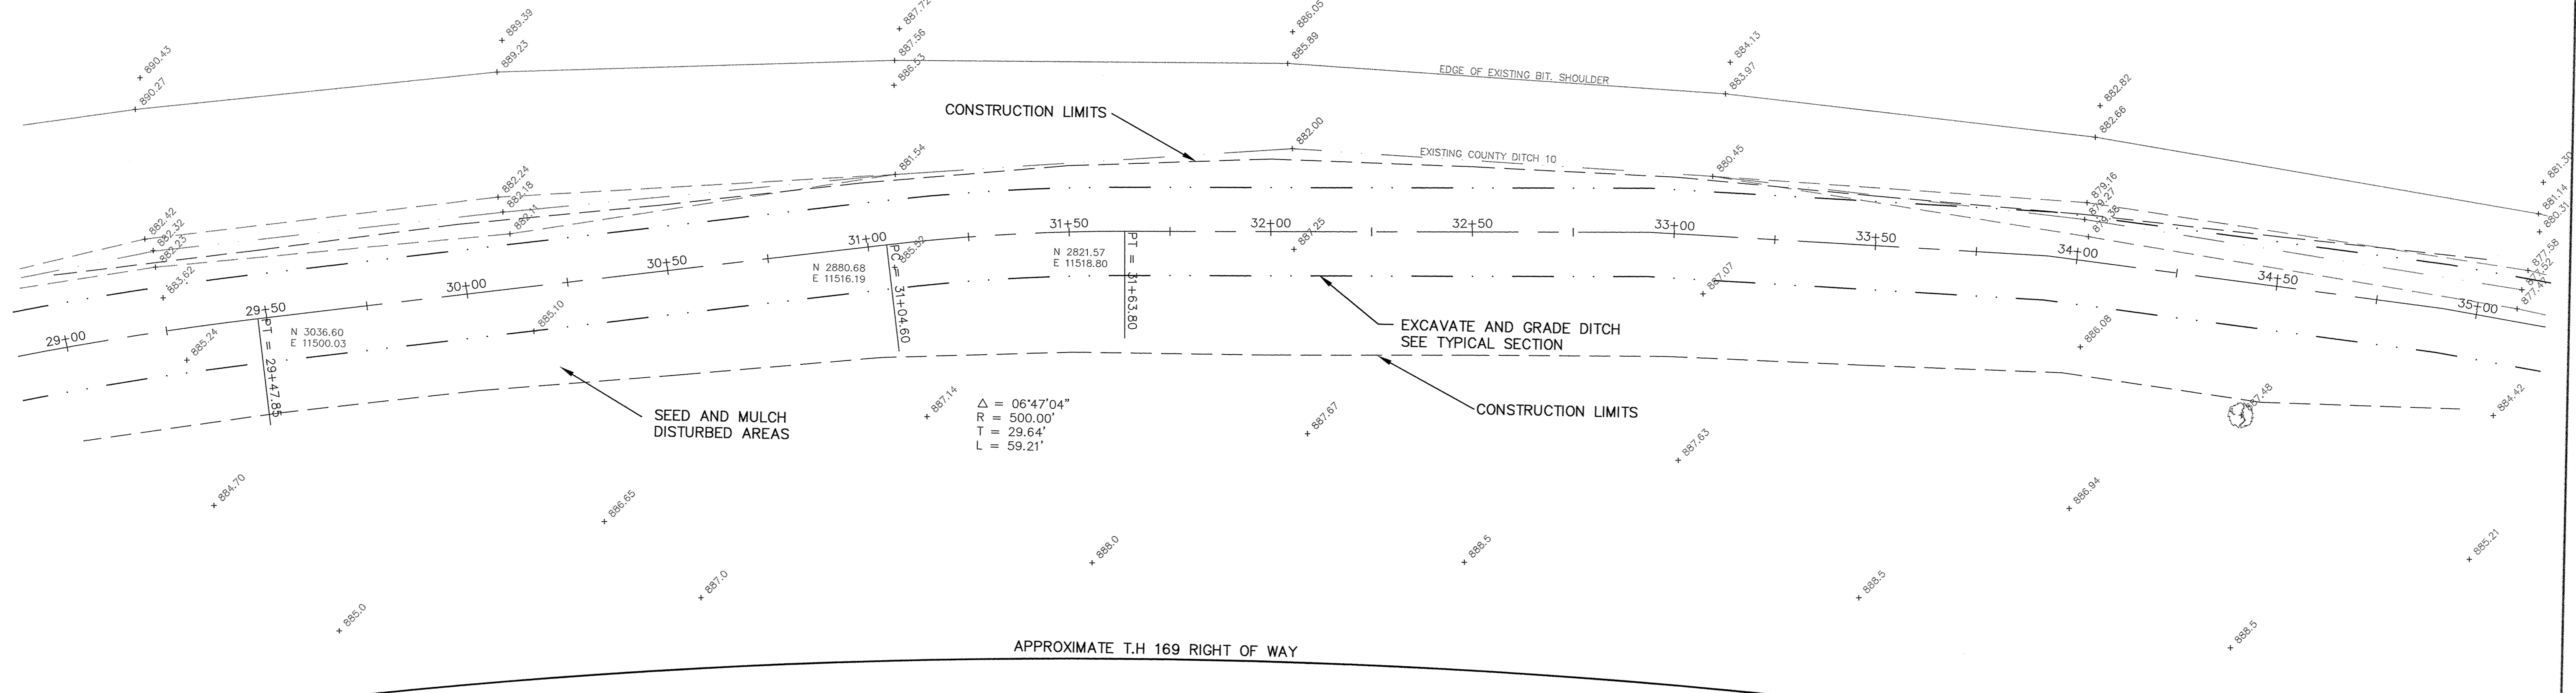

1326 ENERGY PARK DRIVE
ST. PAUL, MINNESOTA 55108
(612) 644-4389
5075 WAYZATA BLVD. SUITE #225
MINNEAPOLIS, MINNESOTA 55416
(612) 546-0432

REVISIONS	DATE	DESCRIPTION

DESIGNED _____
CHECKED _____
DRAWN _____
GRAPHIC SCALE
0 20
0 VERT. 5

CITY OF ELK RIVER
MAIN STREET / EVANS AVENUE
STORM SEWER CONSTRUCTION
COUNTY DITCH 10
29+50 TO 34+50