
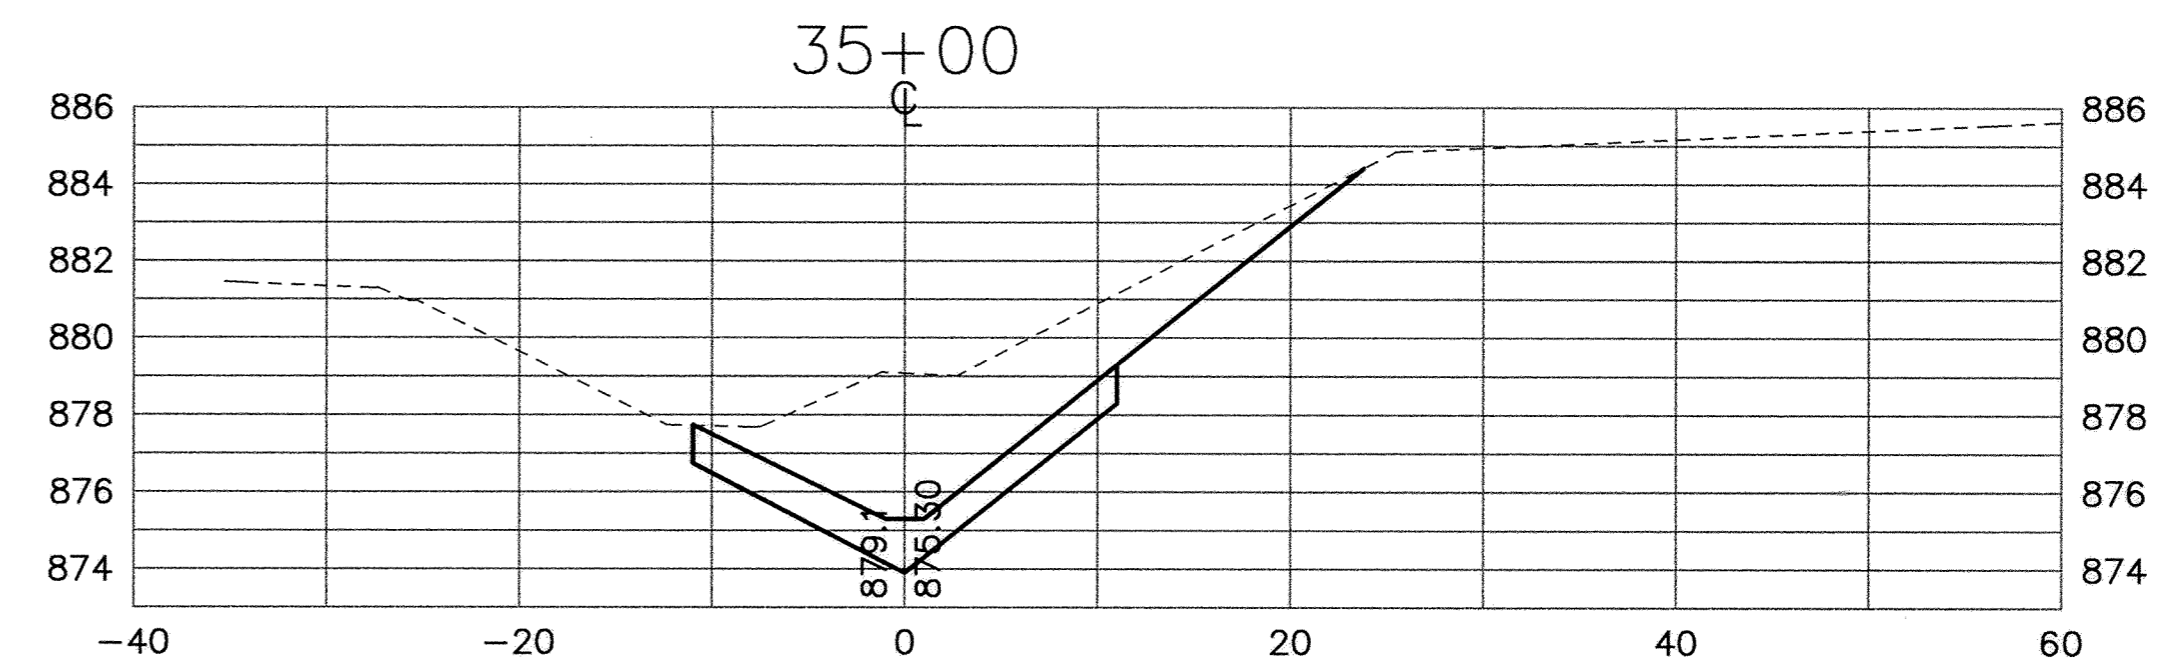
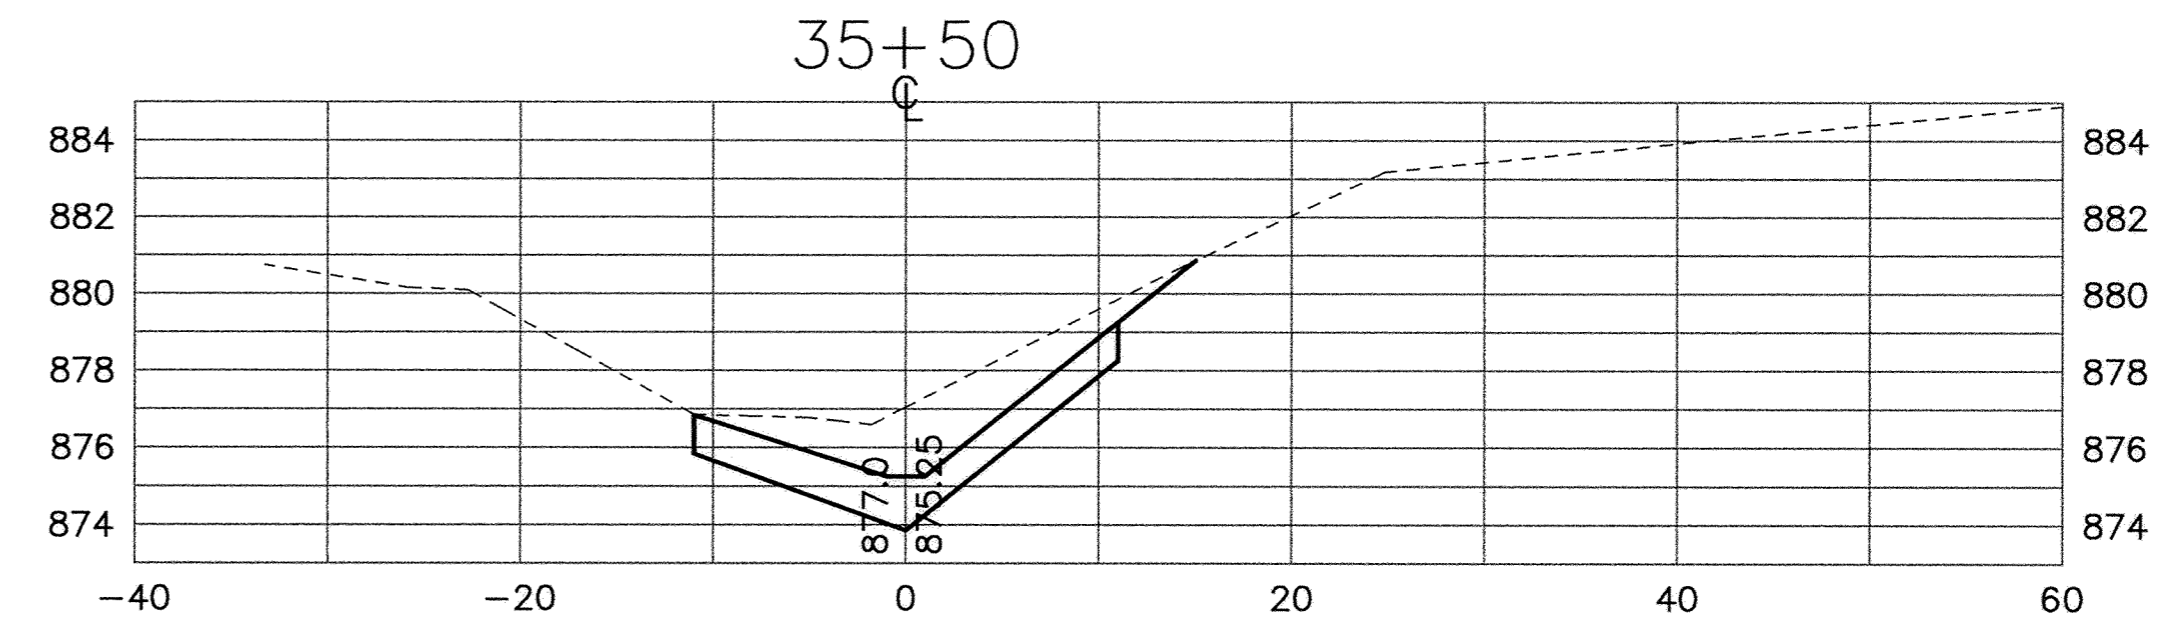
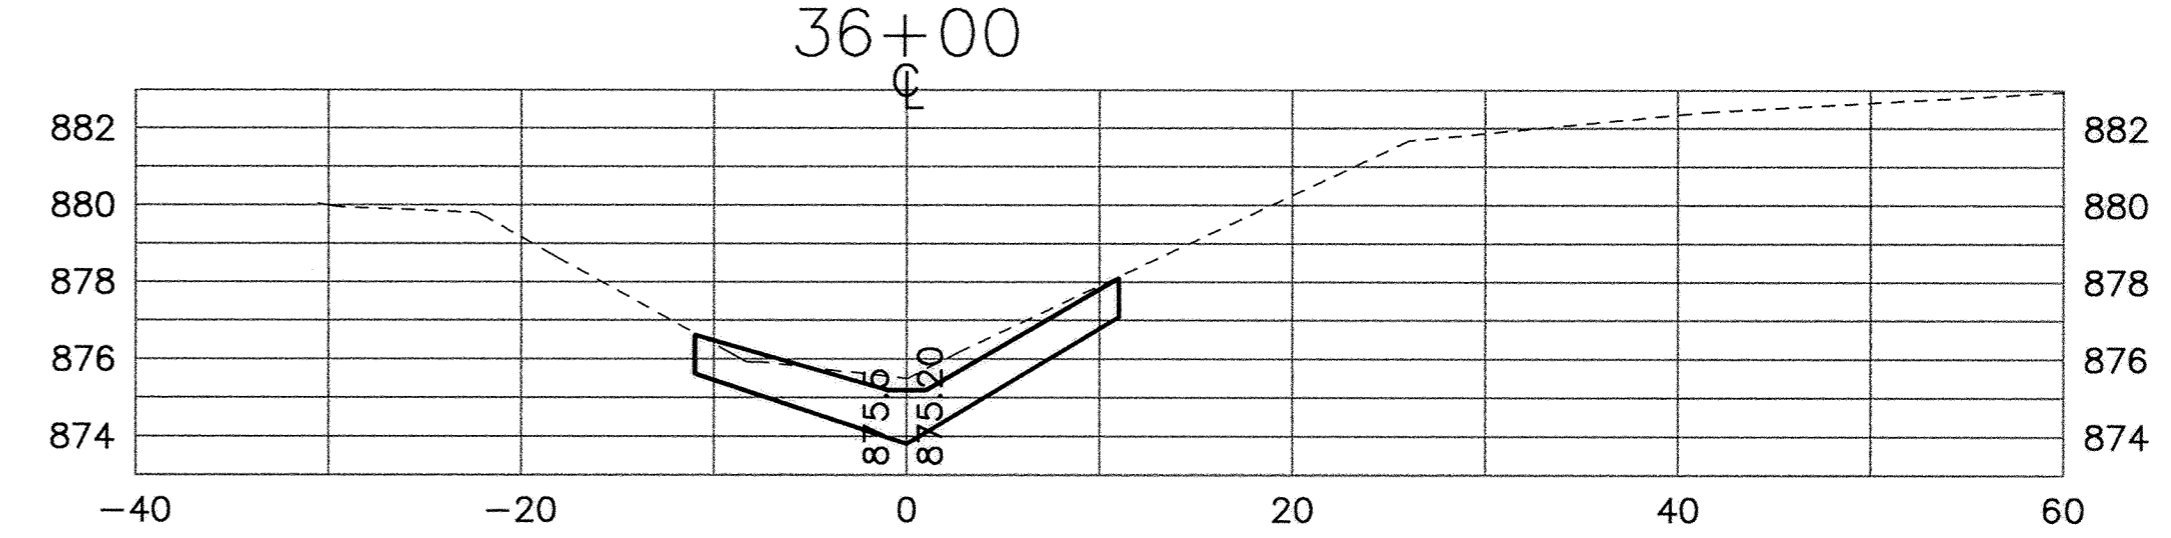


STATION	AREAS Square Feet		VOLUMES Cubic Yards		CUMULATIVE VOLUMES Cubic Yards	
	CUT	FILL	CUT	FILL	CUT	FILL
13+00	137.92	0.00	366.82	0.00	366.82	0.00
13+50	258.24	0.00	440.91	0.00	807.73	0.00
14+00	217.94	0.00	382.46	0.00	1190.20	0.00
14+50	195.12	0.00	337.92	0.00	1528.11	0.00
15+00	169.83	0.00	304.73	0.00	1832.84	0.00
15+50	159.28	0.00	298.31	0.00	2131.15	0.00
16+00	162.89	0.00	306.68	0.00	2437.83	0.00
16+50	168.32	0.00	328.50	0.00	2766.33	0.00
17+00	186.46	0.00	358.65	0.00	3124.98	0.00
17+50	200.88	0.00	364.18	0.00	3489.17	0.00
18+00	192.44	0.00	346.02	0.00	3835.19	0.00
18+50	181.27	0.00	309.11	0.00	4144.30	0.00
19+00	152.57	0.00	279.12	0.00	4423.42	0.00
19+50	148.88	0.00	283.65	0.00	4707.07	0.00
20+00	157.45	0.00	294.36	0.00	5001.43	0.00
20+50	160.45	0.00	272.28	0.00	5273.70	0.00
21+00	133.61	0.00	321.61	0.00	5595.31	0.00
21+50	213.73	0.00	406.98	0.00	6002.29	0.00
22+00	225.80	0.00	721.35	0.00	6723.64	0.00
22+50	553.26	0.00	1011.73	0.00	7735.38	0.00
23+00	539.41	0.00	679.38	0.00	8414.76	0.00
23+50	194.32	0.00	304.80	0.00	8719.55	0.00
24+00	134.87	0.00	260.95	0.00	8980.50	0.00
24+50	146.95	0.00	282.12	0.00	9262.62	0.00
25+00	157.73	0.00	301.38	0.00	9564.00	0.00
25+50	167.76	0.00	307.82	0.00	9871.82	0.00
26+00	164.68	0.00	312.71	0.00	10184.53	0.00
26+50	173.04	0.00	333.17	0.00	10517.71	0.00
27+00	186.78	0.00	359.64	0.00	10877.34	0.00
27+50	201.63	0.00	386.72	0.00	11264.06	0.00
28+00	216.03	0.00	409.43	0.00	11673.49	0.00
28+50	226.16	0.00	402.60	0.00	12076.09	0.00
29+00	208.66	0.00	389.74	0.00	12465.83	0.00
29+50	212.26	0.00	384.70	0.00	12850.53	0.00
30+00	203.22	0.00	388.05	0.00	13238.58	0.00
30+50	215.87	0.00	413.64	0.00	13652.22	0.00
31+00	230.86	0.00	536.10	0.00	15167.87	0.00
31+50	262.12	0.00	480.49	0.00	15648.36	0.00
32+00	302.83	0.00	411.50	0.00	16059.85	0.00
32+50	276.17	0.00	411.50	0.00	16059.85	0.00
33+00	242.76	0.00	411.50	0.00	16059.85	0.00
33+50	201.66	0.00	325.81	0.03	16385.66	0.03
34+00	150.22	0.03	246.33	0.54	16631.99	0.57
34+50	115.81	0.56	178.45	3.28	16810.44	3.84
35+00	76.92	2.98	106.54	9.04	16916.98	12.88
35+50	38.15	6.78	47.72	16.69	16964.71	29.57
36+00	13.39	11.25	17.07	24.46	16981.77	54.04
36+50	5.04	15.17	0.00	0.00	16981.77	54.04

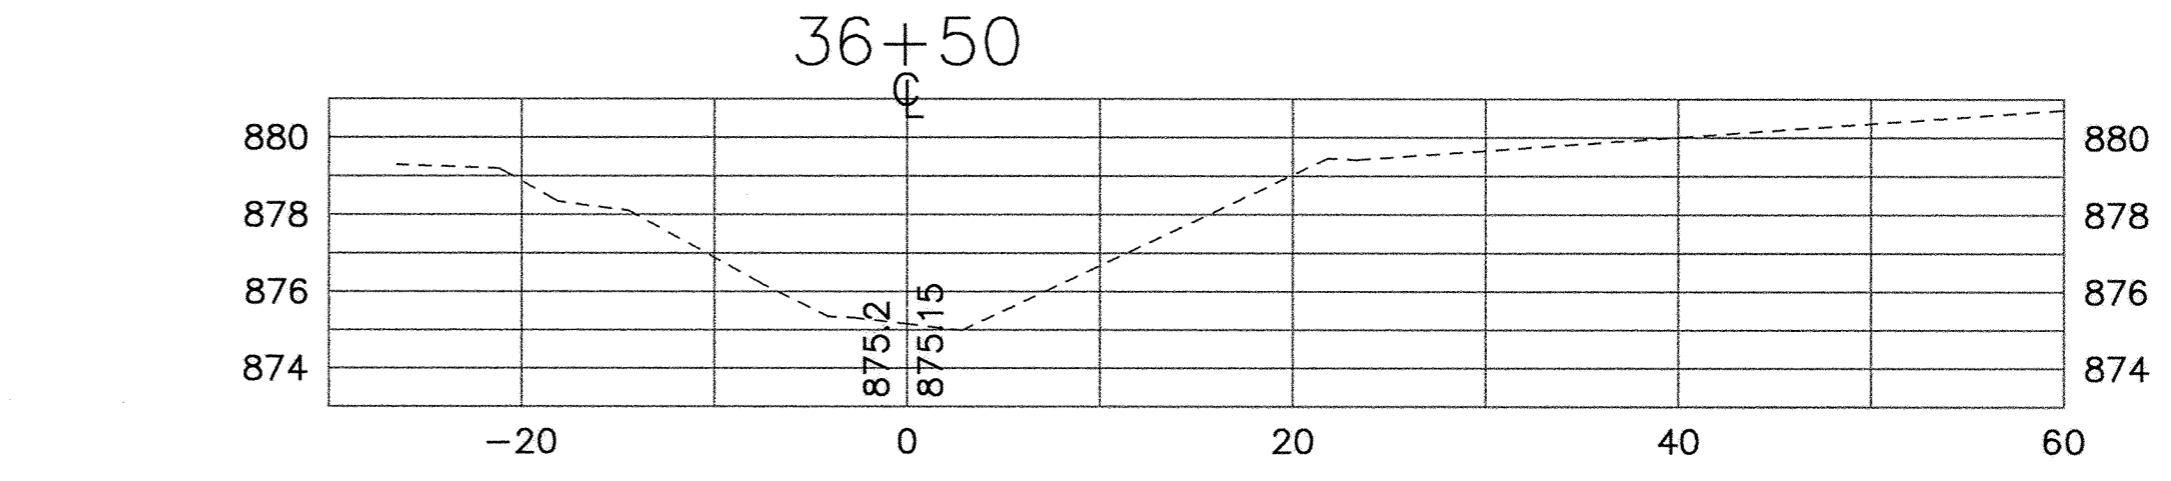

RECORD PLAN  
JANUARY 1996

I HEREBY CERTIFY THAT THIS PLAN, SPECIFICATION, OR REPORT WAS PREPARED BY ME OR UNDER MY DIRECT SUPERVISION AND THAT I AM A DULY REGISTERED PROFESSIONAL ENGINEER UNDER THE LAWS OF THE STATE OF MINNESOTA. <i>Mark V. Guhman</i> DATE <u>5/25/95</u> REG. NO. <u>19130</u>		1326 ENERGY PARK DRIVE ST. PAUL, MINNESOTA 55108 (612) 644-4389  5075 WAYZATA BLVD. SUITE #225 MINNEAPOLIS, MINNESOTA 55416 (612) 546-0432	DATE _____ DESCRIPTION _____	DESIGNED _____ CHECKED _____ DRAWN _____	CITY OF ELK RIVER MAIN STREET / EVANS AVENUE STORM SEWER CONSTRUCTION DITCH SECTIONS 35+00 TO 36+50	DATE MAY 1995 SHEET 14A OF 18 SHEETS PROJECT NO. 230-265
			REVISIONS _____	GRAPHIC SCALE 0 10 0 VERT. 5		

DRAWING NUMBER

DRAWING NUMBER

DRAWING NUMBER

DRAWING NUMBER  
MAINS 95  
14A