




TYPICAL URBAN SECTION (MAIN STREET)  
STA. 8+70 TO 9+25

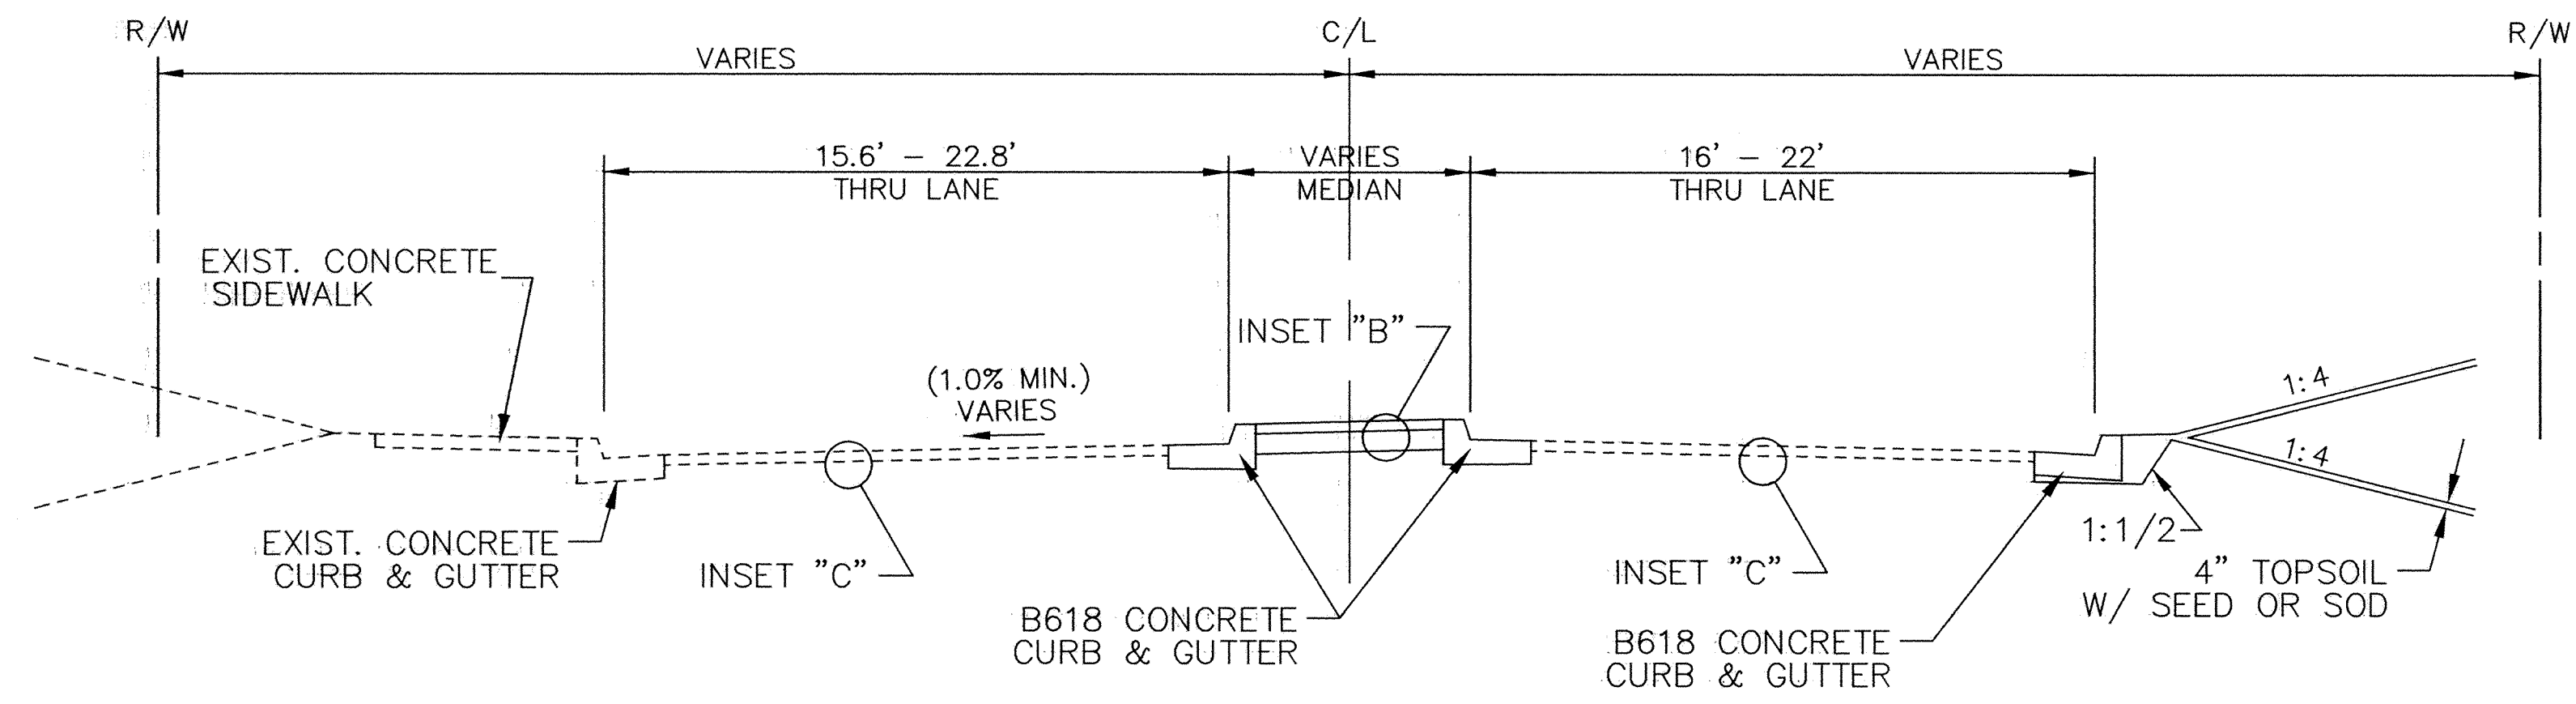


PROPOSED  
TYPICAL BITUMINOUS  
MILL SECTION

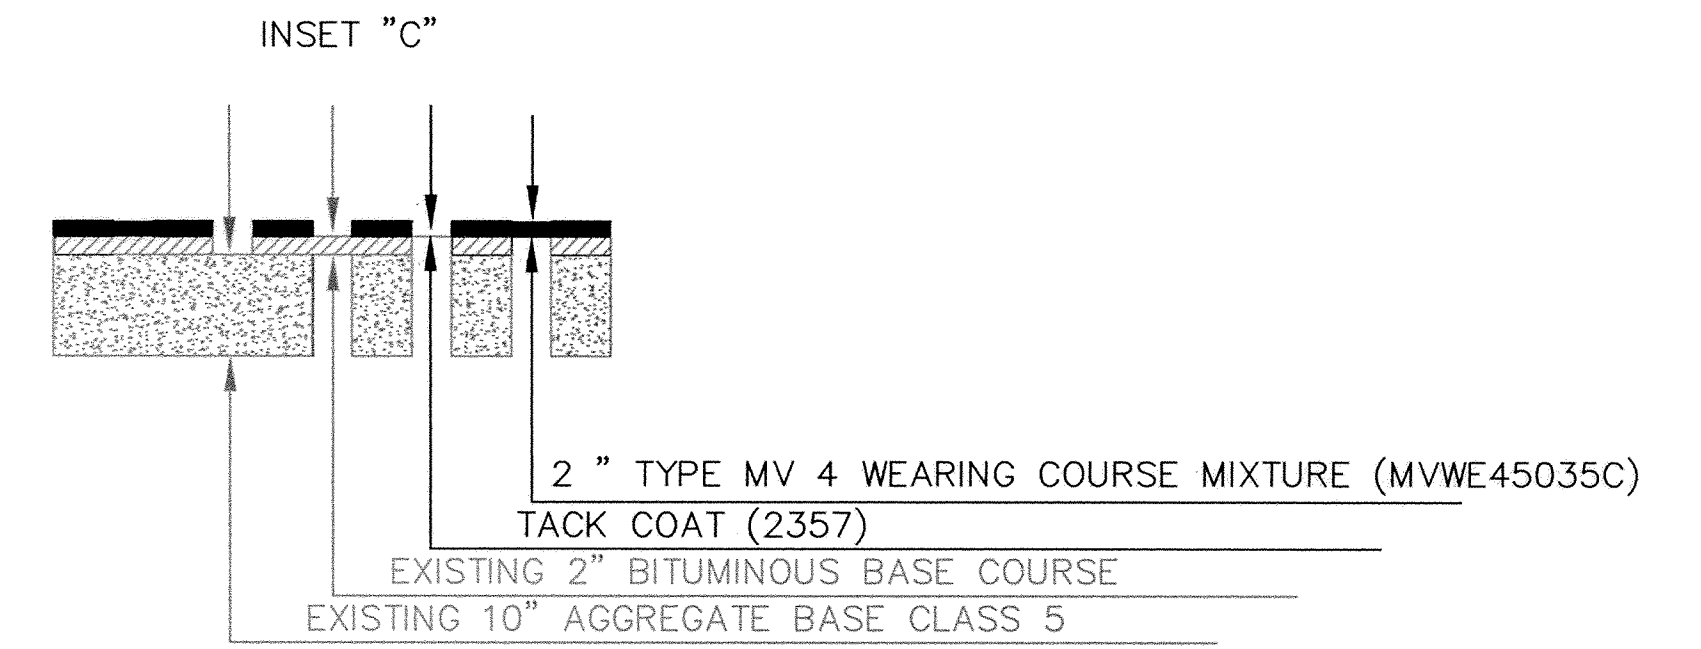


TYPICAL URBAN SECTION (MAIN STREET)  
STA. 9+75 TO 11+50

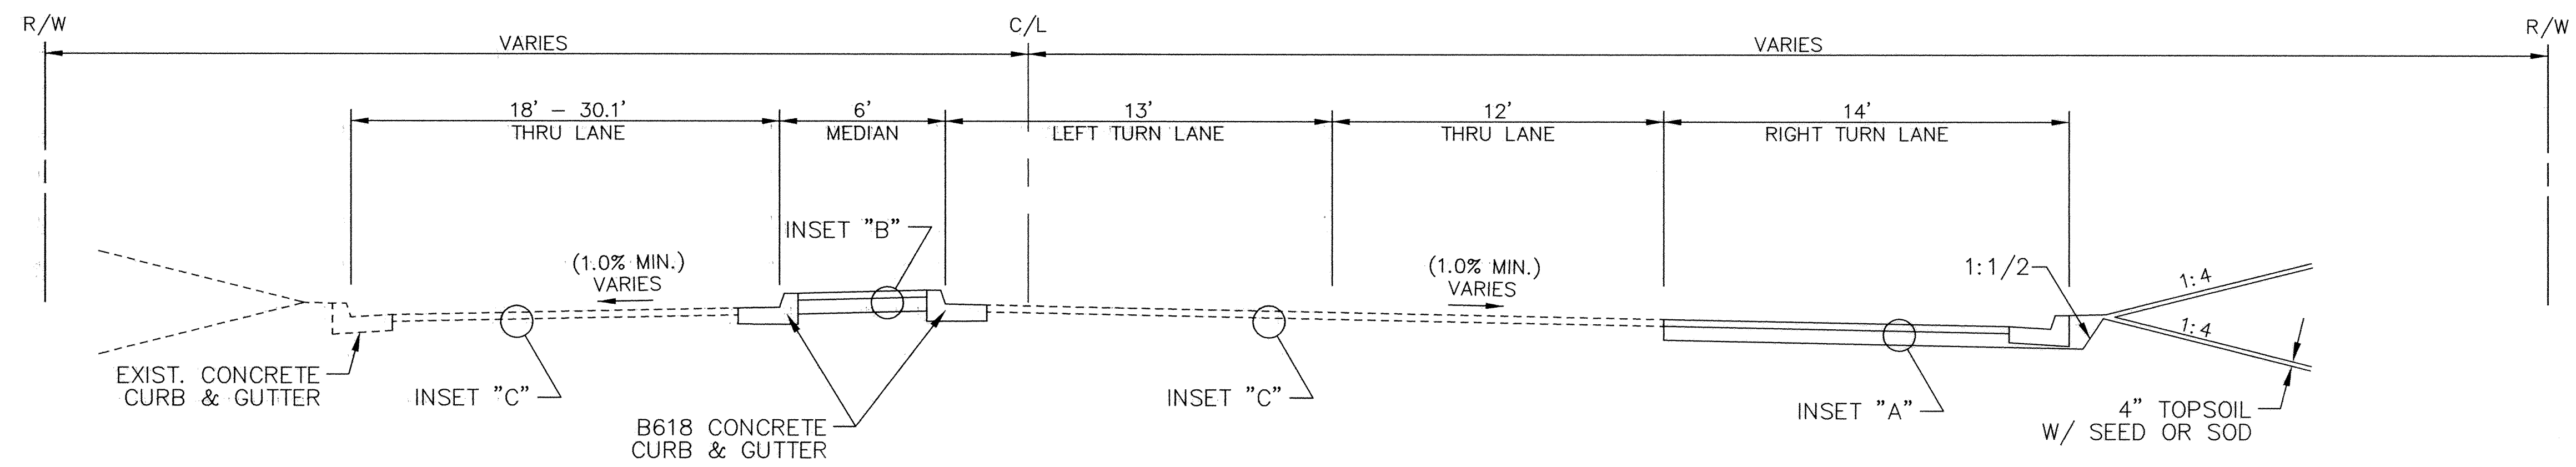


TYPICAL SECTION

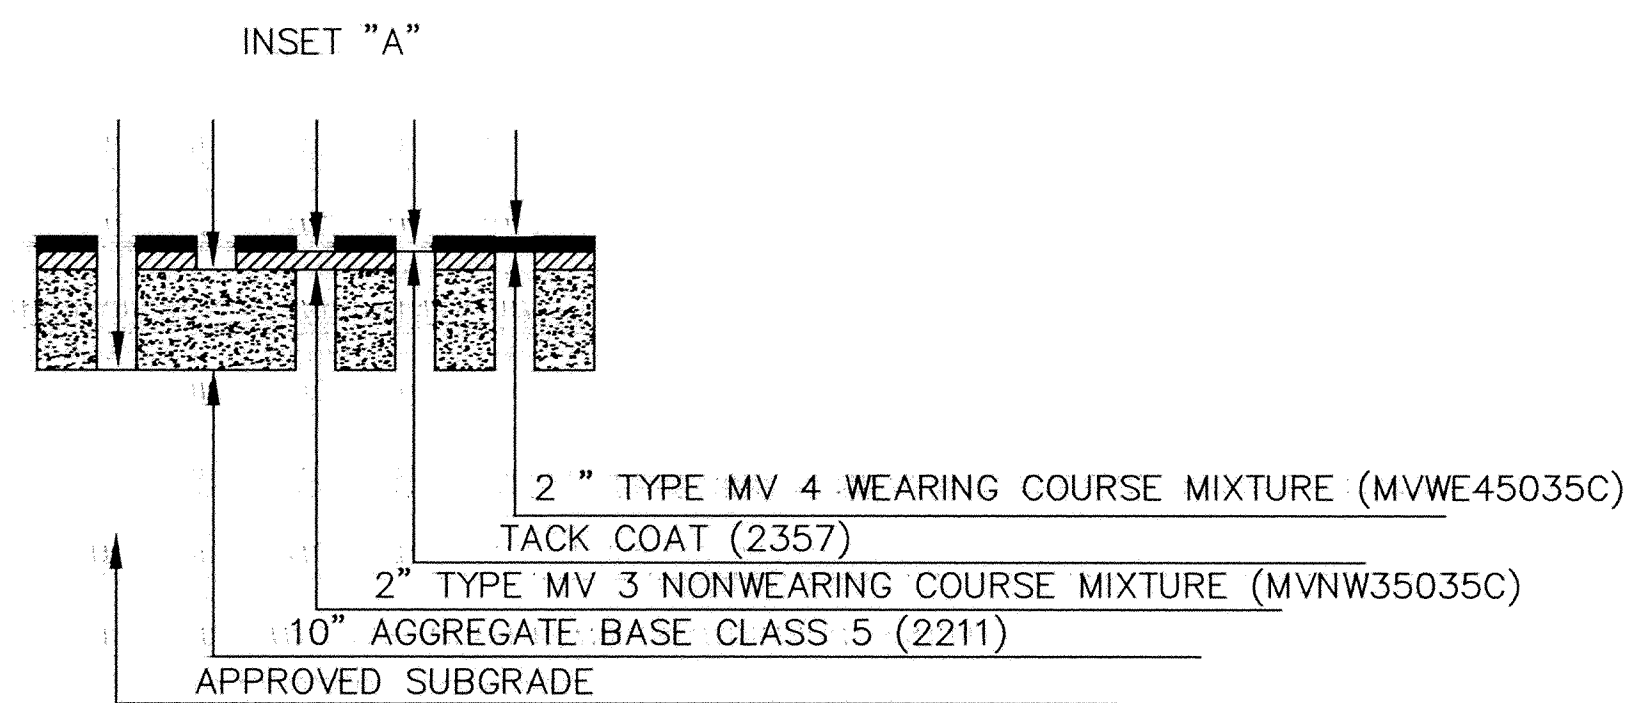

TYPICAL CONCRETE  
MEDIAN SECTION

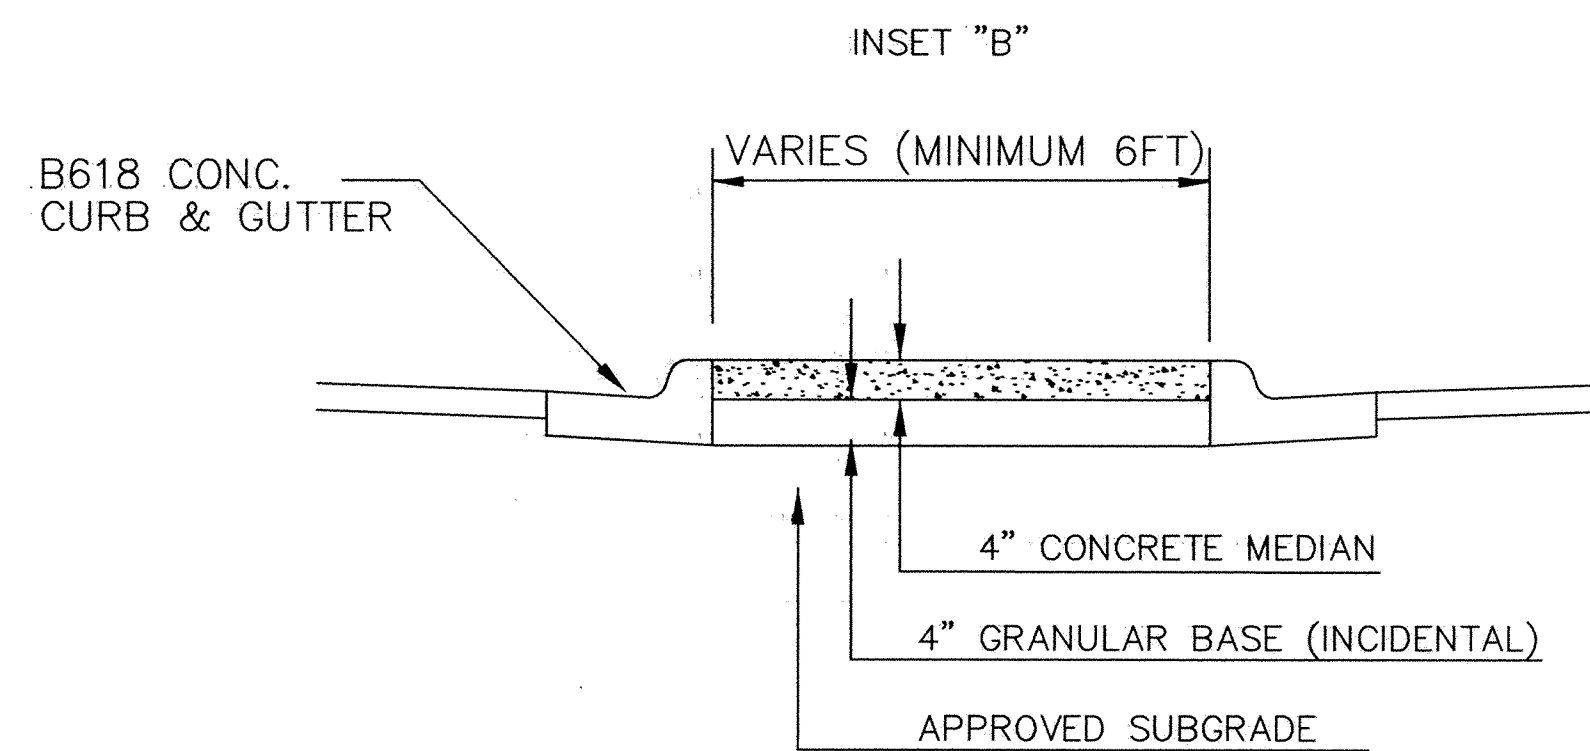

EXISTING  
TYPICAL BITUMINOUS  
MILL SECTION

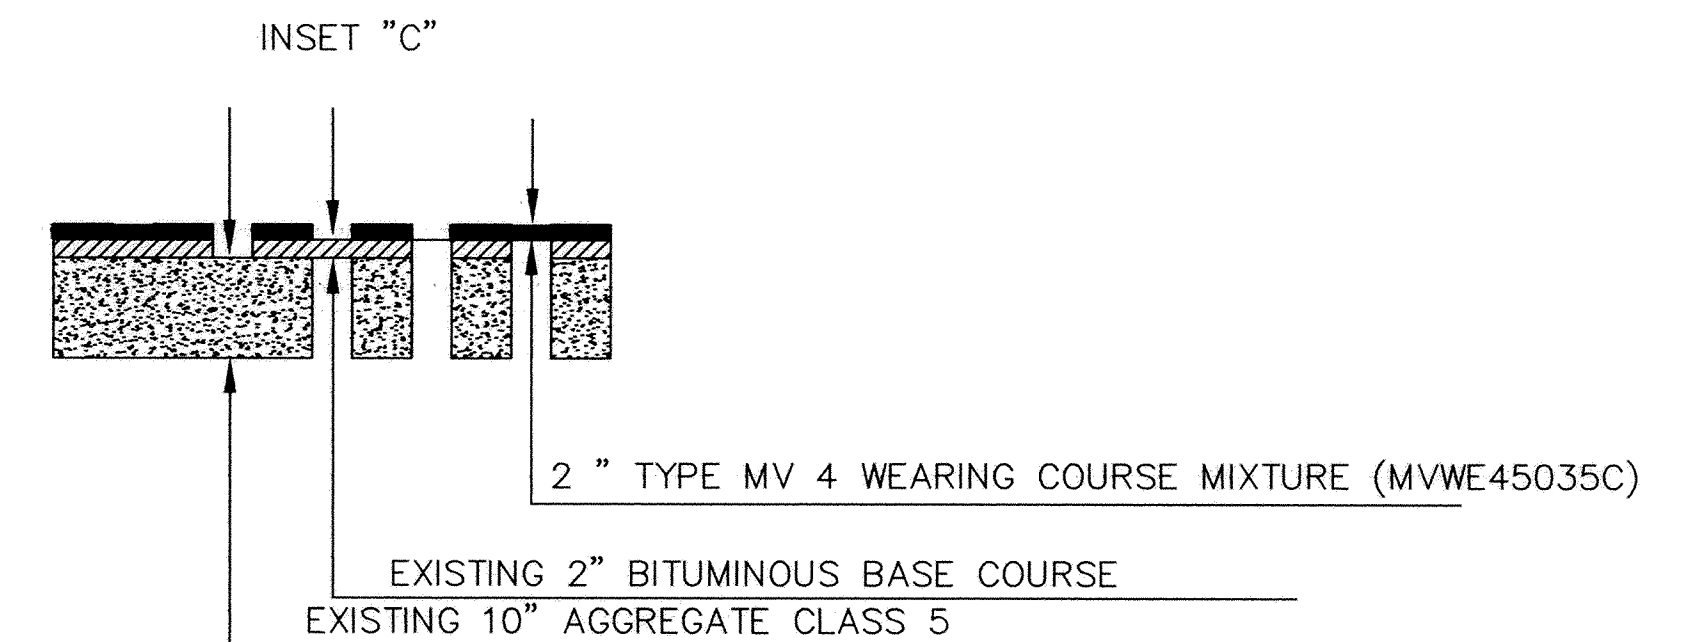


**RECORD PLAN**  
**JANUARY 2005**

DESIGNED BY: KT/EY DRAWN BY: EY  
APPROVED BY: \_\_\_\_\_ JOB NUMBER 816600J  
CAD DATE: January 11, 2005 9:42:25 a.m.  
CAD FILE: 816600\ASBUILT\MISC\816600-TYP.DWG (JOUNIN)

I HEREBY CERTIFY THAT THIS PLAN, SPECIFICATION, OR REPORT WAS PREPARED BY ME OR UNDER MY DIRECT SUPERVISION AND THAT I AM A DULY LICENSED PROFESSIONAL ENGINEER UNDER THE LAWS OF THE STATE OF MINNESOTA.  
SIGNATURE \_\_\_\_\_ DATE \_\_\_\_\_  
PRINTED NAME JOHN ANDERSON LIC. NO. 25889

NO.	DATE	BY	REVISION DESCRIPTION

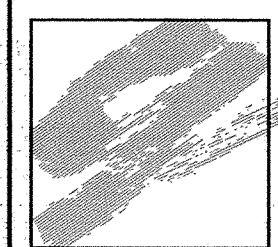

Howard R. Green Company

1326 ENERGY PARK DRIVE  
ST. PAUL, MINNESOTA 55108  
(651) 644-4389

MAIN STREET/U.S. HIGHWAY NO. 10  
CITY OF ELK RIVER

TYPICAL SECTIONS

S.P. 204-113-12

SHEET NO.

**3**