


RECORD PLAN
JANUARY 2005

Xrefs: XCT-BASE.DWG
 DESIGNED BY: EY DRAWN BY: EY
 APPROVED BY: _____ JOB NUMBER 816600J
 CAD DATE: January 06, 2005 9:54:10 a.m.
 CAD FILE: 816600\ASBUILT\816600P-PU.DWG (JCUNNIN)

I HEREBY CERTIFY THAT THIS PLAN, SPECIFICATION, OR REPORT WAS PREPARED BY ME OR UNDER MY DIRECT SUPERVISION AND THAT I AM A DULY LICENSED PROFESSIONAL ENGINEER UNDER THE LAWS OF THE STATE OF MINNESOTA.
 SIGNATURE: *John Anderson* DATE: 2/2/05
 PRINTED NAME: JOHN ANDERSON LIC. NO.: 25889

NO.	DATE	BY	REVISION DESCRIPTION

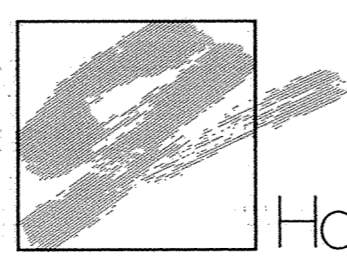

Howard R. Green Company
 1326 ENERGY PARK DRIVE
 ST. PAUL, MINNESOTA 55108
 (651) 644-4389

MAIN STREET/U.S. HIGHWAY NO. 10
CITY OF ELK RIVER

STORM SEWER IMPROVEMENTS
 S.P. 204-113-12
 8+40 TO 14+70

SHEET NO.
10