


MAIN STREET

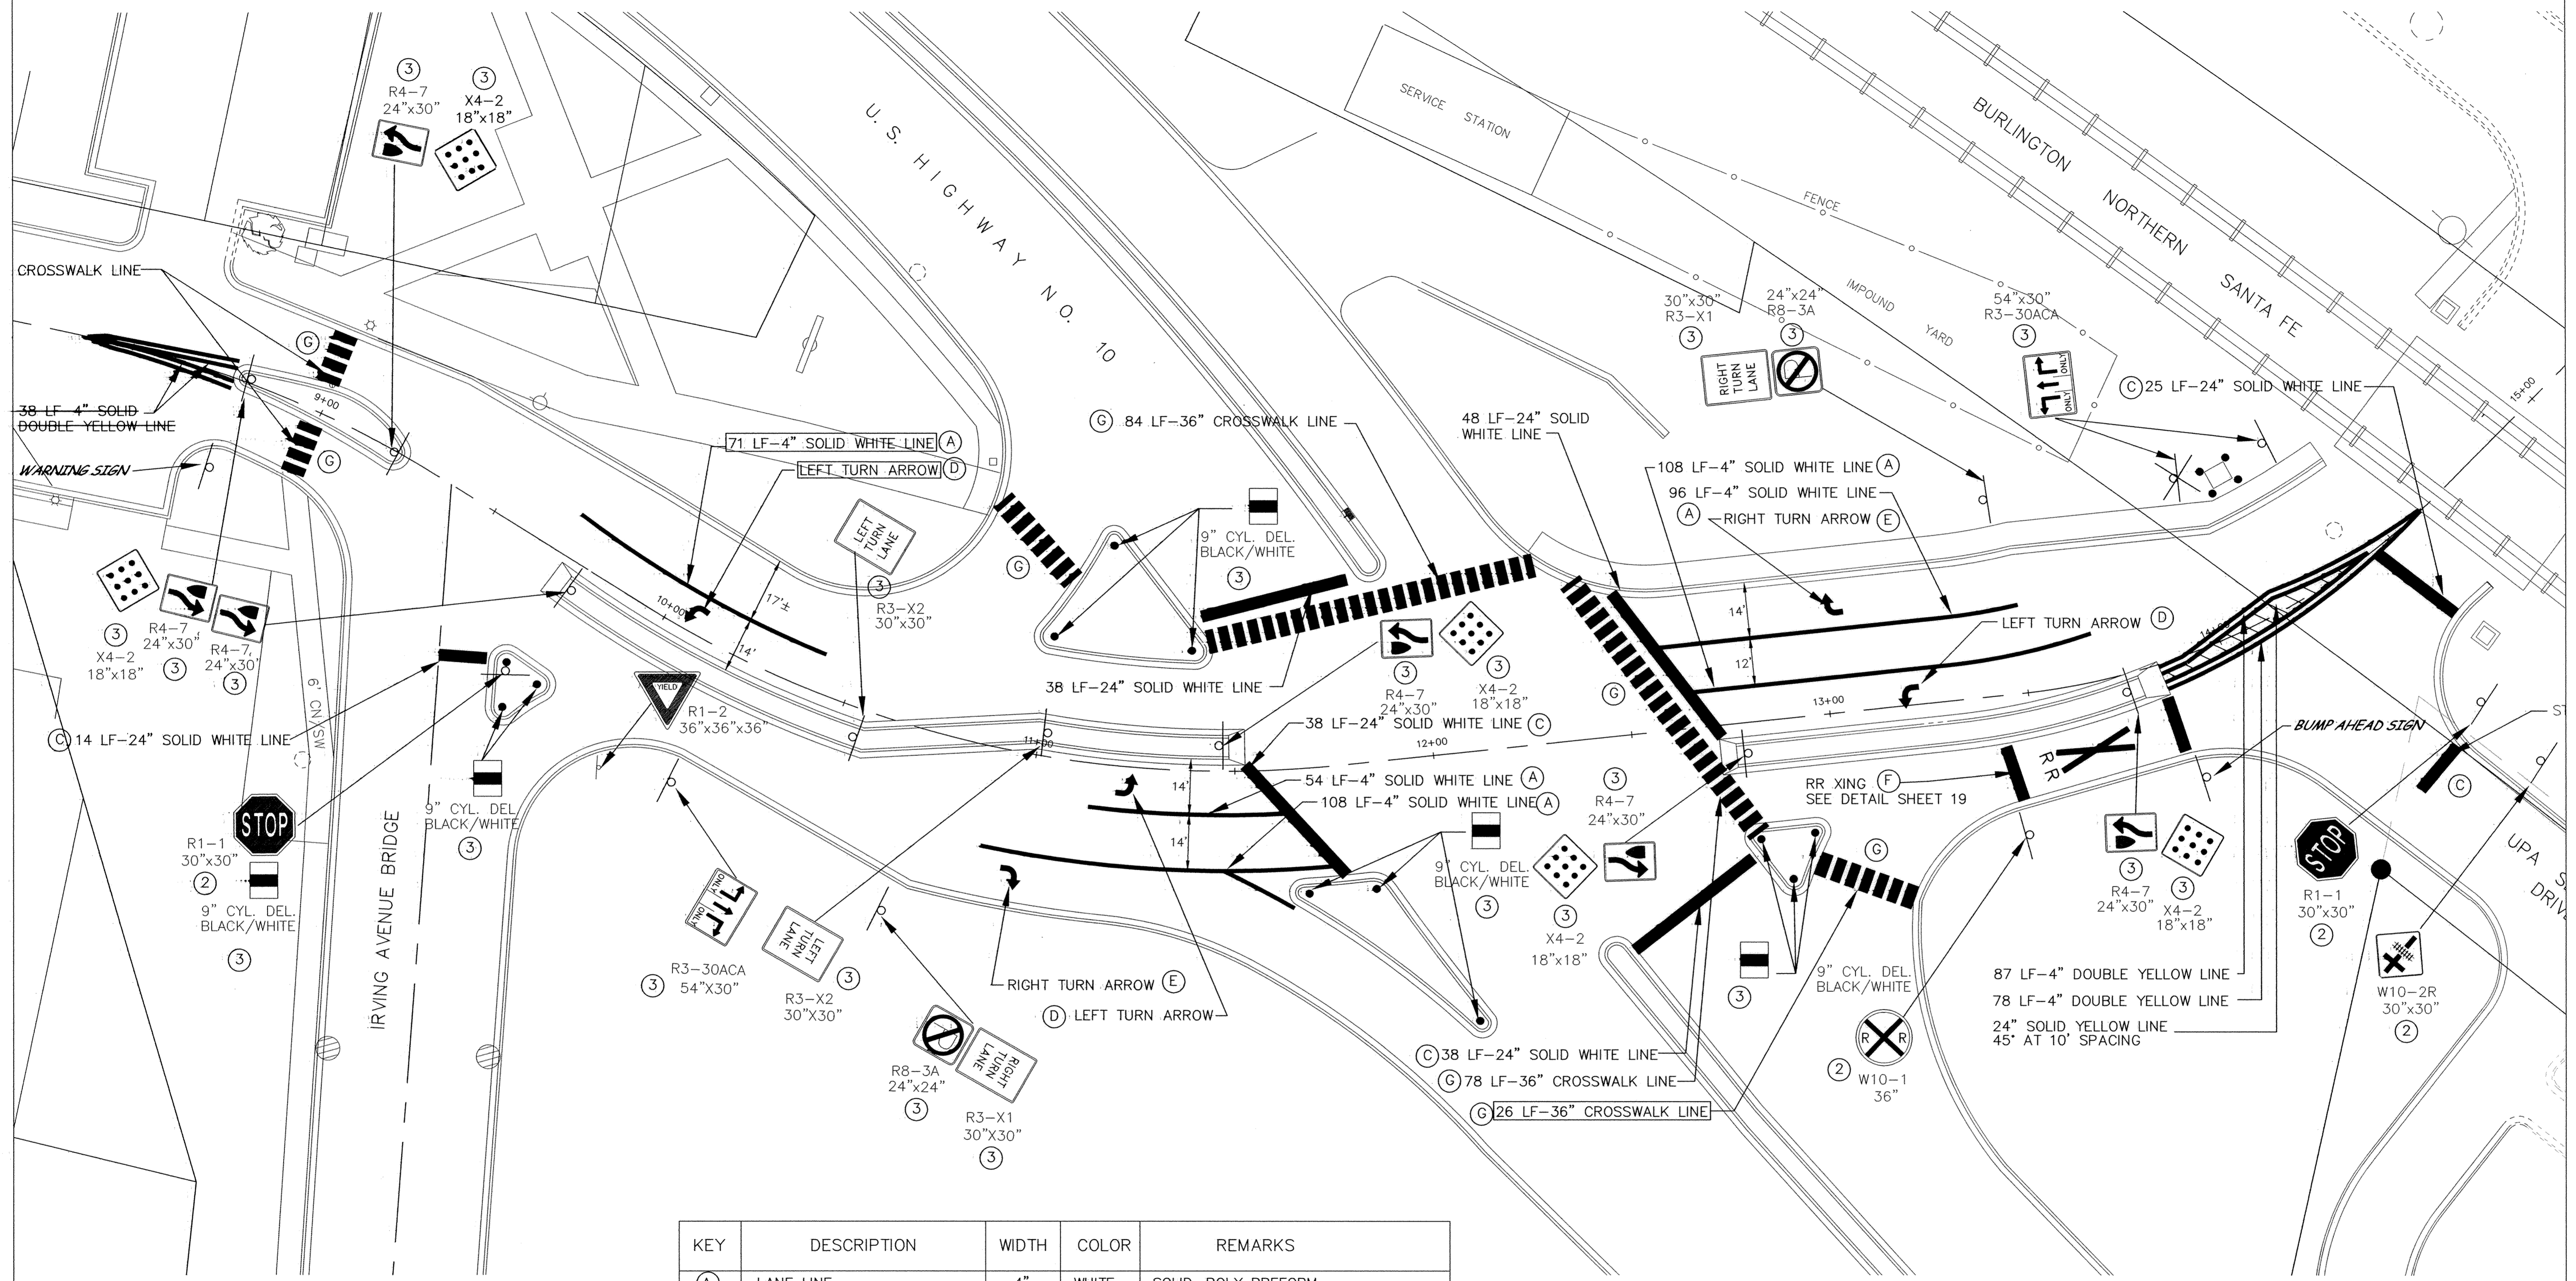


KEY	DESCRIPTION	WIDTH	COLOR	REMARKS
(A)	LANE LINE	4"	WHITE	SOLID, POLY PREFORM
(B)	TAPER STRIPING	24"	YELLOW	SOLID-45', 20' GAP
(C)	STOP BAR	24"	WHITE	SOLID, POLY PREFORM
(D)	LEFT TURN ARROW	8'	WHITE	SOLID, POLY PREFORM
(E)	RIGHT TURN ARROW	8'	WHITE	SOLID, POLY PREFORM
(F)	RR XING	N.A.	WHITE	SEE DETAIL SHEET 19
(G)	ZEBRA CROSSWALK	36"	WHITE	POLY PREFORM, SEE DETAIL SHEET 19

SIGN LEGEND

- ① INPLACE SIGN-REMOVE
- ② INPLACE SIGN-REMOVE AND INSTALL NEW
- ③ FURNISH AND INSTALL

RECORD PLAN
JANUARY 2005

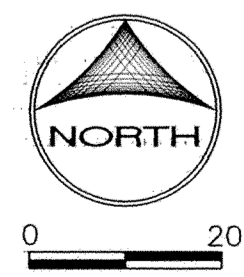

DESIGNED BY: EY DRAWN BY: EY
 APPROVED BY: _____ JOB NUMBER 816600J
 CAD DATE: January 11, 2005 11:11:39 a.m.
 CAD FILE: 816600\ASBUILT\MISC\816600-SS1.DWG (JUNNIN)

I HEREBY CERTIFY THAT THIS PLAN, SPECIFICATION, OR REPORT WAS PREPARED BY ME OR UNDER MY DIRECT SUPERVISION AND THAT I AM A DULY LICENSED PROFESSIONAL ENGINEER UNDER THE LAWS OF THE STATE OF MINNESOTA.

SIGNATURE _____ DATE _____
 PRINTED NAME JOHN ANDERSON LIC. NO. 25889

NO.	DATE	BY	REVISION DESCRIPTION

1326 ENERGY PARK DRIVE
 ST. PAUL, MINNESOTA 55108
 (651) 644-4389

Howard R. Green Company

MAIN STREET/U.S. HIGHWAY NO. 10
CITY OF ELK RIVER

SIGNING AND STRIPING PLAN

S.P. 204-113-12

8+40 TO 14+70

SHEET NO.

14