



# PUBLIC IMPROVEMENTS

McCHESNEY INDUSTRIAL PLAT

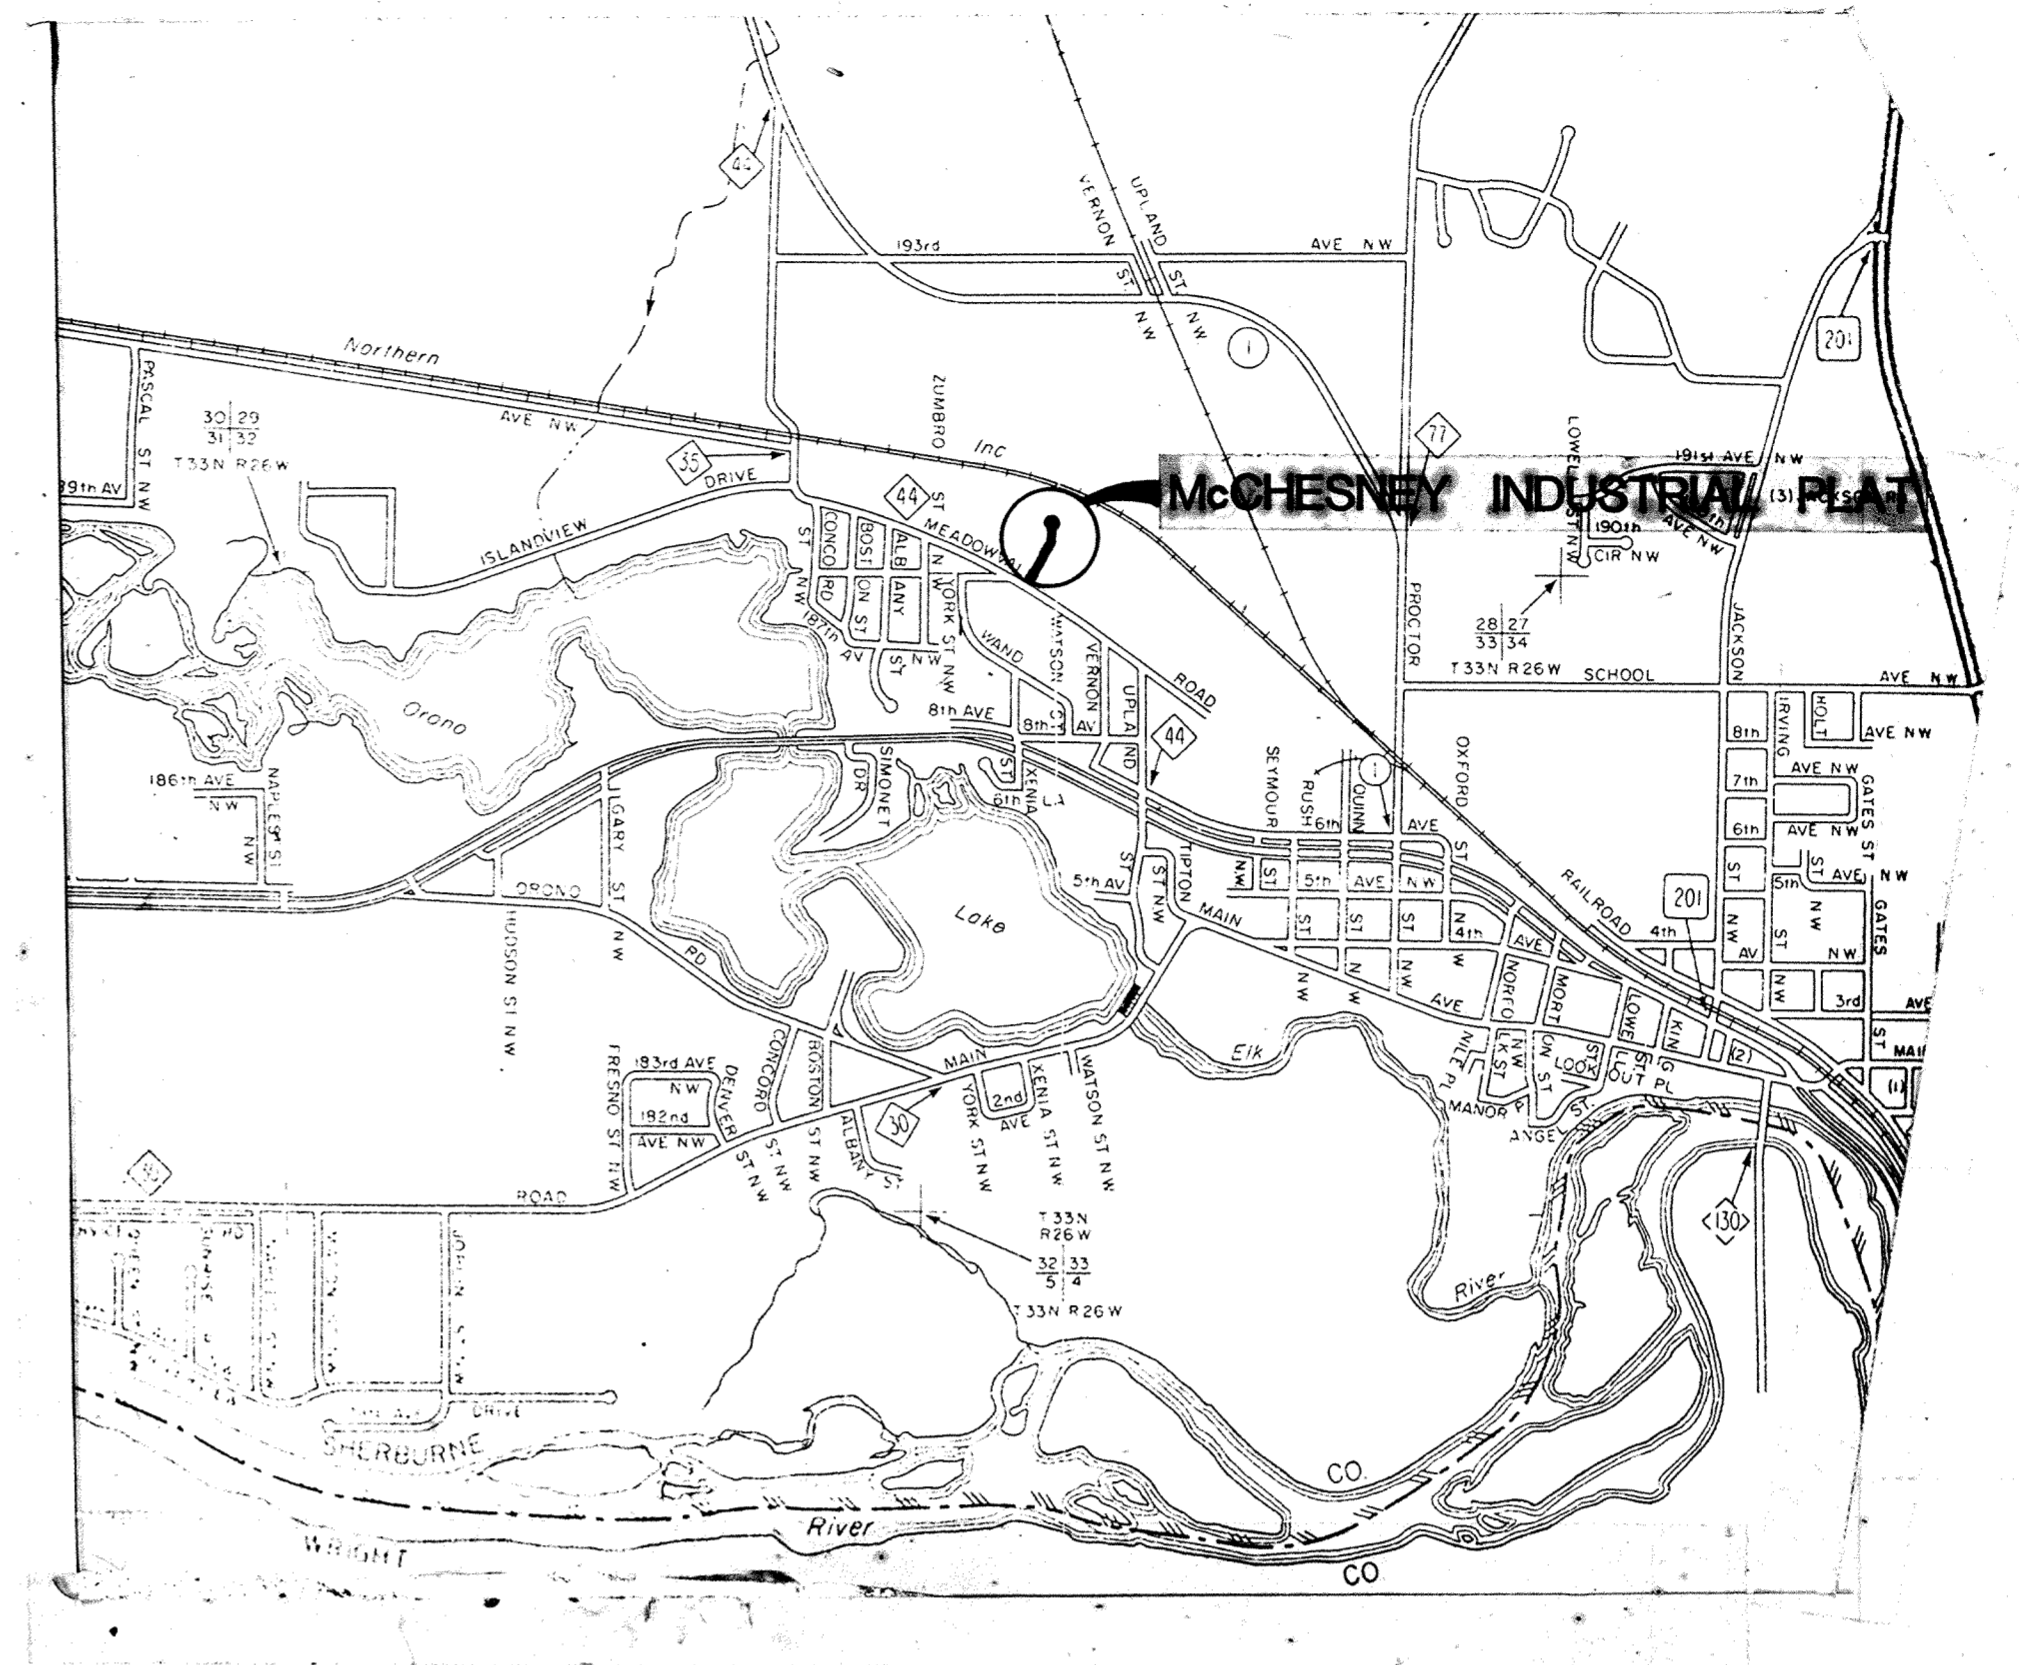

# CITY OF ELK RIVER

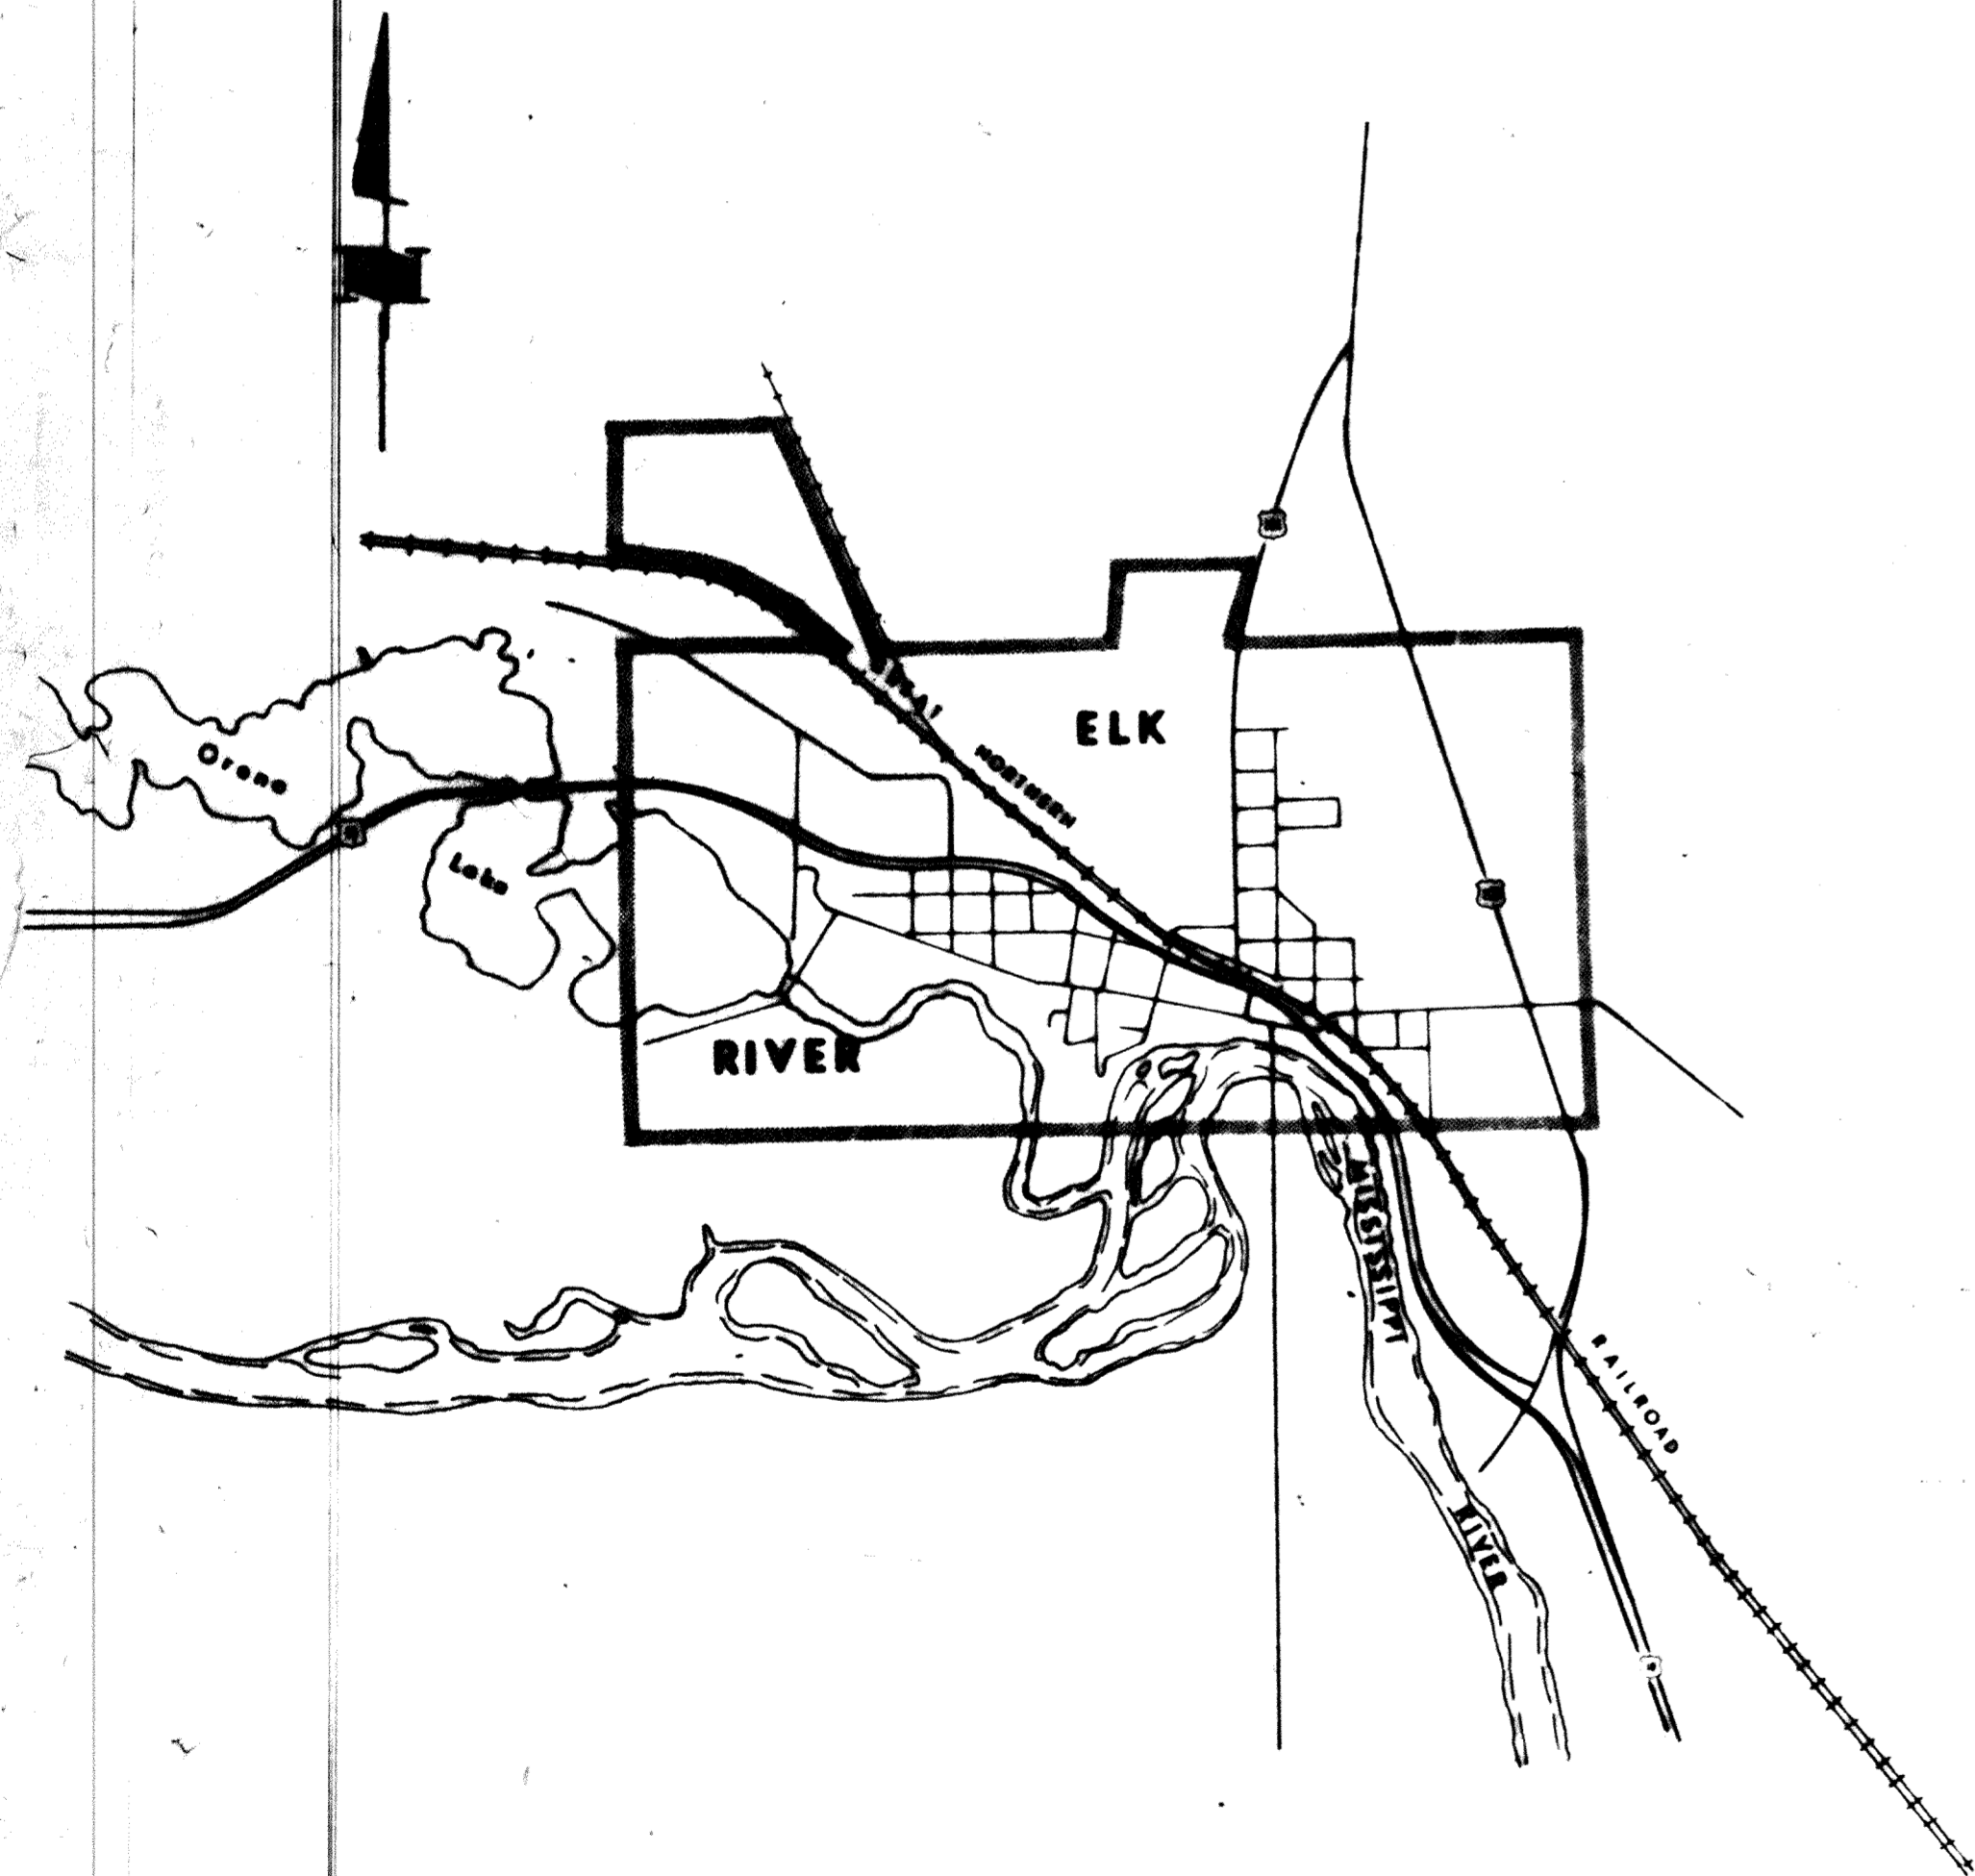

consulting engineers diversified inc.

P.O. Box J, Osseo, Minnesota 55369

I hereby certify that this plan, specification or report was prepared by me or under my direct supervision and that I am a duly Registered Professional Engineer under State of Minnesota Statutes Sections 326.02 to 326.16

*Jeffrey D. Ross*  
Date July 17, 1979 Minnesota Registration No. 10206

AS-BUILT Date 9/1/80

*McChesney Industrial Plat  
1979  
Pg. 1-3*

DRAWING NUMBER

DRAWING NUMBER

DRAWING NUMBER

DRAWING NUMBER  
MOCHE/79  
1

CO. PRODUCTS • NEW HOPE, MINNESOTA  
REGISTERED BY PAINT NUMBER 6243  
PROFESSIONAL ENGINEER OF MINN.

SACCO PRODUCTS • NEW HOPE, MINNESOTA  
REGISTERED BY PAINT NUMBER 6243  
PROFESSIONAL ENGINEER OF MINN.

SACCO PRODUCTS • NEW HOPE, MINNESOTA  
REGISTERED BY PAINT NUMBER 6243  
PROFESSIONAL ENGINEER OF MINN.

SACCO PRODUCTS • NEW HOPE, MINNESOTA  
REGISTERED BY PAINT NUMBER 6243  
PROFESSIONAL ENGINEER OF MINN.