

THE MEADOWS OF ELK RIVER

ELK RIVER, MINNESOTA

== AULIK AND ASSOCIATES INC. ==

GRADING PLAN, STORM SEWER & STREET IMPROVEMENTS

AS-BUILT COMMENTS by: MIKE JURICICH
BDM-ELK RIVER
8-30-2006

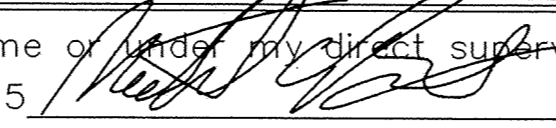
NO WATER OR SANITARY

Approved for Construction: _____
Terry Maurer, City Engineer

Civil Engineering
Land Surveying
Land Planning

John Oliver & Associates, Inc.

580 Dodge Avenue, Elk River, Minnesota 55330 763-441-2072, Fax 763-441-5665
Offices in: Elk River, Burnsville and Brooklyn Center, Minnesota

I hereby certify that this plan, specification, or report was prepared by me or under my direct supervision and that I am a duly Licensed Professional Engineer under State of Mn. Statutes Sections 326.02-326.15.  Date 12/22/2005 Lic. No. 42661

Michael C. Brandt, PE

REV. NO.	DATE	REVISIONS	SHEETS REVISED
1	01/16/06	CITY COMMENTS	ALL
2	01/27/06	CITY COMMENTS	ALL
3	02/16/06	CITY COMMENTS	ALL
4	12/20/06	RECORD DRAWINGS	ALL

1 / 6

DRAWING NUMBER

DRAWING NUMBER

DRAWING NUMBER

DRAWING NUMBER
MEADLK.06

SAFCO PRODUCTS • NEW HOPE, MINNESOTA
REGISTERED BY PART NUMBER 8592
NATIONAL BOARD OF PROFESSIONAL ENGINEERS