


NOTE:  
ALL SANITARY SEWER SHALL  
BE PVC ASTM 3034, SDR 35  
UNLESS OTHERWISE INDICATED.

# LANDER STREET

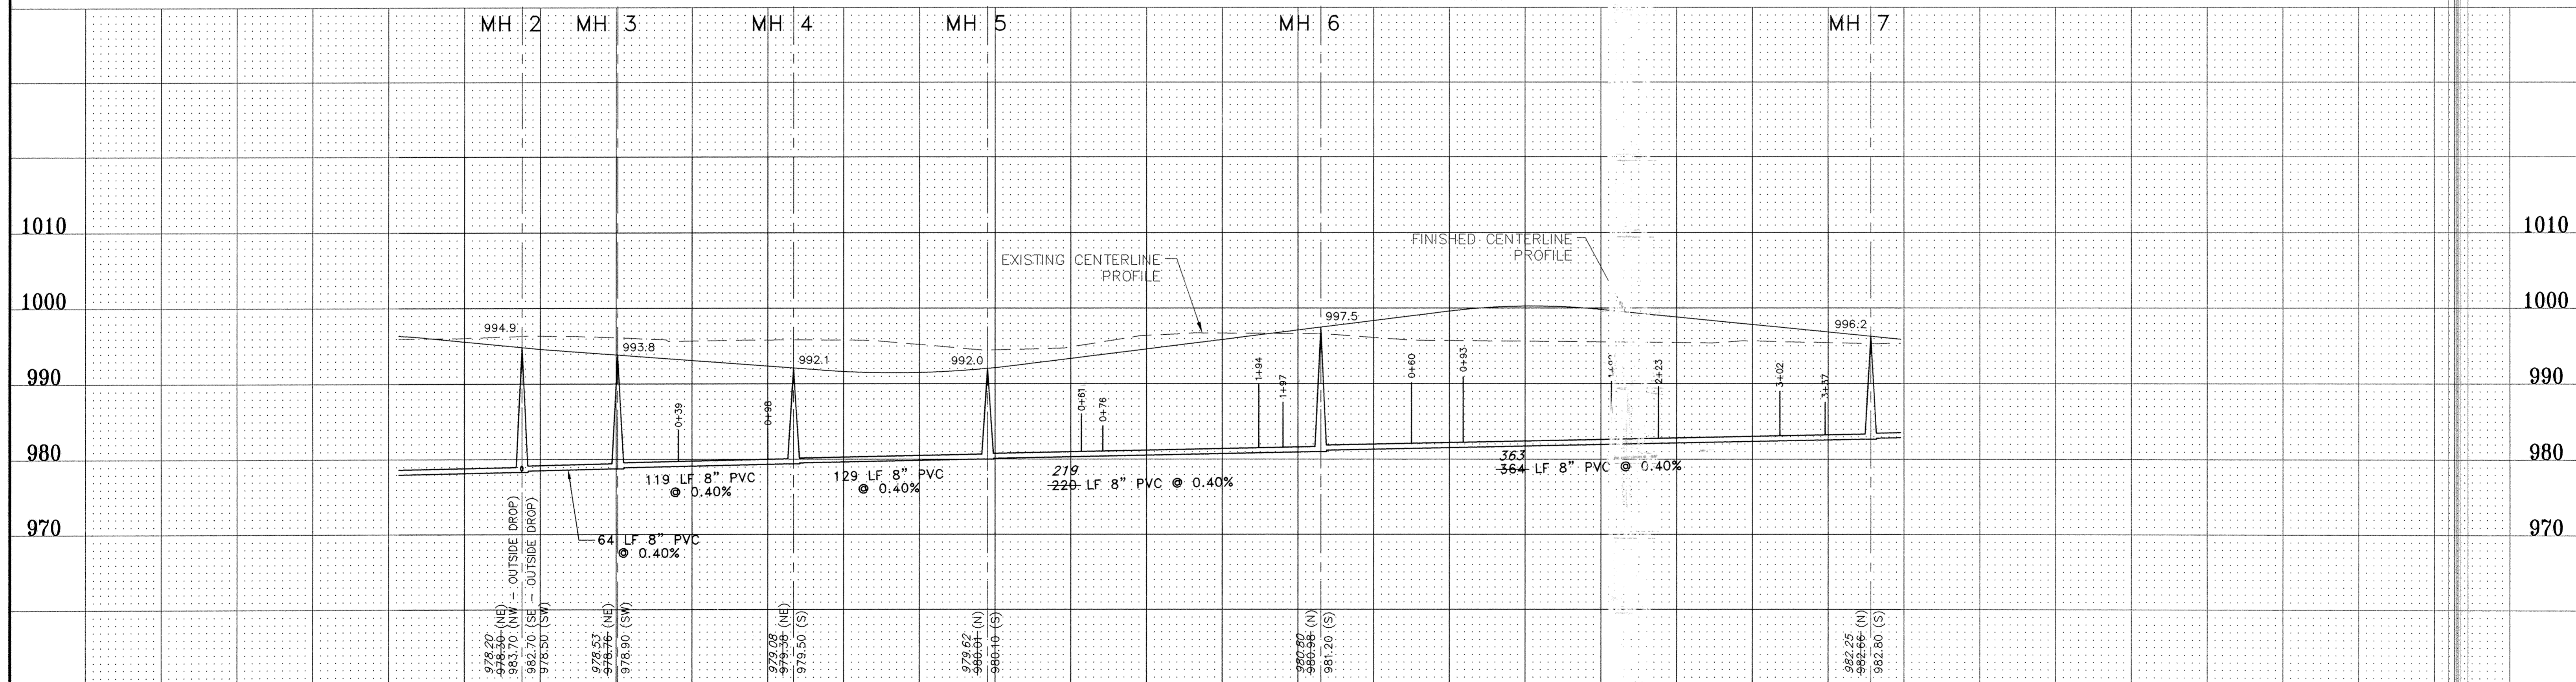

RECORD PLAN

**Revisions**

No.	Date	By	Remarks
A	1/06/05	MRJ	RECORD PLAN REVISIONS

I hereby certify that this plan was prepared by me or under my direct supervision and that I am a duly Registered Professional Engineer under the laws of the State of Minnesota.

Name: Paul Pearson Paul Pearson  
Date: 03/14/01  
Registration Number: 12795

Scale 1"=10' VERT  
1"=50' HORIZ

Designed: PWP  
Drawn: JHR  
Date: 03/14/01  
Checked: PWP  
Approved:



Engineering • Planning • Surveying

15050 23rd Avenue North • Plymouth, Minnesota • 55447  
phone 612/476-6010 • fax 612/476-8532  
E-Mail: cadd@mfra.com

Client  
**Lyman Development**  
Excelsior, MN

Project  
**Meadowoods Village**  
Elk River, MN

Sheet Title  
**Sanitary Sewer Plan & Profile**  
LANDER STREET

Sheet	Revision
9/17	A

MFRA FILE NO.: 12896