



SAICO PRODUCTS • NEW HOPK, MINNESOTA
RESUBMIT BY PART NUMBER 6532
MINNESOTA BOARD OF PROFESSIONAL ENGINEERS

DENVER COURT

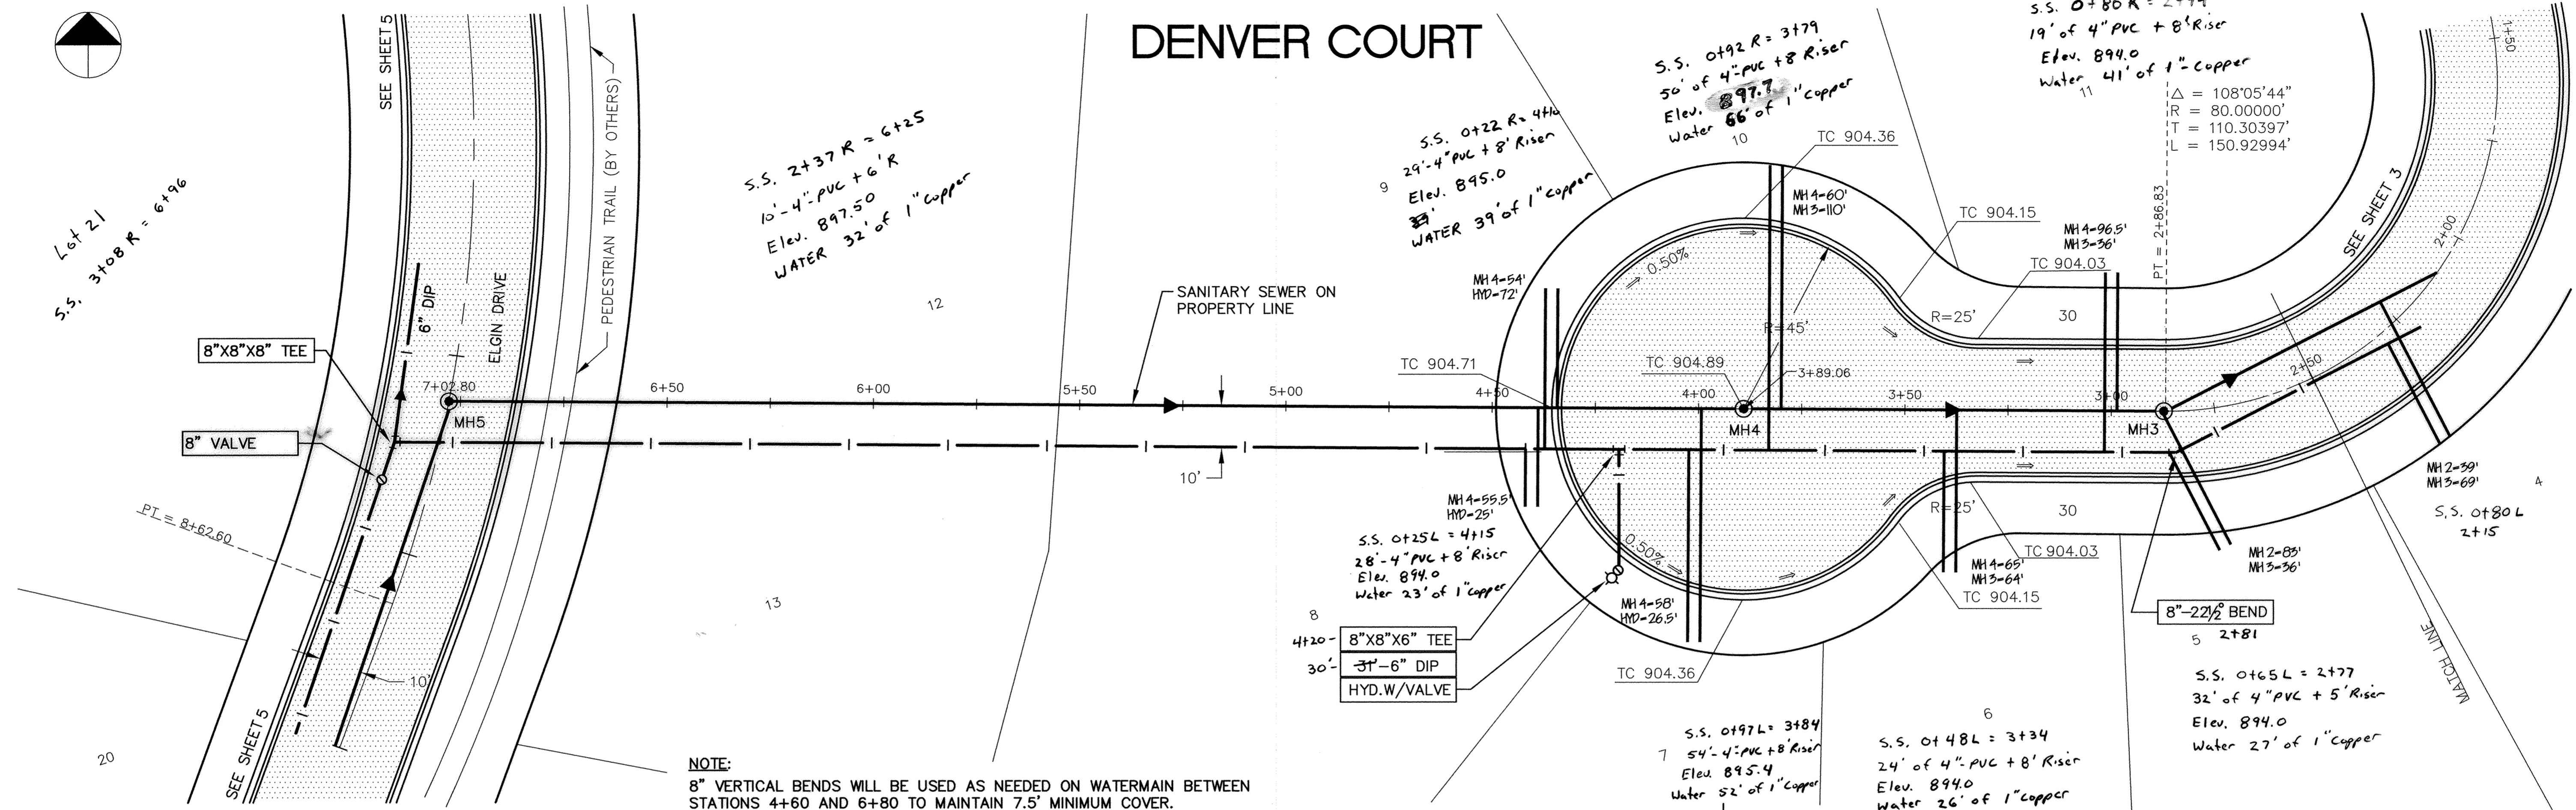

NOTE:
 8" VERTICAL BENDS WILL BE USED AS NEEDED ON WATERMAIN BETWEEN STATIONS 4+60 AND 6+80 TO MAINTAIN 7.5' MINIMUM COVER.

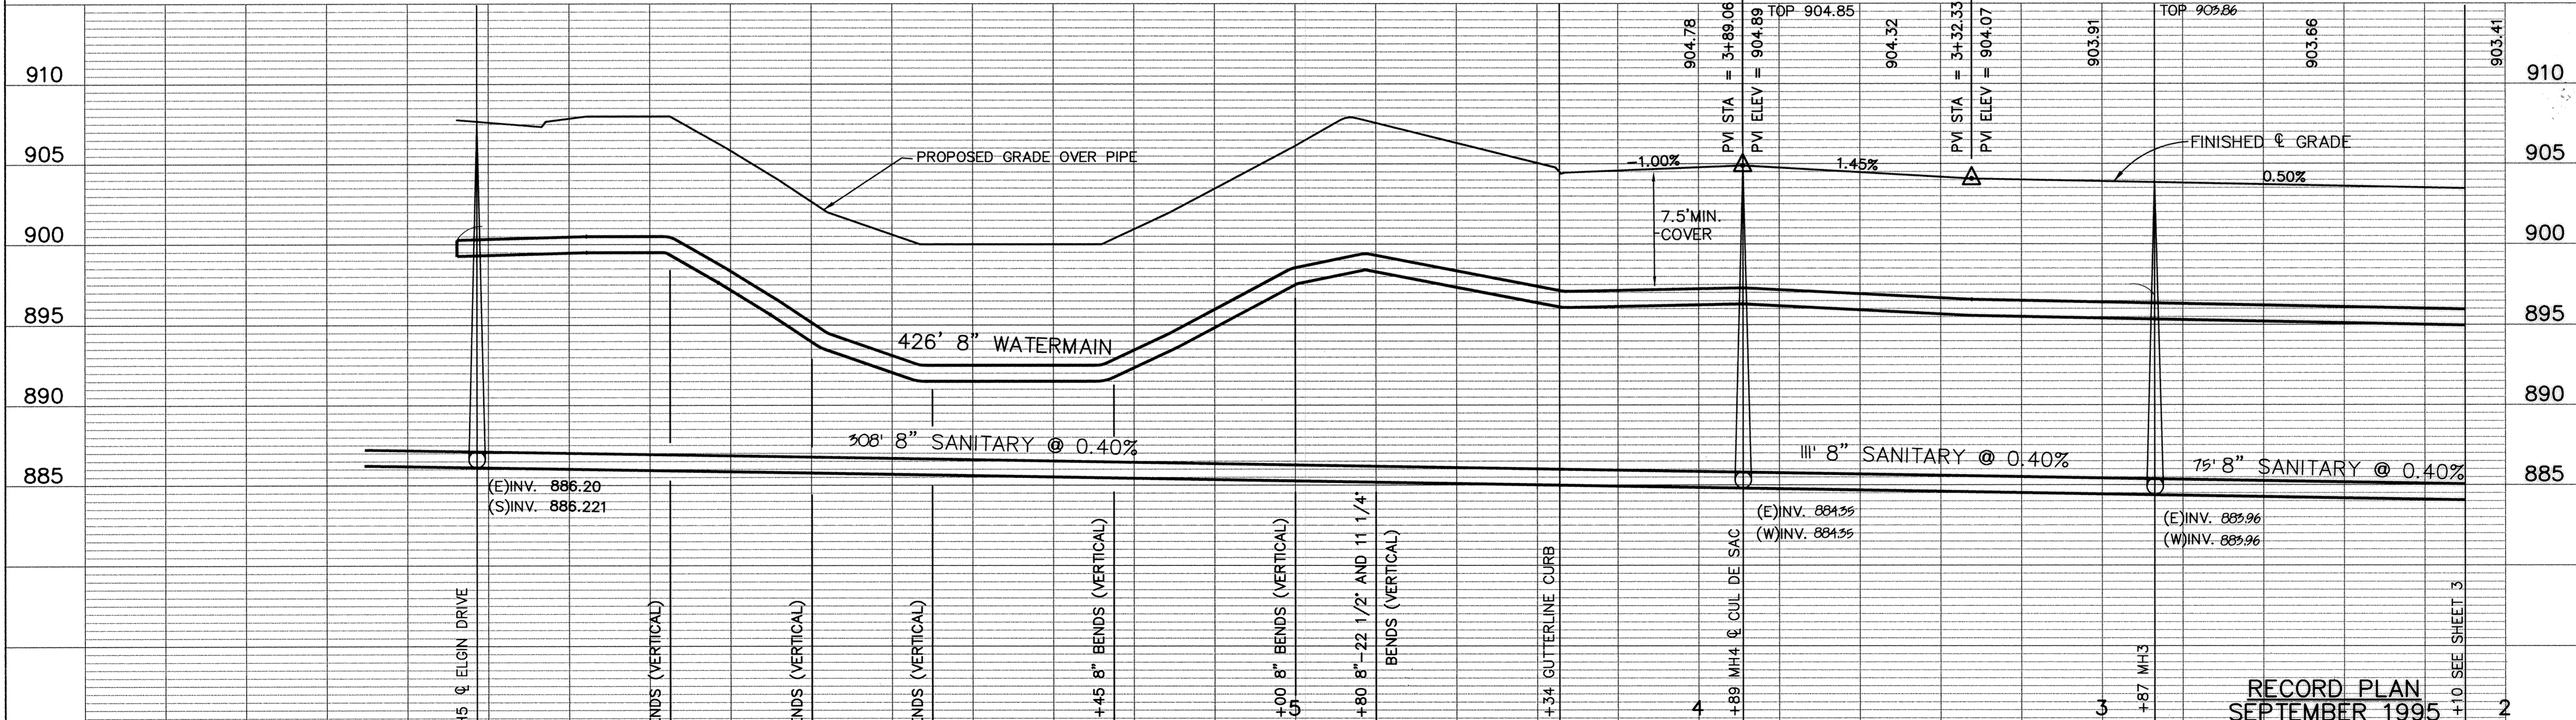

REVISIONS	DATE	DESCRIPTION	DESIGNED	CHECKED	DRAWN
2/95	2/95	GRADE REVISIONS BETWEEN 2+10-4+34	MYG	RB	IC
2/95	2/95	ADDED 8" BENDS FROM STATION 4+40-6+60			

GRAPHIC SCALE	DATE	SHEET	PROJECT NO.
0 HORIZ. 20 0 VERT. 5	FEB, 1994	4 OF 13 SHEETS	230-208

I HEREBY CERTIFY THAT THIS PLAN, SPECIFICATION, OR REPORT WAS PREPARED BY ME OR UNDER MY DIRECT SUPERVISION AND THAT I AM A DULY REGISTERED PROFESSIONAL ENGINEER UNDER THE LAWS OF THE STATE OF MINNESOTA.
Mark Graham
 DATE 2/16/95 REG. NO. 19130



1326 ENERGY PARK DRIVE
 ST. PAUL, MINNESOTA 55108
 (612) 644-4389
 9800 SHELARD PARKWAY
 MINNEAPOLIS, MINNESOTA 55441
 (612) 546-0432

RECORD PLAN
SEPTEMBER 1995
 CITY OF ELK RIVER
 STREET AND UTILITY IMPROVEMENTS
 DENVER COURT