


**NOTE:**  
 THE LIFT STATION MUST BE OPERATIONAL BY NOVEMBER 15, 1993. TEMPORARY EQUIPMENT MUST BE PROVIDED, NECESSARY, TO MEET THIS DEADLINE.

**LIFT STATION PLAN**  
 1"=2'

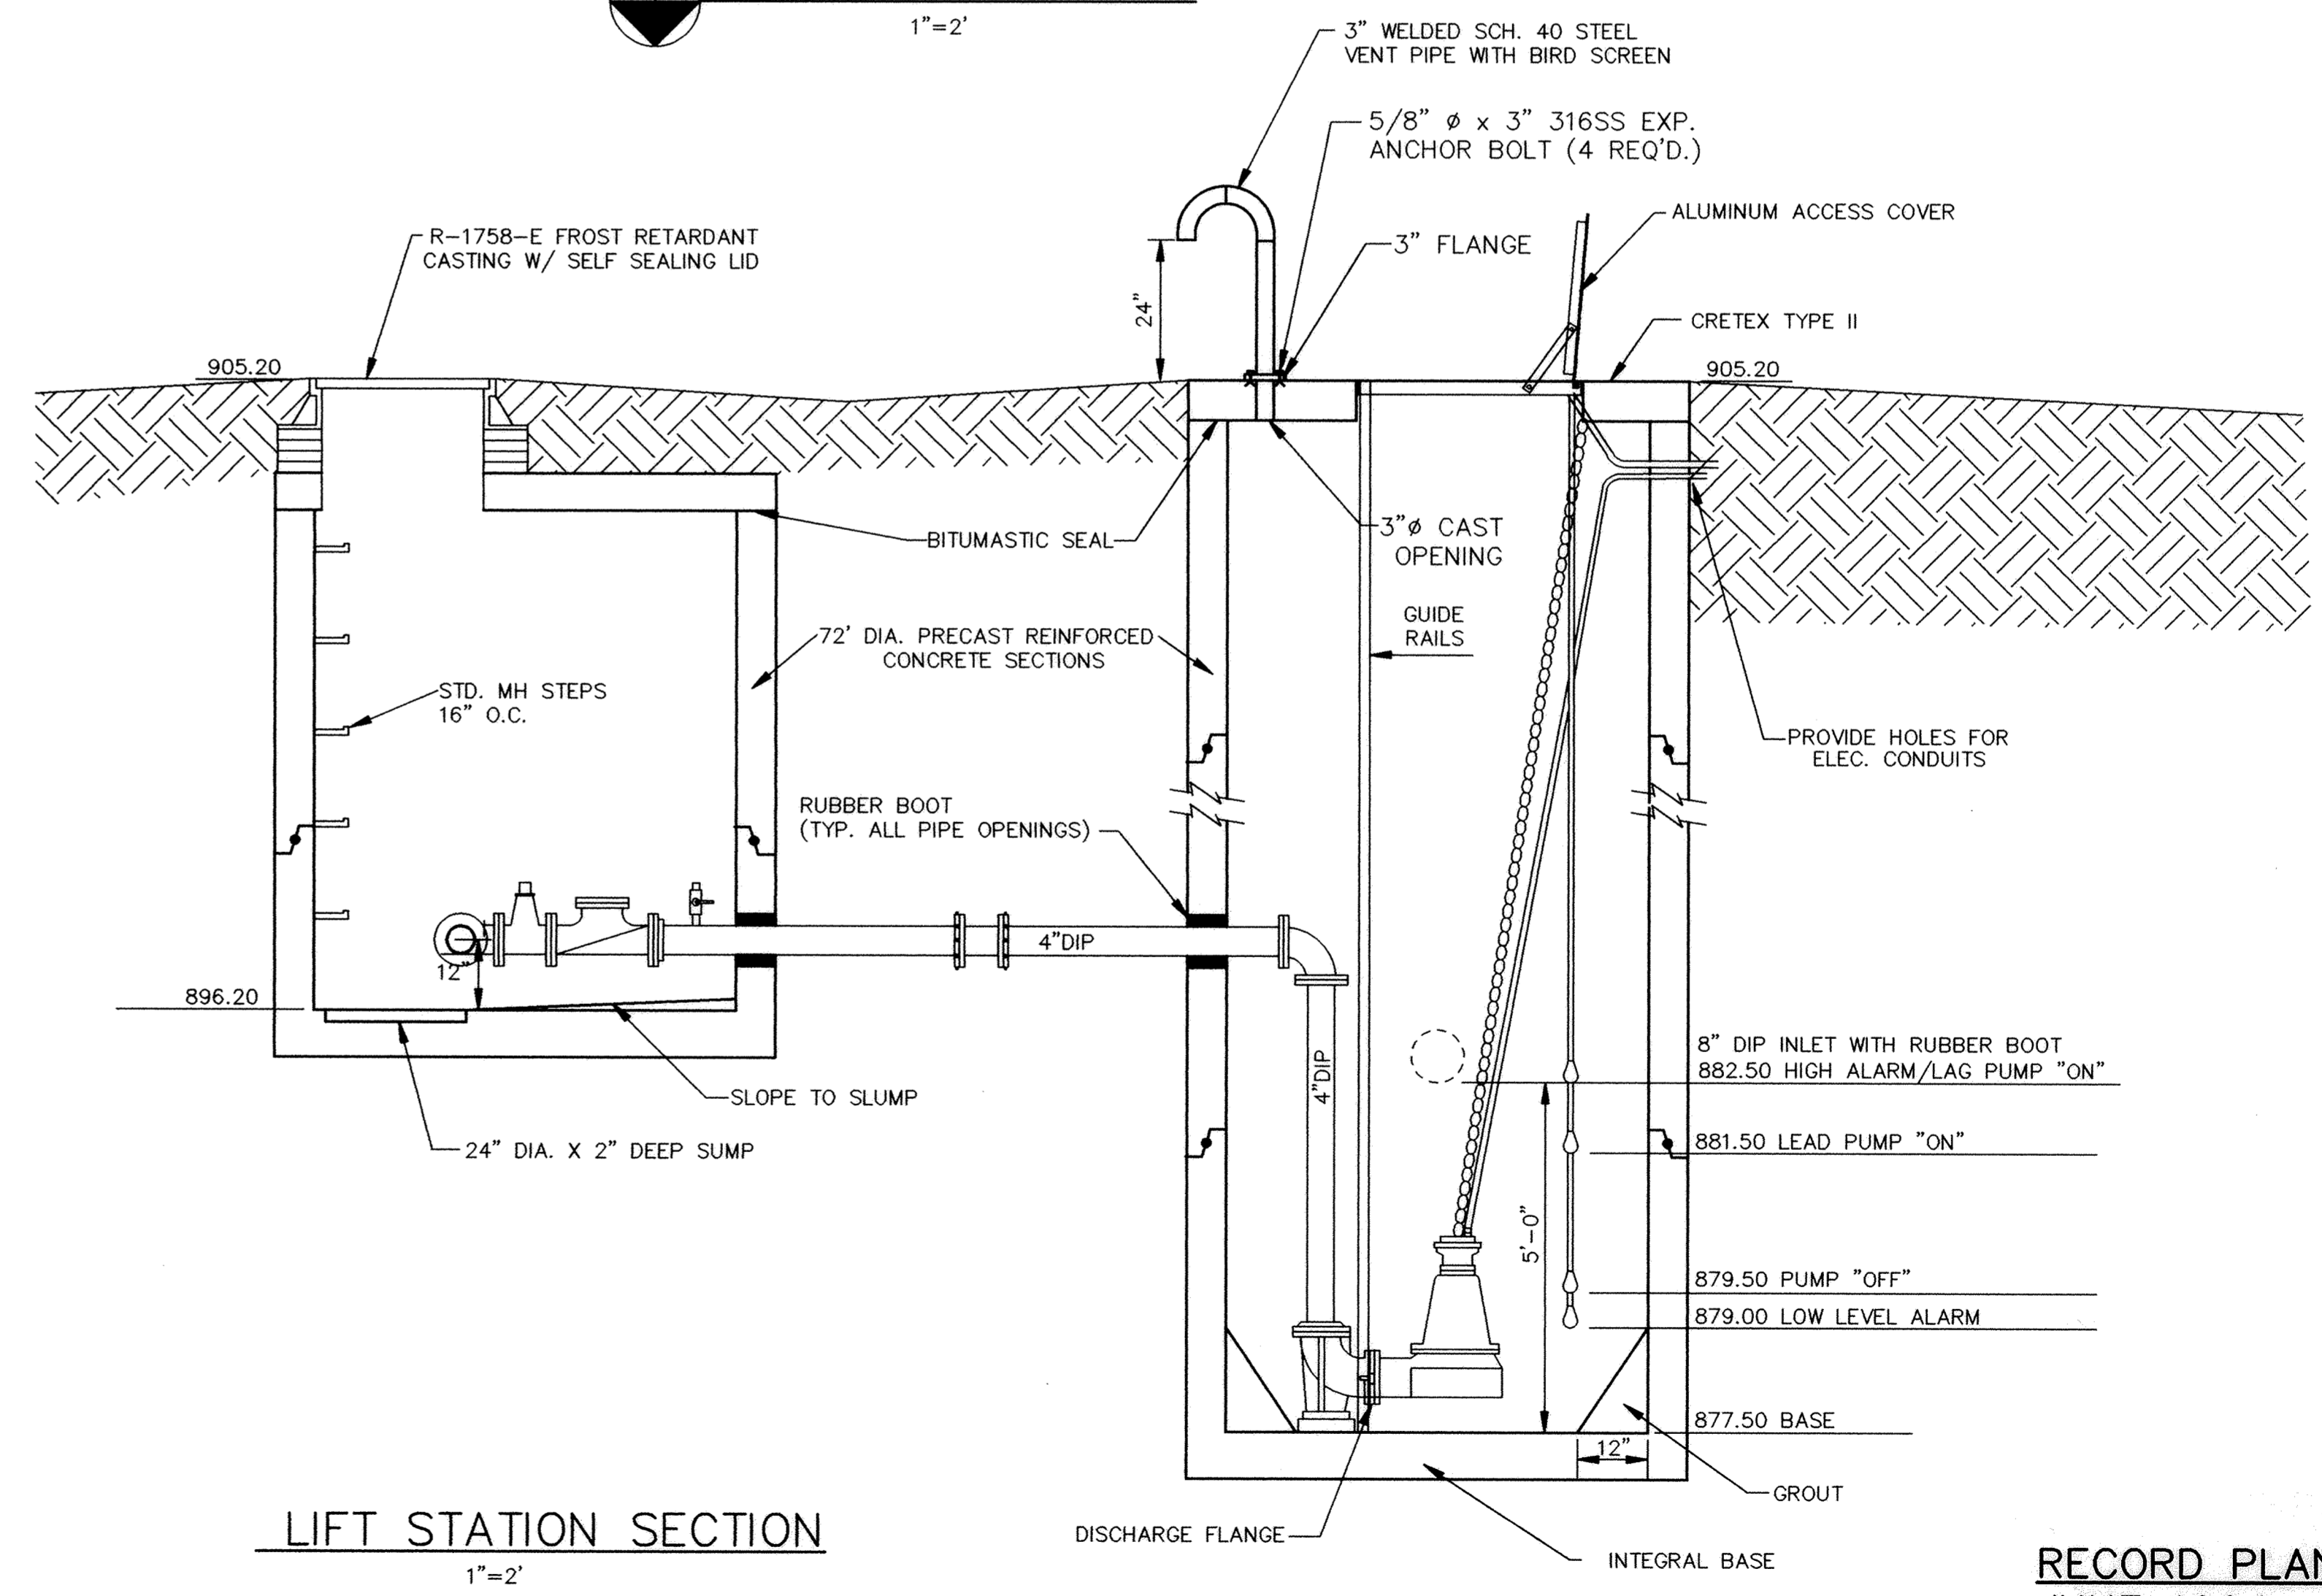

**LIFT STATION SECTION**  
 1"=2'

**RECORD PLAN**  
 JUNE 1994

I HEREBY CERTIFY THAT THIS PLAN, SPECIFICATION, OR REPORT WAS PREPARED BY ME OR UNDER MY DIRECT SUPERVISION AND THAT I AM A DULY REGISTERED PROFESSIONAL ENGINEER UNDER THE LAWS OF THE STATE OF MINNESOTA.  
*Walter J. Graham*  
 DATE 6/13/93 REG. NO. 19130

**Maier Stewart & Associates Inc.**  
 CONSULTING ENGINEERS  
 1959 SLOAN PLACE (612) 774-6021 ST. PAUL, MINNESOTA 55117  
 9800 SHELARD PARKWAY (612) 546-0432 MINNEAPOLIS, MINNESOTA 55441

DATE	DESCRIPTION	DESIGNED
		CHECKED
		DRAWN
		GRAPHIC SCALE
		0 HORIZ.
		0 VERT.

**CITY OF ELK RIVER**  
**MEADOWVALE HEIGHTS-TRUNK UTILITY IMPROVEMENTS**  
**LIFT STATION**  
 DATE AUGUST 1993 SHEET 7 OF 12 SHEETS PROJECT NO. 230-171