
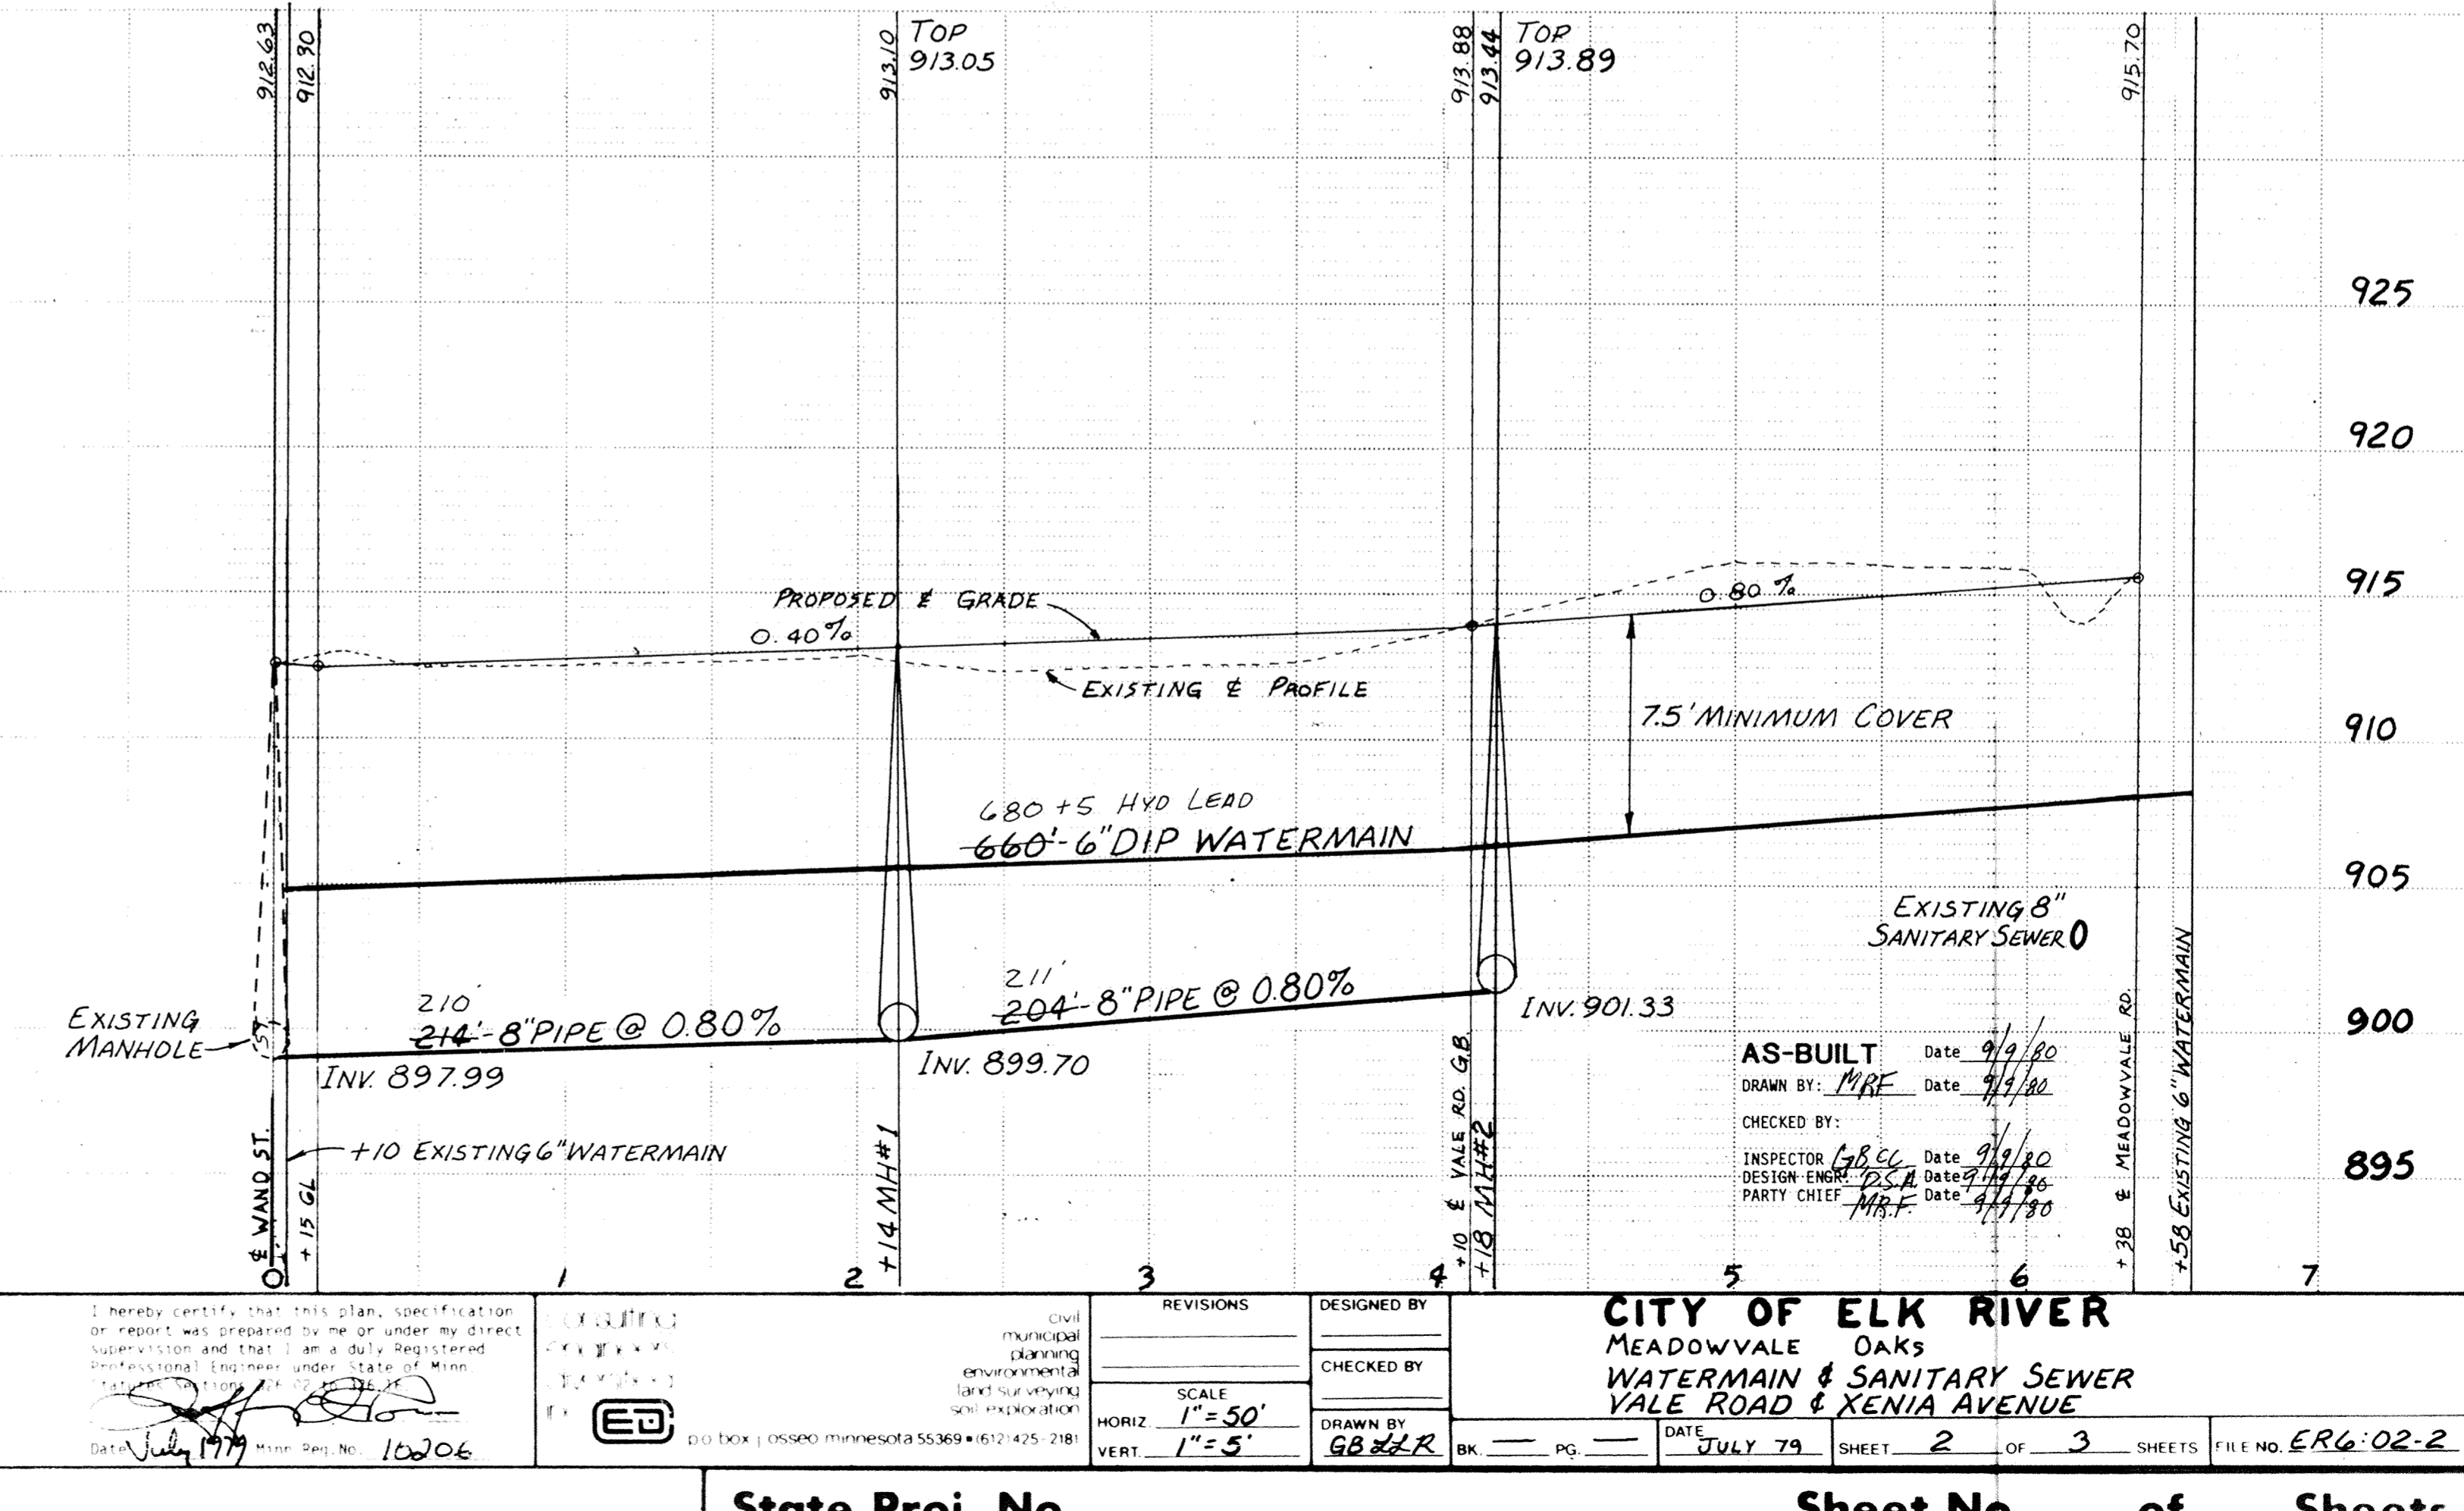


AS BUILT NOTES:
 1) WATER SERVICES ARE 10' UPSTREAM UNLESS OTHERWISE NOTED.
 2) LOTS 7 & 8 BACK 2 SANITARY SEWER & WATER SERVICES ARE FROM WAND ST.

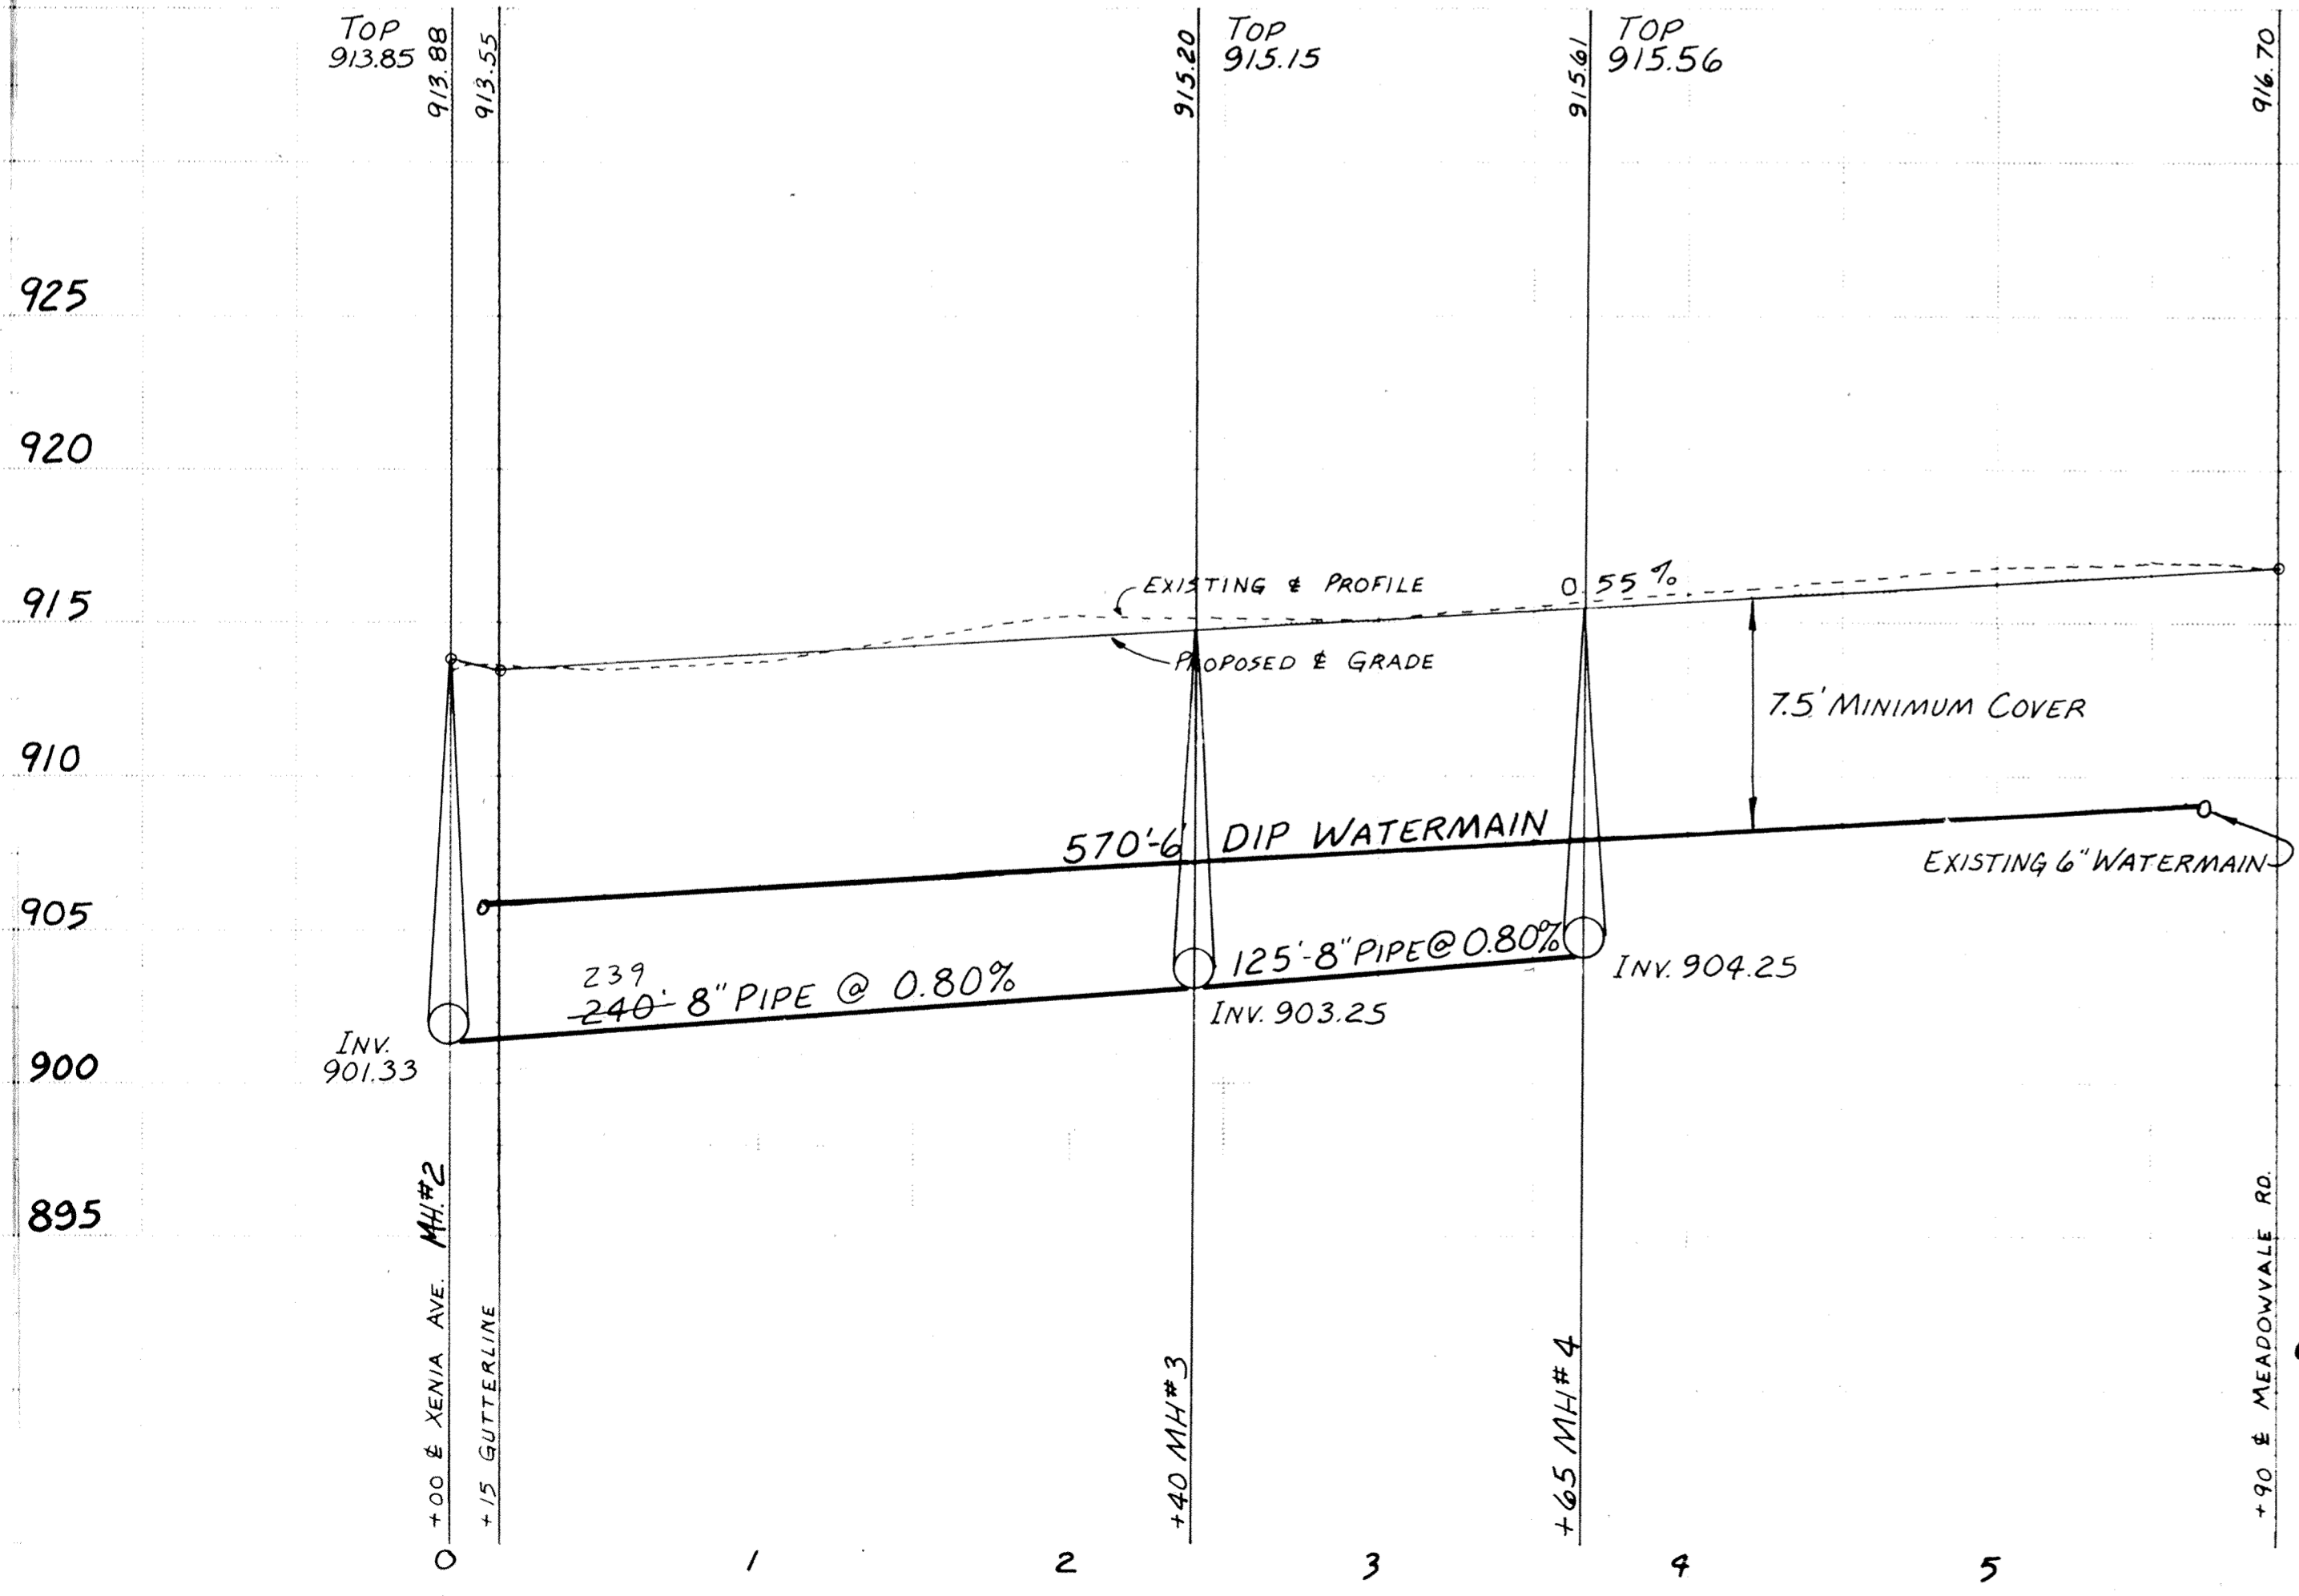

AS-BUILT Date 9/9/80
 DRAWN BY: MRF Date 9/9/80
 CHECKED BY:
 INSPECTOR: GRC Date 9/9/80
 DESIGN ENGR: DSA Date 9/9/80
 PARTY CHIEF: MRF Date 9/9/80

I hereby certify that this plan, specification or report was prepared by me or under my direct supervision and that I am a duly registered Professional Engineer under the State of Minnesota. Date July 1977	 CIVIL MUNICIPAL PLANNING ENVIRONMENTAL LAND SURVEYING AND EXPLORATION P.O. Box 10500, Minneapolis, MN 55404	REVISIONS DESIGNED BY CHECKED BY SCALE HORIZ 1"=50' VERT 1"=5'	DRAWN BY BK PG DATE JULY 79	CITY OF ELK RIVER MEADOWVALE OAKS WATERMAIN & SANITARY SEWER VALE ROAD & XENIA AVENUE	SHEET 2 OF 3 SHEETS FILE NO. ER6-02-2
		State Proj. No.	Sheet No. of Sheets		

DRAWING NUMBER
 MEADO 79
 DRAWING NUMBER
 MEADO 79
 DRAWING NUMBER
 MEADO 79