
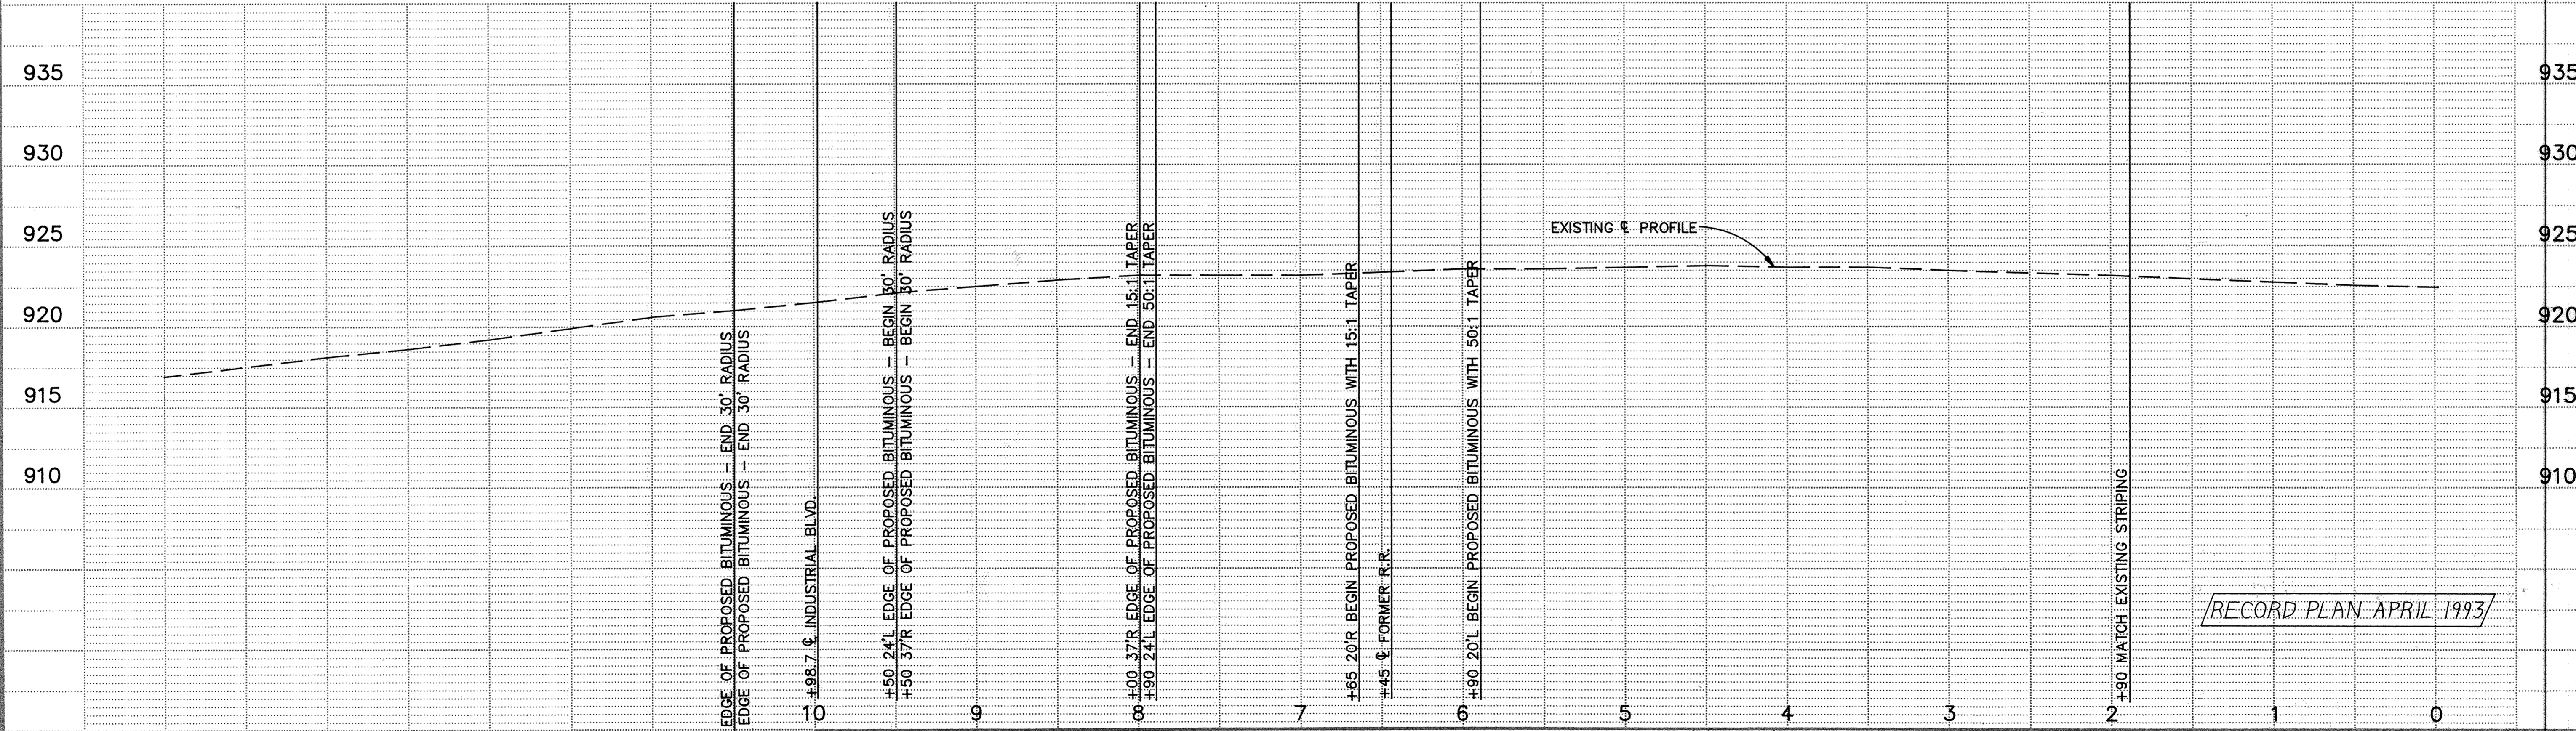
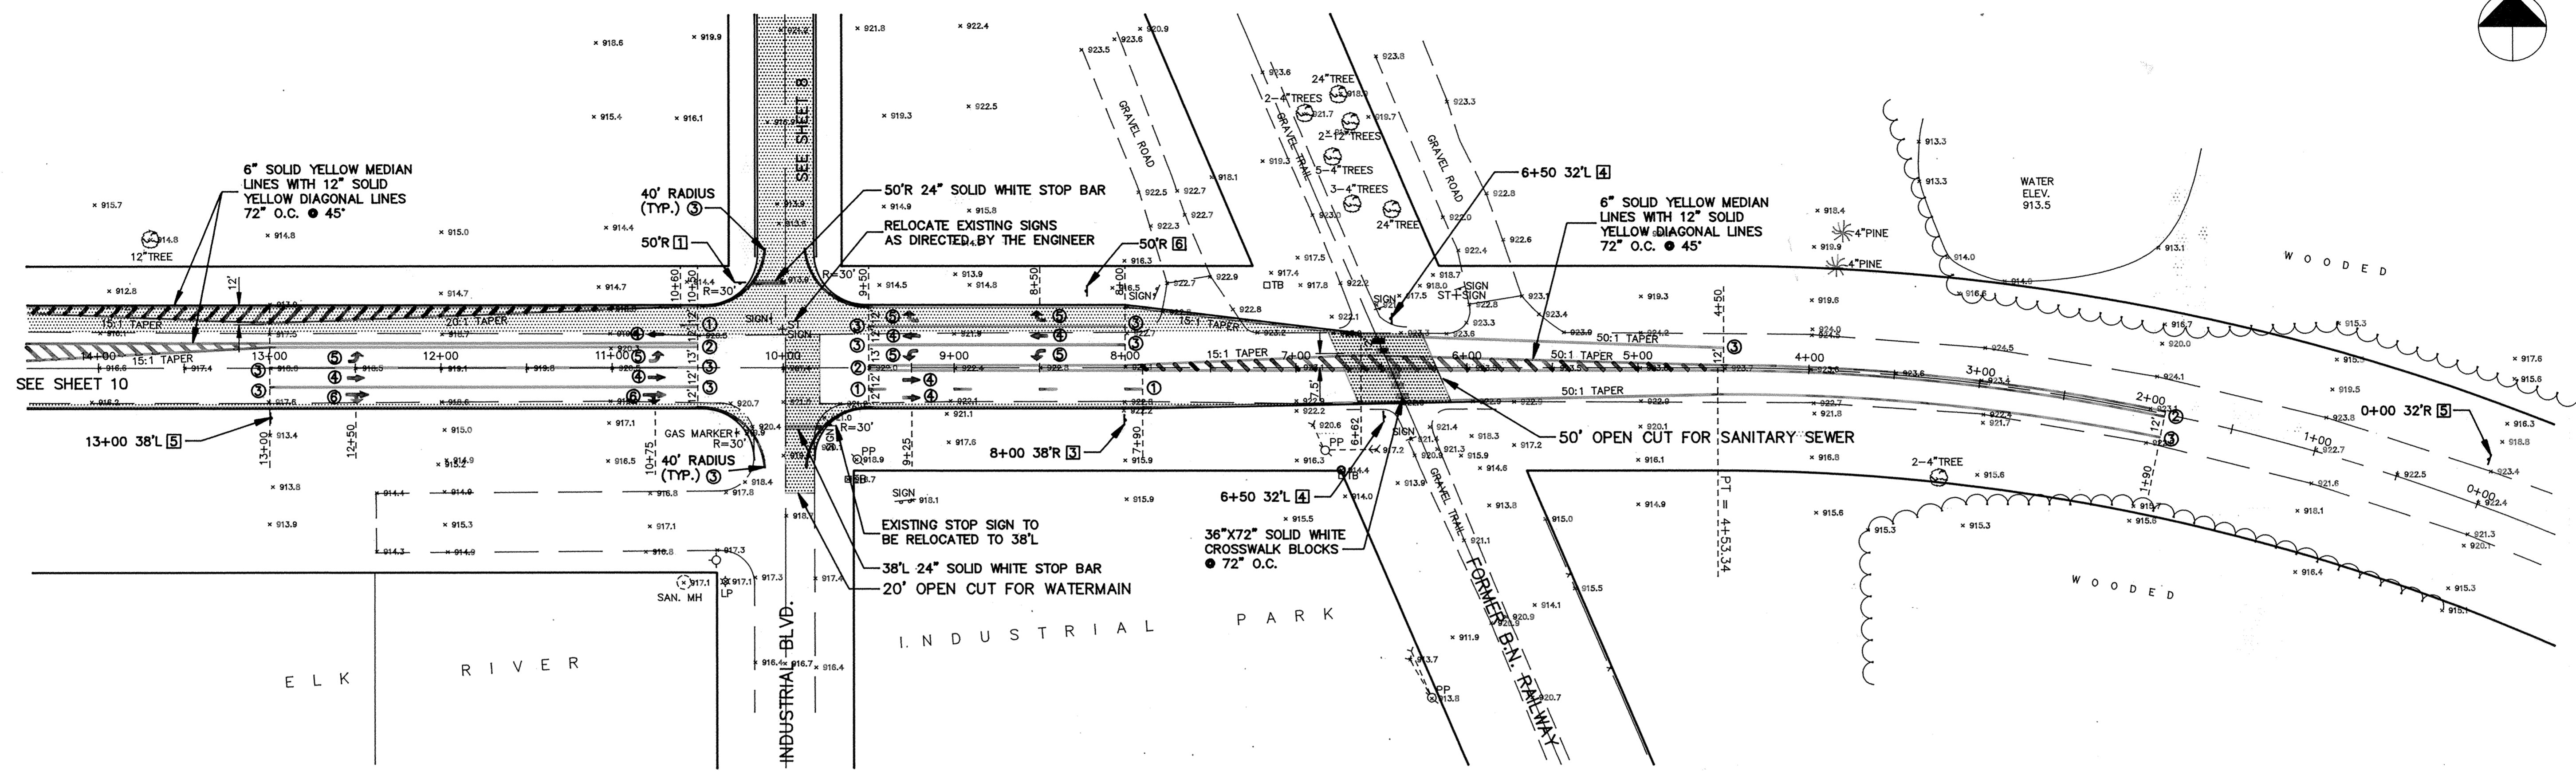


C.S.A.H. NO. 1

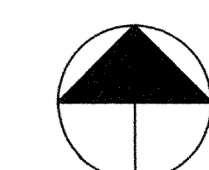

RECORD PLAN APRIL 1993

I HEREBY CERTIFY THAT THIS PLAN, SPECIFICATION, OR REPORT WAS PREPARED BY ME OR UNDER MY DIRECT SUPERVISION AND THAT I AM A DULY REGISTERED PROFESSIONAL ENGINEER UNDER THE LAWS OF THE STATE OF MINNESOTA.
Virgil S. Markens
 DATE 9/12/91 REG. NO. 19941

MSA CONSULTING ENGINEERS
Maier Stewart & Associates Inc.
 1959 SLOAN PLACE (612)774-6021 ST. PAUL, MINNESOTA 55117

REVISIONS	DATE	DESCRIPTION	DESIGNED	CHECKED	DRAWN

GRAPHIC SCALE
 0 HORIZ. 50
 0 VERT. 5

CITY OF ELK RIVER
 STREET IMPROVEMENTS
 C.S.A.H. NO. 1
 DATE AUG. 1991 SHEET 9 OF 14 SHEETS PROJECT NO. 230-125

* SEE SHEET 566A FOR REVISED STRIPING 566