
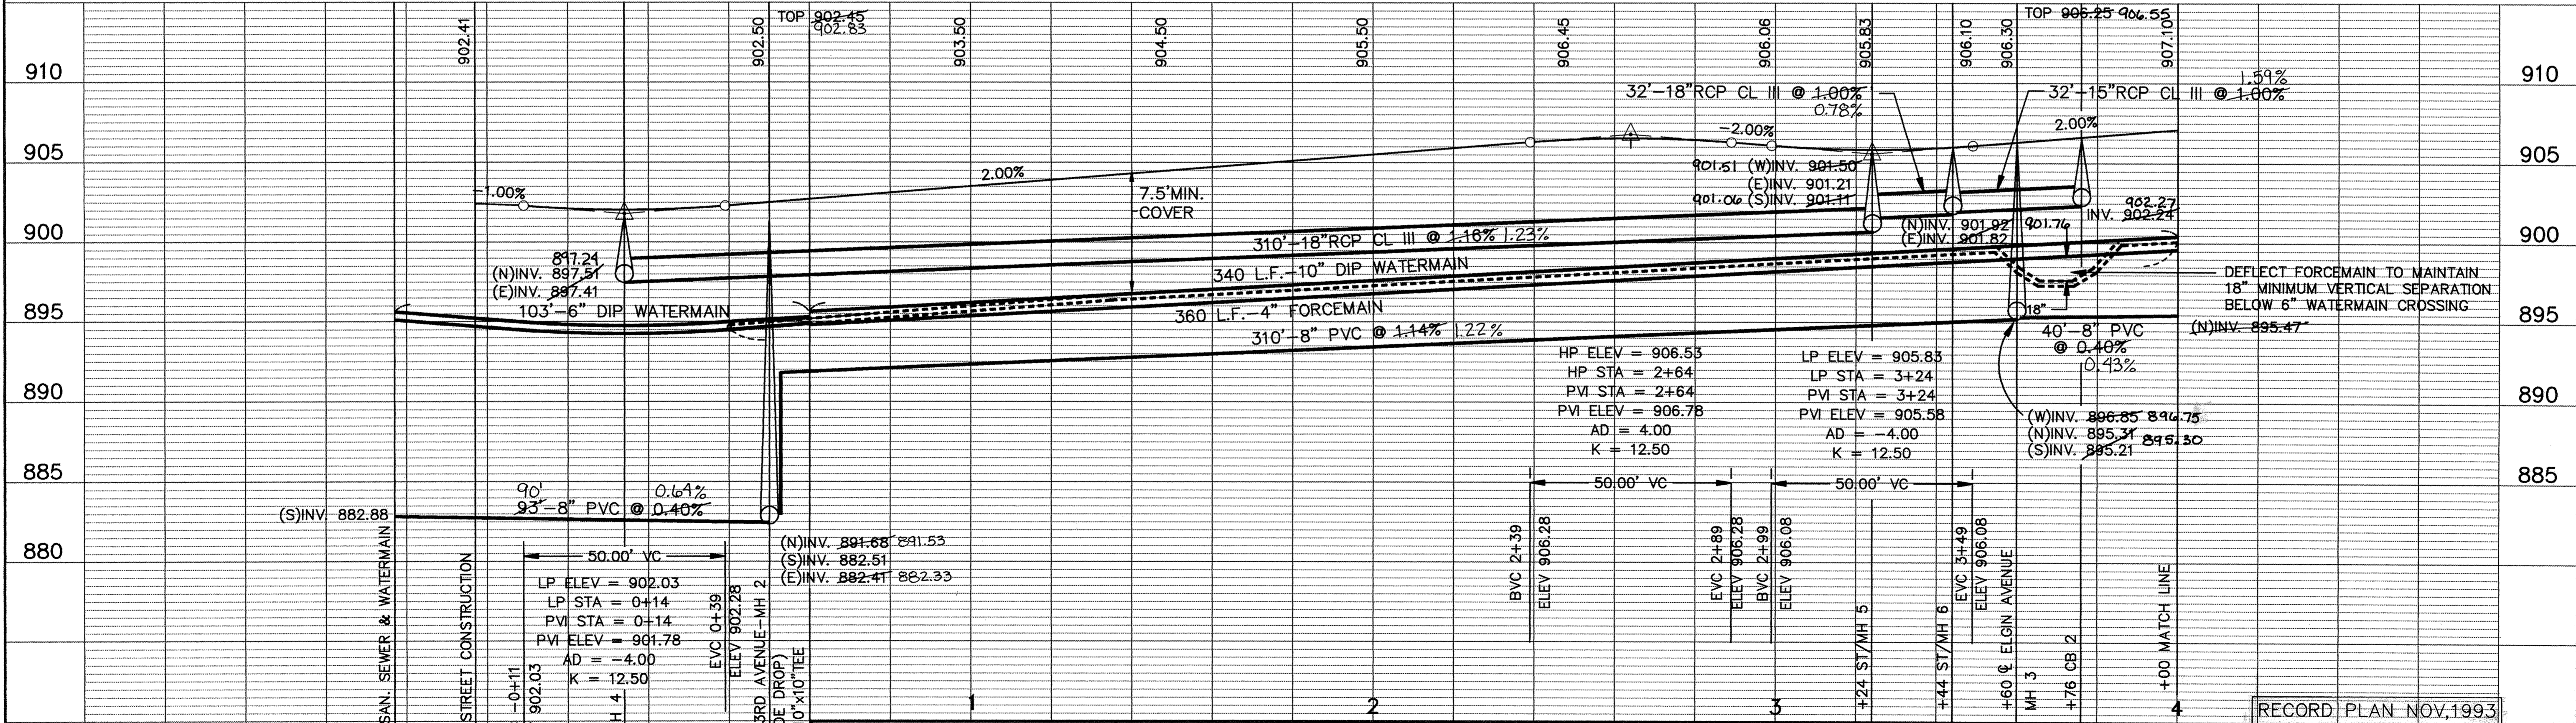


# DENVER STREET

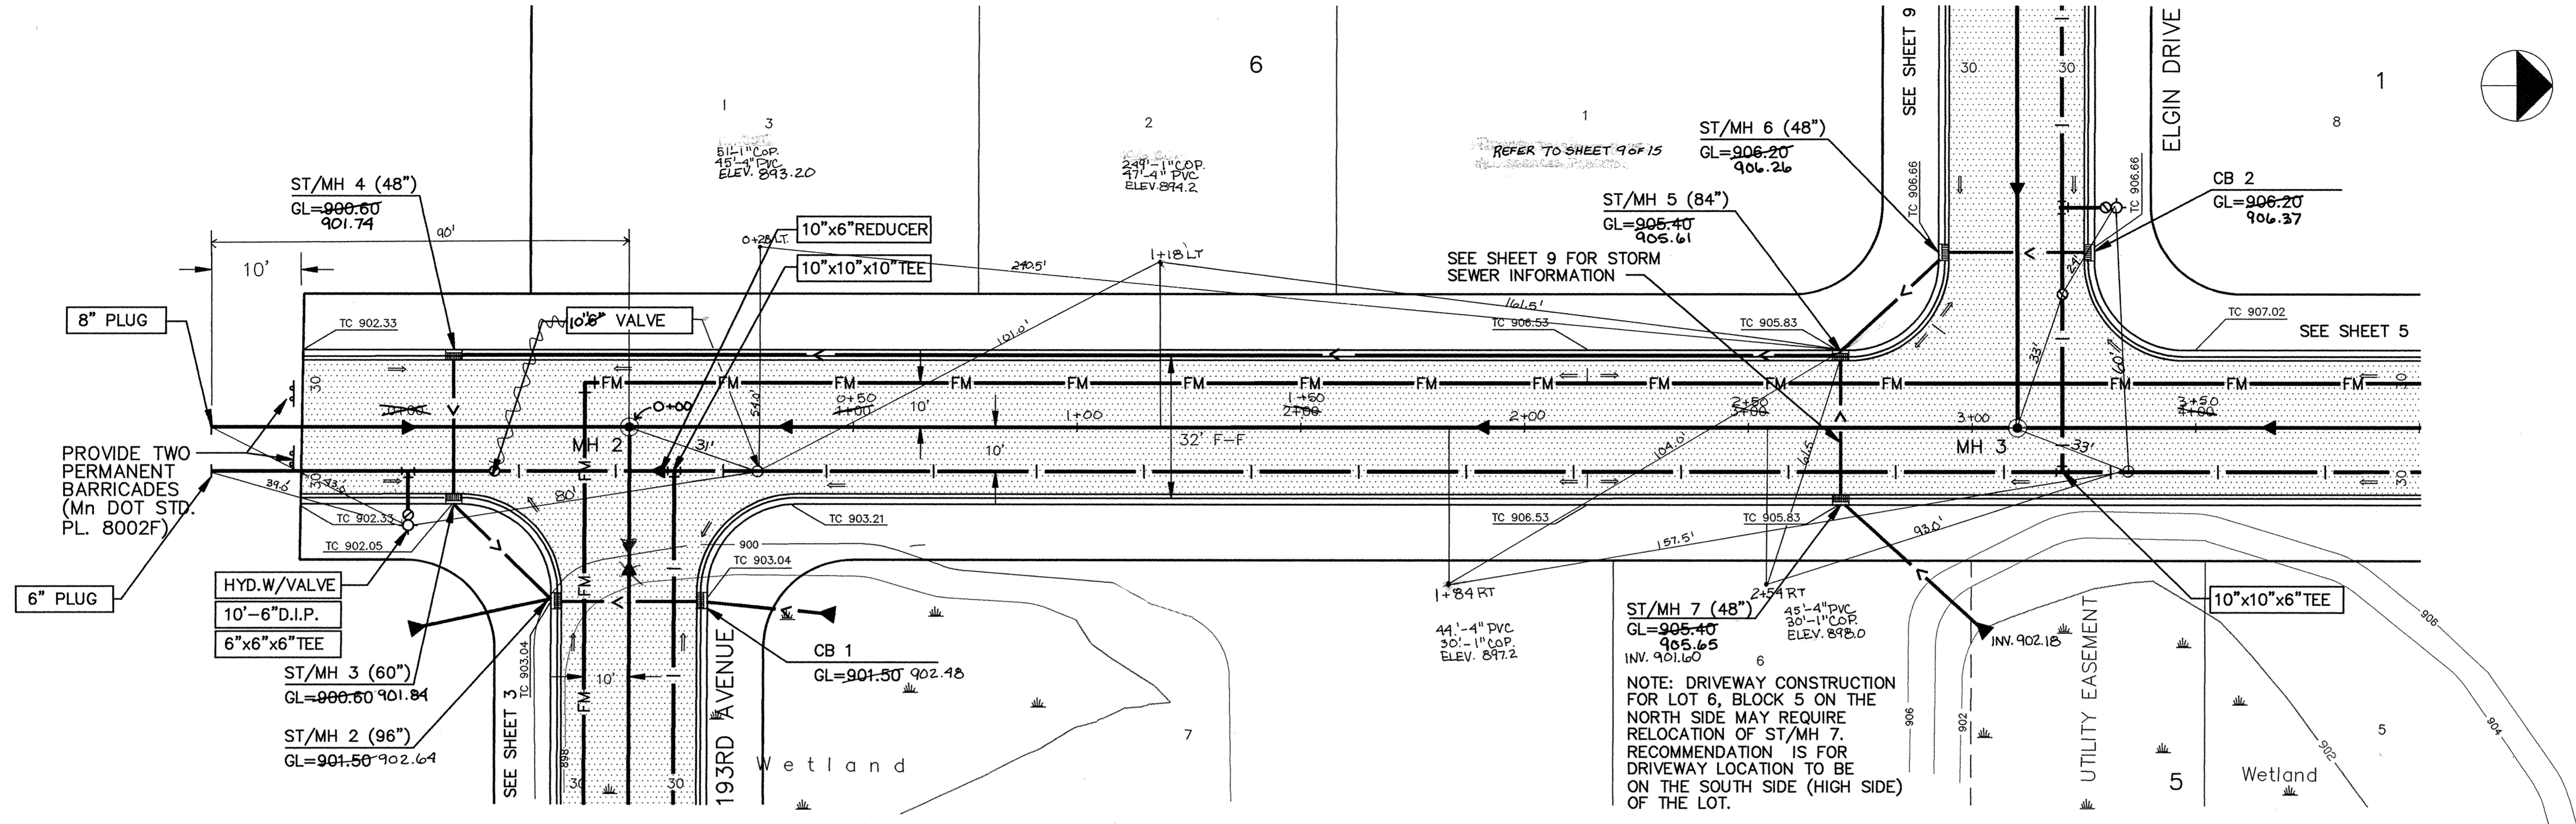

I HEREBY CERTIFY THAT THIS PLAN, SPECIFICATION, OR REPORT WAS PREPARED BY ME OR UNDER MY DIRECT SUPERVISION AND THAT I AM A DULY REGISTERED PROFESSIONAL ENGINEER UNDER THE LAWS OF THE STATE OF MINNESOTA.

*Mark J. Gushard*  
 DATE 8/18/93 REG. NO. 19130

**MS&A** CONSULTING ENGINEERS  
 Maier Stewart & Associates Inc.  
 1959 SLOAN PLACE (612) 774-6021 ST. PAUL, MINNESOTA 55117  
 9800 SHELARD PARKWAY (612) 546-0432 MINNEAPOLIS, MINNESOTA 55441

DATE	DESCRIPTION	DESIGNED	CHECKED
7/14/93	SAN. SEWER DEPTH	MJC	BAL
8/06/93	193RD RELOCATION SAN. SEWER AND WATERMAIN	MRF	MRF
8/18/93	FORCEMAIN ADDITION SAN. SEWER ADD. @ 194TH		

RECORD PLAN NOV, 1993

CITY OF ELK RIVER  
 STREET AND UTILITY CONSTRUCTION STA. 0+00 TO 5+00  
 DENVER STREET

DATE MAY, 1993 SHEET 4 OF 15 SHEETS PROJECT NO. 230-168

DRAWING NUMBER  
 MEADO 93  
 4  
 CITY OF ELK RIVER  
 SANITARY PRODUCTS • NEW HOPE, MINNESOTA  
 REQUESTED BY PART NUMBER 6502  
 REVISIONS: 08/18/93  
 DRAWN: MRF  
 CHECKED: BAL  
 GRAPHIC SCALE  
 HORIZ. 20  
 VERT. 5  
 DRAWING NUMBER  
 MEADO 93  
 4  
 CITY OF ELK RIVER  
 SANITARY PRODUCTS • NEW HOPE, MINNESOTA  
 REQUESTED BY PART NUMBER 6502  
 REVISIONS: 08/18/93