

MISSISSIPPI RIDGE

CITY OF ELK RIVER
MINNESOTA


CONTACTS
GENERAL CONTRACTOR: MEADOWVALE, INC.
DEVELOPER: SCOTT POWELL

=====**MR. SCOTT POWELL**=====

ORIGINAL PROJECT PLANS BY
JOHN OLIVER & ASSOCIATES
580 DODGE AVENUE
ELK RIVER, MN. 55313
DRAWN BY TGL @ JOA

RECORD DRAWING
MEASURED & INSPECTED BY:
HOWARD R. GREEN, INC.
DRAWN BY MG @ BPA

SANITARY SEWER, WATERMAIN, STORM SEWER & STREET IMPROVEMENTS

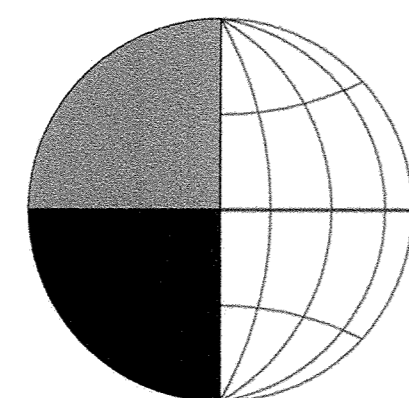

**BOGART, PEDERSON
& ASSOCIATES, INC.**

LAND SURVEYING
CIVIL ENGINEERING
MAPPING

13076 FIRST STREET, BECKER, MN 55308-9322
TEL: 763-262-8822 FAX: 763-262-8844

I hereby certify that this plan, specification, or report was prepared by me or under my direct supervision and that I am a Licensed Professional Engineer under the laws of the State of Minnesota

Signed: *Christopher C. Otterness*
CHRISTOPHER C. OTTERNESS
Date: 10-26-06 Reg. No. 41961

City of Elk River		Date: _____	
City Engineer: _____		Date: _____	
REV. NO.	DATE	REVISIONS	SHEETS REVISED
1	6/4/01	CITY COMMENTS	ALL
2	8/2/01	REALIGNMENT OF 171ST AVENUE	1-4
3	8/9/01	CITY COMMENTS	ALL
4	8/15/01	CITY COMMENTS	ALL
5	10/26/06	AS-BUILTS REVISIONS	

1
5