
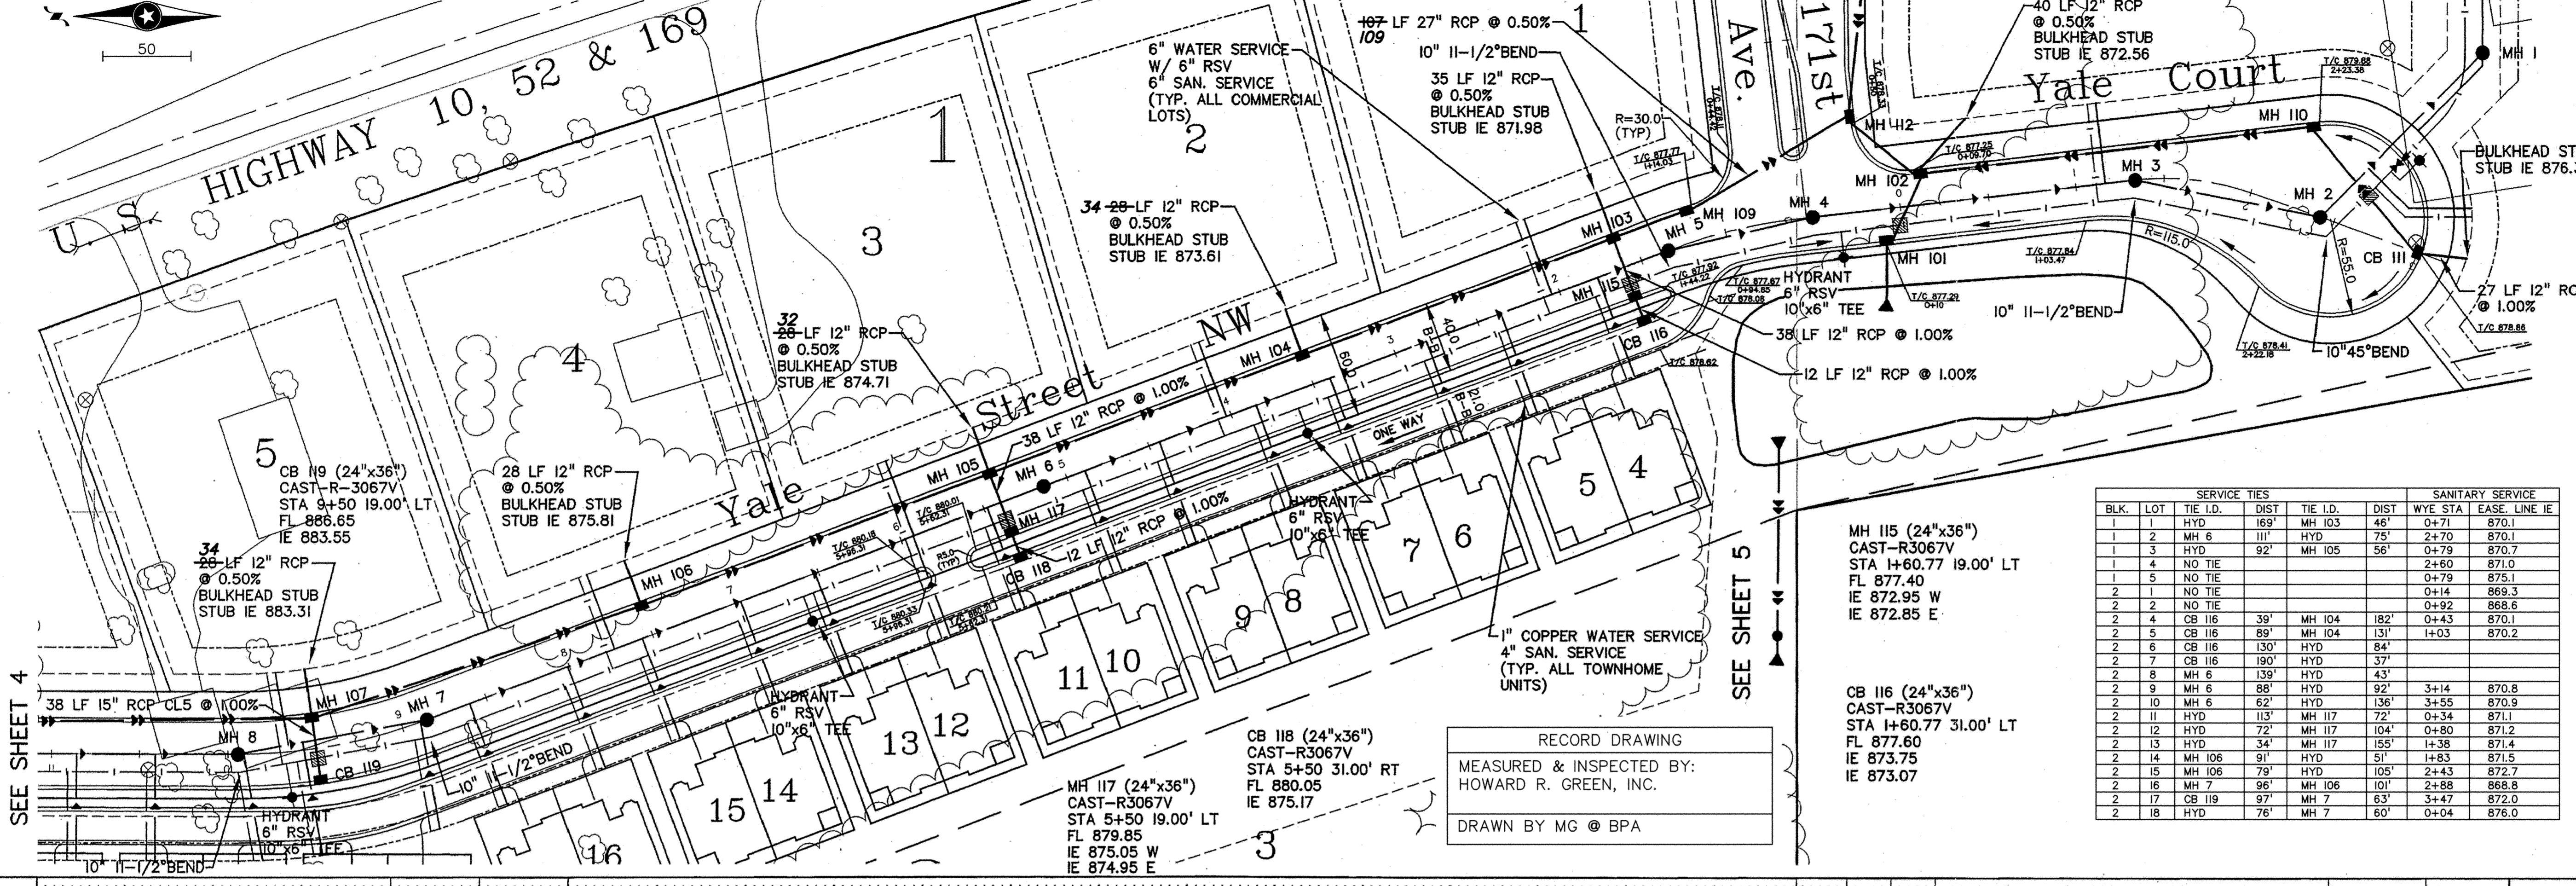


YALE STREET NW - YALE COURT

SEE SHEET 4

SEE SHEET 5

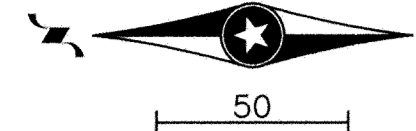

SERVICE TIES				SANITARY SERVICE			
BLK.	LOT	TIE I.D.	DIST.	TIE I.D.	DIST.	WYE STA	EASE LINE IE
1	1	HYD	163'	MH 103	46'	0+71	870.1
1	2	MH 6	111'	HYD	75'	2+70	870.1
1	3	HYD	92'	MH 105	56'	0+79	870.7
1	4	NO TIE				2+60	871.0
1	5	NO TIE				0+79	875.1
2	1	NO TIE				0+14	869.3
2	2	NO TIE				0+32	868.6
2	4	CB IIE	39'	MH 104	182'	0+43	870.1
2	5	CB IIE	89'	MH 104	131'	1+03	870.2
2	6	CB IIE	130'	HYD	84'		
2	7	CB IIE	190'	HYD	37'		
2	8	MH 6	139'	HYD	43'		
2	9	MH 6	88'	HYD	92'	3+14	870.8
2	10	MH 6	62'	HYD	136'	3+55	870.9
2	11	HYD	113'	MH 117	72'	0+34	871.1
2	12	HYD	72'	MH 117	104'	0+80	871.2
2	13	HYD	34'	MH 117	155'	1+38	871.4
2	14	MH 106	91'	HYD	51'	1+83	871.5
2	15	MH 106	79'	HYD	105'	2+43	872.7
2	16	MH 7	96'	MH 106	101'	2+88	868.8
2	17	CB IIE	97'	MH 7	63'	3+47	872.0
2	18	HYD	76'	MH 7	60'	0+04	876.0

MH 115 (24"x36")
CAST-R3067V
STA I+60.77 19.00' LT
FL 877.40
IE 872.95 W
IE 872.85 E

MH 116 (24"x36")
CAST-R3067V
STA I+60.77 31.00' LT
FL 877.60
IE 873.75
IE 873.07

RECORD DRAWING
MEASURED & INSPECTED BY:
HOWARD R. GREEN, INC.
DRAWN BY MG @ BPA


REV. NO.	DATE	DESCRIPTION
1	6/4/01	CITY COMMENTS
2	8/2/01	REVISED 171ST AVENUE
3	8/9/01	CITY COMMENTS
4	8/15/01	CITY COMMENTS
5	8/23/01	YALE COURT GRADES & UTILITIES
6	8/26/01	MOVED MH 6, MH 105, MH 117 & CB 118
7	10/26/06	AS-BUILT REVISIONS

DESIGN BY: JK
DRAWN BY: TGL
CHECKED BY: WJM
DWG FILE: SHEET 3
TEXT FILE: NONE
FILE NO.: 06-0367.00

DATE: 4/18/01

I hereby certify that this plan, specification, or report was prepared by me or under my direct supervision and that I am a duly Licensed Professional Engineer under the laws of the state of Minnesota.

Signed: *Christopher C. Ottensness*
Christopher C. Ottensness
Reg. No. 41961
Date: 10-28-06

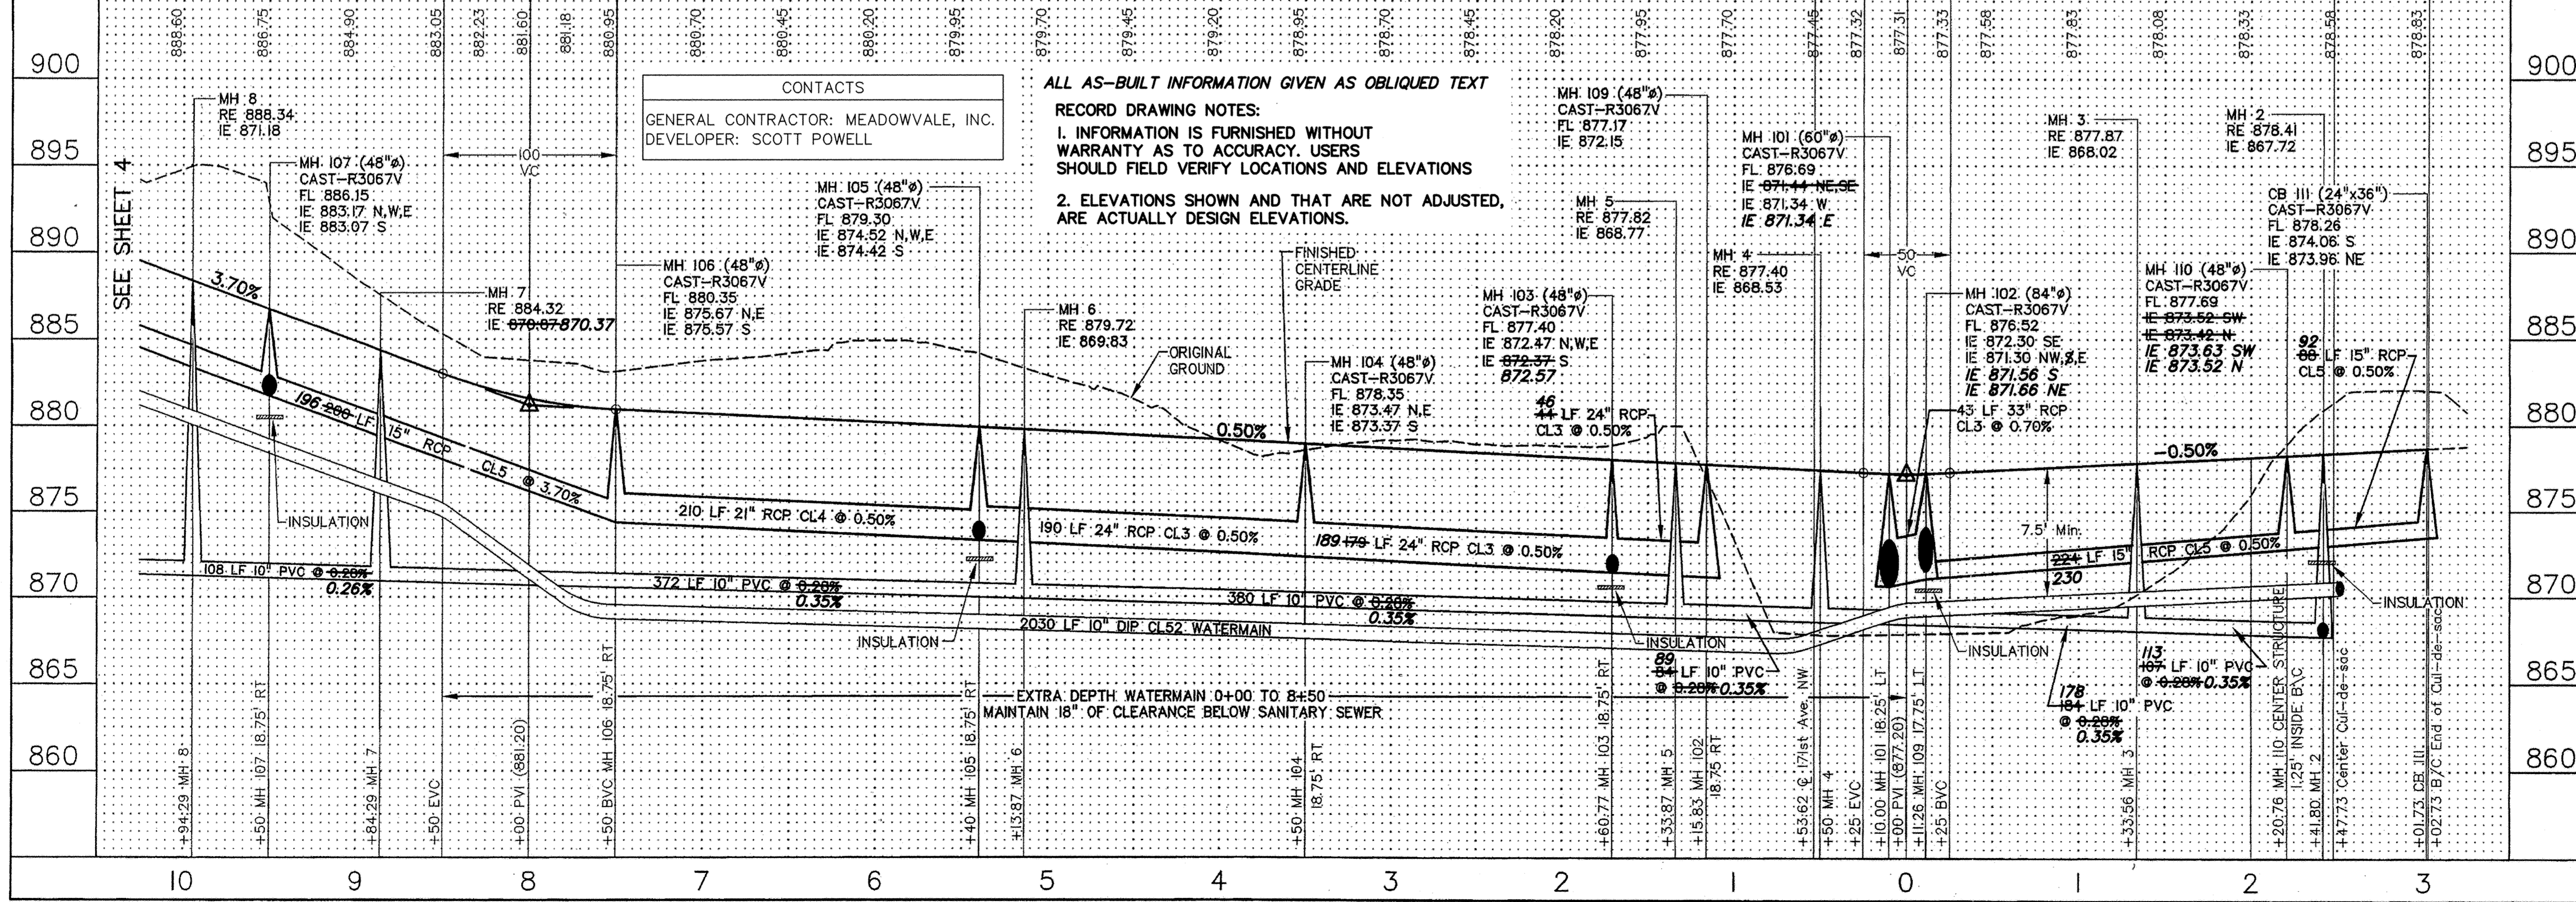

CONTACTS
GENERAL CONTRACTOR: MEADOWVALE, INC.
DEVELOPER: SCOTT POWELL

ALL AS-BUILT INFORMATION GIVEN AS OBLIQUED TEXT
RECORD DRAWING NOTES:
1. INFORMATION IS FURNISHED WITHOUT WARRANTY AS TO ACCURACY. USERS SHOULD FIELD VERIFY LOCATIONS AND ELEVATIONS
2. ELEVATIONS SHOWN AND THAT ARE NOT ADJUSTED, ARE ACTUALLY DESIGN ELEVATIONS.

BOGART, PEDERSON & ASSOCIATES, INC.
LAND SURVEYING
CIVIL ENGINEERING
MAPPING

1076 FIRE STREET, BECKER, MN 55305-3322
TEL: 763-262-9662 FAX: 763-262-8644

MISSISSIPPI RIDGE
ELK RIVER, MN
SCOTT POWELL
STREET, SAN. SEWER, STORM SEWER &
WATERMAIN CONSTRUCTION PLAN
YALE STREET NW & YALE COURT

SHEET NO. 3 OF 5