
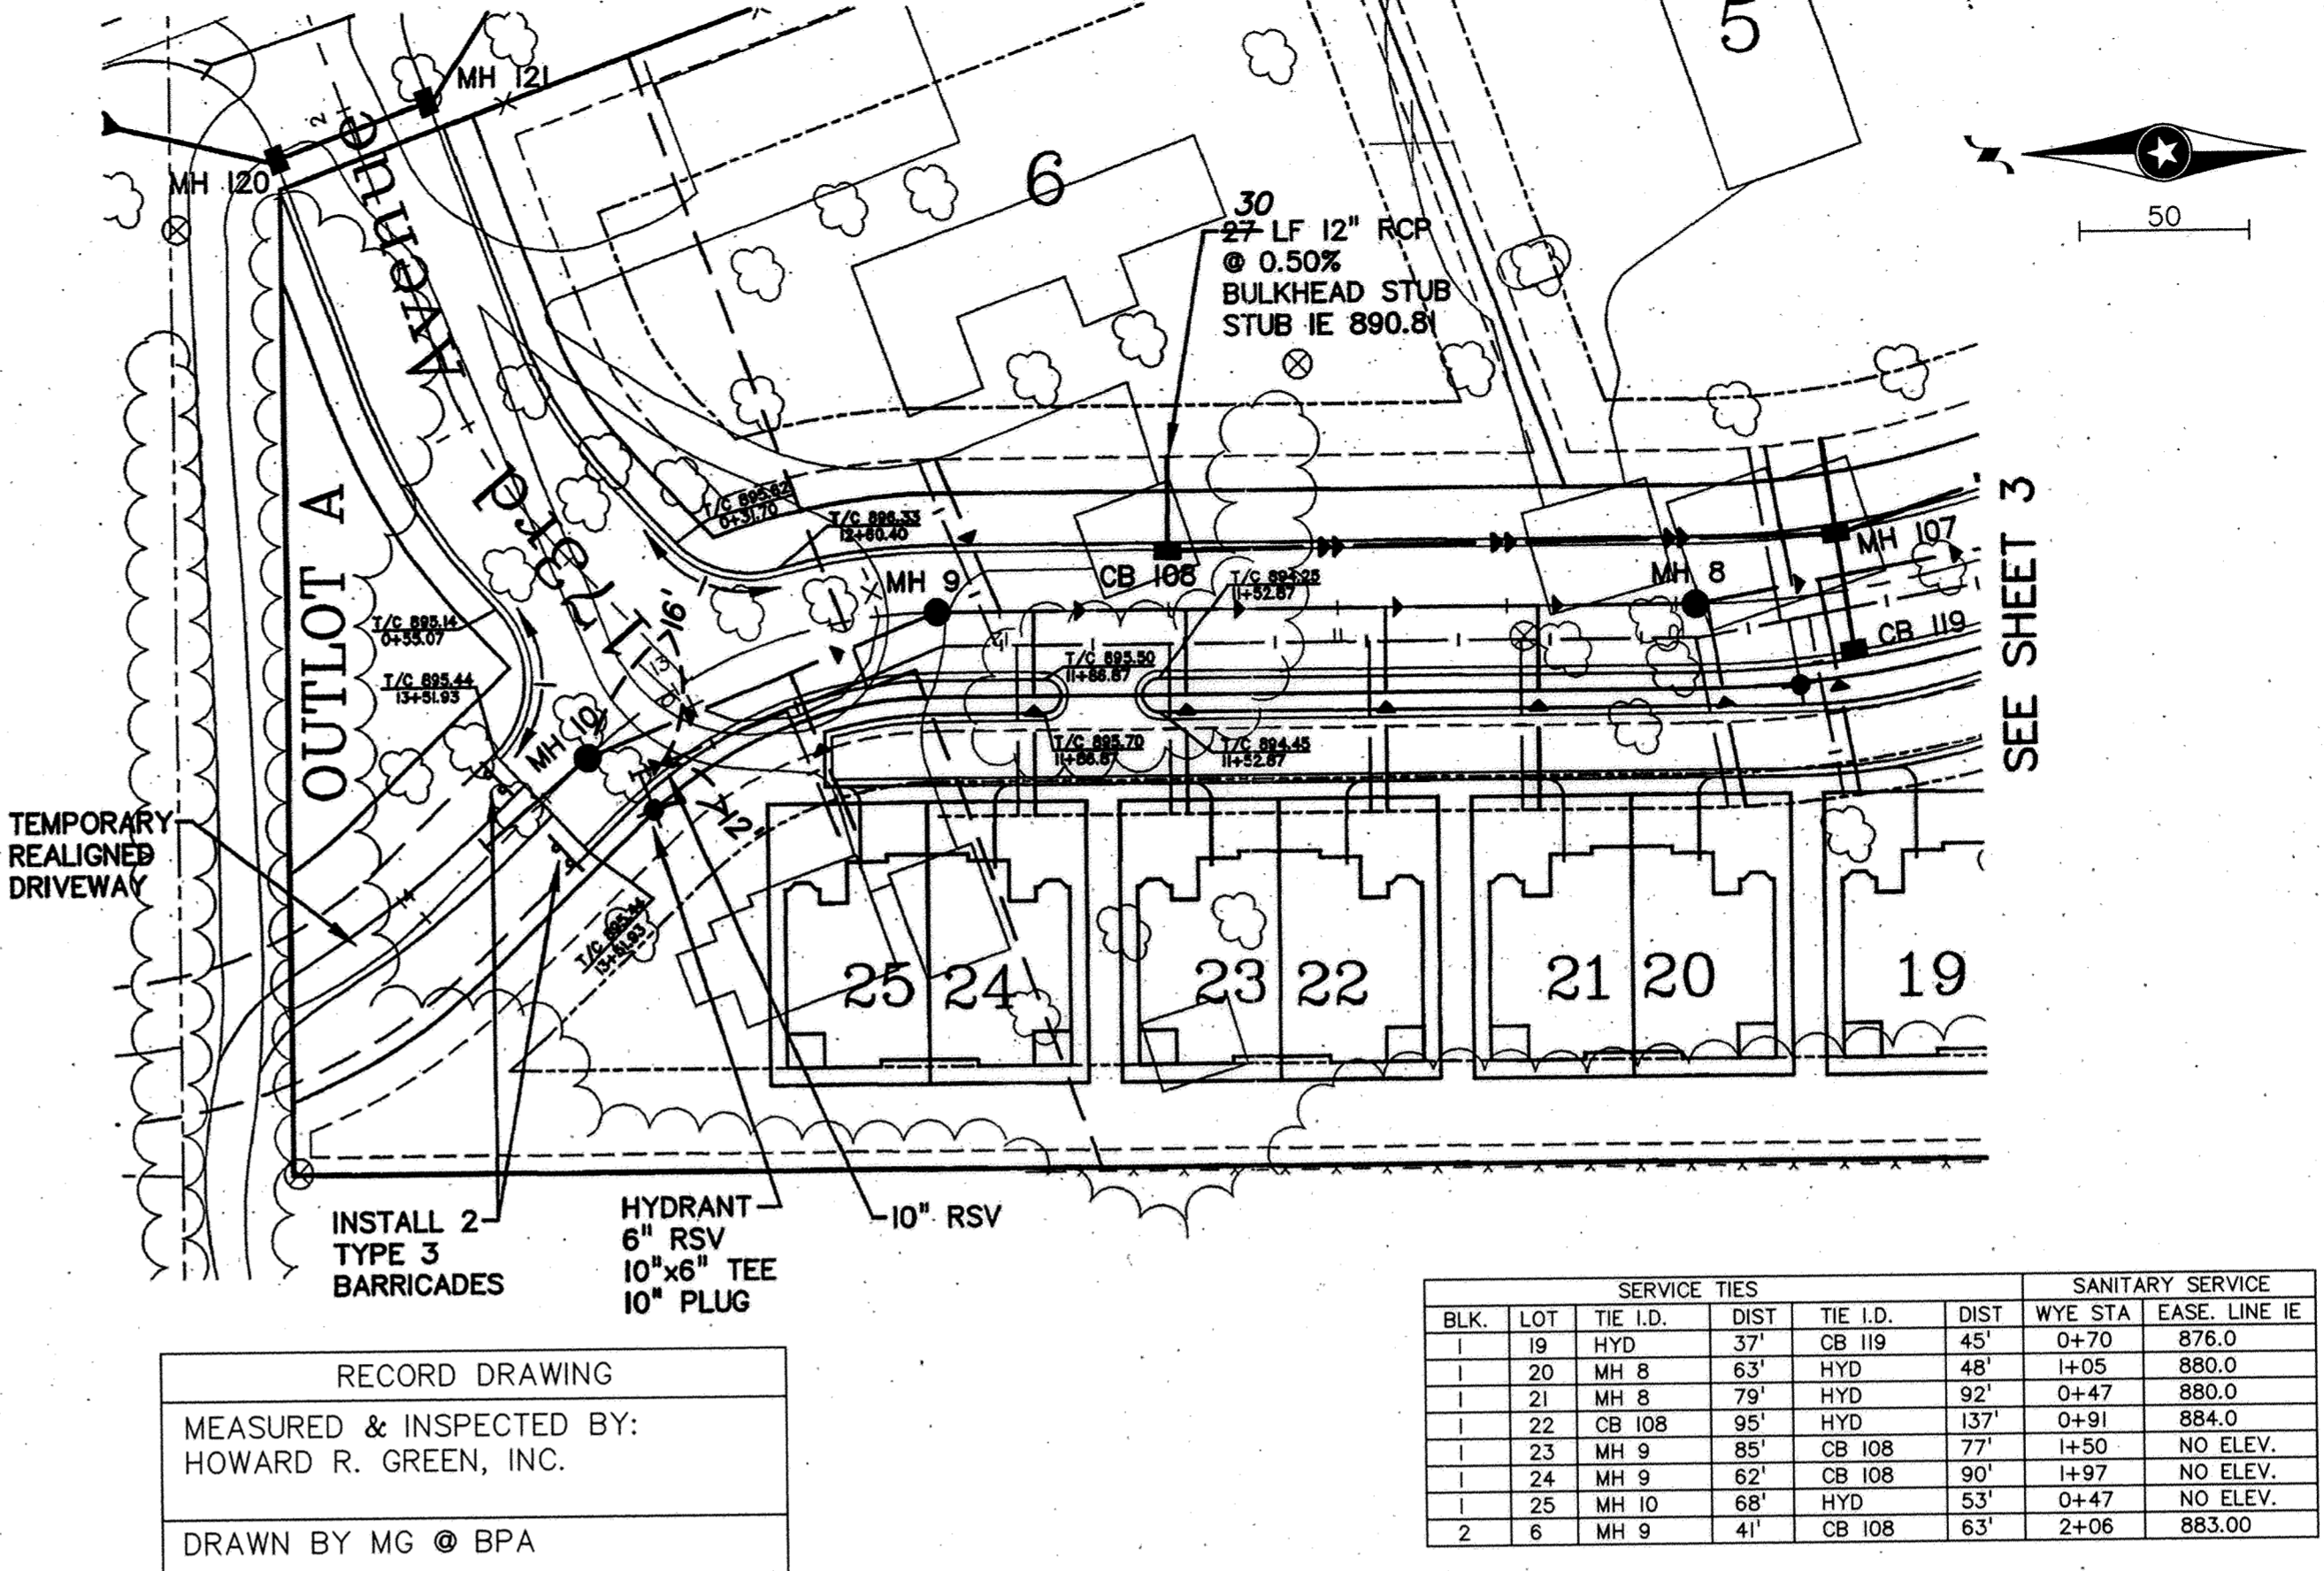


171st AVENUE NW

YALE STREET NW

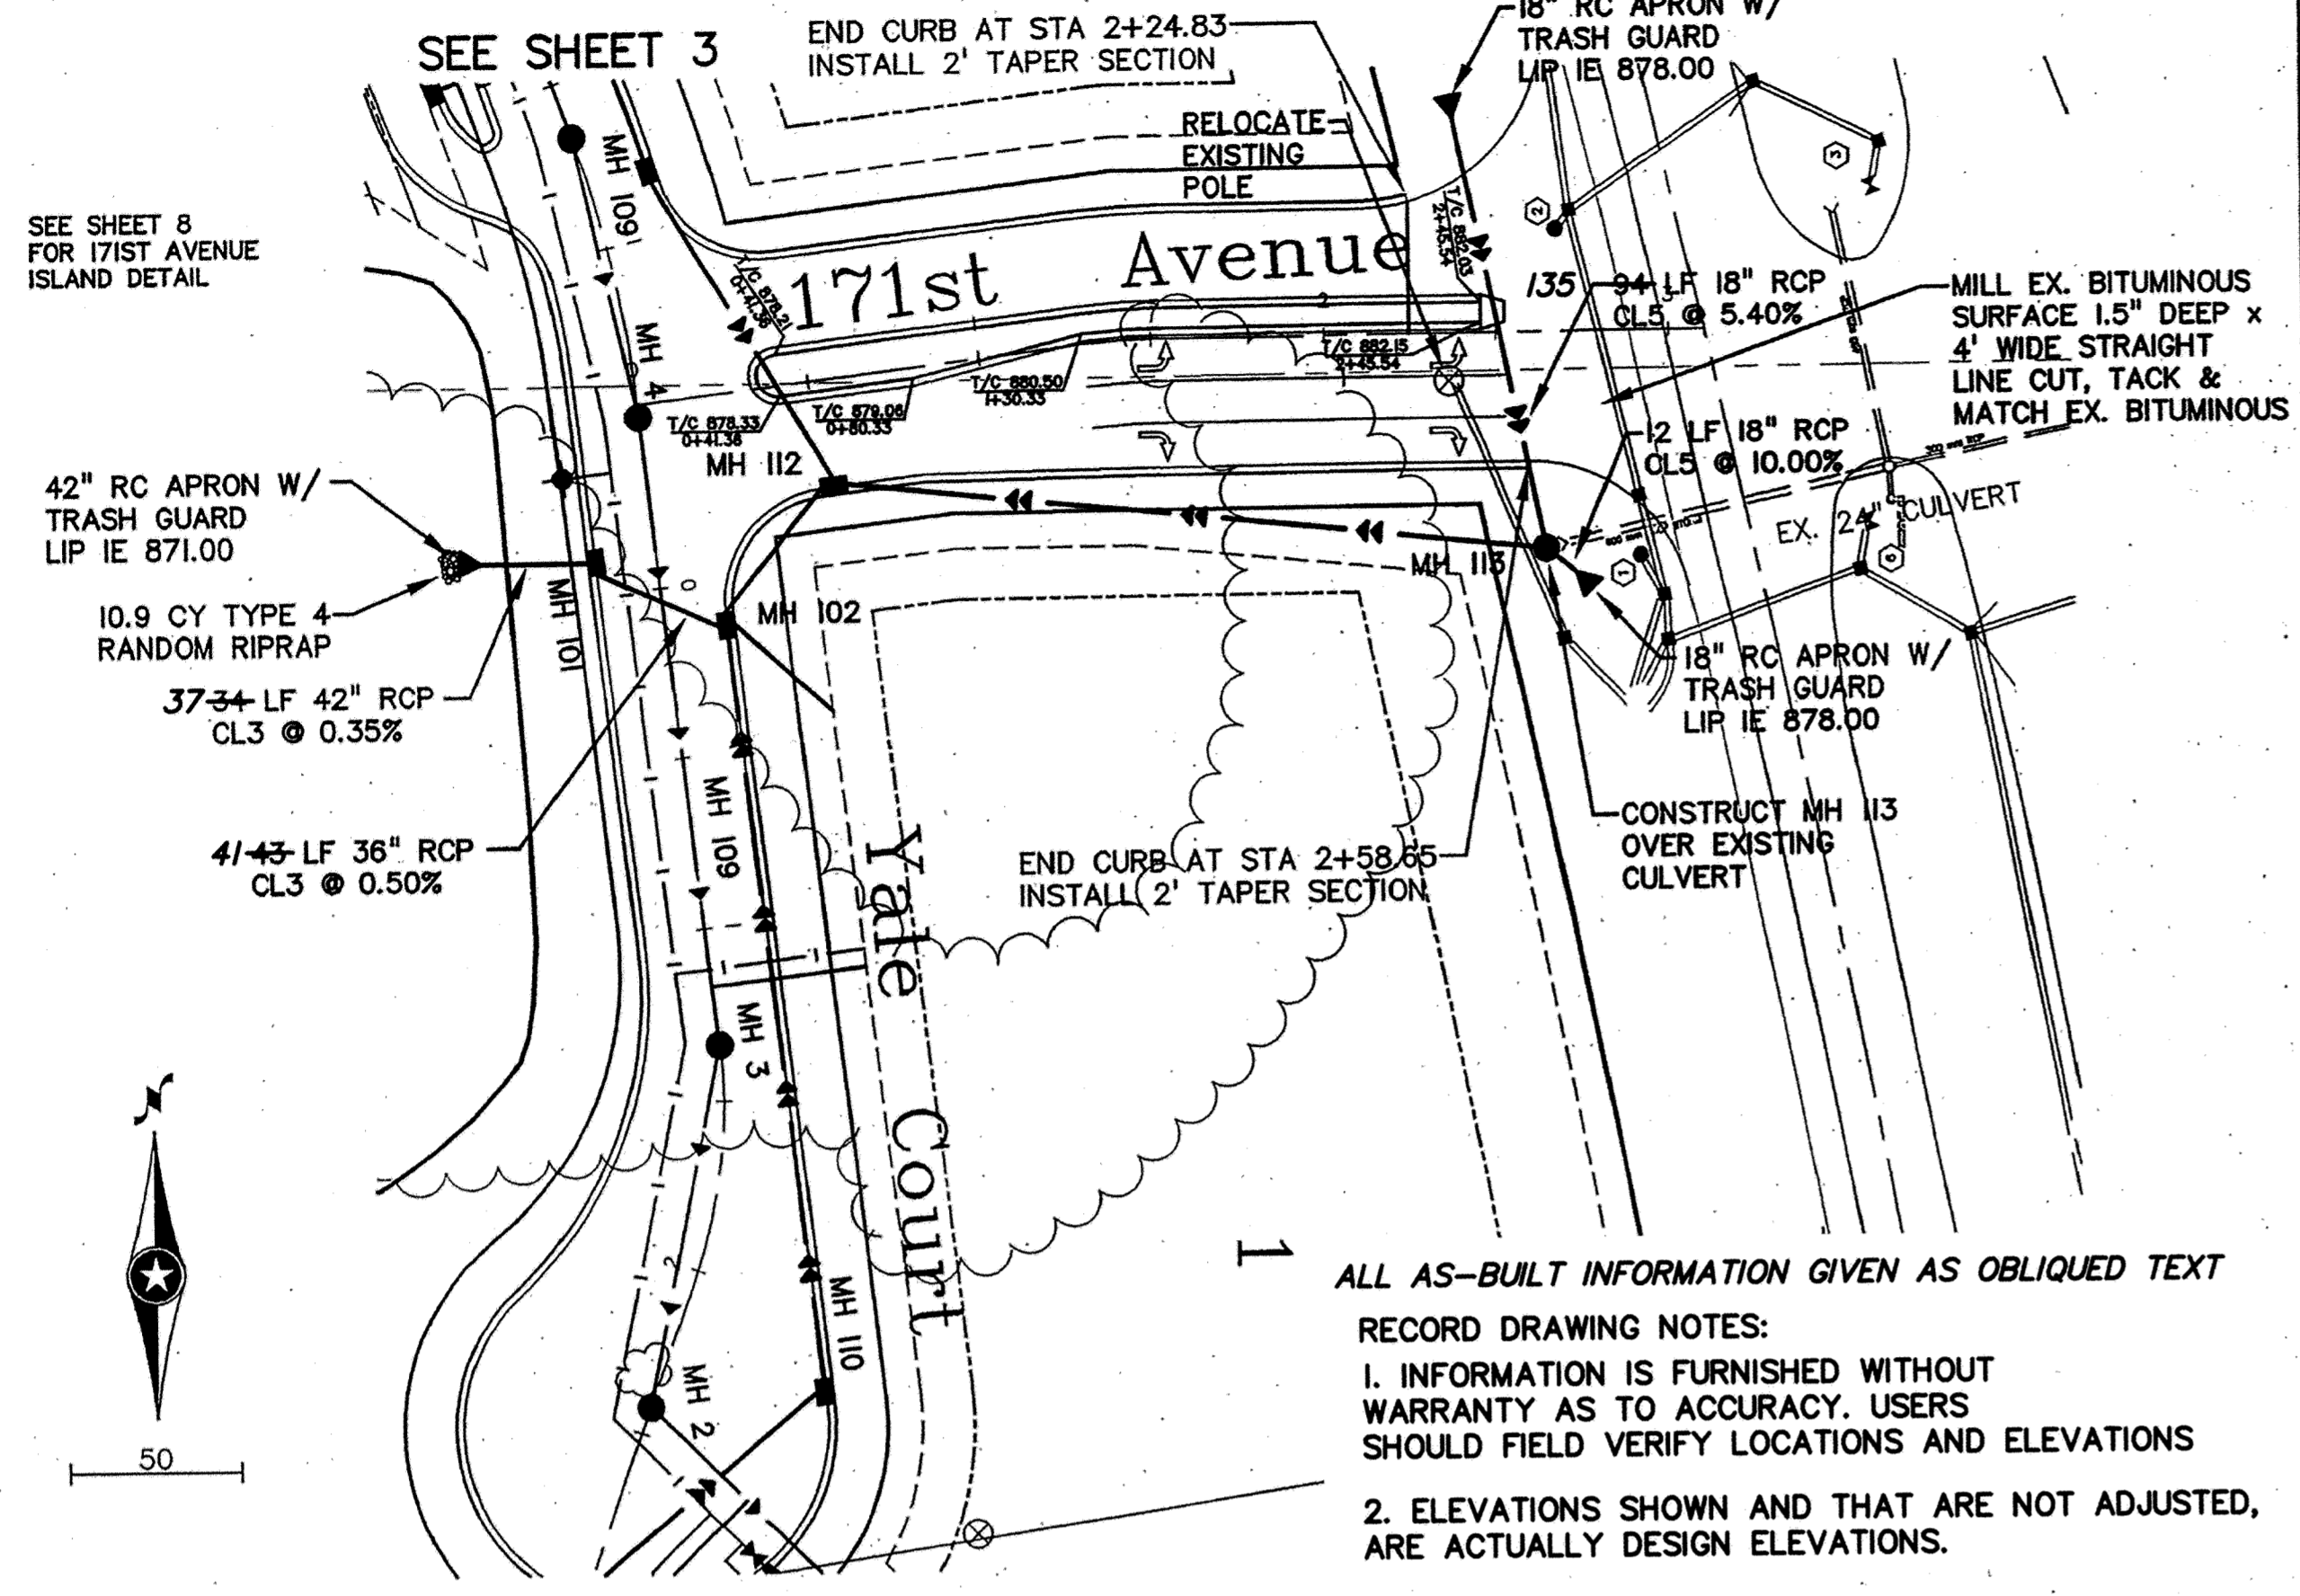



ALL AS-BUILT INFORMATION GIVEN AS OBLIQUED TEXT
RECORD DRAWING NOTES:
 1. INFORMATION IS FURNISHED WITHOUT WARRANTY AS TO ACCURACY. USERS SHOULD FIELD VERIFY LOCATIONS AND ELEVATIONS
 2. ELEVATIONS SHOWN AND THAT ARE NOT ADJUSTED, ARE ACTUALLY DESIGN ELEVATIONS.

RECORD DRAWING
 MEASURED & INSPECTED BY:
 HOWARD R. GREEN, INC.
 DRAWN BY MG @ BPA

| SERVICE TIES | | | | SANITARY SERVICE | | | |
|--------------|-----|----------|------|------------------|------|---------|---------------|
| BLK. | LOT | TIE I.D. | DIST | TIE I.D. | DIST | WYE STA | EASE. LINE IE |
| I | 19 | HYD | 37' | CB I19 | 45' | 0+70 | 878.0 |
| I | 20 | MH 8 | 63' | HYD | 48' | 1+05 | 880.0 |
| I | 21 | MH 8 | 79' | HYD | 92' | 0+47 | 880.0 |
| I | 22 | CB I08 | 95' | HYD | 137' | 0+91 | 884.0 |
| I | 23 | MH 9 | 85' | CB I08 | 77' | 1+50 | NO ELEV. |
| I | 24 | MH 9 | 62' | CB I08 | 90' | 1+97 | NO ELEV. |
| I | 25 | MH I0 | 68' | HYD | 53' | 0+47 | NO ELEV. |
| 2 | 6 | MH 9 | 41' | CB I08 | 63' | 2+06 | 883.00 |

I hereby certify that this plan, specification and report was prepared by me or under my direct supervision and that I am a duly Licensed Professional Engineer under the laws of the state of Minnesota.
 Signed: *Christopher C. Ottner*
 Date: 10-26-04
 Reg. No. 41961
 CHRISTOPHER C. OTTNER
 ENGINEERING
 10716 FIRST STREET, BECKER, MN 55306-9322
 TEL: 763-262-8822 FAX: 763-262-8844

CONTACTS
 GENERAL CONTRACTOR: MEADOWVALE, INC.
 DEVELOPER: SCOTT POWELL

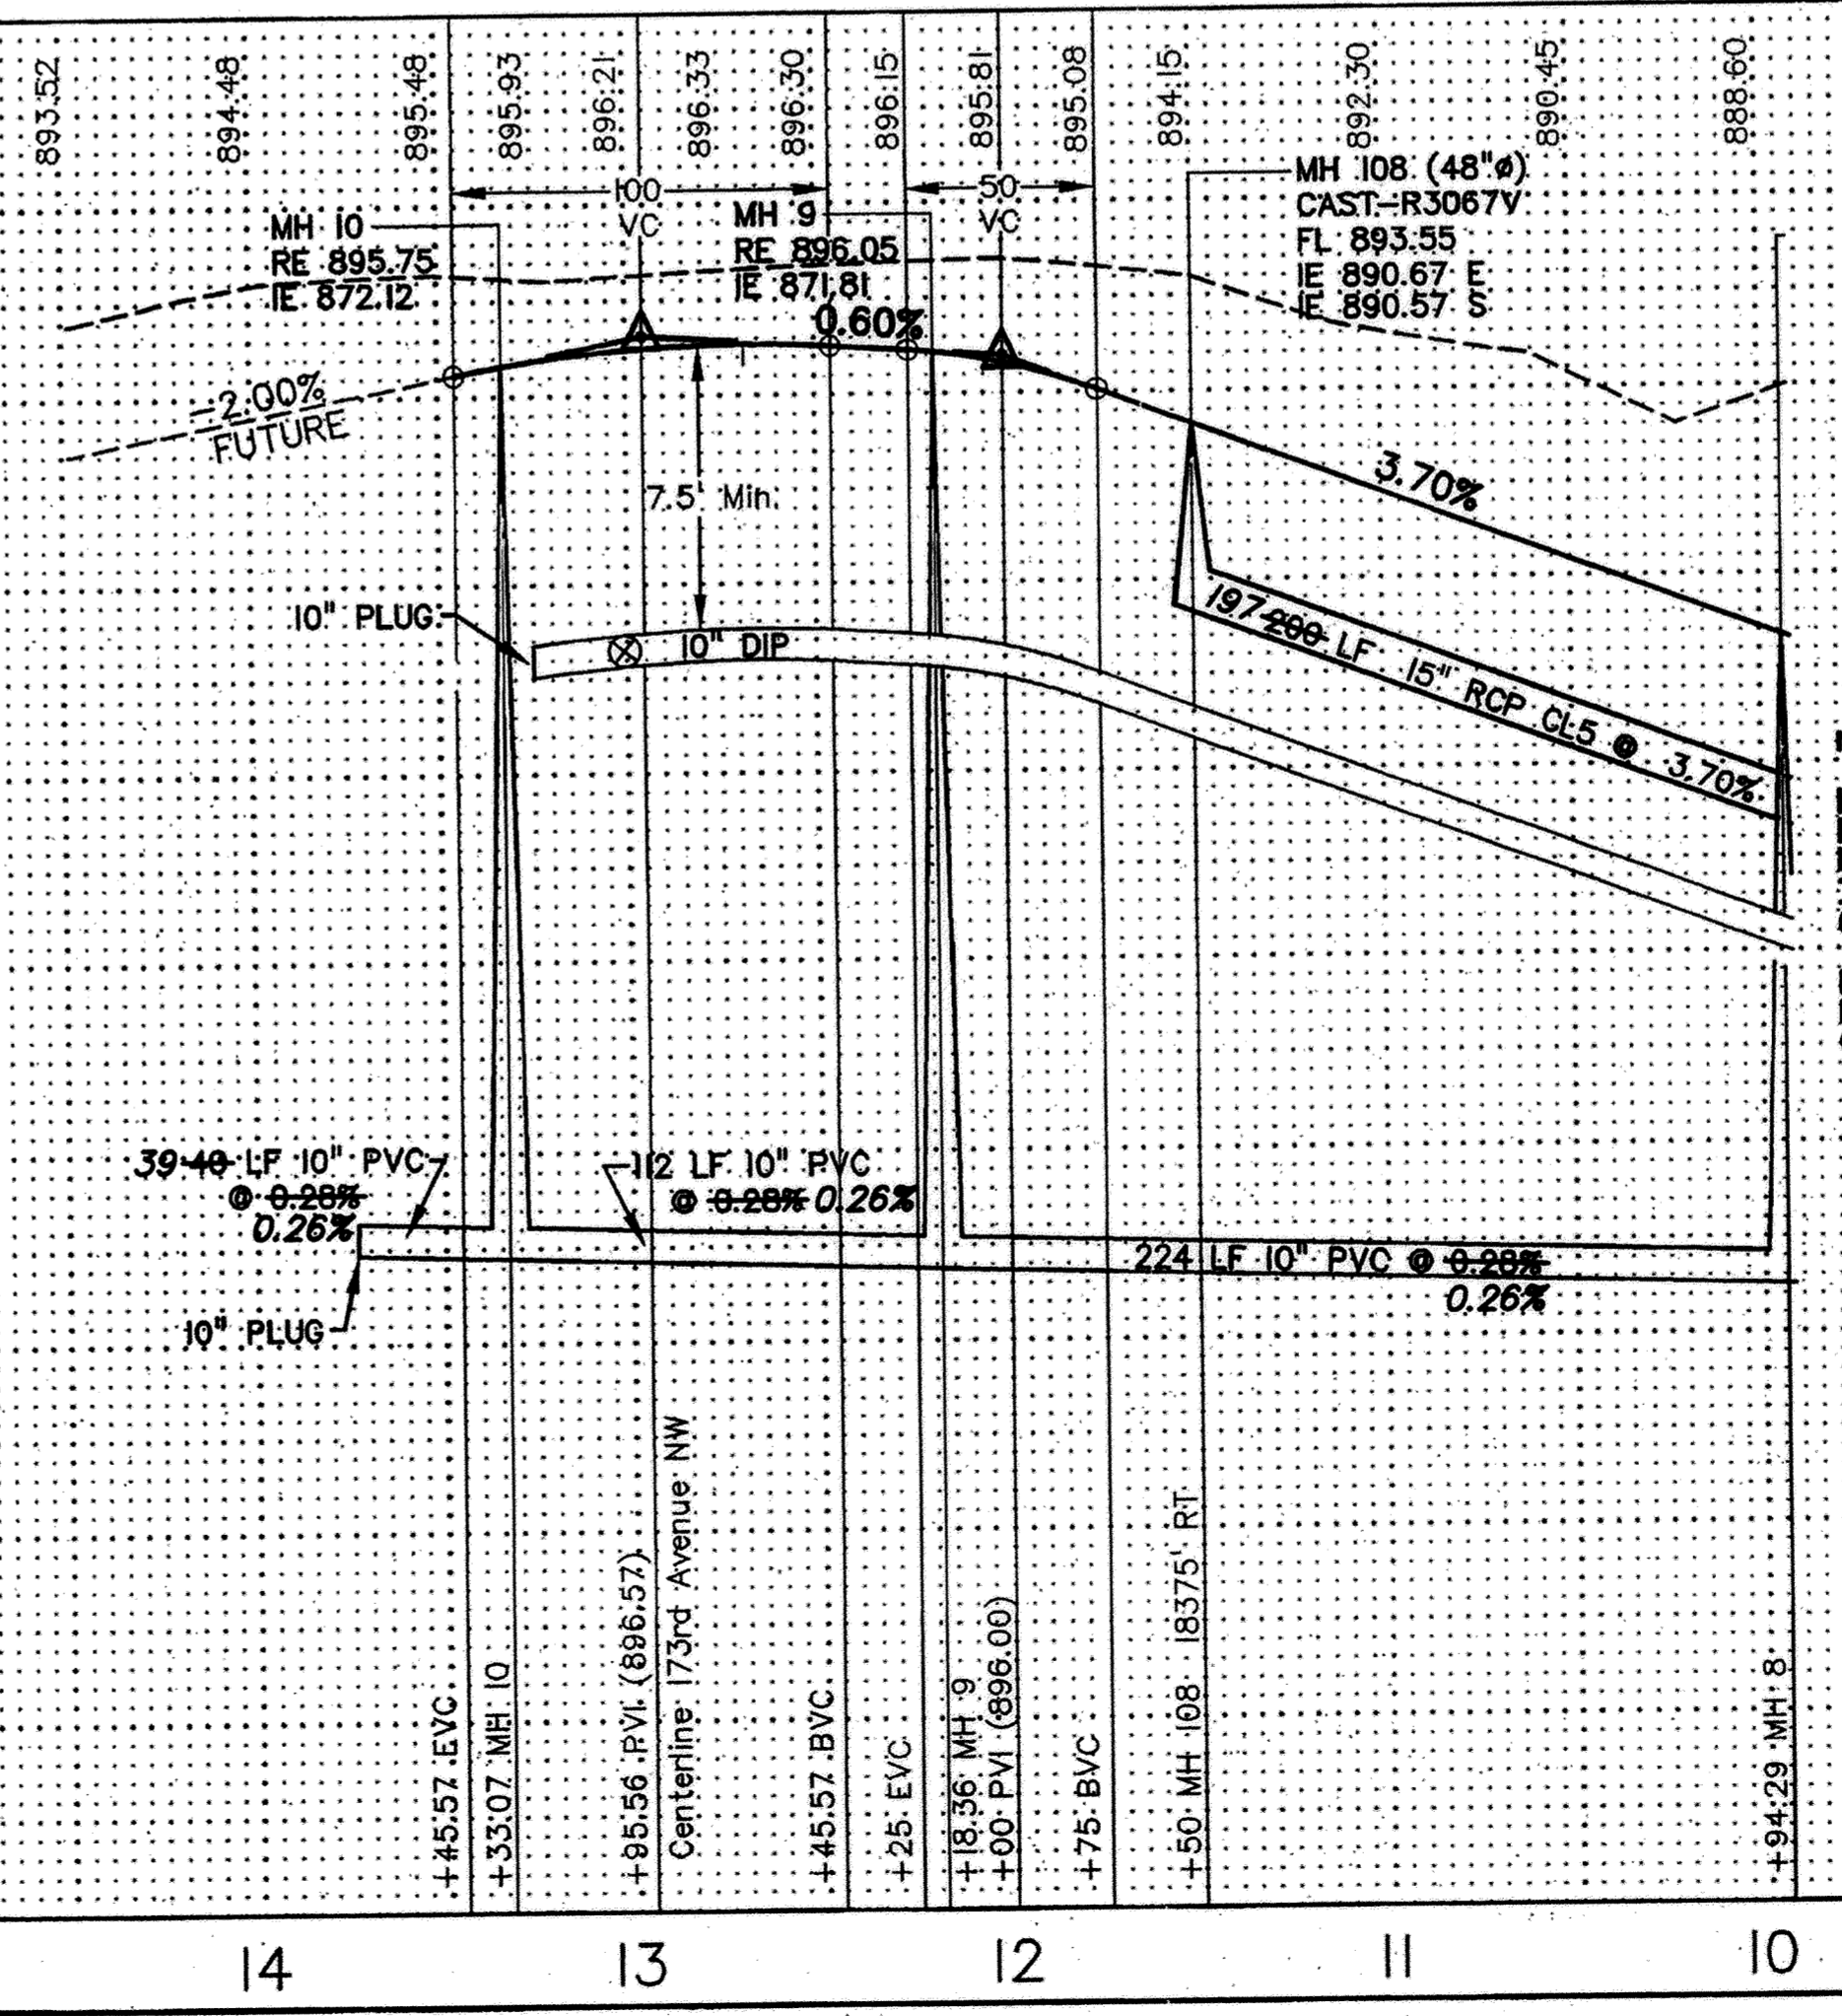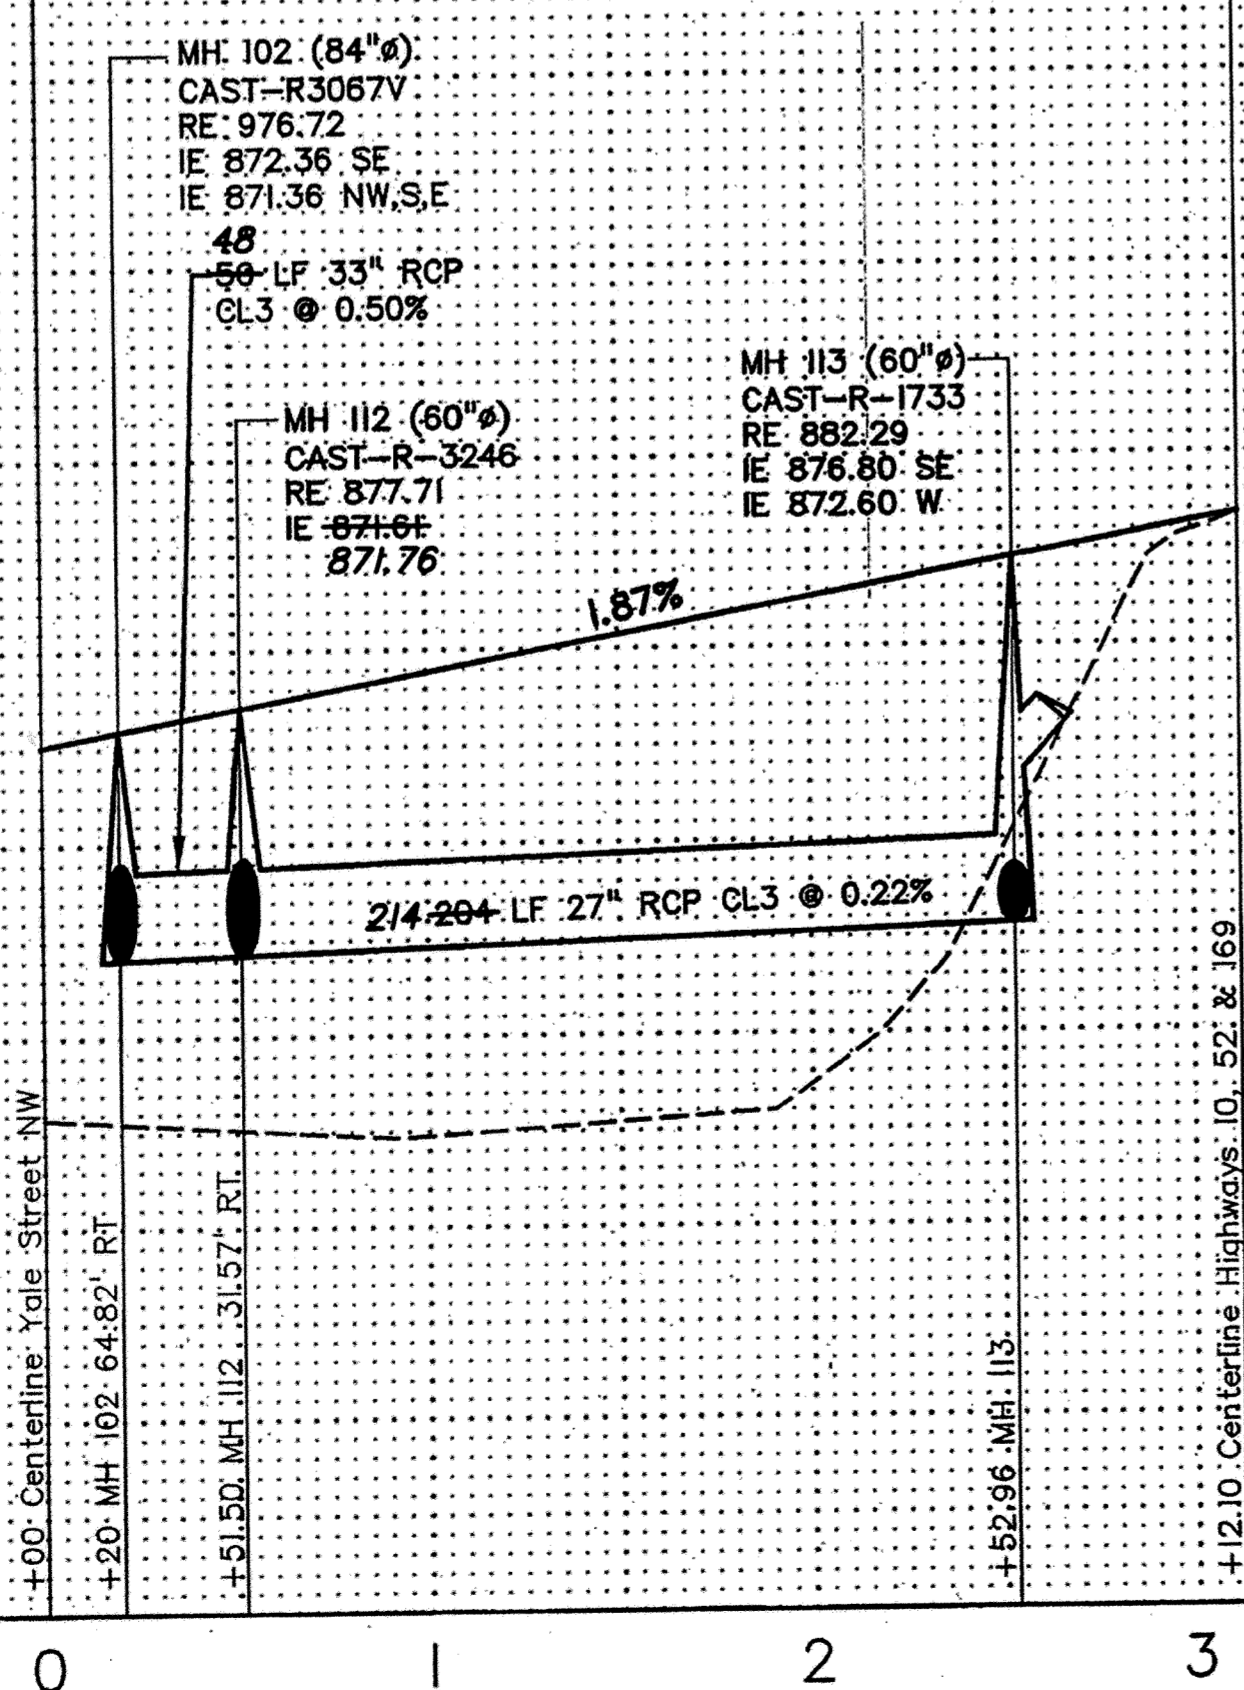

BOGART, PEDERSON & ASSOCIATES, INC.
 LAND SURVEYING
 CIVIL ENGINEERING
 13076 FIRST STREET, BECKER, MN 55306-9322
 TEL: 763-262-8822 FAX: 763-262-8844

MISSISSIPPI RIDGE
 ELK RIVER, MN
SCOTT POWELL
 STREET, SAN. SEWER, STORM SEWER &
 WATERMAIN CONSTRUCTION PLAN
 YALE STREET NW & 171st AVENUE NW

SHEET NO.
 4 OF 5

DRAWING NUMBER

DRAWING NUMBER

DRAWING NUMBER

DRAWING NUMBER
 MISSRIDG06
 4