


SHEET INDEX

TITLE SHEET	1
INDEX AND STREET SIGN PLAN	2
180TH AVENUE NW – SANITARY SEWER, WATERMAIN, STORM SEWER, AND STREET CONSTRUCTION	3
CONCORD ST NW – SANITARY SEWER, WATERMAIN, AND STREET CONSTRUCTION	4
179TH COURT NW & CONCORD CRT NW – SANITARY SEWER, WATERMAIN, STORM SEWER AND STREET CONSTRUCTION	5
ELGIN STREET NW – SANITARY SEWER, WATERMAIN, STORM SEWER AND STREET CONSTRUCTION	6
STORM SEWER	7
LIFT STATION	8
LIFT STATION	9
DETAILS	10
DETAILS	11
DETAILS	12

RECORD DRAWINGS

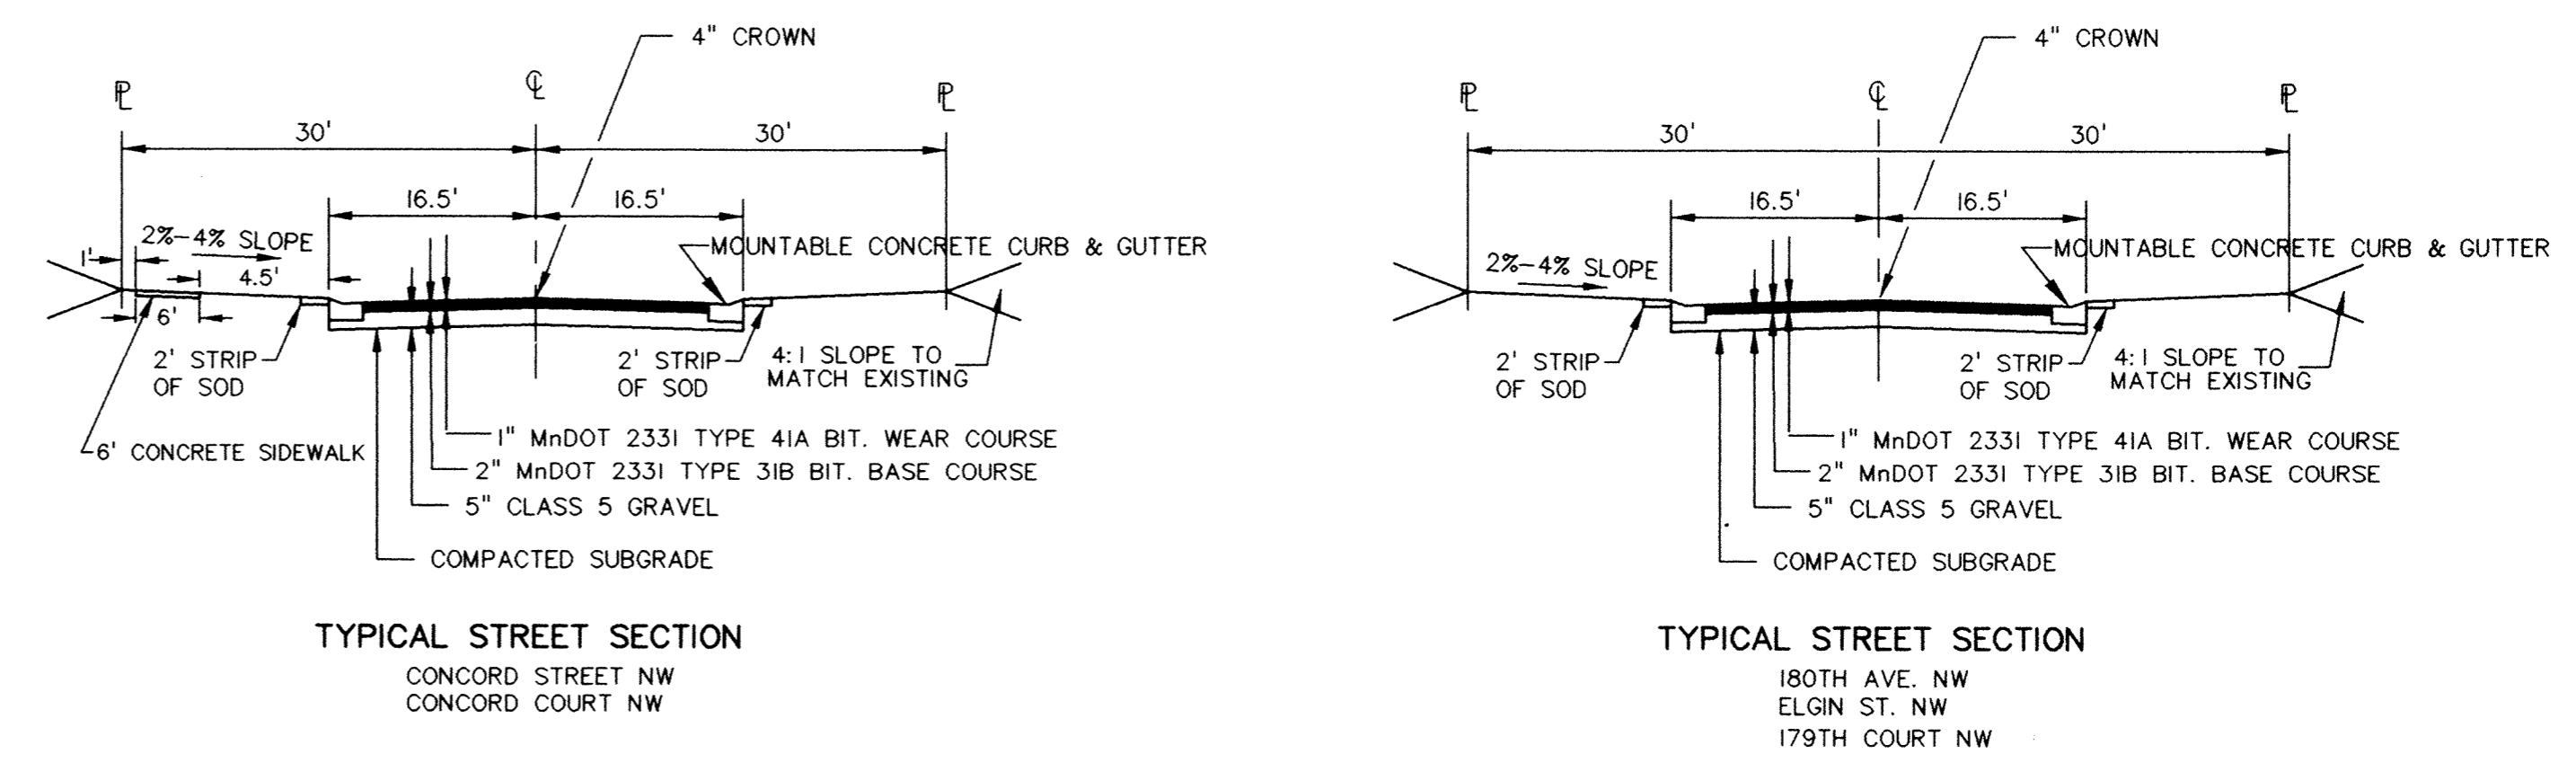

PRIME CONTRACTOR/UTILITIES: C. W. HOULE, INC.
 CURB & GUTTER: HALVORSON CONCRETE, INC.
 STREETS: BAUERLY BROS., INC.
 INSPECTION: RALPH BADER, HOWARD R. GREEN CO.
 SURVEY: JOHN OLIVER & ASSOCIATES, INC.
 EARTHWORK: SOIL-CON, INC.
 RECORD DRAWINGS: FRED FRITSCHEL, JOHN OLIVER & ASSOCIATES, INC.
 CONSTRUCTED: 1997

STREET SIGN LEGEND
 + STREET SIGN WITH 2 BLADES –4ea.
 ○ RI-I STOP (CITY STANDARD) –2ea.


ORIG. DATE: 5/5/95
 DESIGN BY: JR, PG, TM
 DRAWN BY: PG
 CHECKED BY: TM
 REVISIONS: 8/28/96
 CITY COMMENTS: 12/23/97 RECORD DRAWINGS

I hereby certify that this plan was prepared by me or under my direct supervision and that I am a duly Registered Professional Engineer under the laws of the State of Minnesota.

Signed: *John Oliver*
 Date: 7/22/96 Reg. No. 20383

John Oliver & Associates, Inc.
 Civil Engineering, Land Surveying, Land Planning
 580 Dodge Avenue
 Elk River, Minnesota
 (612)441-2072 (FAX)441-5665
 201 W. Travelers Trail, Suite 200
 Burnsville, MN 55337
 (612)894-3045 (FAX)894-3049

MISSISSIPPI OAKS SECOND ADDITION
 SHEET INDEX & STREET SIGN PLAN
SHEET 2 OF 12 FILE NO. 6521.20-03

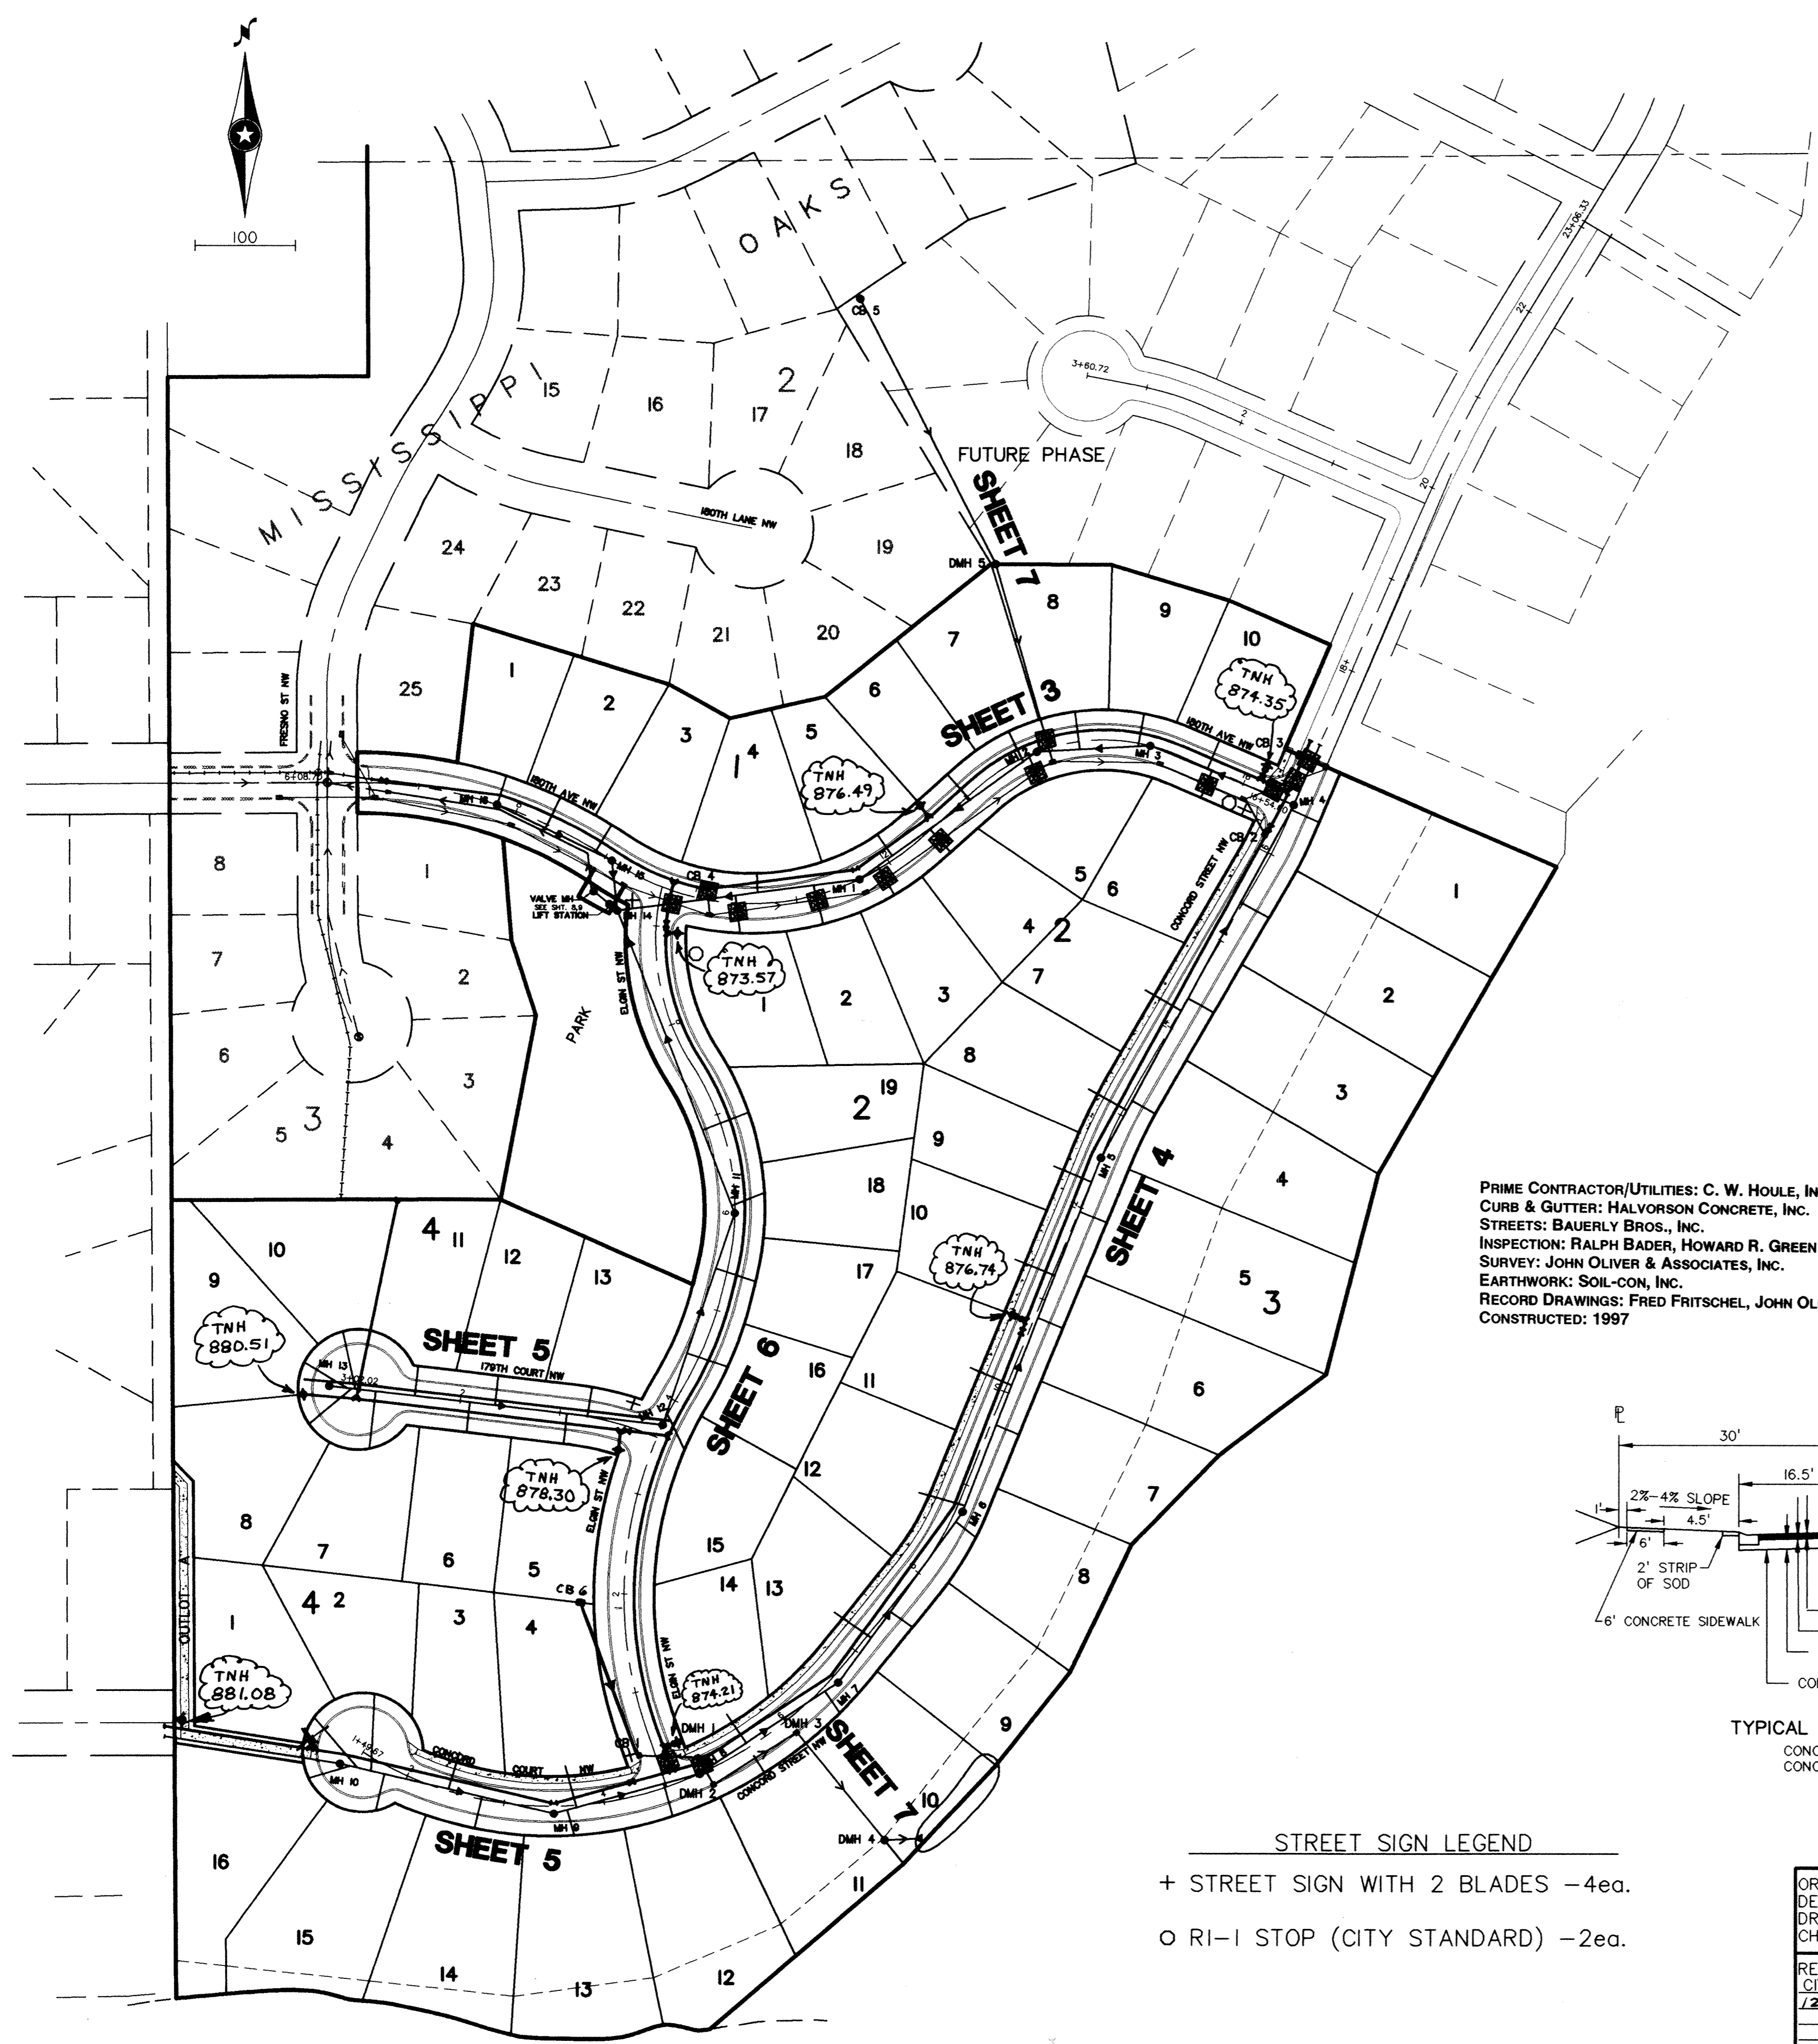

SAYCO PRODUCTS • NEW HAVEN, MINNESOTA
 REPRODUCED BY PLAN NUMBER 6521