

MISSISSIPPI OAKS 3RD ADDITION

ELK RIVER, MINNESOTA

MISSISSIPPI OAKS DEVELOPMENT CORP.

RECORD DRAWINGS

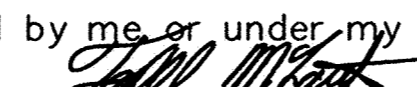
SANITARY SEWER, WATERMAIN,
STORM SEWER & STREET IMPROVEMENTS

PRIME CONTRACTOR/UTILITIES: KUECHLE UNDERGROUND, INC.
EARTHWORK: NORTH PINE AGGREGATE, INC.
CURB & GUTTER: SCHMIDT CURB COMPANY, INC.
STREETS: BAUERLY BROTHERS CO.
INSPECTION: HOWARD R. GREEN, INC.
SURVEY: JOHN OLIVER & ASSOCIATES, INC.
RECORD DRAWINGS: FRED FRITSCHER, JOHN OLIVER & ASSOCIATES, INC.
CONSTRUCTED: 2002

Civil Engineering
Land Surveying
Land Planning

John Oliver & Associates, Inc.

580 Dodge Avenue, Elk River, Minnesota 55330 763-441-2072, Fax 763-441-5665
Offices in: Elk River, Burnsville and Brooklyn Center, Minnesota

I hereby certify that this plan, specification, or report was prepared by me or under my direct supervision and that I am a duly Licensed Professional Engineer under State of Mn. Statutes 326.02-326.16
 Date 8/2/02 Mn. Reg. No. 20383

TODD McLOUTH, PE

REV. NO.	DATE	REVISIONS	SHEETS REVISED
1	9/9/02	CITY COMMENTS	1-13
2	9/25/02	CITY COMMENTS	7, 9
3	2/26/03	RECORD DRAWINGS	ALL

1 / 13

DRAWING NUMBER MISS302