

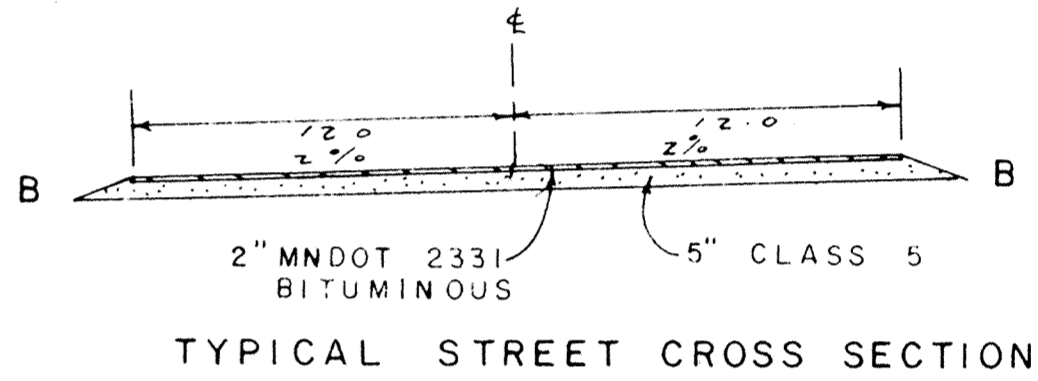
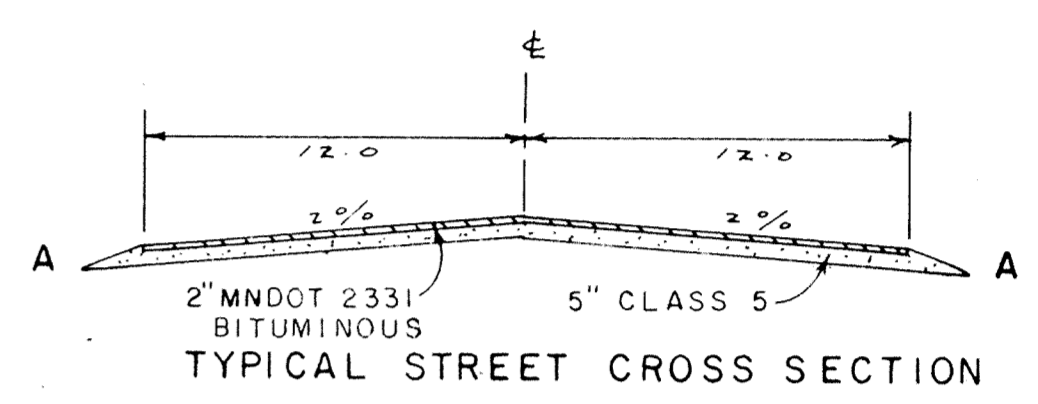


PLAN & PROFILE FOR: MEADOWLARK TOWNHOMES

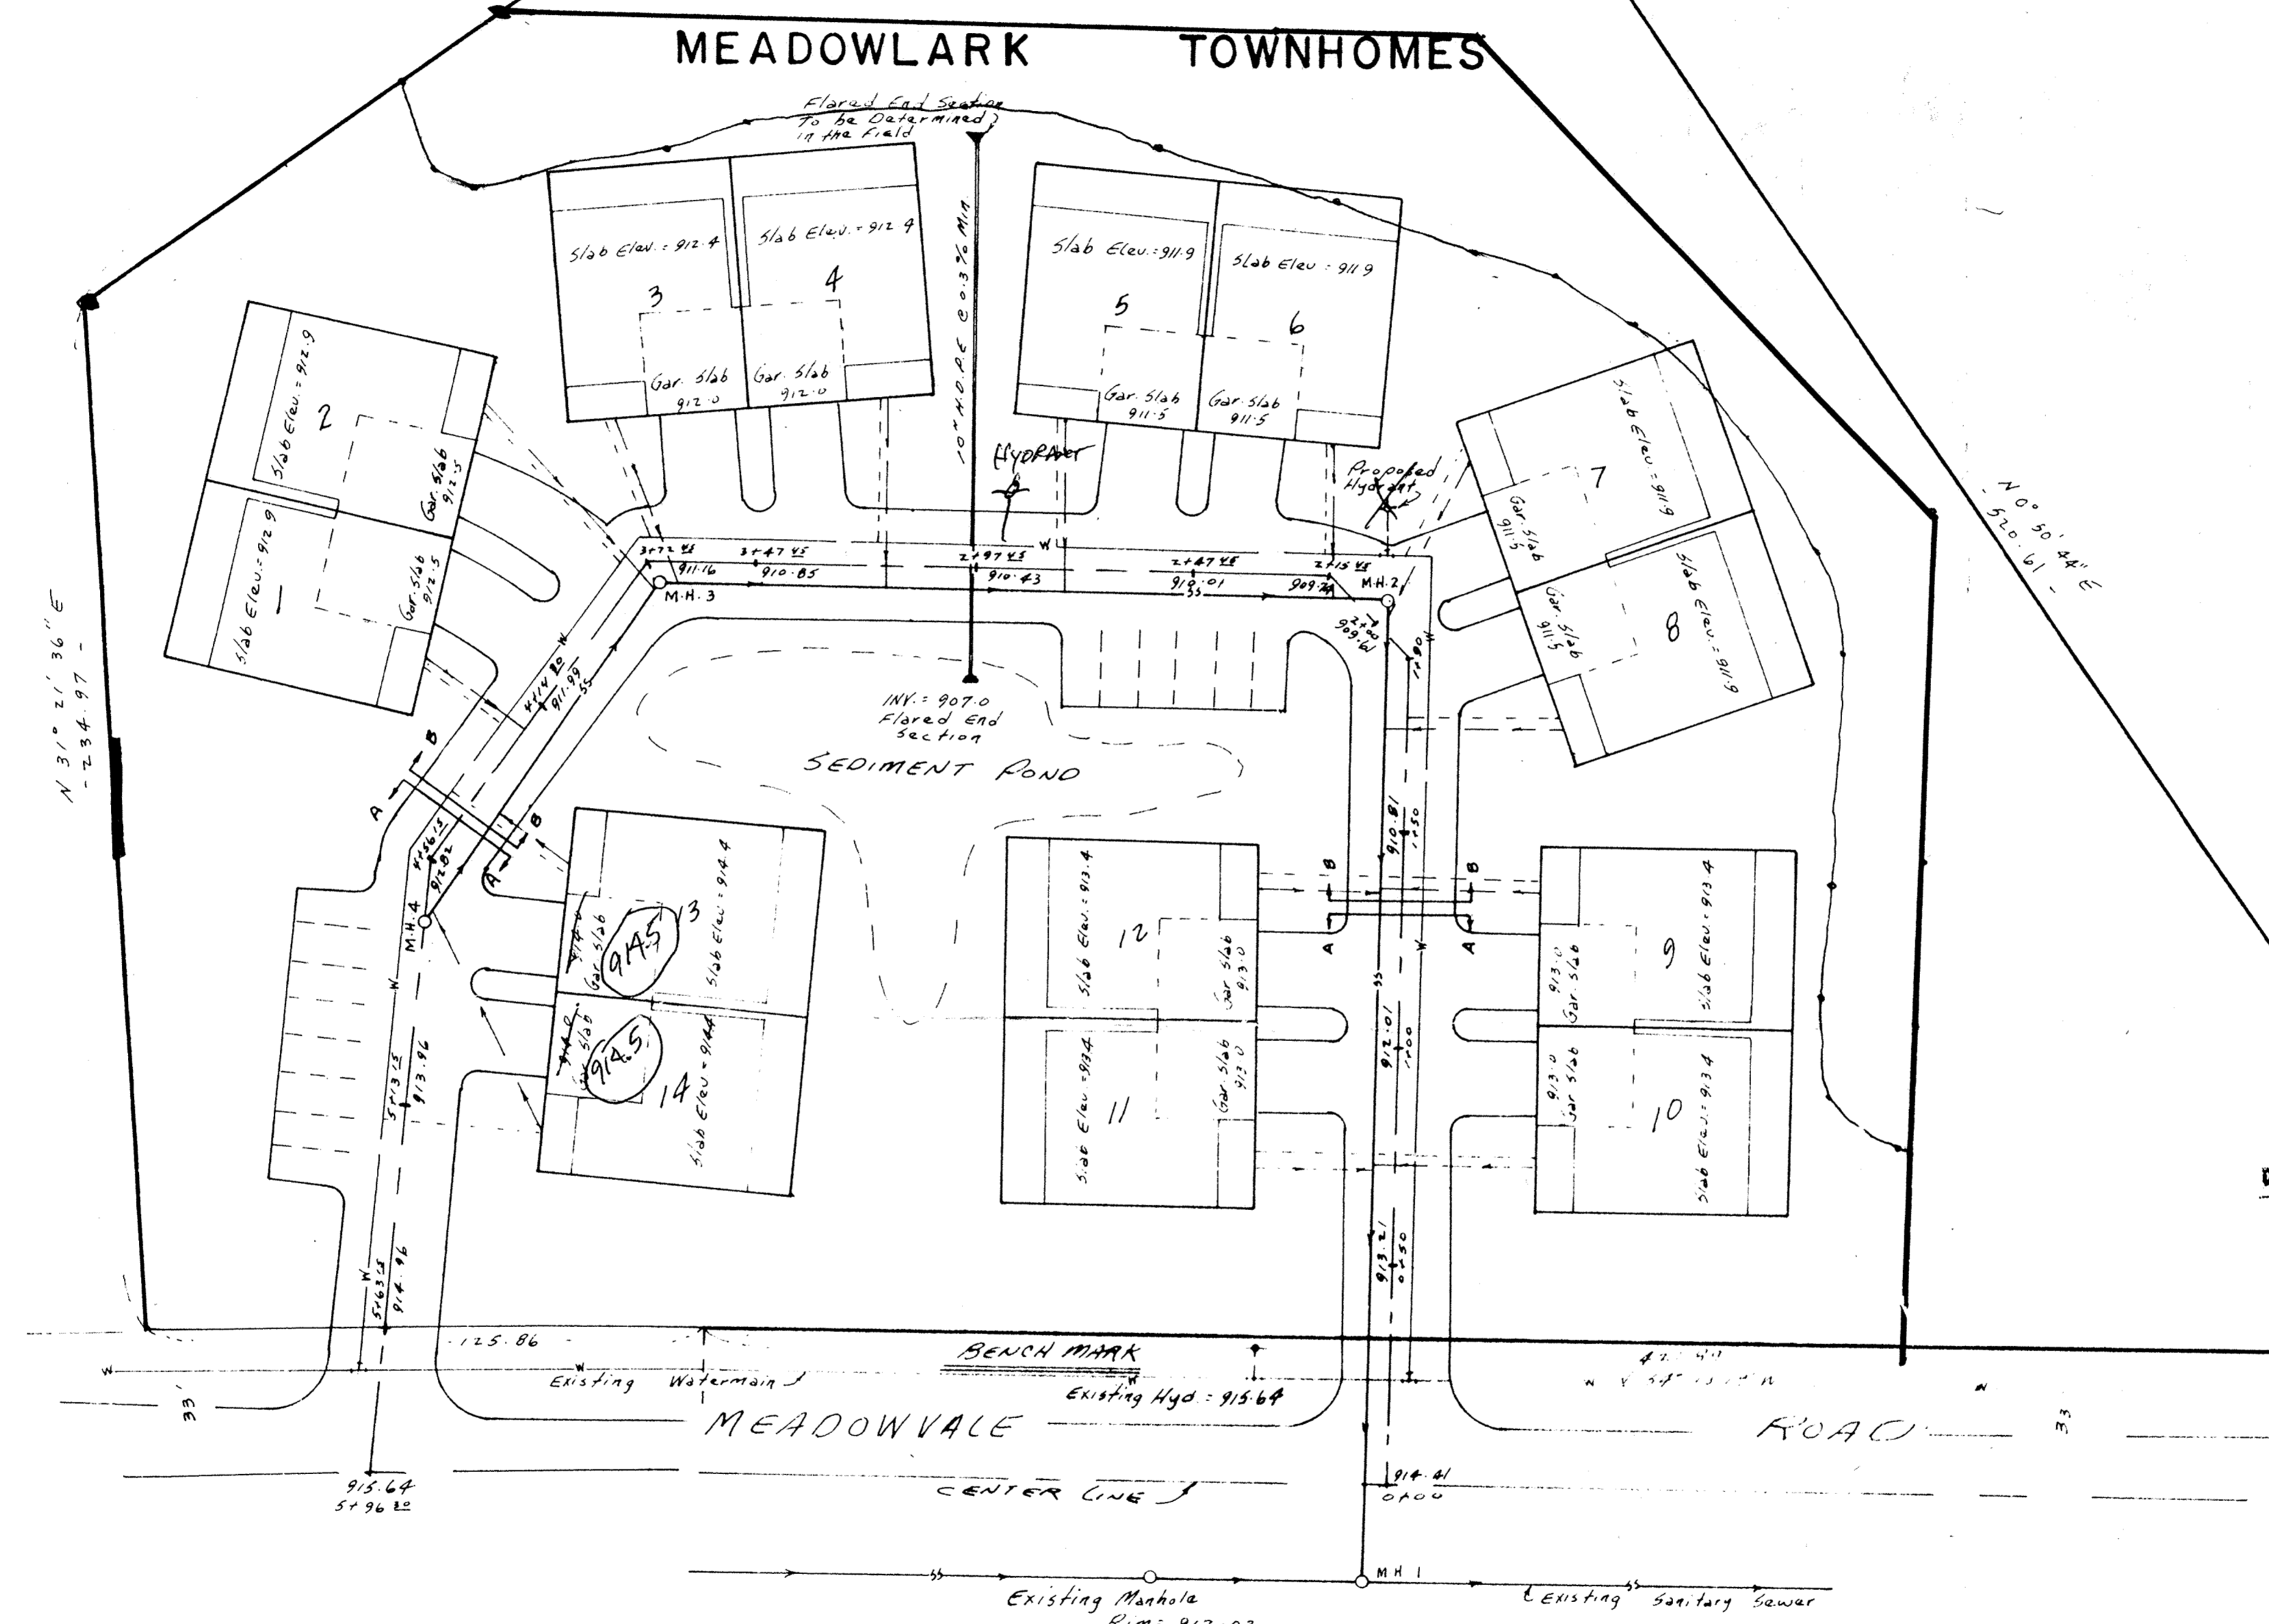

APPROVED
 Date: 10/14/94
 NOTE: Lots 13/14 Raised 0.5' to 914.5

I HEREBY CERTIFY THAT THIS PLAN, SPECIFICATION OR REPORT WAS PREPARED BY ME OR UNDER MY DIRECT SUPERVISION AND THAT I AM A DULY REGISTERED PROFESSIONAL ENGINEER UNDER THE LAWS OF THE STATE OF MINNESOTA.
 Kenneth J. Gust
 REGISTRATION NO. 9631, DATED 9-22-94

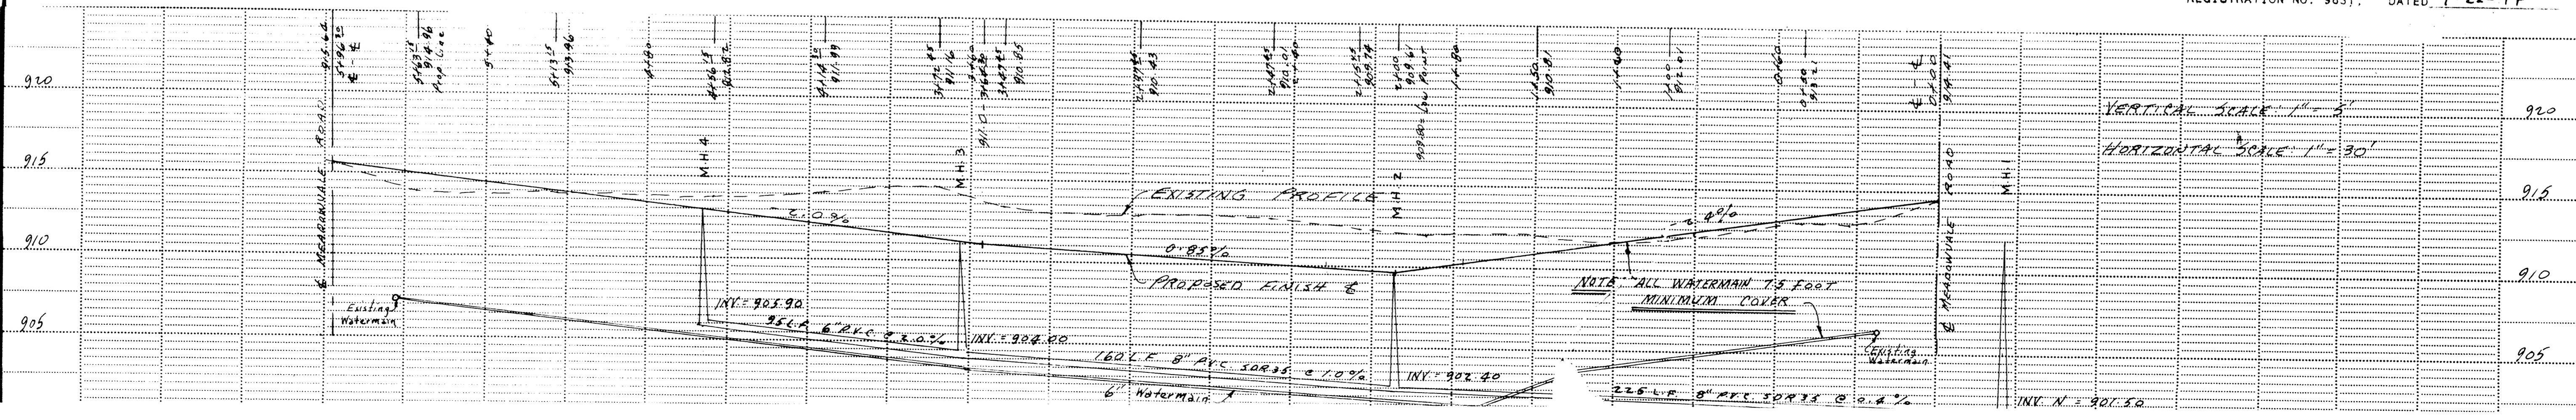

NOTE: ALL WATERMAIN TO BE AT MINIMUM COVER