


NOTE:
 PROJECT WAS CONSTRUCTED IN
 GENERAL CONFORMANCE TO
 PLANS AND SPECIFICATIONS.

RECORD DRAWING
 This record drawing has been prepared in strict accordance with the information furnished by the owner. It is the responsibility of the owner to ensure that the information furnished is accurate and complete. The engineer's responsibility is to verify the information furnished and to prepare this record drawing. It is not a record drawing of the actual construction. It is a record drawing of the information furnished by the owner and the engineer's verification thereof. It is not a record drawing of the actual construction. It is a record drawing of the information furnished by the owner and the engineer's verification thereof.

Prepared By: *Marty O'Connell* Date: 11/27/2016

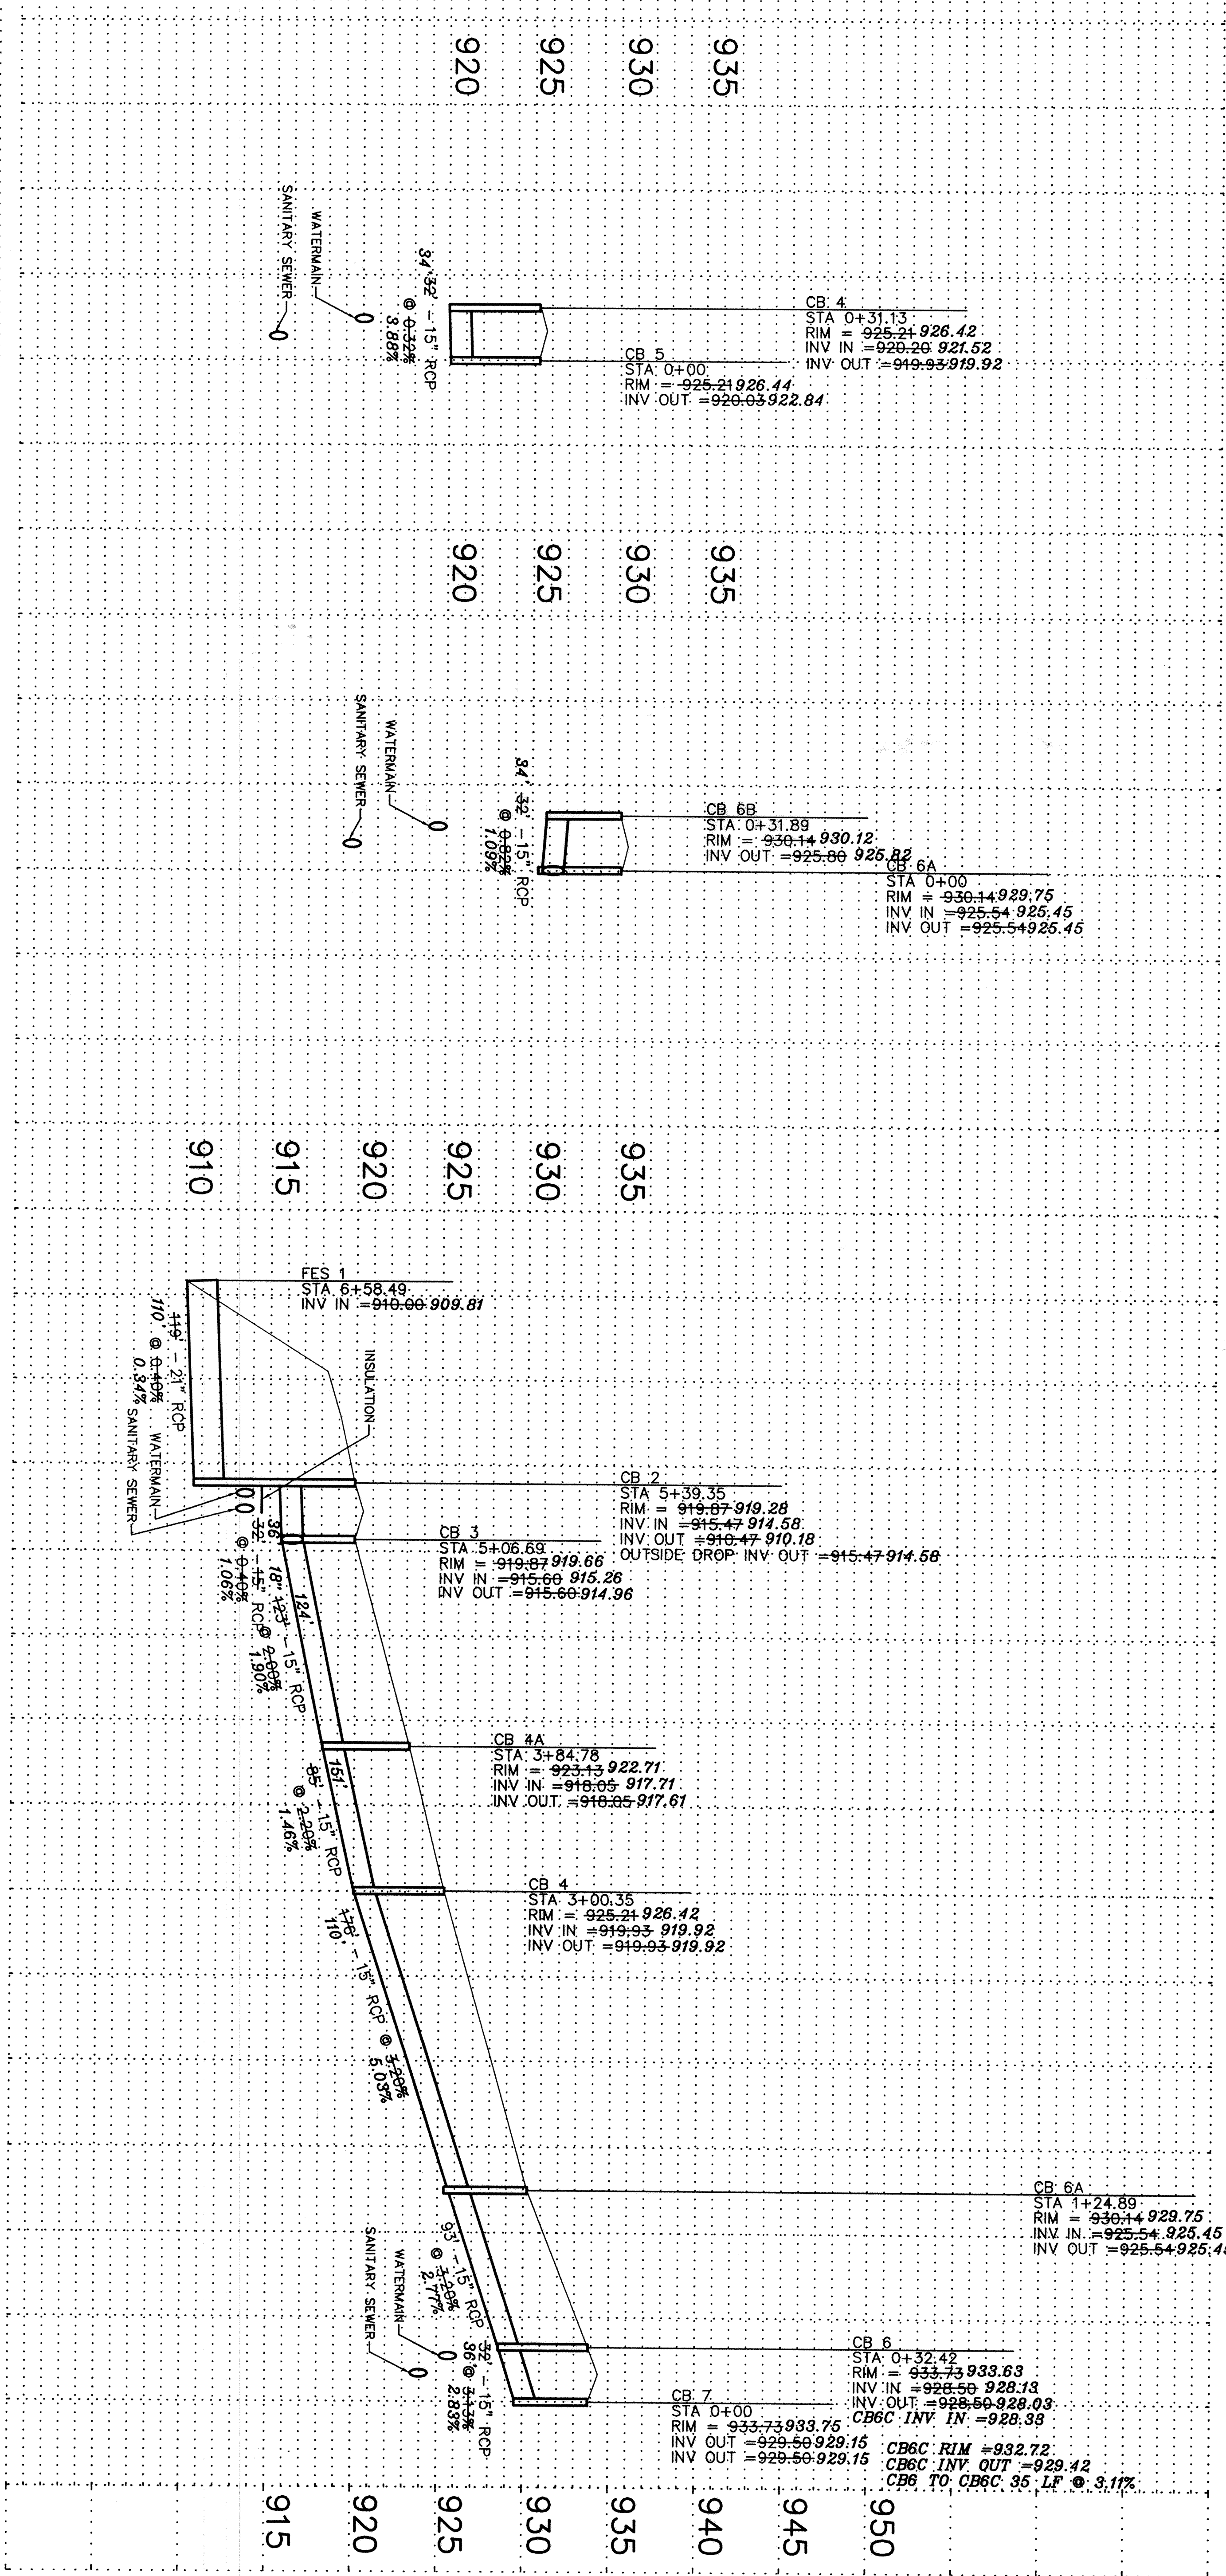

NORDIC HILLS CITY OF ELK RIVER MINNESOTA		ROYAL DAKS REALTY, INC 1000 SHOREVIEW, MN 55128 TEL: 651-483-6518 FAX: 651-483-6642
ASSOCIATES Planning • Civil Engineering • Land Surveying Landscape Architecture • Environmental • Technology Surveying • Professional Engineering Services 111 1/2 W. Hennepin Avenue, Suite 200 Minneapolis, MN 55402		PROJECT NO: 02-015 SHEET NO: C6-2