


NORDIC WOODS

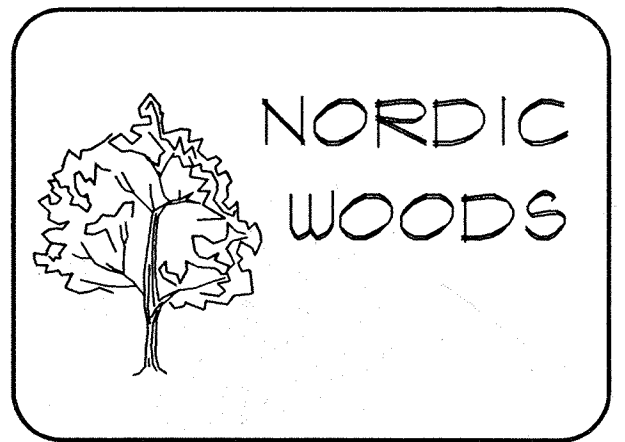

CITY
OF
ELK
RIVER
MINNESOTA

OWNER/DEVELOPER

RICHARD LUND
3075 COON RAPIDS BLVD.
COON RAPIDS, MINNESOTA
55433

SHEET INDEX

SHEET	TITLE	REV.
C11	TITLE SHEET	
C21	FINAL PLAN	
C33	100 SCALE GRADING PLAN	
	UTILITIES & STREETS	
C42	195TH AVE. NORTH	
C43	195TH AVE. NORTH	
C44	BOSTON STREET	
C45	ALBANY COURT ALBANY STREET	
C46	ZUMBRO STREET	
C47	194TH AVE. NO.	
C91	DETAIL SHEET	
C92	DETAIL SHEET	
C93	BOOSTER STATION DETAIL	

DATE	REVISION
7-3-96	CITY COMMENTS
9-10-96	RAISED STREET GRADES



CERTIFICATION:
I hereby certify that this plan was prepared by me, or under my direct supervision, and that I am a duly registered Professional Engineer under the laws of the state of MINNESOTA.

Stephen H. Johnston
Stephen H. Johnston
Registration No. 1994 Date: 5-15-96




DATE: 5-15-96
FILE NAME: C102NWDWG
PROJECT NO. HC95004

TITLE SHEET
C1.1

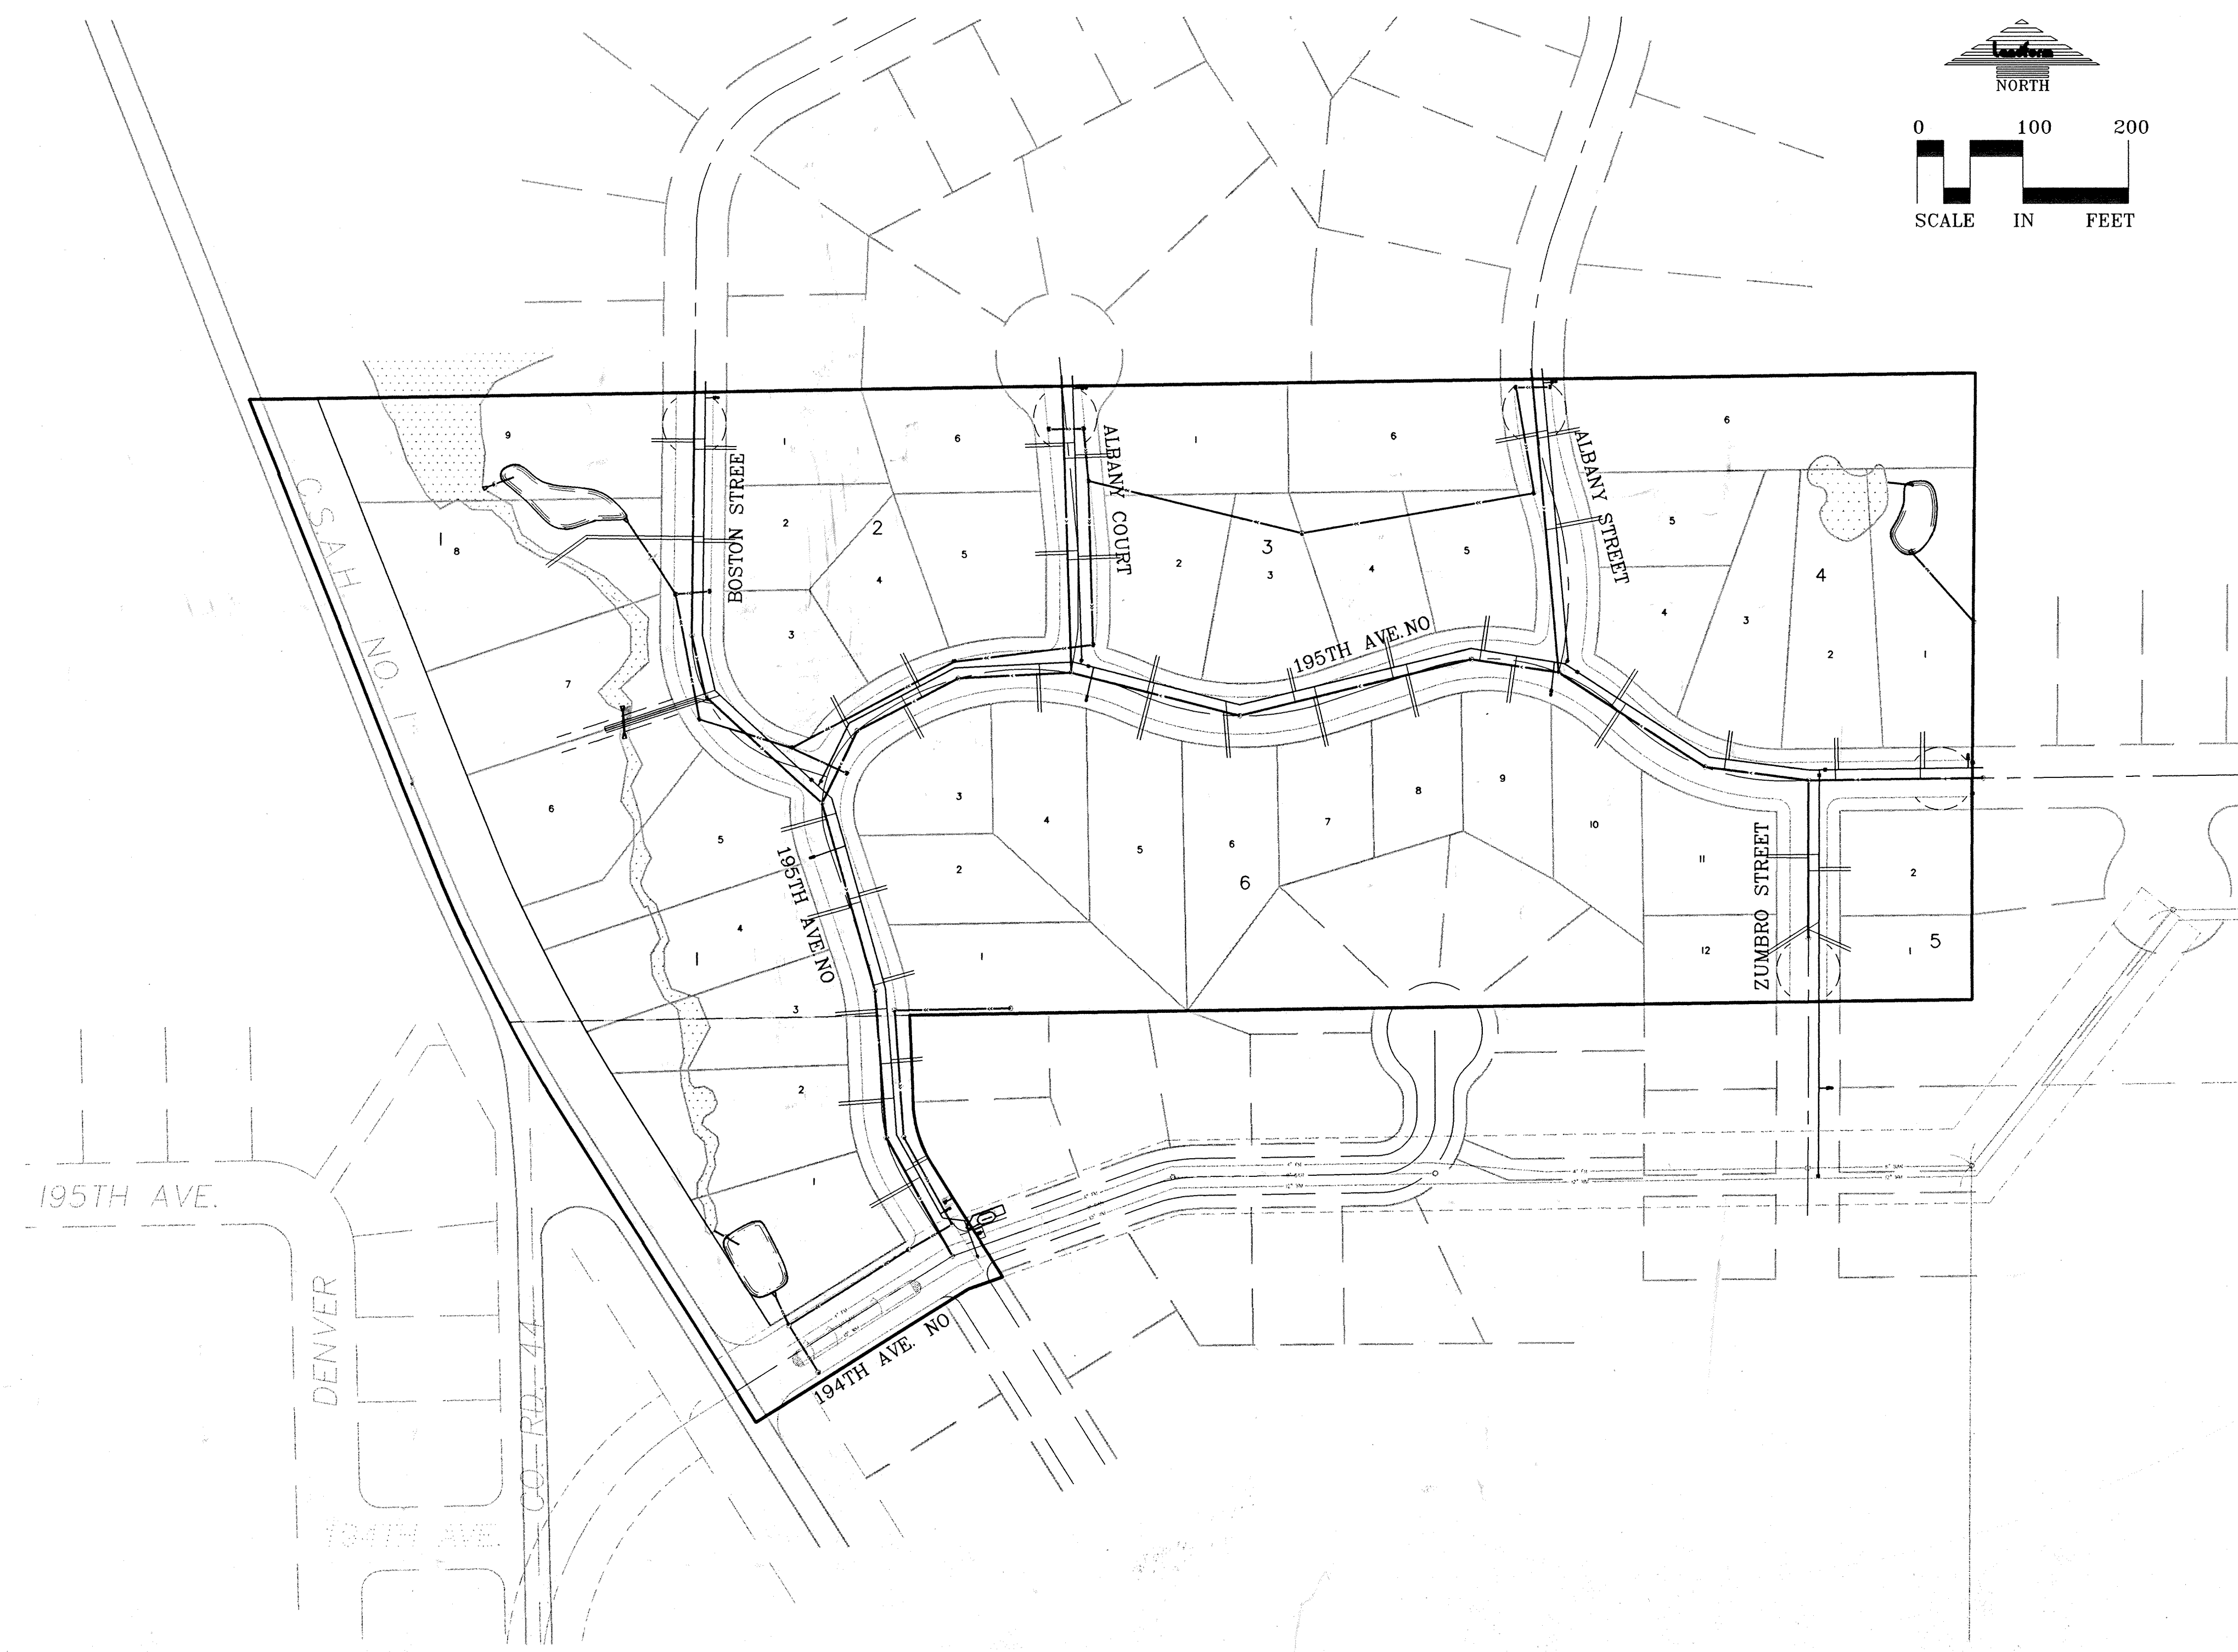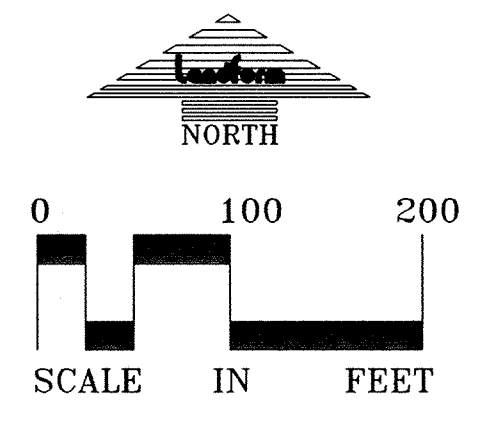

AS-BUILT COMPLETED BY: LANDFORM ENGINEERING COMPANY
DATE: AUGUST 12, 1997

CONTRACTOR:
ANNANDALE CONTRACTING
6646 COUNTY ROAD 5 NW
ANNANDALE, MN 55302

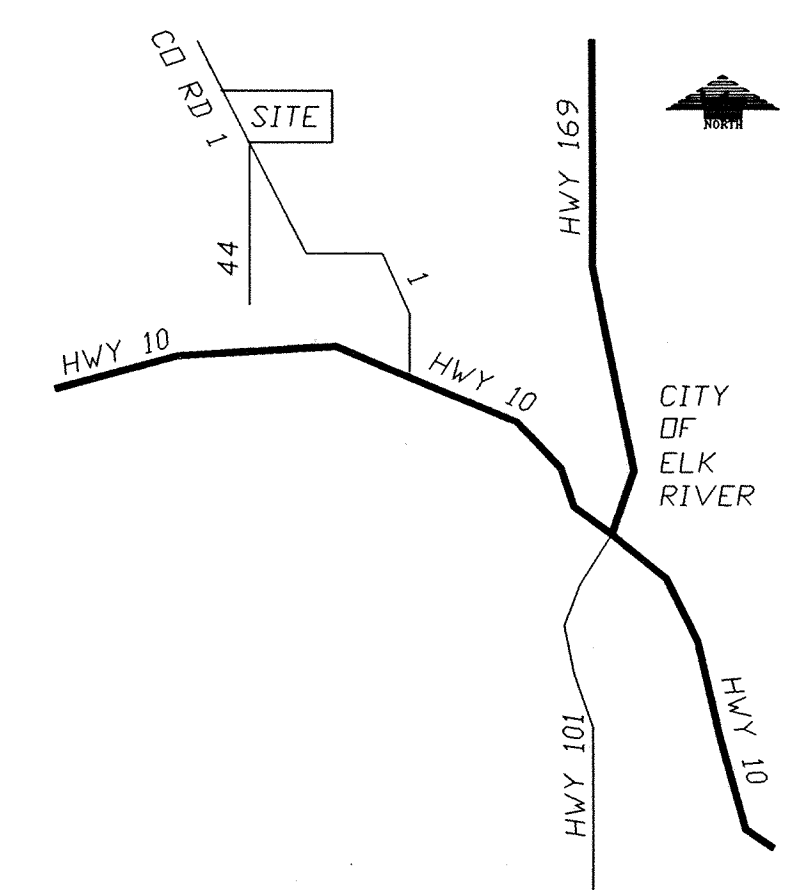

LOCATION MAP

Approved by _____ Date _____
City Engineer