
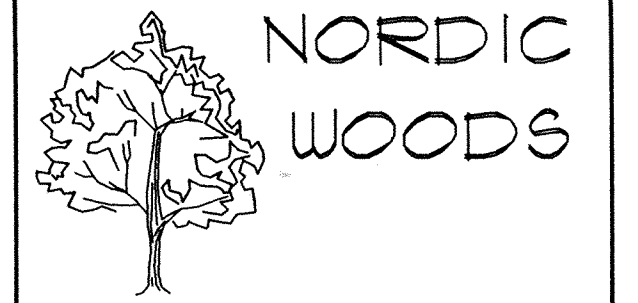


# NORDIC WOODS

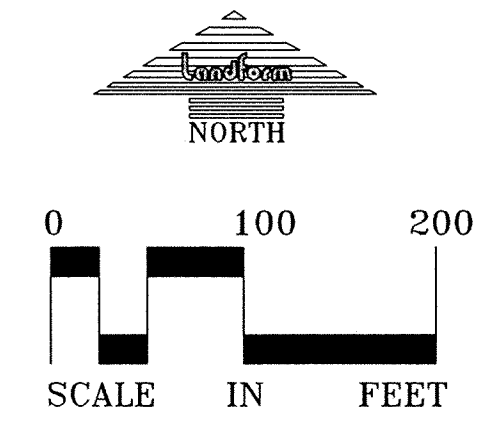

CITY  
OF  
ELK  
RIVER  
MINNESOTA

OWNER/DEVELOPER

RICHARD LUND  
3075 COON RAPIDS BLVD.  
COON RAPIDS, MINNESOTA  
55433

SHEET INDEX

SHEET	TITLE	REV.
C11	TITLE SHEET	
C21	FINAL FLAT	
C33	100 SCALE GRADING PLAN	
UTILITIES & STREETS		
C42	195TH AVE. NORTH	
C43	195TH AVE. NORTH	
C44	BOSTON STREET	
C45	ALBANY COURT ALBANY STREET	
C46	ZUMERO STREET	
C47	194TH AVE. NO.	
C91	DETAIL SHEET	
C92	DETAIL SHEET	
C93	BOOSTER STATION DETAIL	

DATE	REVISION
7-3-96	CITY COMMENTS

CERTIFICATION:  
I hereby certify that this plan was prepared by me, or under my direct supervision, and that I am a duly registered Professional Engineer under the laws of the state of MINNESOTA.

*Stephen M. Johnston*  
Stephen M. Johnston  
Registration No: 18915 Date: 5-15-96

**Landform**  
Engineering Company  
901 Twelve Oaks Center 16500 Wayzata Boulevard  
Wayzata, Minnesota 55391 (612)475-3272

AS-BUILT COMPLETED BY: LANDFORM ENGINEERING COMPANY

DATE: AUGUST 12, 1997

CONTRACTOR:  
ROYAL EXCAVATING  
4196 LEXINGTON AVE.  
SHOREVIEW, MN 55126

DATE: 5-15-96  
FILE NAME: C3030NWDWG  
PROJECT NO. HC95004

100 SCALE GRADING PLAN  
**C3.3**

