


SCALES:
 1" = 50' HOR
 1" = 5' VER

AS-BUILT COMPLETED BY: LANDFORM ENGINEERING COMPANY
 DATE: AUGUST 12, 1997
 CONTRACTOR:
 ANNANDALE CONTRACTING
 6646 COUNTY ROAD 5 NW
 ANNANDALE, MN 55302

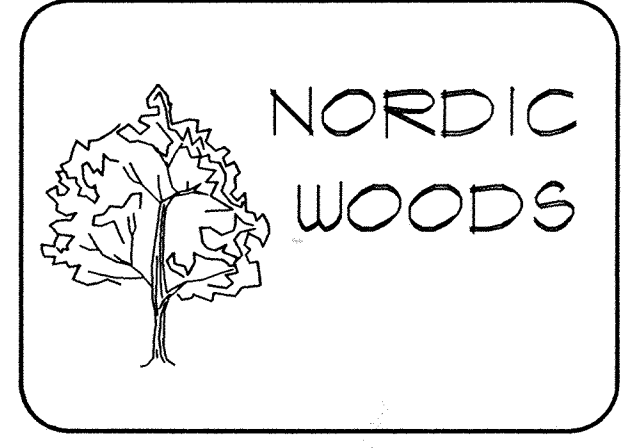

CITY
 OF
 ELK
 RIVER
 MINNESOTA

OWNER/DEVELOPER
 RICHARD LUND
 3075 COON RAPIDS BLVD.
 COON RAPIDS, MINNESOTA
 55433

SHEET	TITLE	REV.
C11	TITLE SHEET	
C21	FINAL FLAT	
C33	100 SCALE GRADING PLAN	
UTILITIES & STREETS		
C42	195TH AVE. NORTH	
C43	195TH AVE. NORTH	
C44	BOSTON STREET	
C45	ALBANY COURT ALBANY STREET	
C46	ZUMERO STREET	
C47	194TH AVE. NO.	
C31	DETAIL SHEET	
C32	DETAIL SHEET	
C33	BOOSTER STATION DETAIL	

DATE	REVISION
7-3-96	CITY COMMENTS
9-10-96	RAISED STREET GRADES
7-31-97	AS-BUILTS

CERTIFICATION:
 I hereby certify that this plan was prepared by me,
 or under my direct supervision, and that I am a duly
 registered Professional Engineer under the laws of
 the state of MINNESOTA.
Stephen M. Johnston
 Stephen M. Johnston
 Registration No: 18914 Date: 3-15-96



801 Twelve Oaks Center 15500 Wayzata Boulevard
 Wayzata, Minnesota 55391 (612)475-3272

DATE: 5-15-96
 FILE NAME: C4020NWDWG
 PROJECT NO: HC35004
 195TH AVE NO.
 0+00 - 7+00
C4.2

195TH AVENUE NORTH

