
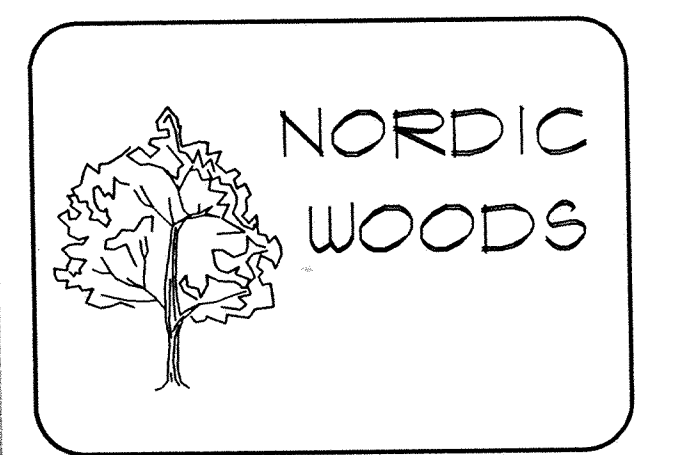


AS-BUILT COMPLETED BY: LANDFORM ENGINEERING COMPANY  
 DATE: AUGUST 12, 1997  
 CONTRACTOR:  
 ANNANDALE CONTRACTING  
 6646 COUNTY ROAD 5 NW  
 ANNANDALE, MN 55302

SCALES:  
 1" = 50' HOR  
 1" = 5' VER

195TH AVENUE NORTH

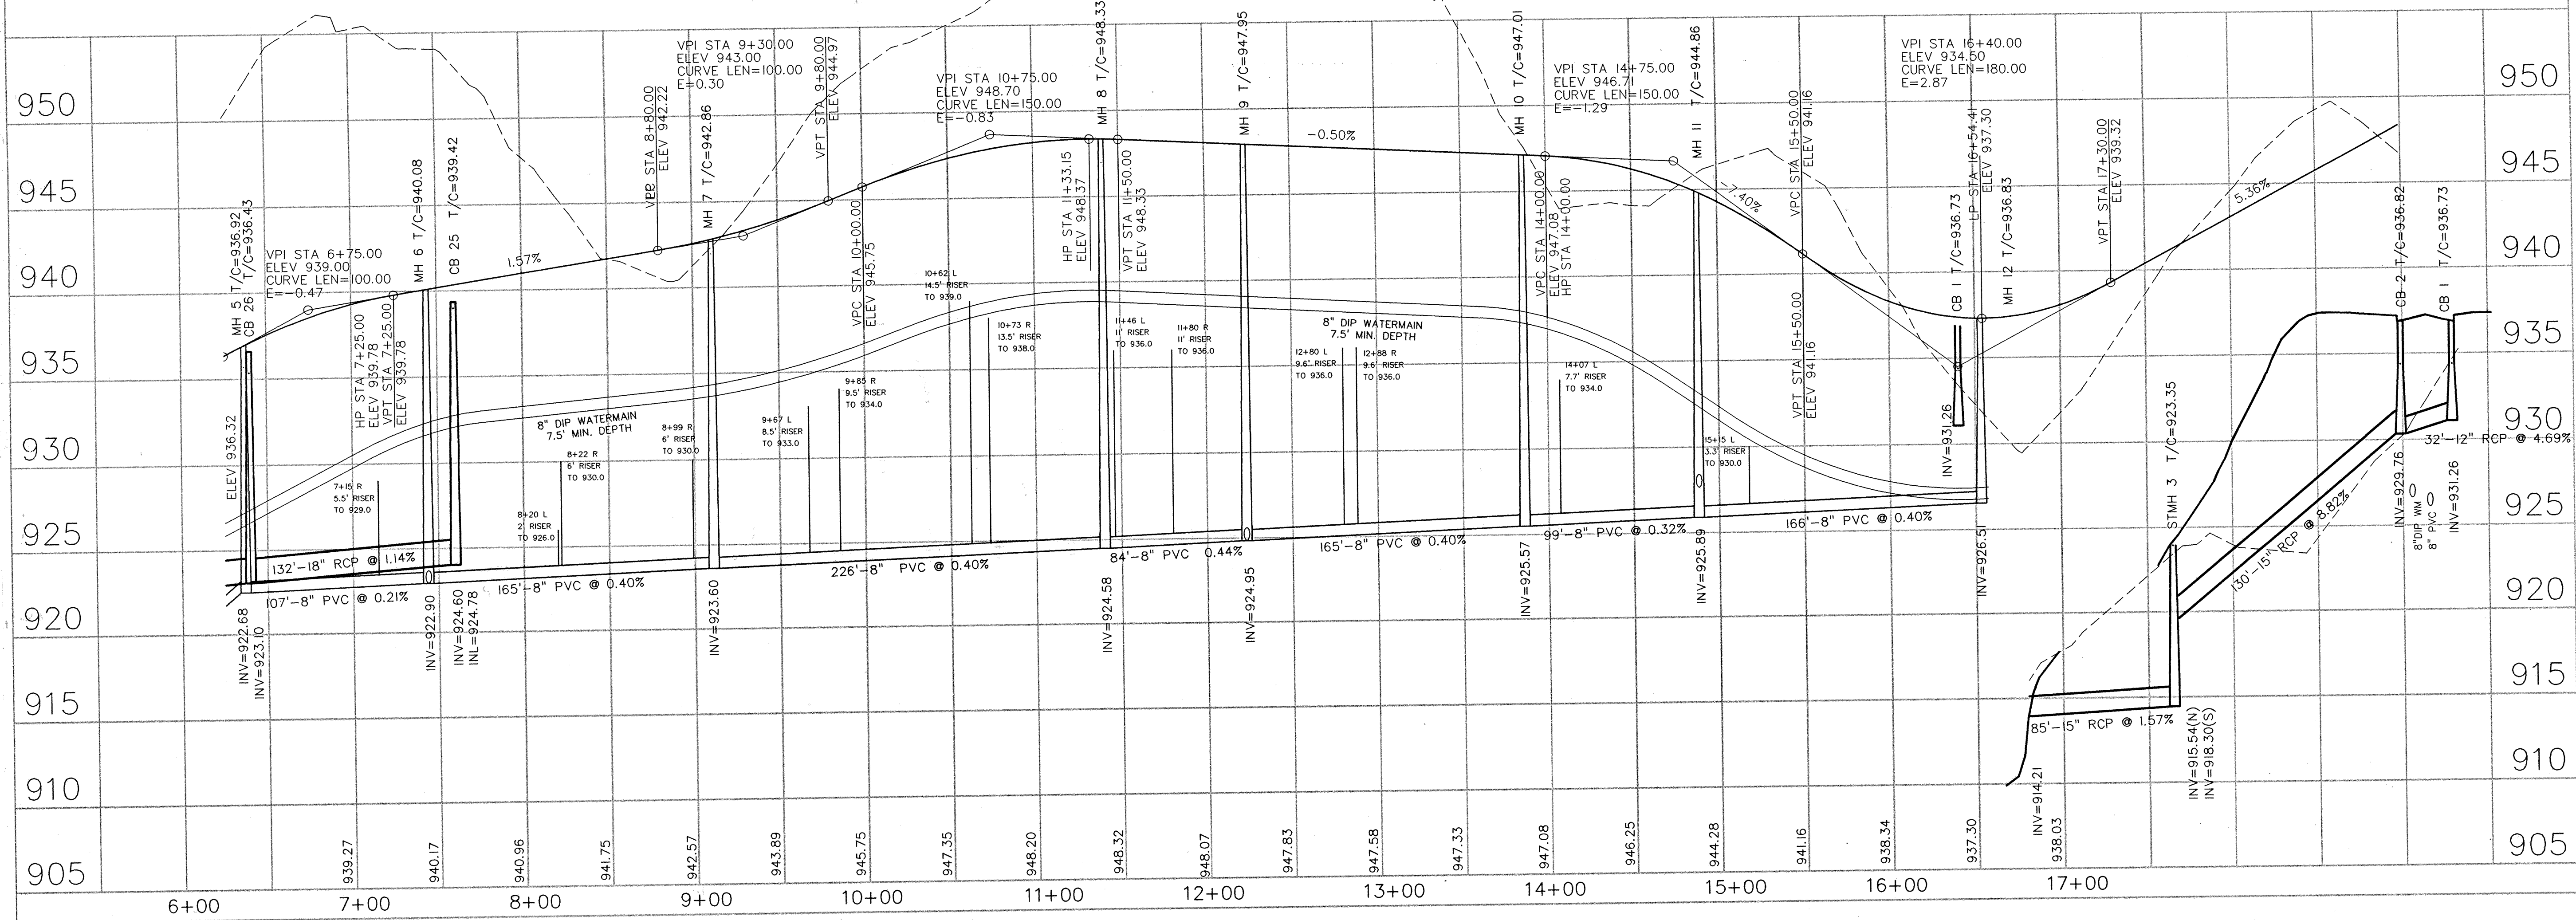

CITY OF ELK RIVER MINNESOTA

OWNER/DEVELOPER  
 RICHARD LUND  
 3075 COON RAPIDS BLVD.  
 COON RAPIDS, MINNESOTA 55433

SHEET	TITLE	REV.
C11	TITLE SHEET	
C21	FINAL PLAN	
C33	100 SCALE GRADING PLAN	
UTILITIES & STREETS		
C42	195TH AVE. NORTH	
C43	195TH AVE. NORTH	
C44	BOSTON STREET	
C45	ALBANY COURT ALBANY STREET	
C46	ZUMBRO STREET	
C41	194TH AVE. NO.	
C81	DETAIL SHEET	
C92	DETAIL SHEET	
C93	BOOSTER STATION DETAIL	

DATE	REVISION
7-3-96	CITY COMMENTS
7-22-96	STORM SEWER
9-10-96	RAISED STREET GRADES
7-31-97	AS-BUILTS

CERTIFICATION:  
 I hereby certify that this plan was prepared by me, or under my direct supervision, and that I am a duly registered Professional Engineer under the laws of the state of MINNESOTA.  
*Stephan W. Johnson*  
 Stephan W. Johnson  
 Registration No: 18914 Date: 5-15-96



DATE: 5-15-96  
 FILE NAME: C4030NWDWG  
 PROJECT NO. HC95004  
 195TH AVE. NO.  
 7+00 - 17+00  
**C4.3**