



SCALES:
1" = 50' HOR
1" = 5' VER

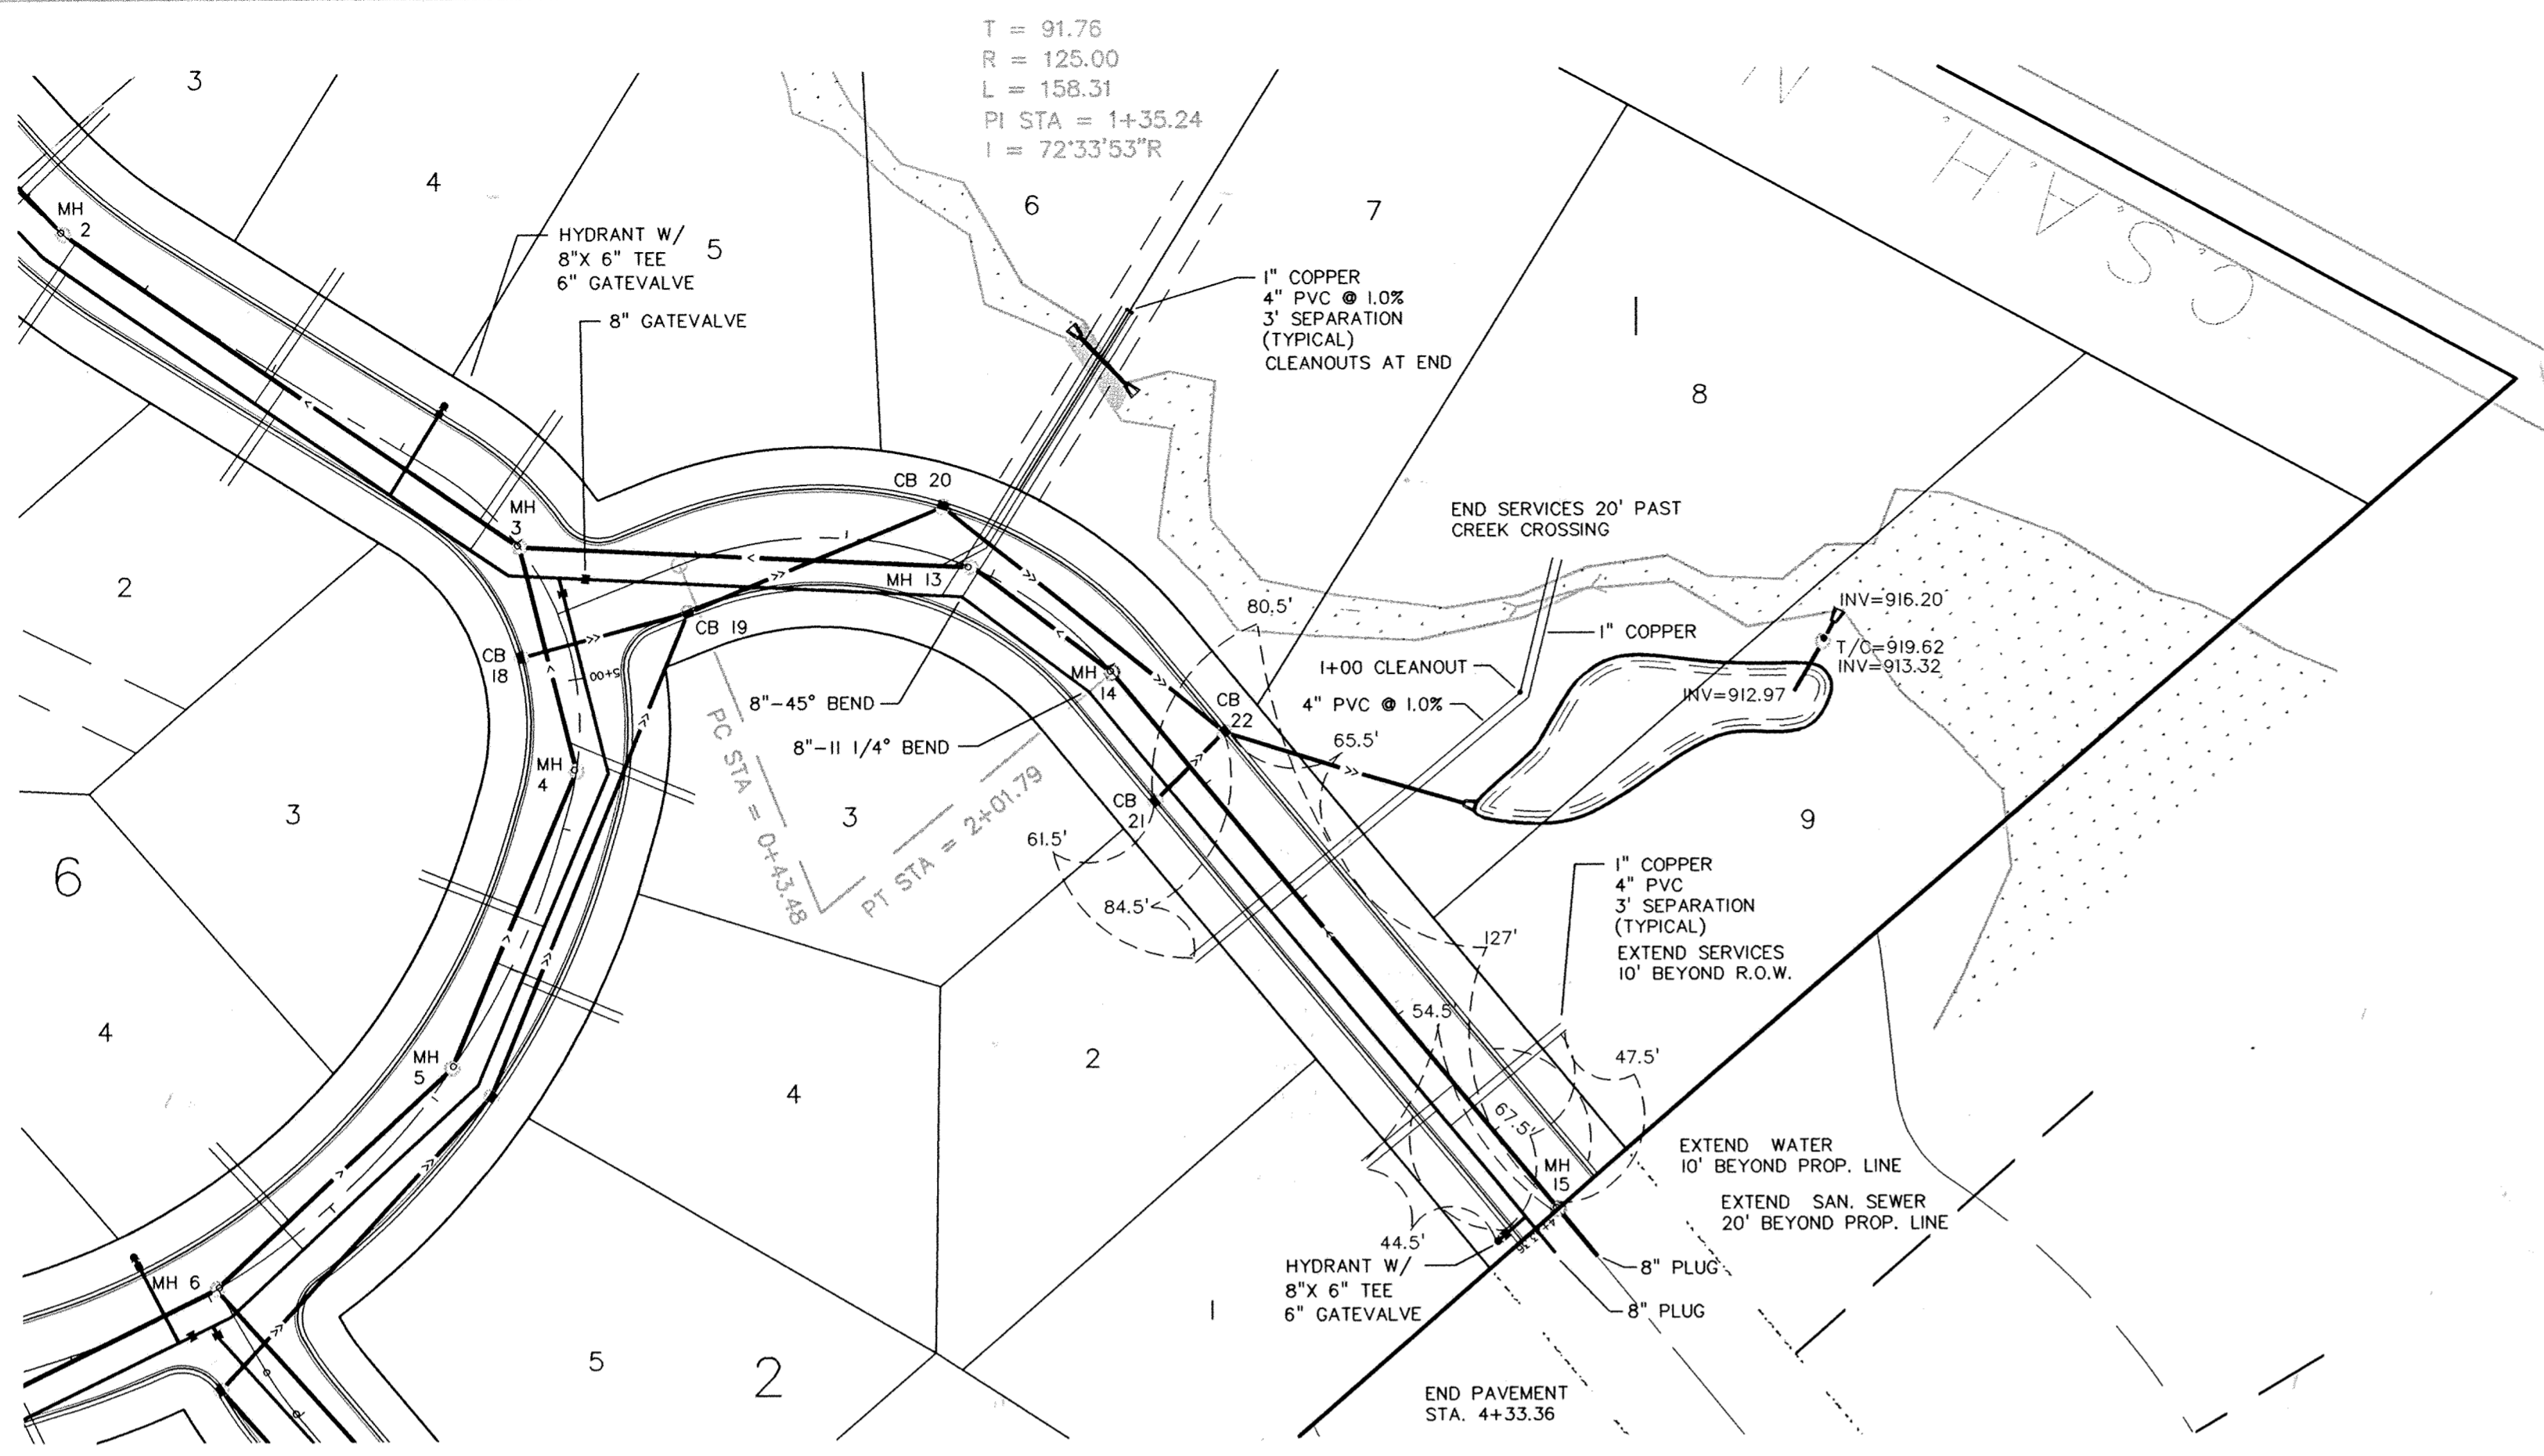

T = 91.76
R = 125.00
L = 158.31
PI STA = 1+35.24
I = 72°33'53\"/>

AS-BUILT COMPLETED BY: LANDFORM ENGINEERING COMPANY
DATE: AUGUST 12, 1997
CONTRACTOR:
ANNANDALE CONTRACTING
6646 COUNTY ROAD 5 NW
ANNANDALE, MN 55302

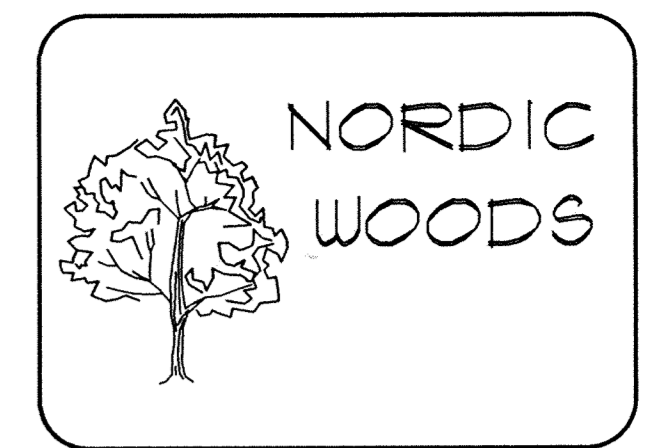


CITY
OF
ELK
RIVER
MINNESOTA

OWNER/DEVELOPER
RICHARD LUND
3075 COON RAPIDS BLVD.
COON RAPIDS, MINNESOTA
55433

SHEET	TITLE	REV.
C11	TITLE SHEET	
C21	FINAL FLAT	
C3.3	100 SCALE GRADING PLAN	
UTILITIES & STREETS		
C4.2	195TH AVE. NORTH	
C4.3	195TH AVE. NORTH	
C4.4	BOSTON STREET	
C4.5	ALBANY COURT ALBANY STREET	
C4.6	ZUMBRO STREET	
C4.1	194TH AVE. NO.	
C9.1	DETAIL SHEET	
C9.2	DETAIL SHEET	
C9.3	BOOSTER STATION DETAIL	

BOSTON STREET

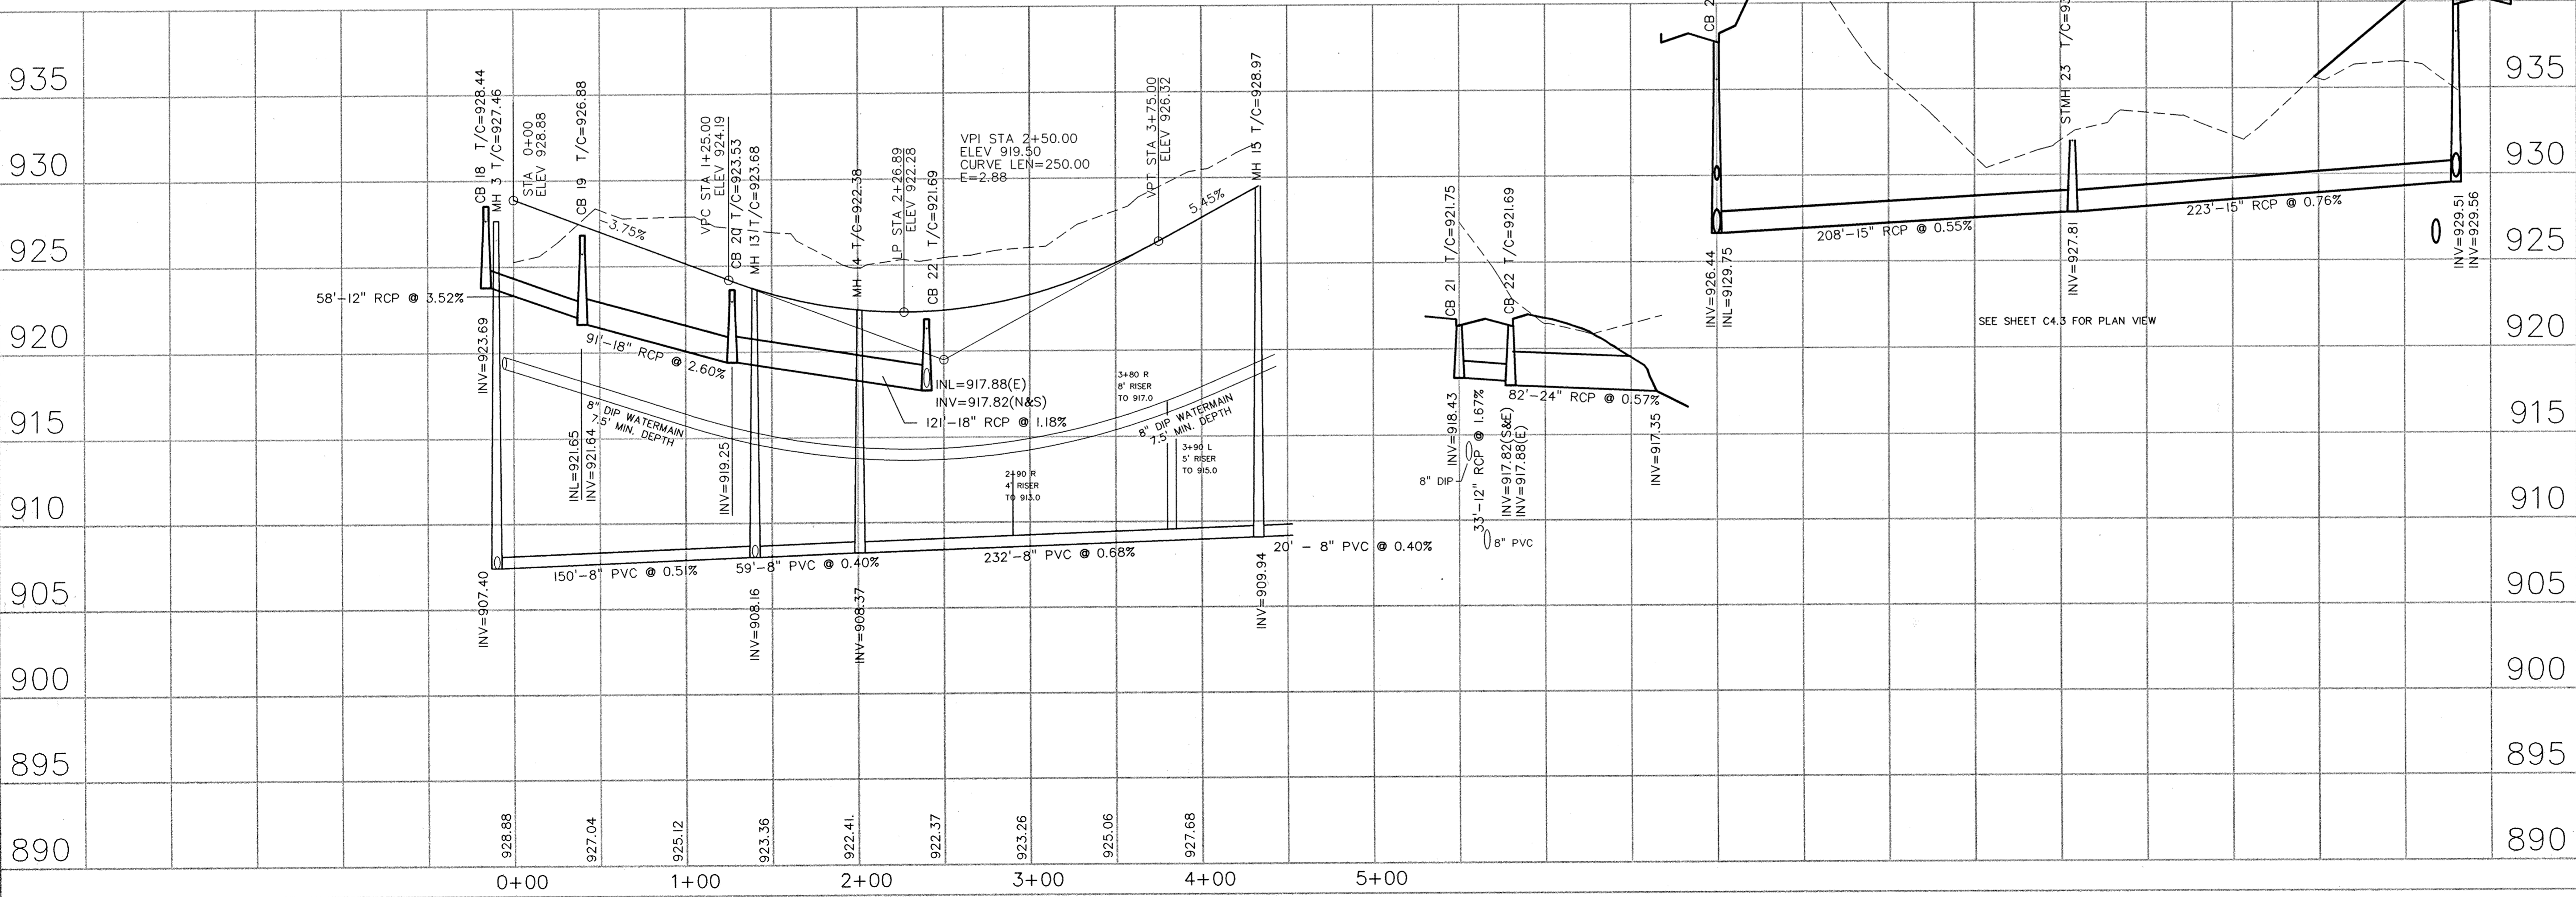

DATE	REVISION
7-3-96	CITY COMMENTS
7-22-96	STORM SEWER
9-10-96	RAISED STREET GRADES
7-31-97	AS-BUILTS

CERTIFICATION:
I hereby certify that this plan was prepared by me, or under my direct supervision, and that I am a duly registered Professional Engineer under the laws of the state of MINNESOTA.
Stephen H. Johnston
Stephen H. Johnston
Registration No. 18914 Date: 5-15-96



DATE: 5-15-96
FILE NAME: C4040NWDWG
PROJECT NO. HC95004
BOSTON STREET
0+00 - 5+00
C4.4