


ALBANY COURT

SCALES:
1" = 50' HOR
1" = 5' VER

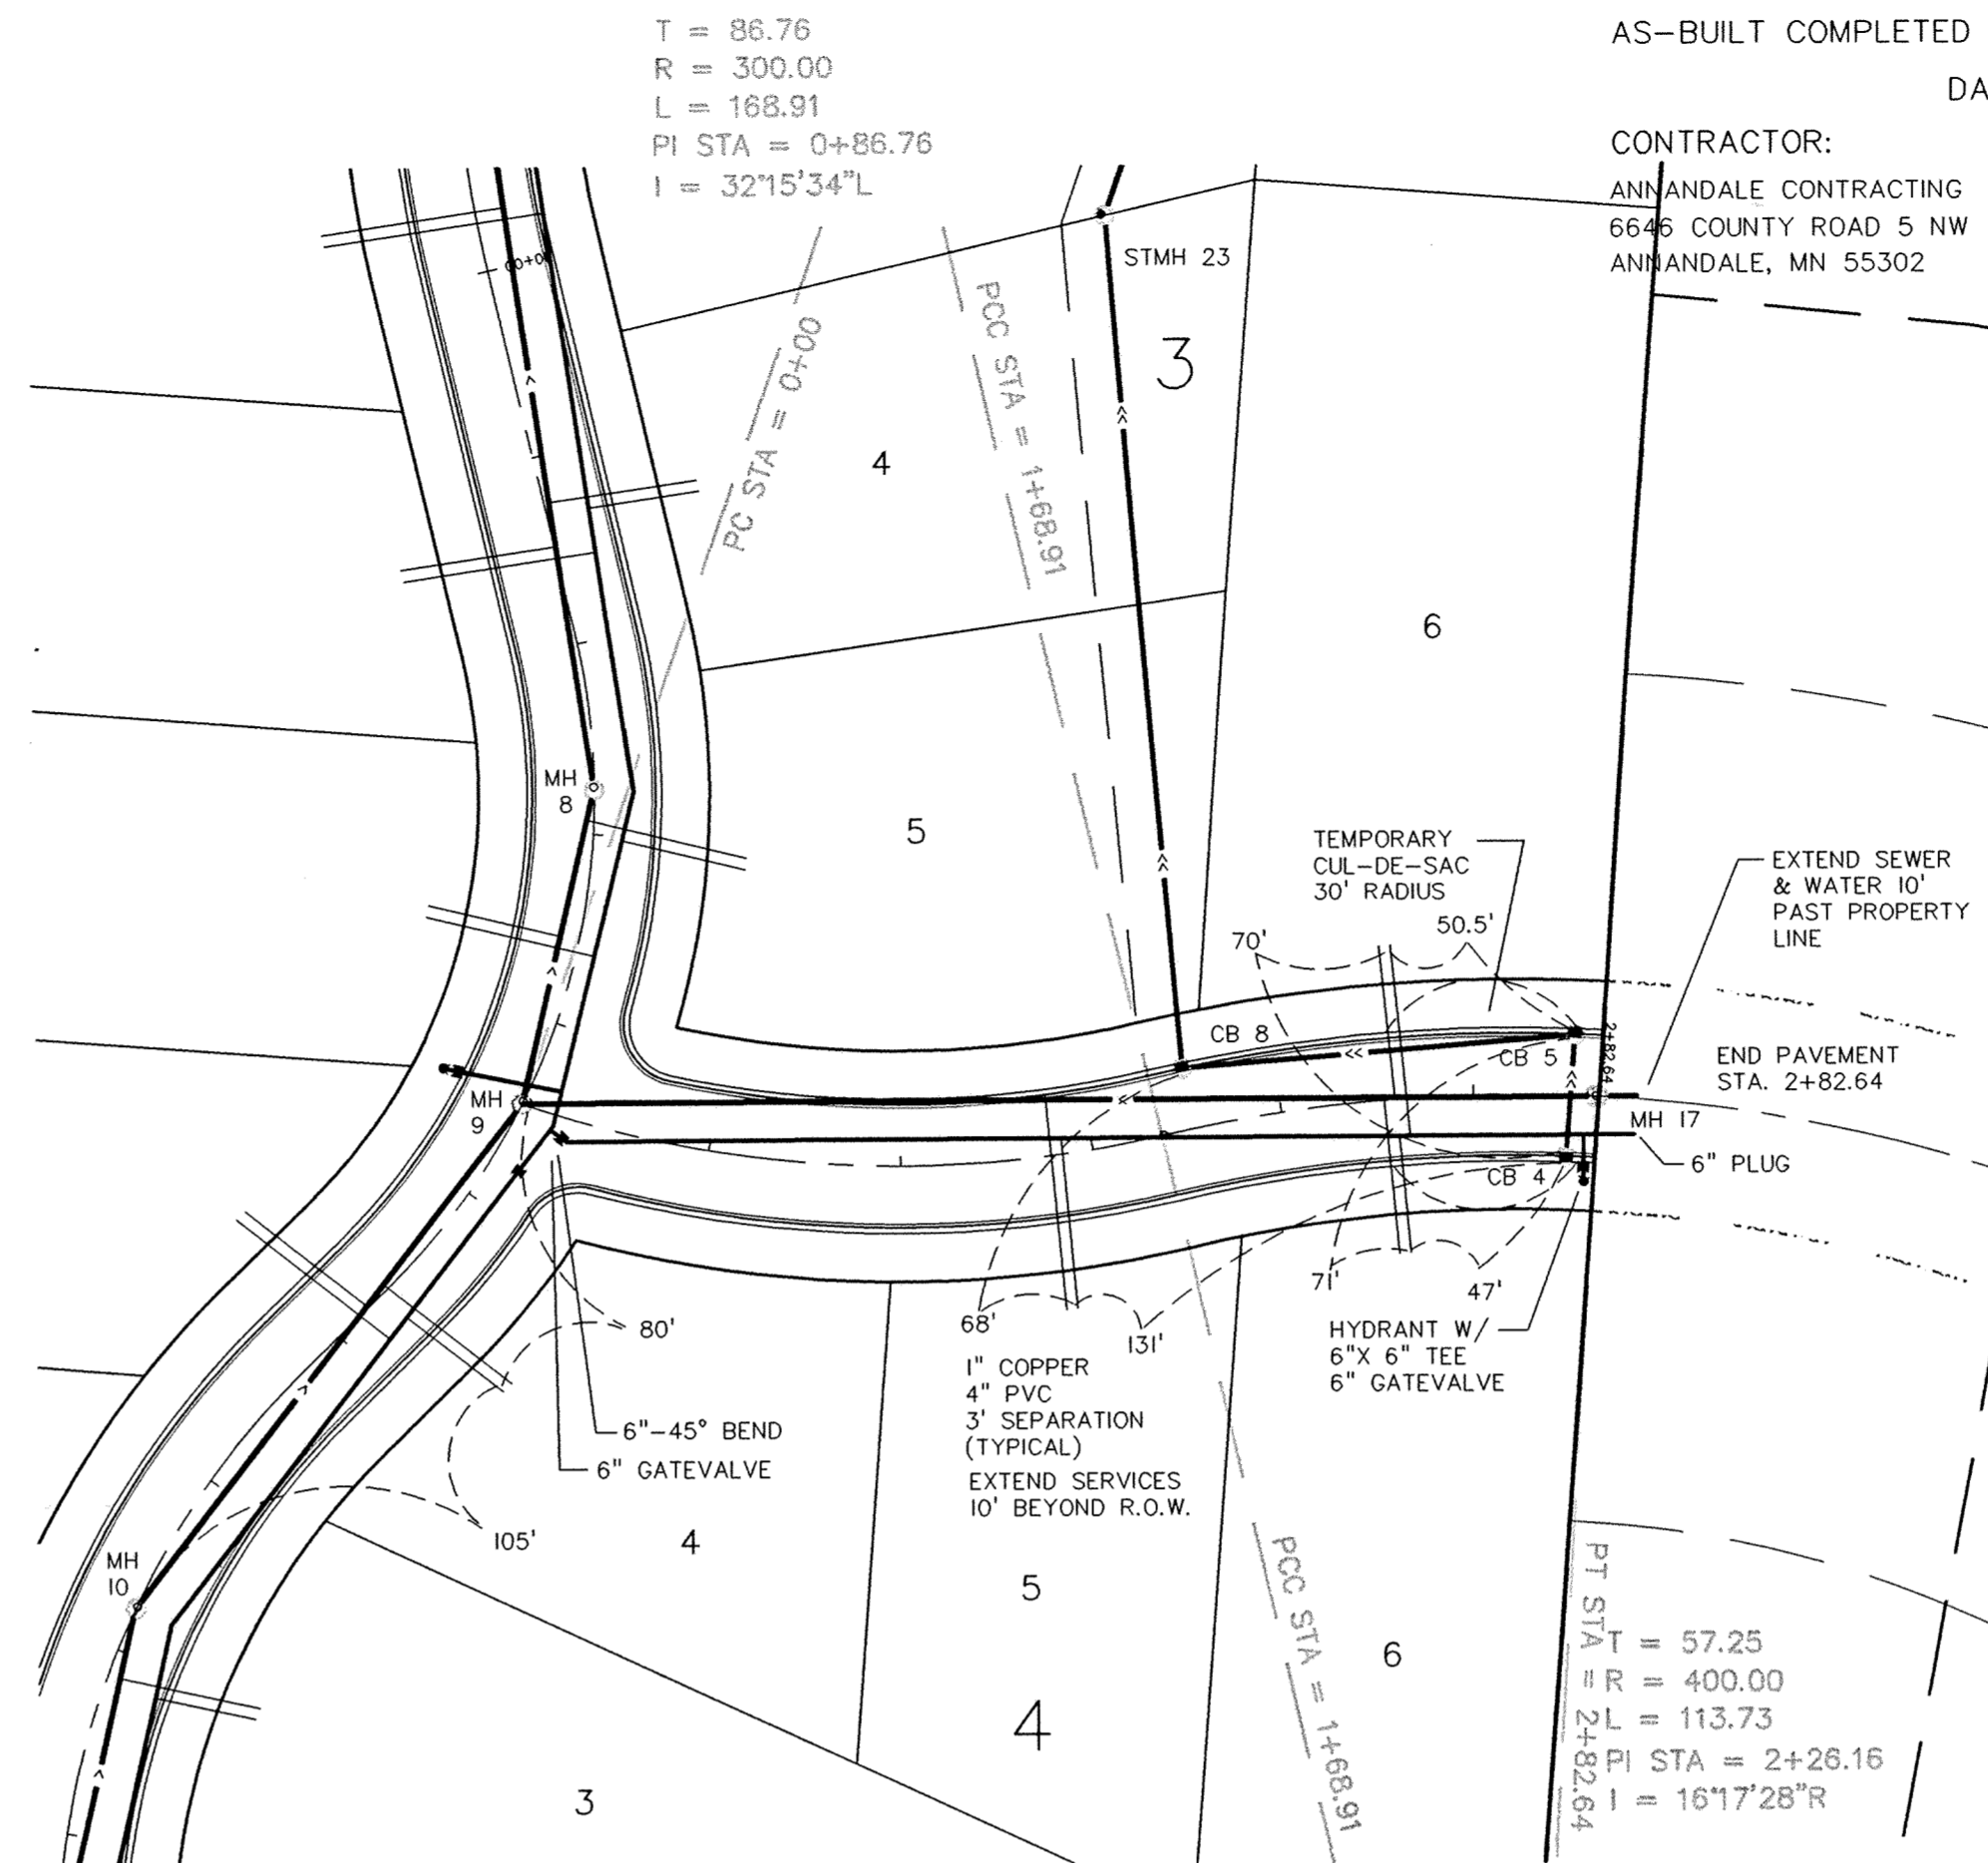

ALBANY STREET

AS-BUILT COMPLETED BY: LANDFORM ENGINEERING COMPANY
DATE: AUGUST 12, 1997

CONTRACTOR:
ANNANDALE CONTRACTING
6646 COUNTY ROAD 5 NW
ANNANDALE, MN 55302




CITY OF
ELK RIVER
MINNESOTA

OWNER/DEVELOPER
RICHARD LUND
3075 COON RAPIDS BLVD.
COON RAPIDS, MINNESOTA
55433

SHEET	TITLE	REV.
C1.1	TITLE SHEET	
C2.1	FINAL PLAN	
C3.3	100 SCALE GRADING PLAN	
UTILITIES & STREETS		
C4.2	195TH AVE. NORTH	
C4.3	195TH AVE. NORTH	
C4.4	BOSTON STREET	
C4.5	ALBANY COURT ALBANY STREET	
C4.6	ZUMBRO STREET	
C4.7	194TH AVE. NO.	
C3.1	DETAIL SHEET	
C3.2	DETAIL SHEET	
C3.3	BOOSTER STATION DETAIL	

DATE	REVISION
7-3-96	CITY COMMENTS
9-10-96	RAISED STREET GRADES
7-31-97	AS-BUILTS

CERTIFICATION
I hereby certify that this plan was prepared by me, or under my direct supervision, and that I am a duly registered Professional Engineer under the laws of the state of MINNESOTA.
Stephen H. Johnston
Stephen H. Johnston
Registration No: 18914 Date: 5-15-96

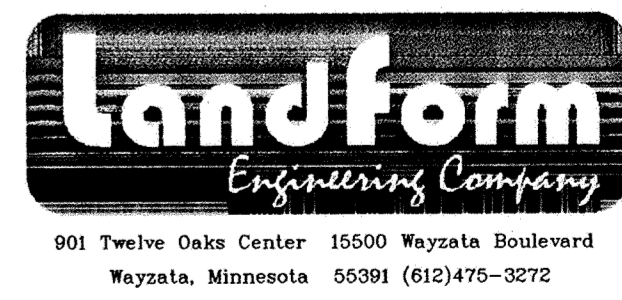

901 Twelve Oaks Center 15500 Wayzata Boulevard
Wayzata, Minnesota 55391 (612)475-3272

DATE: 5-15-96
FILE NAME: C4050NWDJWG
PROJECT NO. HC95004
ALBANY COURT
ALBANY STREET
C4.5

