

CITY
OF
ELK
RIVER
MINNESOTA

OWNER/DEVELOPER
RICHARD LUND
3075 COON RAPIDS BLVD.
COON RAPIDS, MINNESOTA
55433

SHEET	TITLE	REV.
C1.1	TITLE SHEET	
C2.1	FINAL FLAT	
C3.3	100 SCALE GRADING PLAN	
UTILITIES & STREET		
C4.2	195TH AVE. NORTH	
C4.3	195TH AVE. NORTH	
C4.4	BOSTON STREET	
C4.5	ALBANY COURT ALBANY STREET	
C4.6	ZUMBRO STREET	
C4.7	194TH AVE. NO.	
C9.1	DETAIL SHEET	
C9.2	DETAIL SHEET	
C9.3	BOOSTER STATION DETAIL	

DATE	REVISION
7-3-96	CITY COMMENTS
9-10-96	RAISED STREET GRADES
7-31-97	AS-BUILTS

CERTIFICATION:
I hereby certify that this plan was prepared by me,
or under my direct supervision, and that I am a duly
registered Professional Engineer under the laws of
the state of MINNESOTA.


Stephen M. Johnston
Stephen M. Johnston
Registration No: 18914 Date: 5-15-96




DATE: 5-15-96
FILE NAME: C4060NWDWG
PROJECT NO. HC95004

ZUMBRO STREET

C4.6

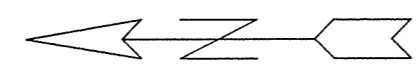

SCALES:
1" = 50' HOR
1" = 5' VER

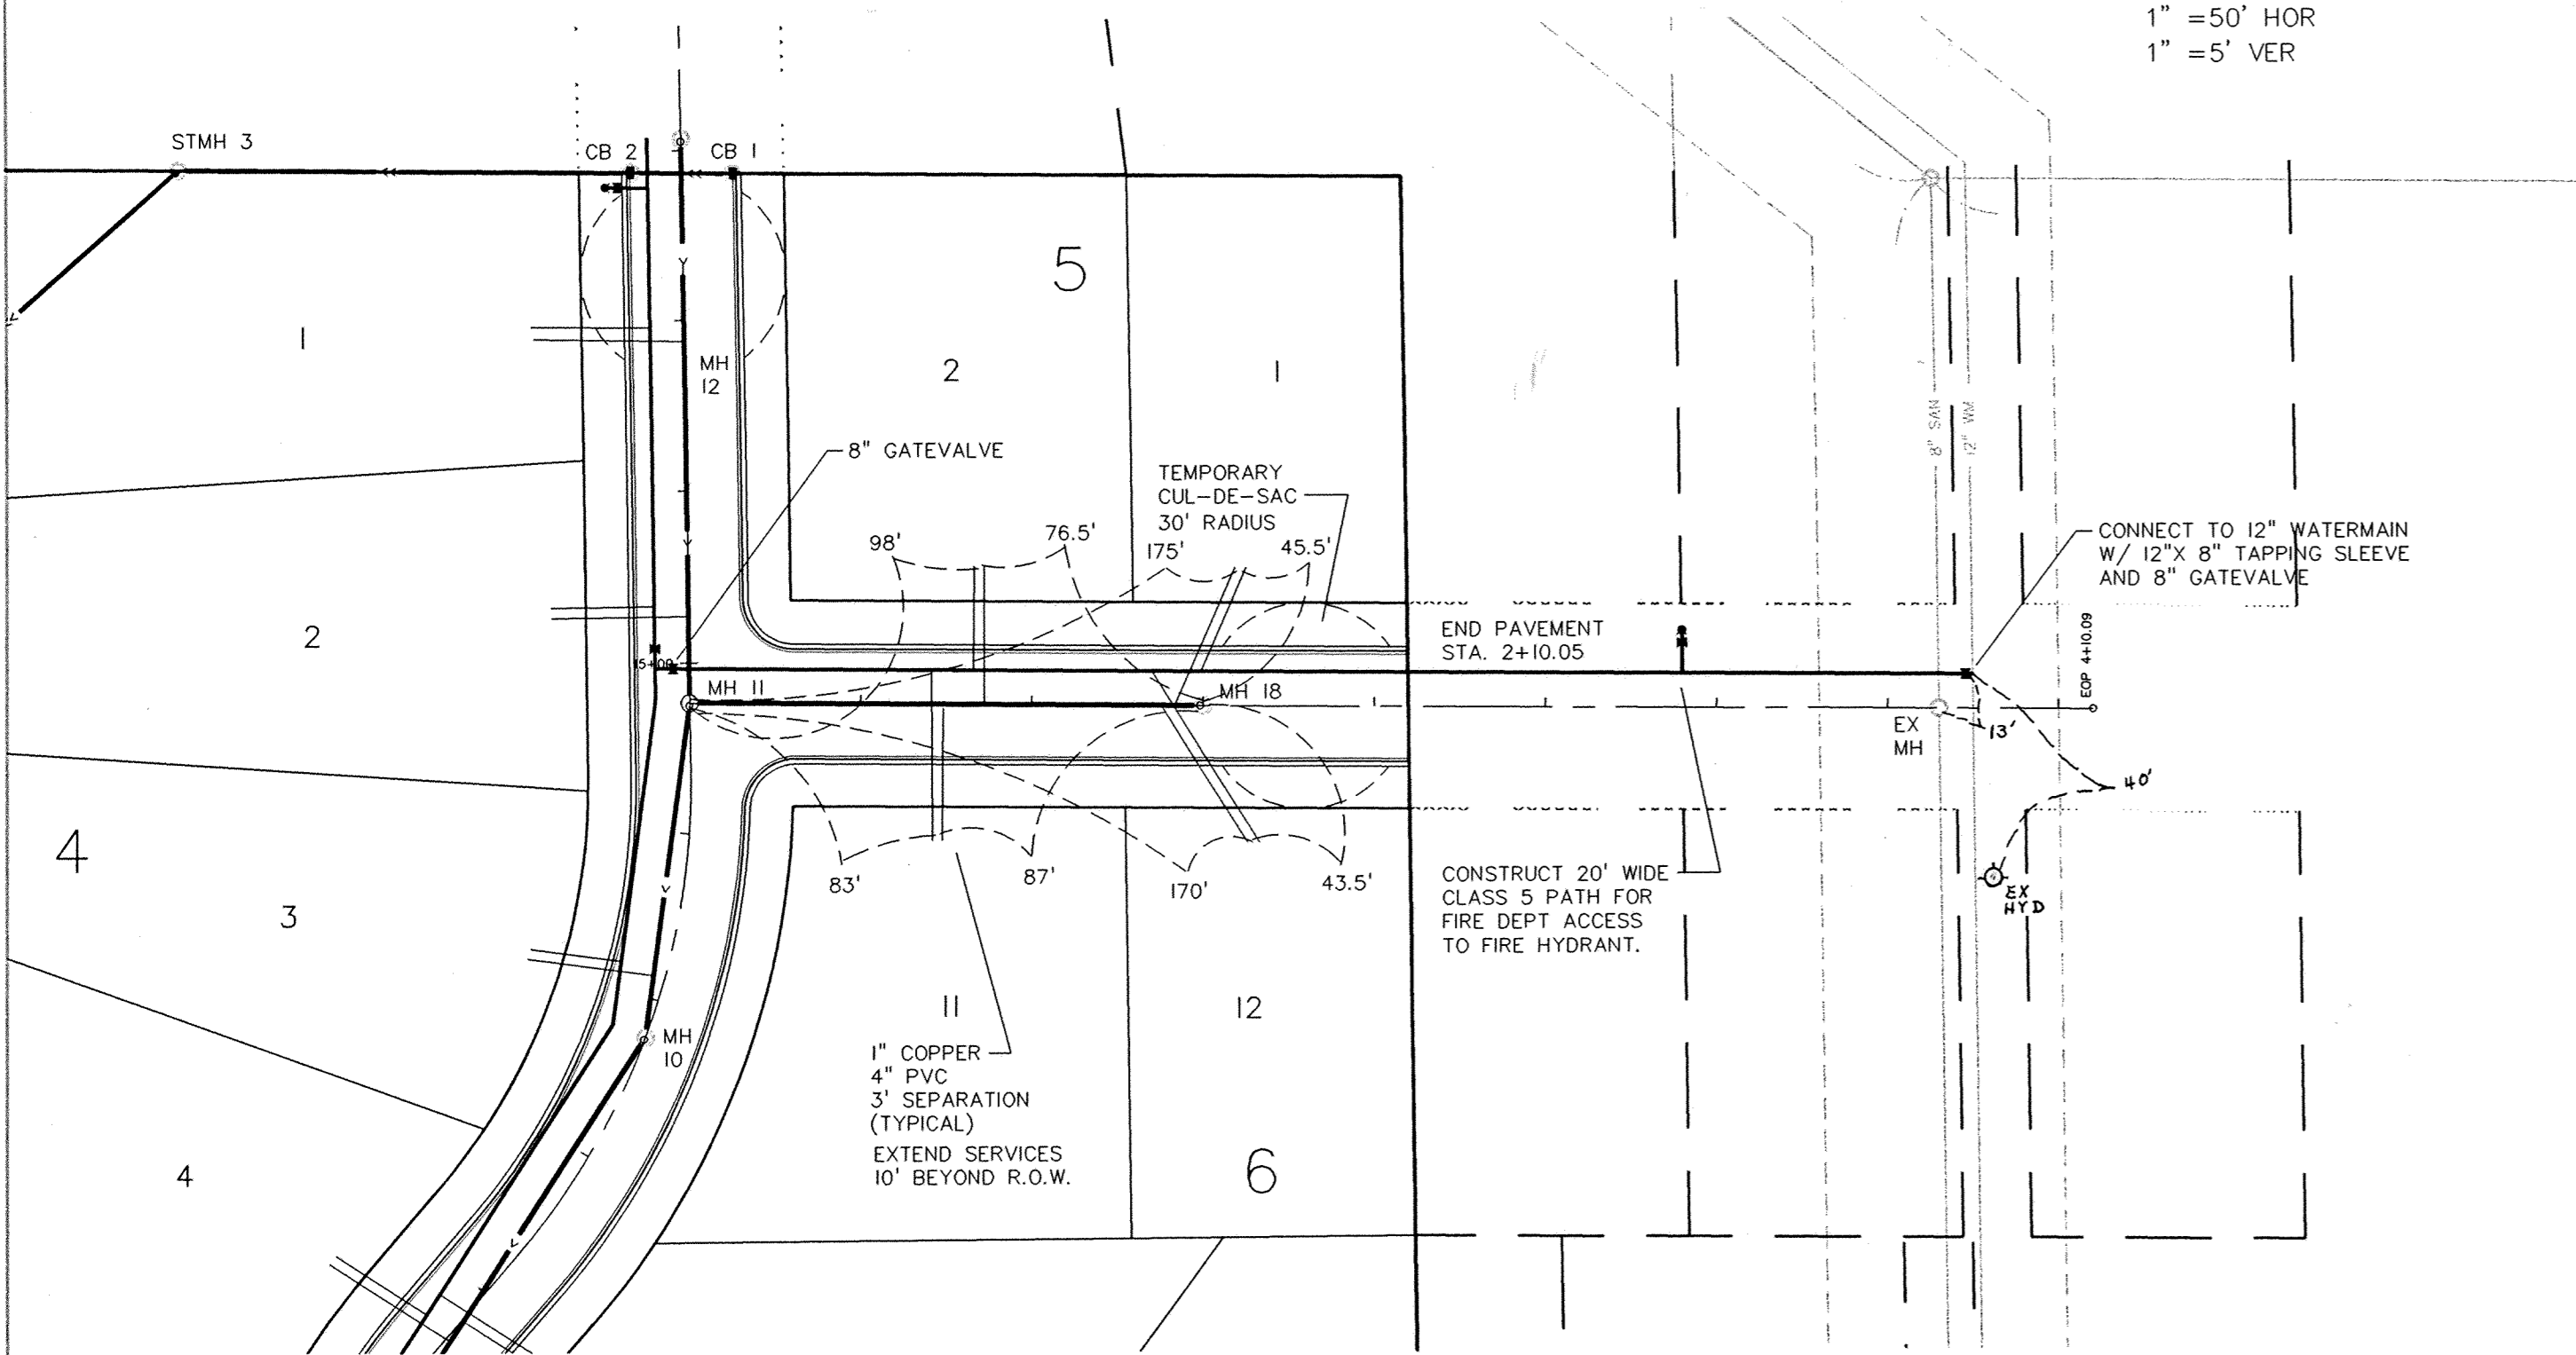

ZUMBRO STREET

