


SCALES:
 1" = 50' HOR
 1" = 5' VER

194TH AVENUE NORTH

AS-BUILT COMPLETED BY: LANDFORM ENGINEERING COMPANY
 DATE: AUGUST 12, 1997
 CONTRACTOR:
 ANNANDALE CONTRACTING
 6646 COUNTY ROAD 5 NW
 ANNANDALE, MN 55302

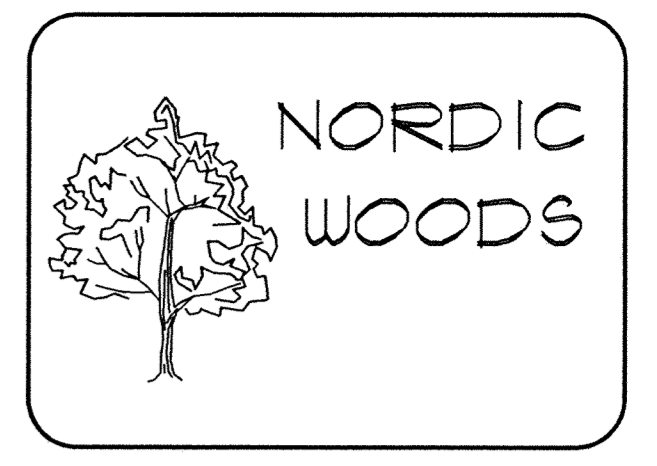

CITY
 OF
 ELK
 RIVER
 MINNESOTA

OWNER/DEVELOPER
 RICHARD LUND
 3075 COON RAPIDS BLVD.
 COON RAPIDS, MINNESOTA
 55433

SHEET	TITLE	REV.
C11	TITLE SHEET	
C21	FINAL PLAN	
C3.3	100 SCALE GRADING PLAN	
UTILITIES & STREETS		
C4.2	195TH AVE. NORTH	
C4.3	195TH AVE. NORTH	
C4.4	BOSTON STREET	
C4.5	ALBANY COURT ALBANY STREET	
C4.6	ZUMERO STREET	
C4.1	194TH AVE. NO.	
C9.1	DETAIL SHEET	
C9.2	DETAIL SHEET	
C9.3	BOOSTER STATION DETAIL	

DATE	REVISION
7-3-96	CITY COMMENTS
9-10-96	RAISED STREET GRADES
7-31-97	AS-BUILTS

CERTIFICATION:
 I hereby certify that this plan was prepared by me,
 or under my direct supervision, and that I am a duly
 registered Professional Engineer under the laws of
 the state of MINNESOTA.
Stephen H. Johnston
 Stephen H. Johnston
 Registration No: 18914 Date: 3-15-96



DATE: 5-15-96
 FILE NAME: C4010NWDWG
 PROJECT NO. HC95004
 194TH AVE. NO.
C4.7

