



DENVER STREET

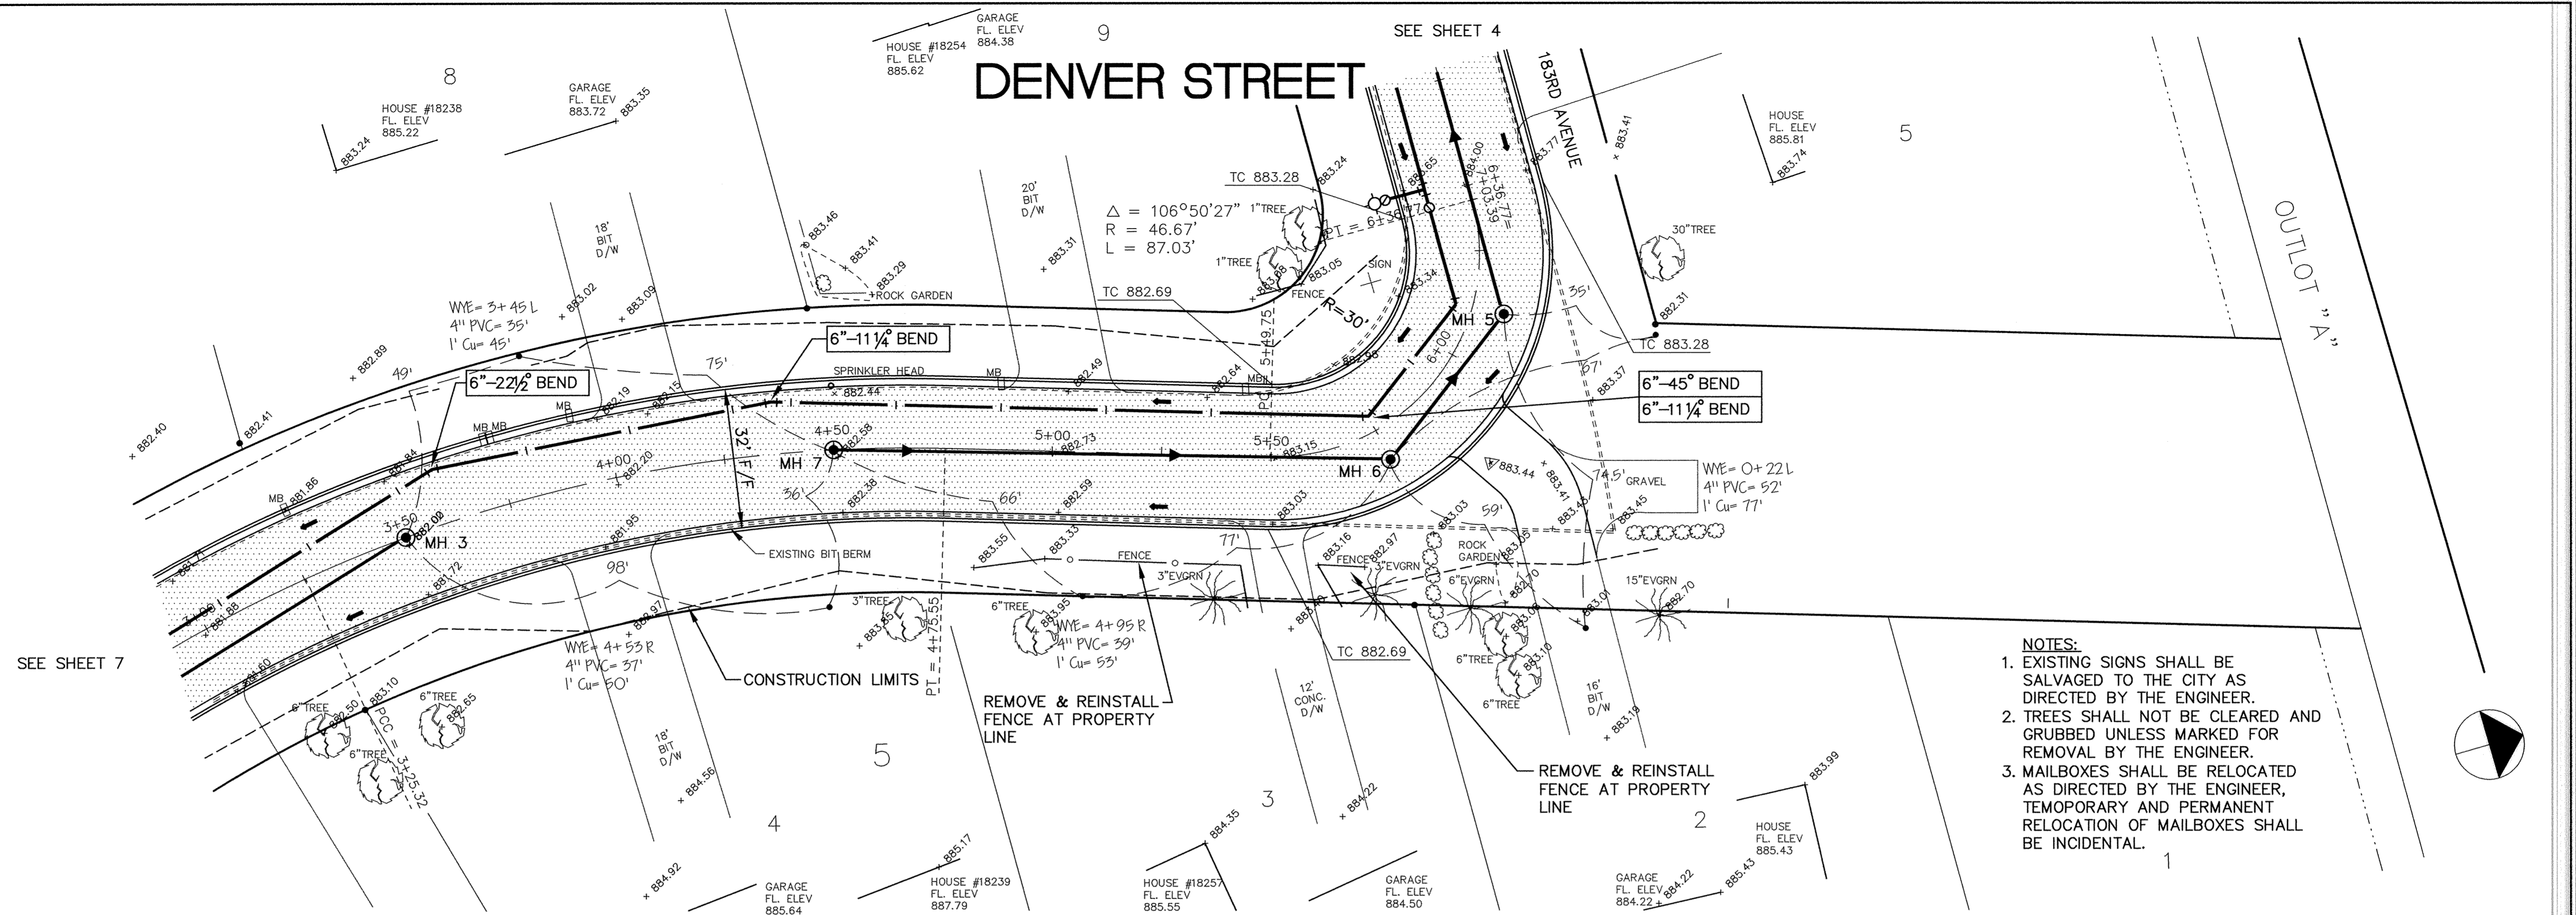

- NOTES:**
- EXISTING SIGNS SHALL BE SALVAGED TO THE CITY AS DIRECTED BY THE ENGINEER.
 - TREES SHALL NOT BE CLEARED AND GRUBBED UNLESS MARKED FOR REMOVAL BY THE ENGINEER.
 - MAILBOXES SHALL BE RELOCATED AS DIRECTED BY THE ENGINEER, TEMPORARY AND PERMANENT RELOCATION OF MAILBOXES SHALL BE INCIDENTAL.

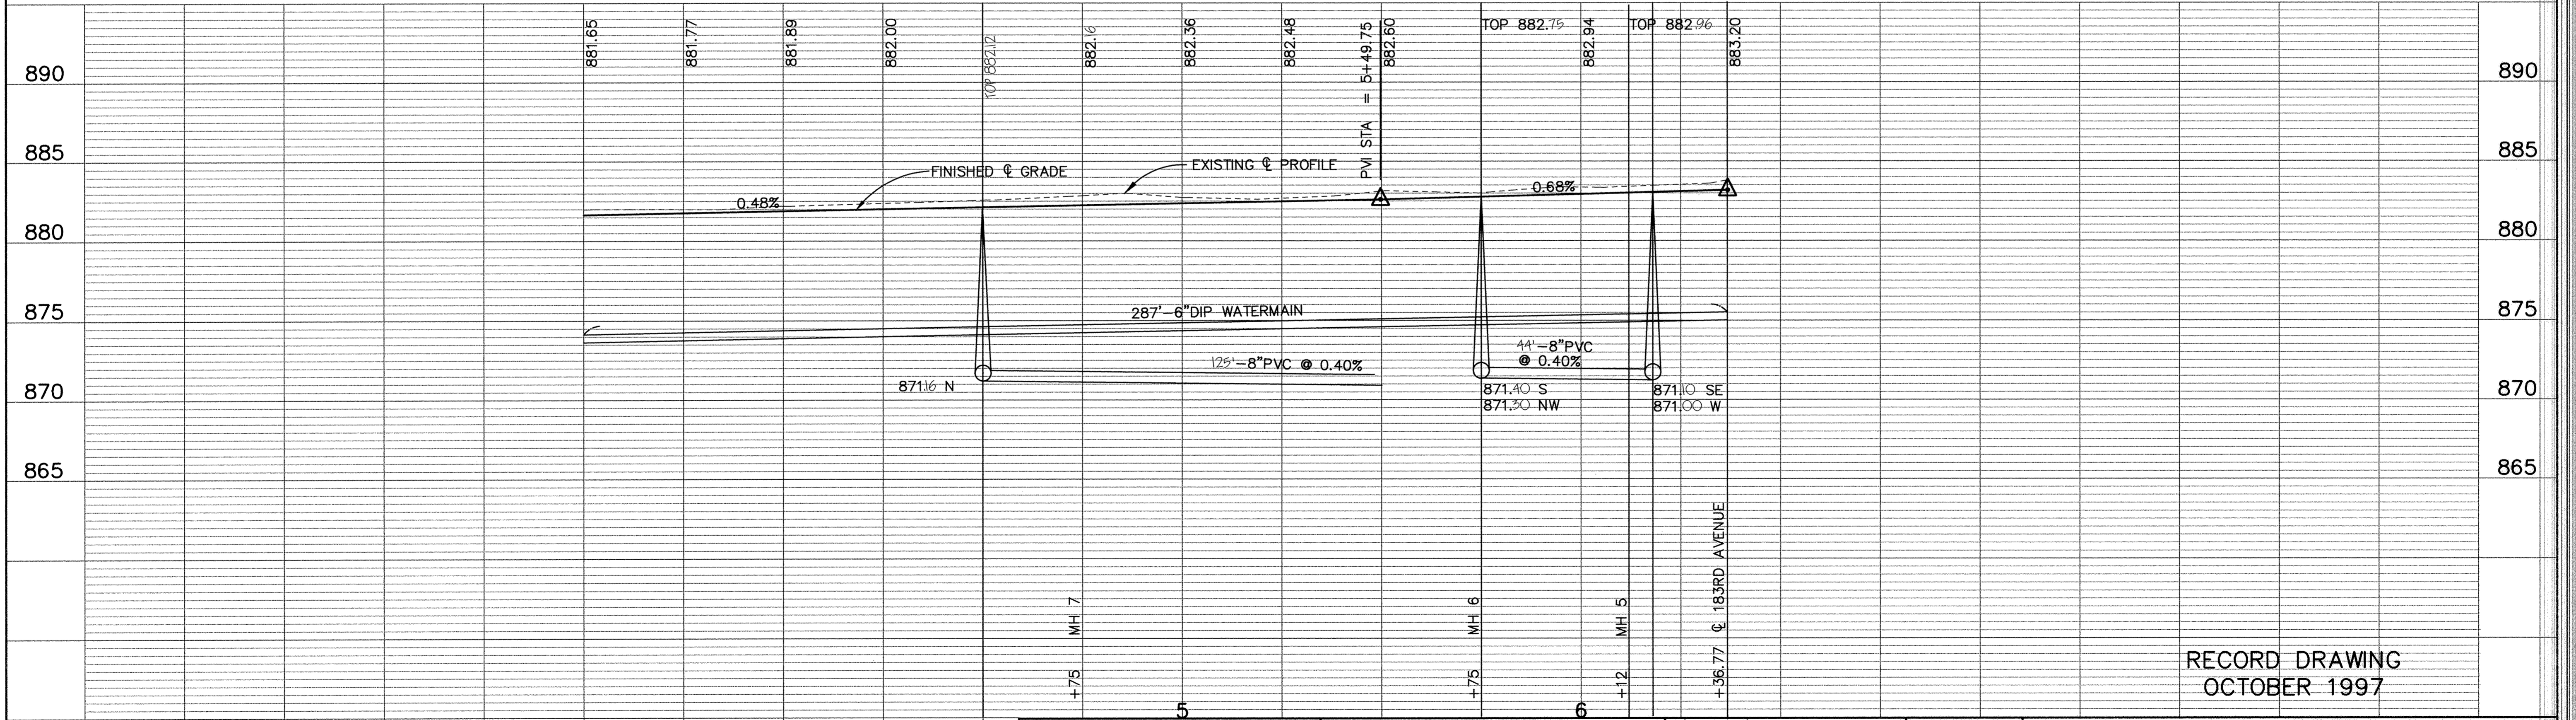

RECORD DRAWING
OCTOBER 1997

I HEREBY CERTIFY THAT THIS PLAN, SPECIFICATION, OR REPORT WAS PREPARED BY ME OR UNDER MY DIRECT SUPERVISION AND THAT I AM A DULY REGISTERED PROFESSIONAL ENGINEER UNDER THE LAWS OF THE STATE OF MINNESOTA.

Levy J. Munn
DATE 12/9/96 REG. NO. 15314



1326 ENERGY PARK DRIVE
ST. PAUL, MINNESOTA 55108
(612) 644-4389

DATE	DESCRIPTION

DESIGNED	SEE
CHECKED	
DRAWN	RKM
GRAPHIC SCALE	0 20
VERT.	0 5

CITY OF ELK RIVER ORONO LAKE 3RD ADDITION STREET AND UTILITY IMPROVEMENTS DENVER STREET		
DATE NOV. 1996	SHEET 8 OF 31 SHEETS	PROJECT NO. 230-320