
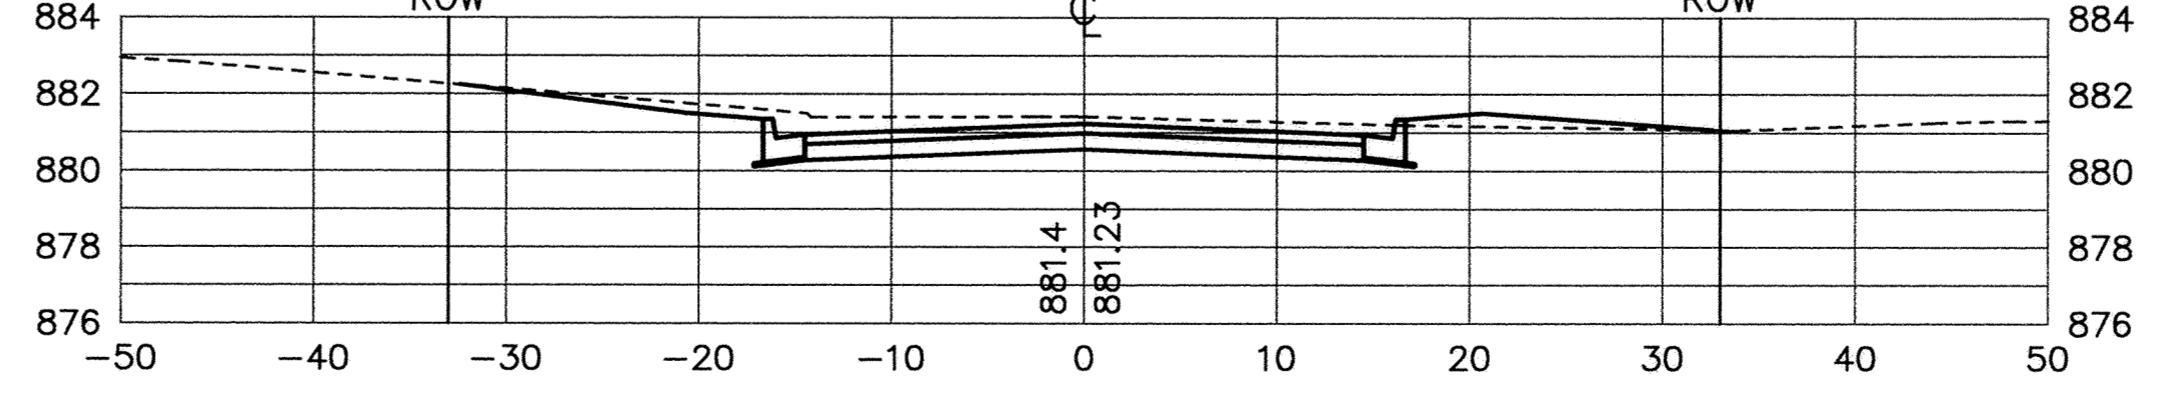
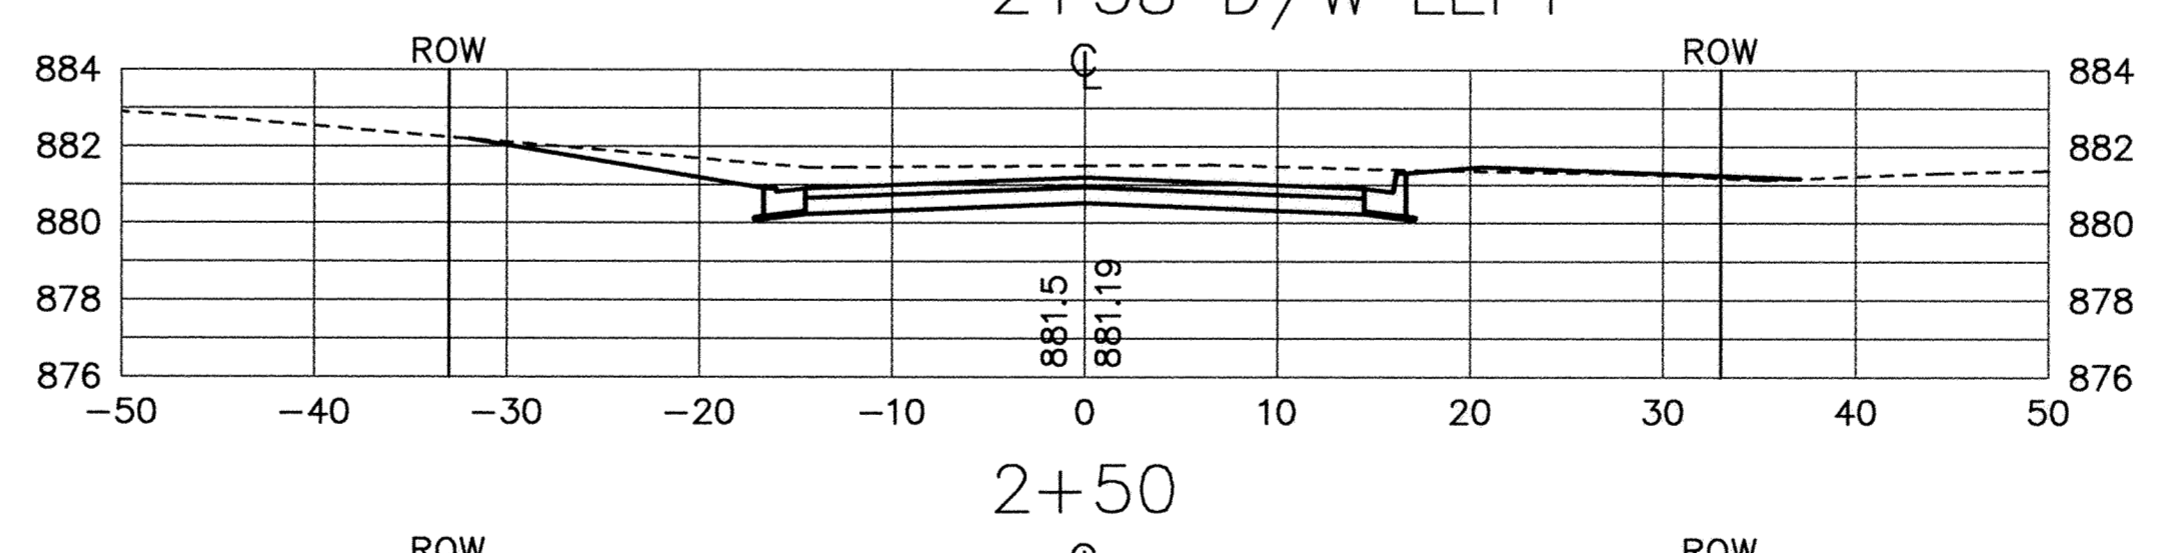
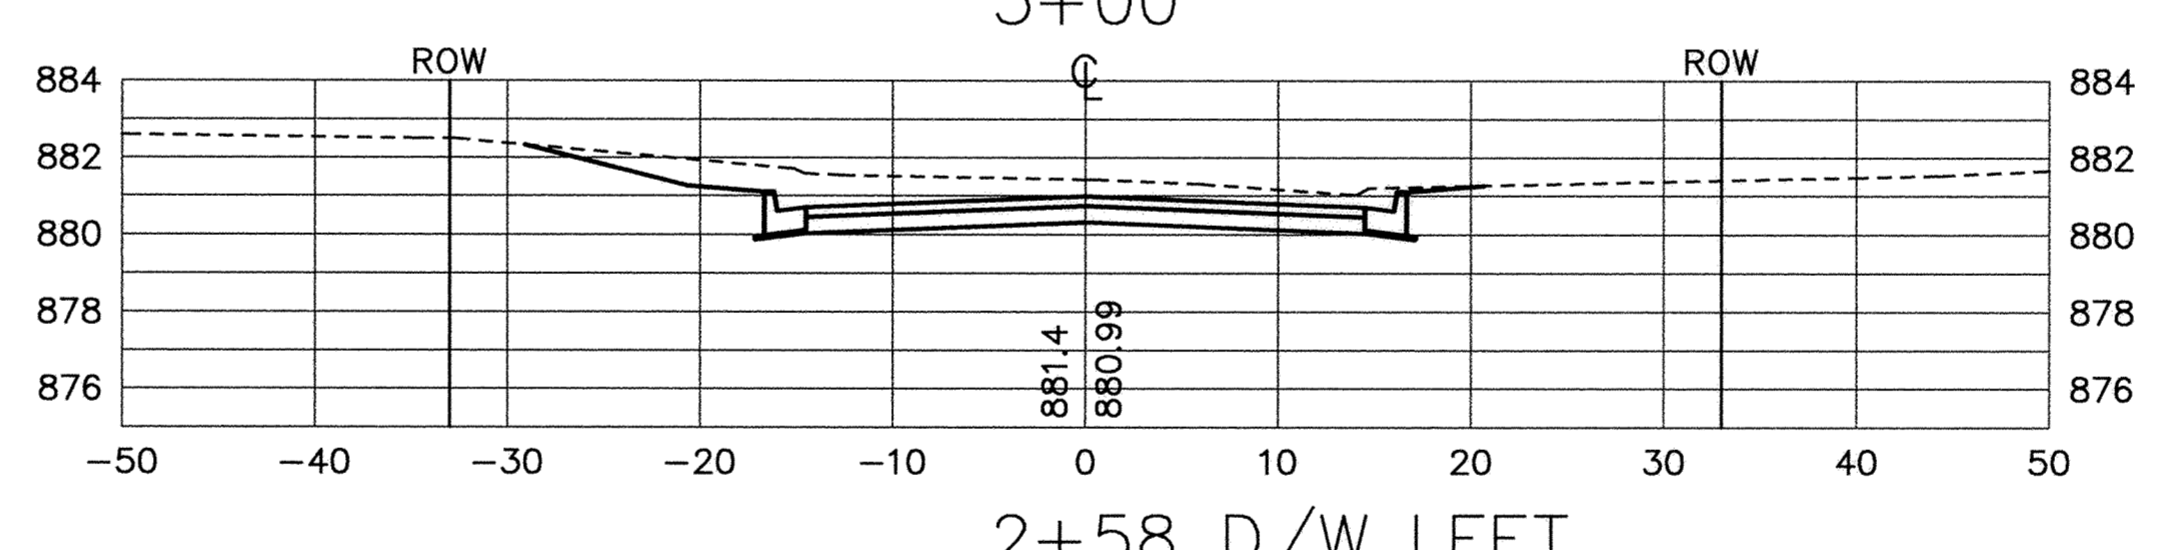
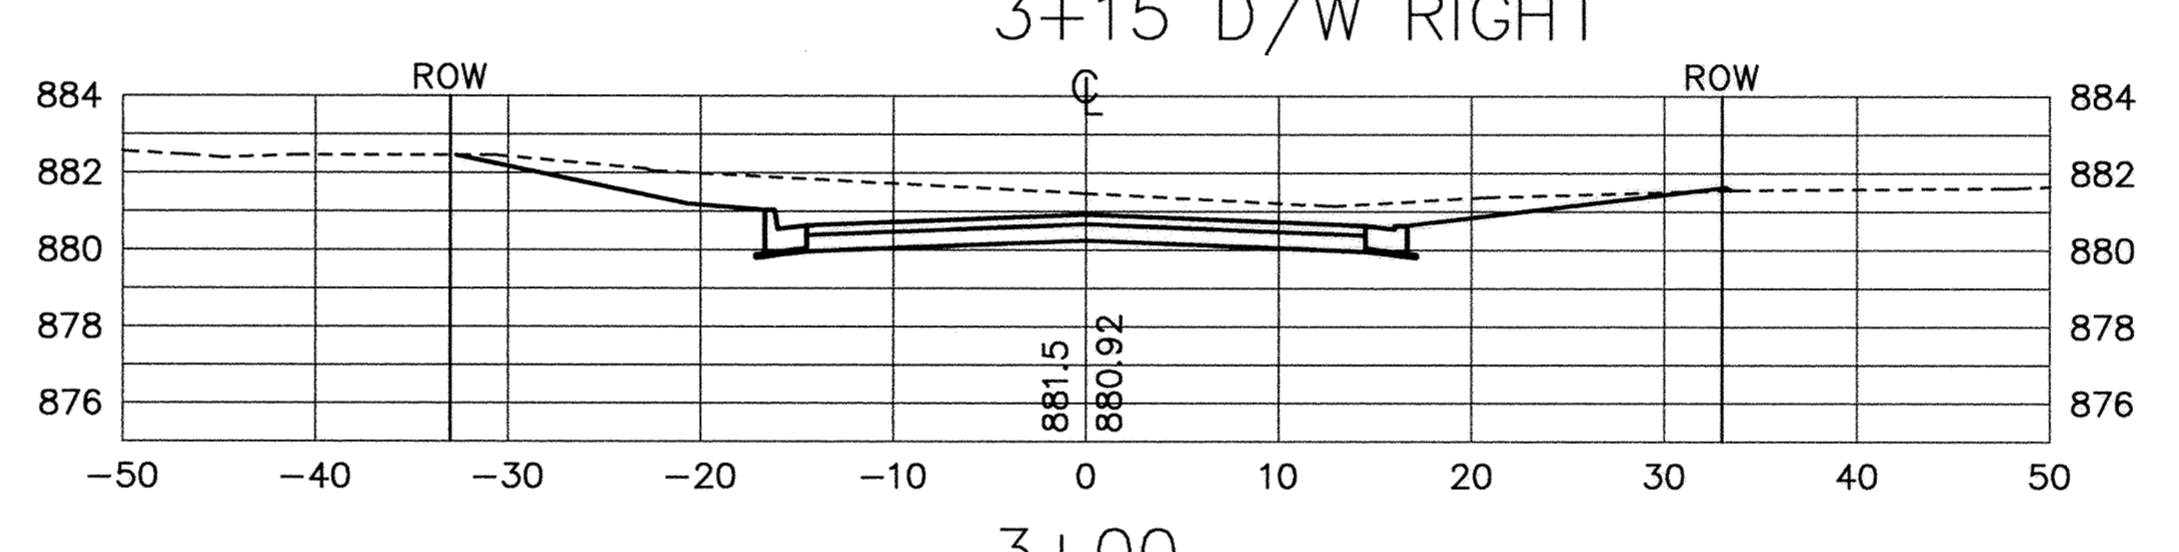
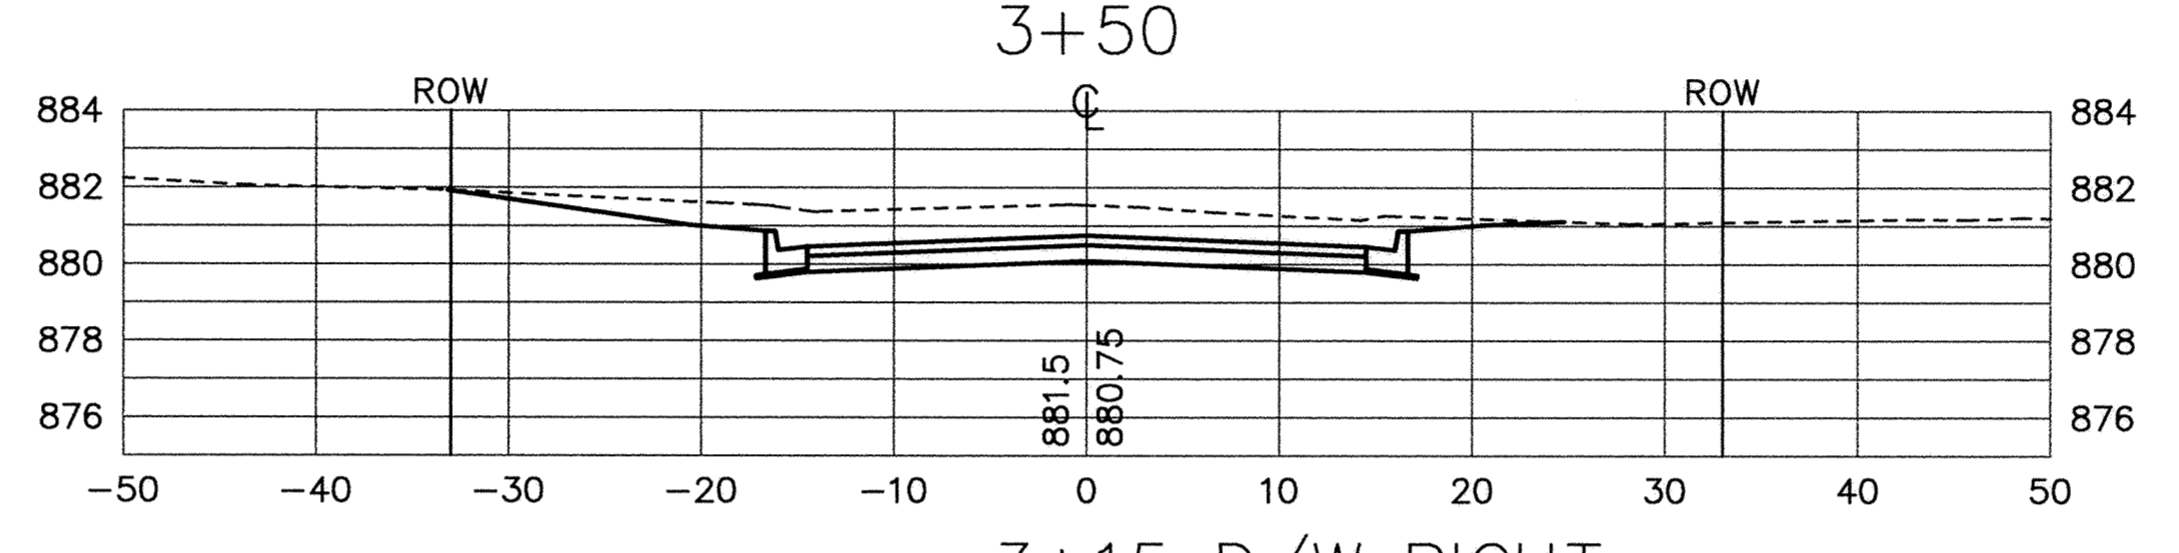
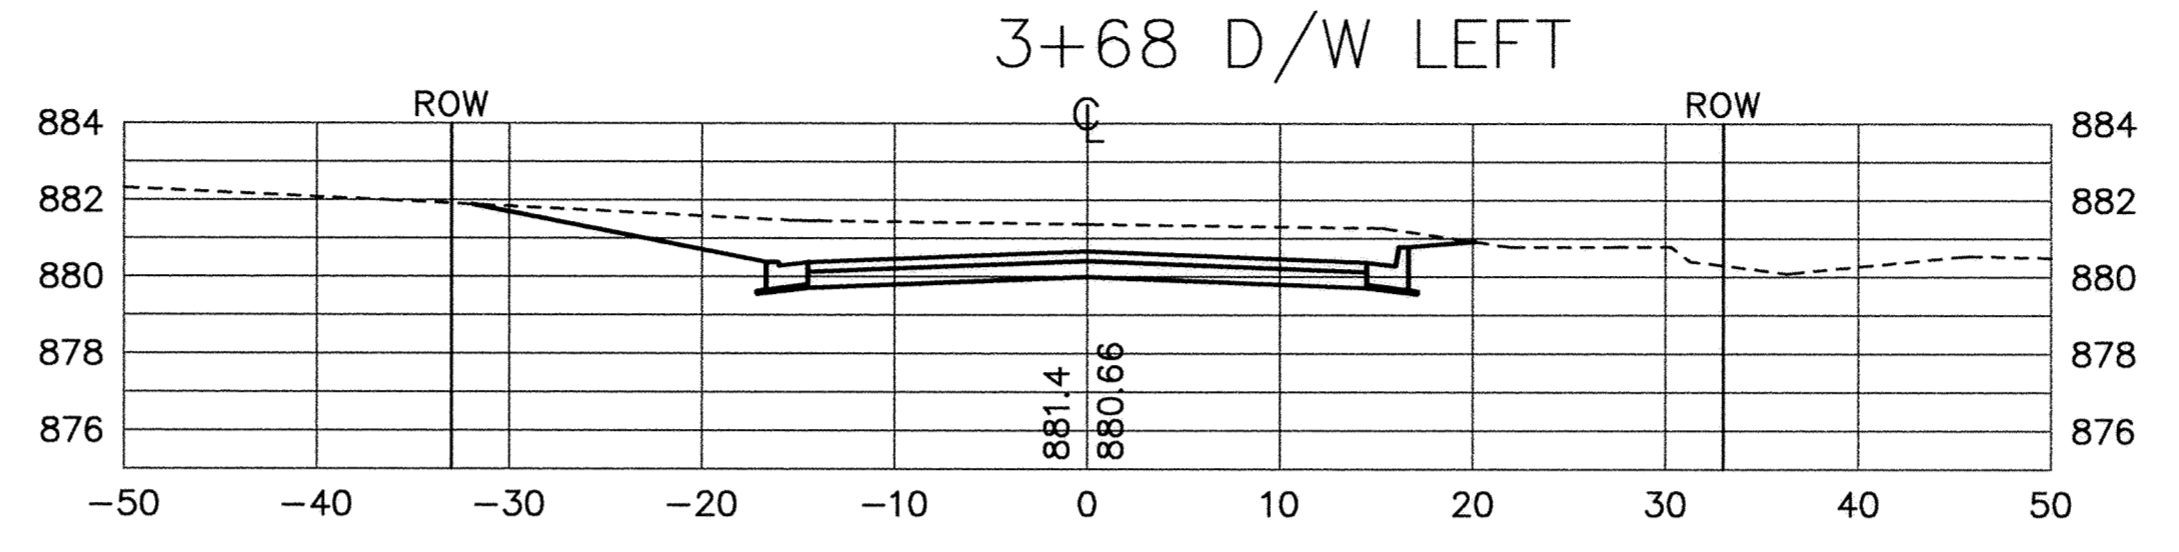
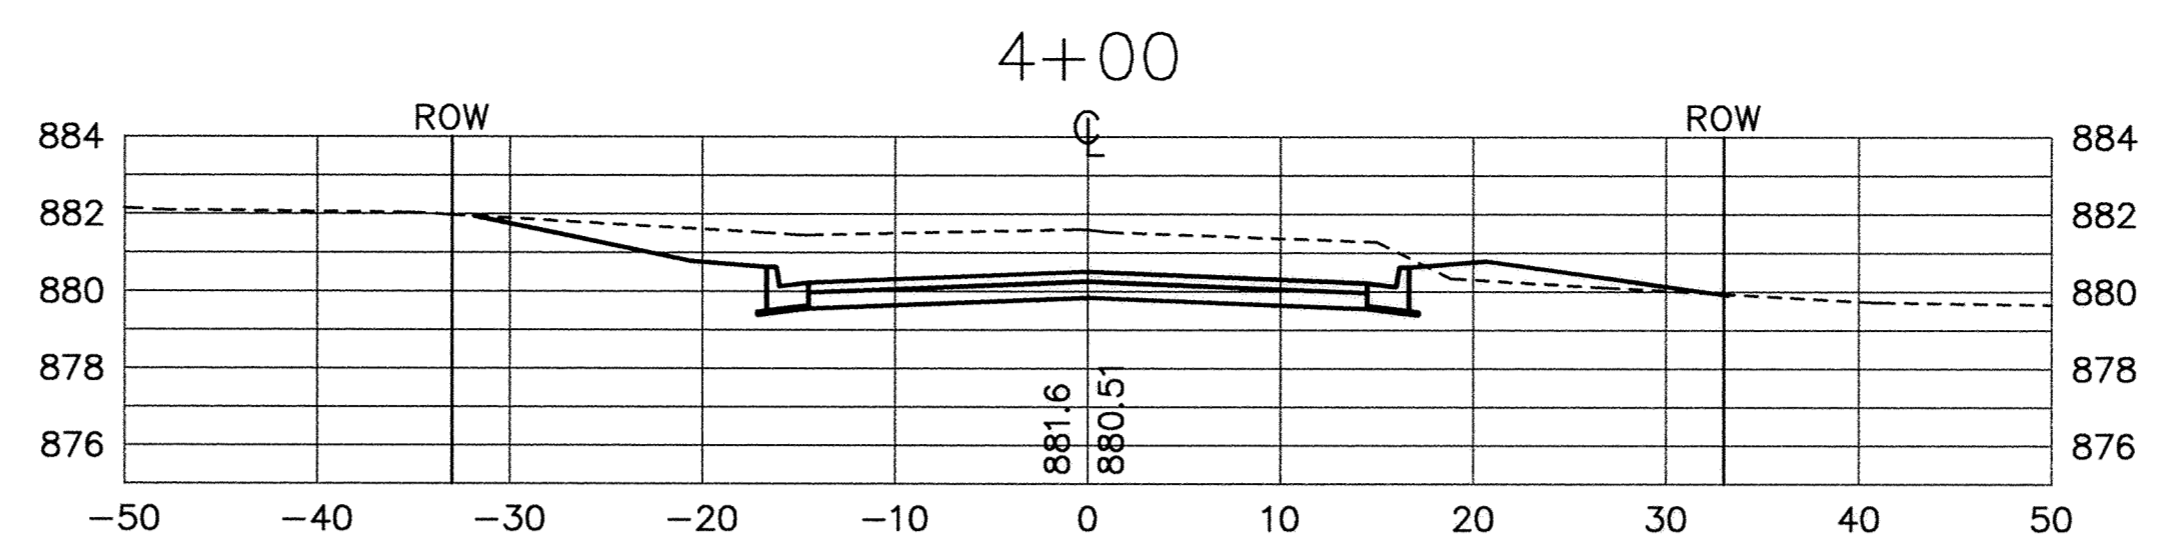
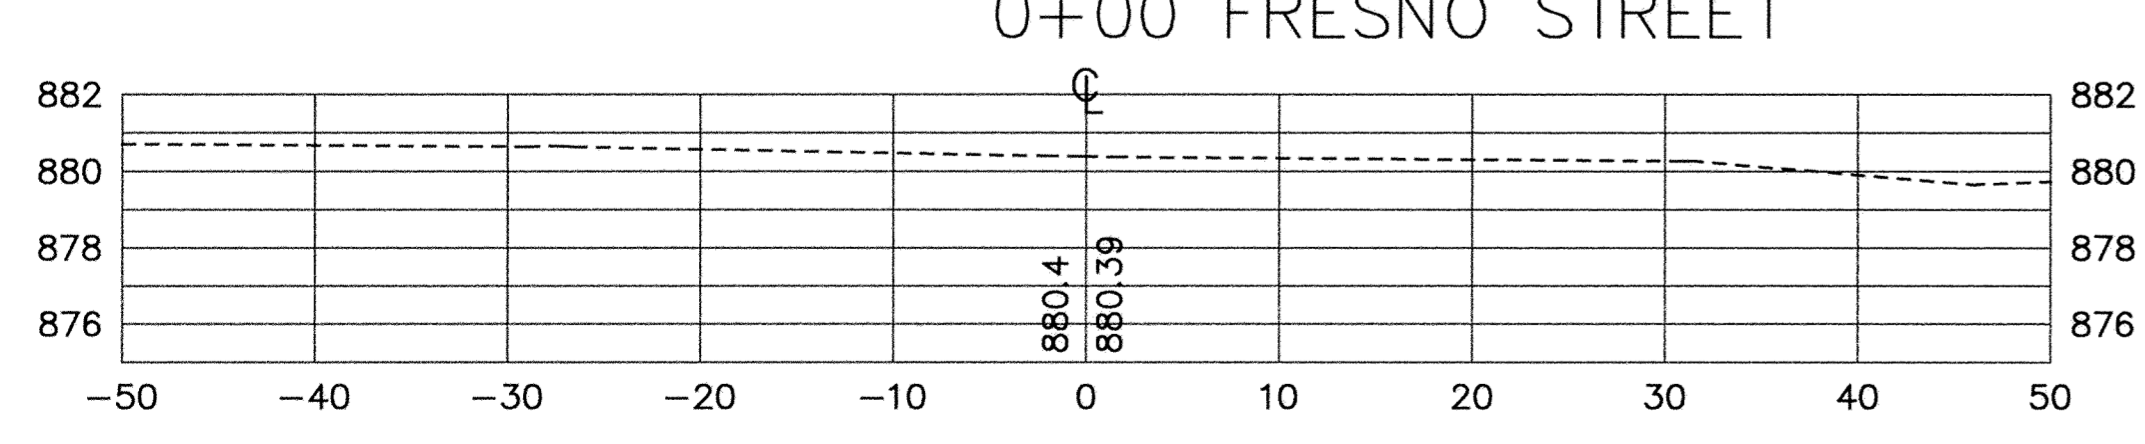
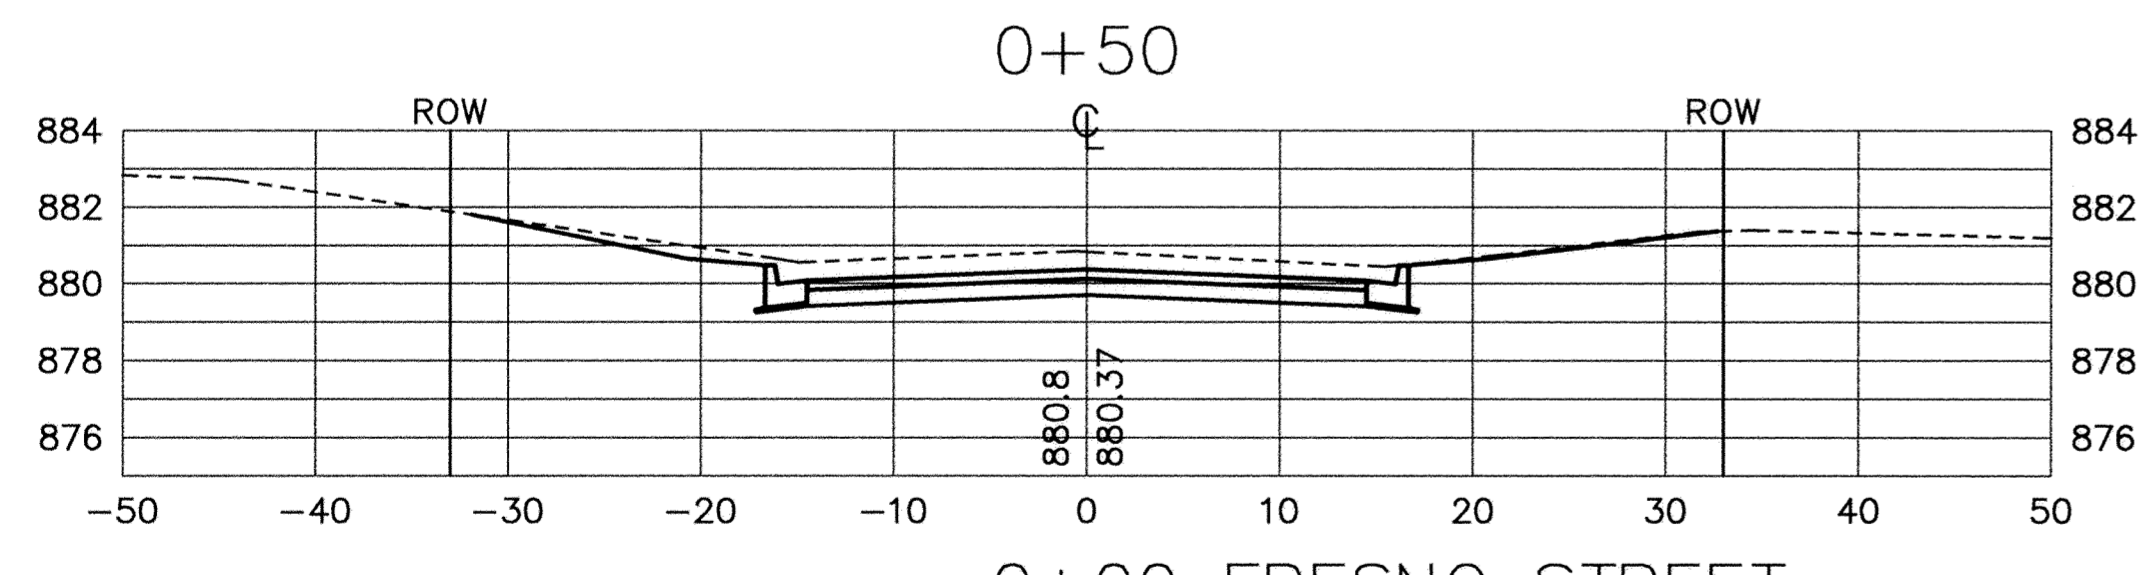
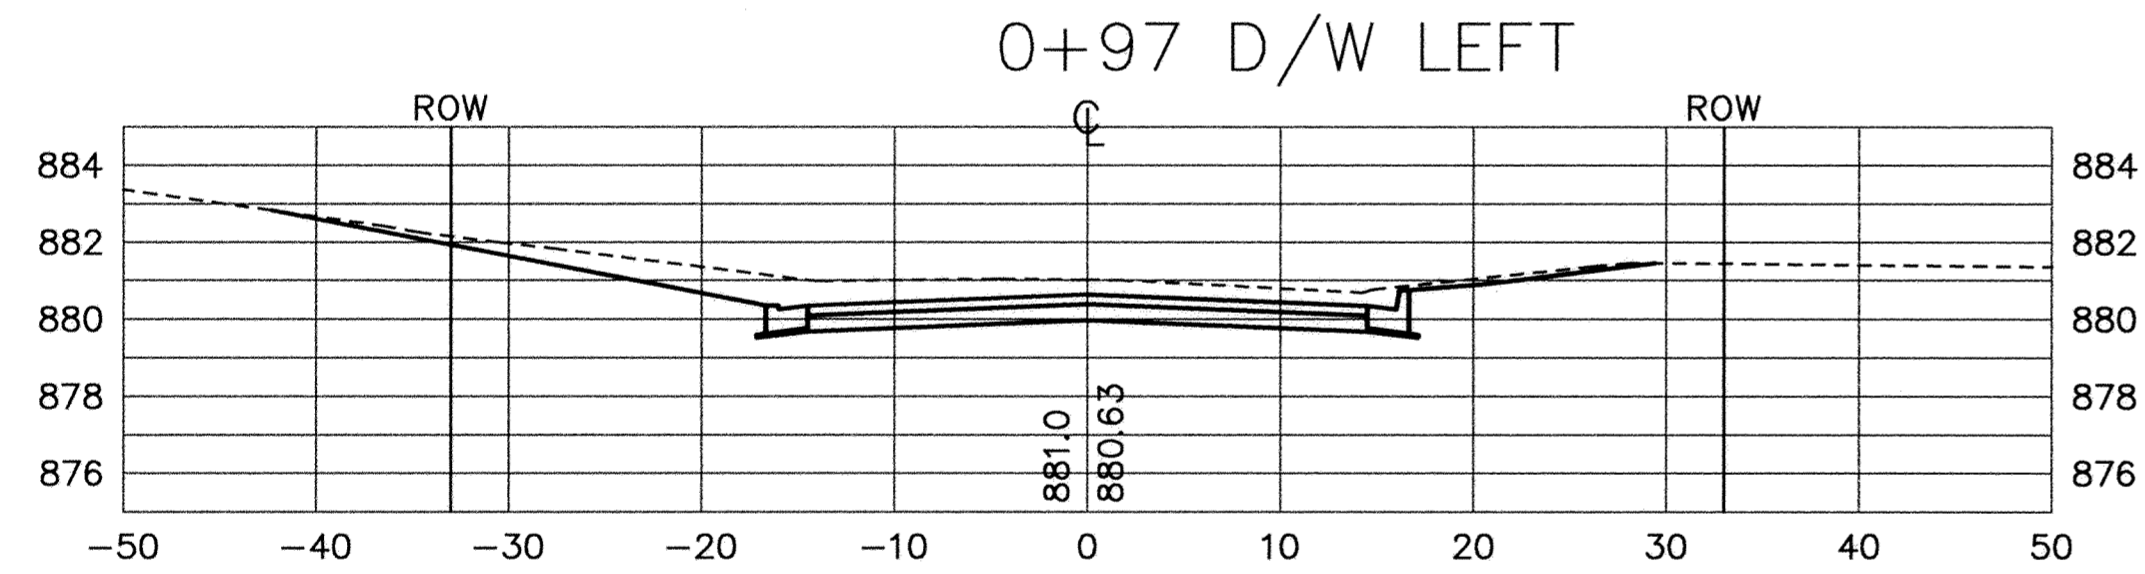
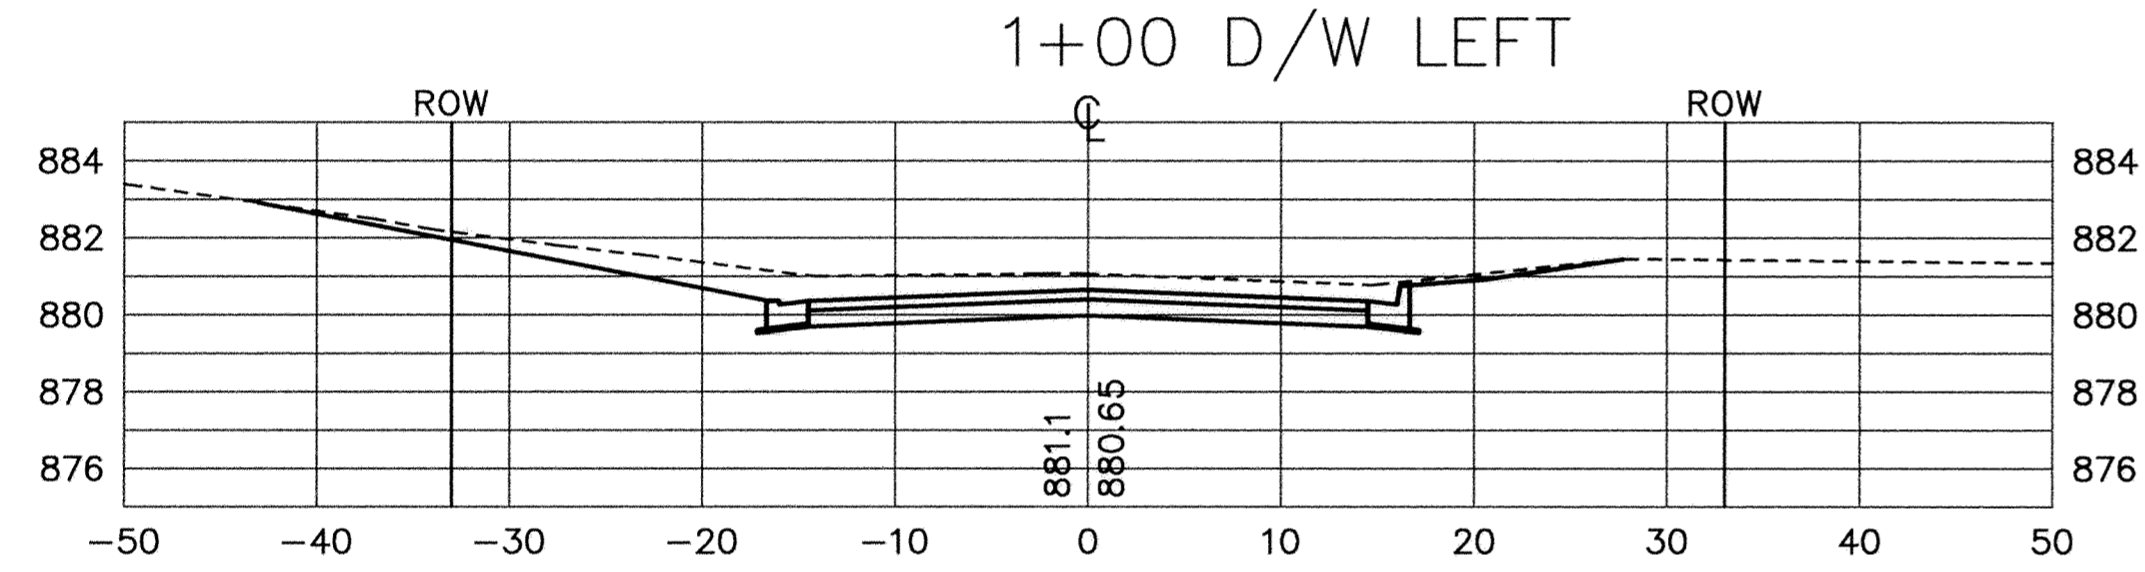
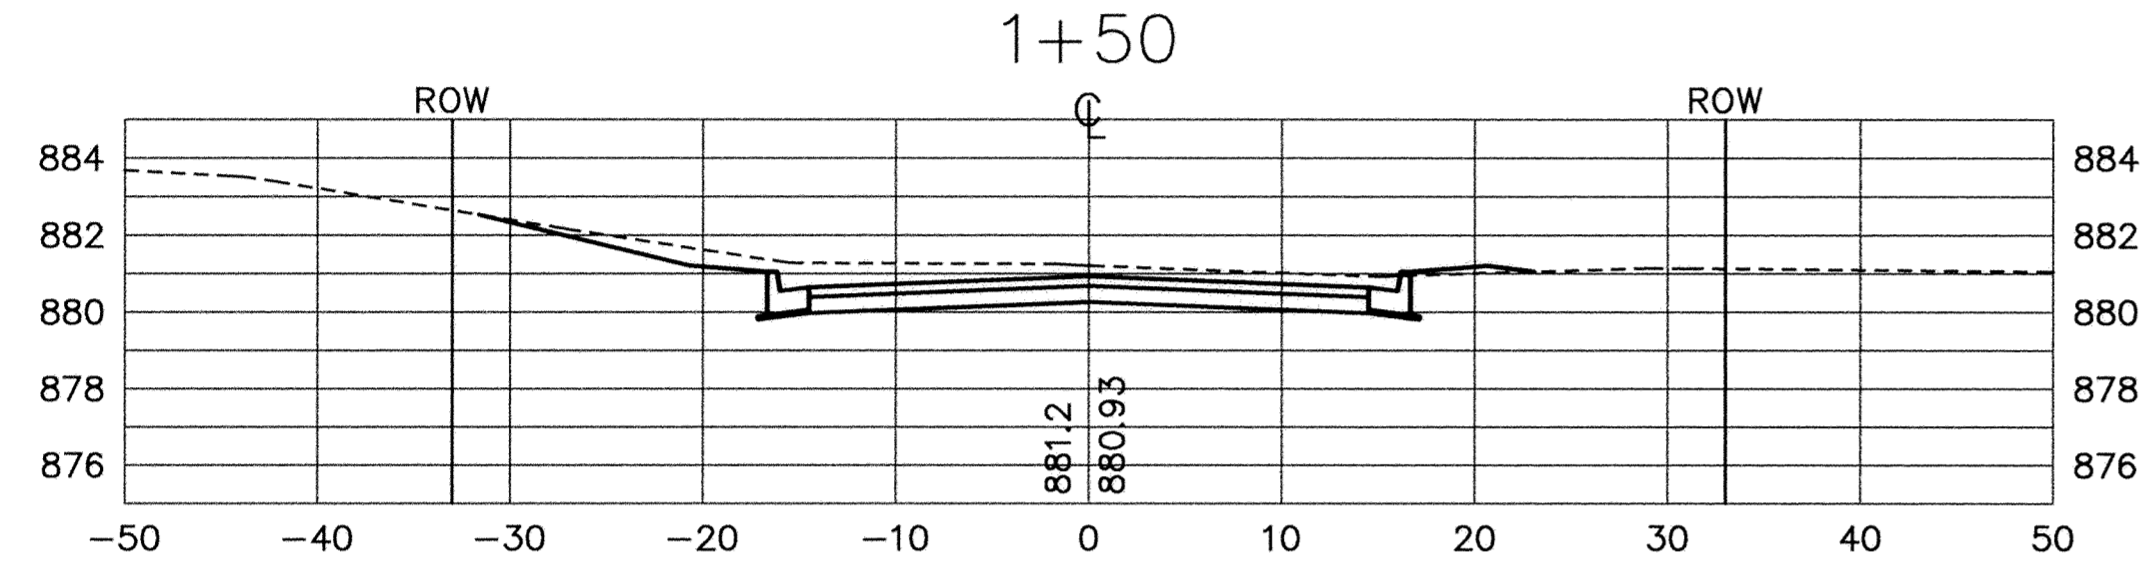


SAICO PRODUCTS - NEW LEBE, MINNESOTA
SAICO PRODUCTS - NEW LEBE, MINNESOTA
SAICO PRODUCTS - NEW LEBE, MINNESOTA
SAICO PRODUCTS - NEW LEBE, MINNESOTA

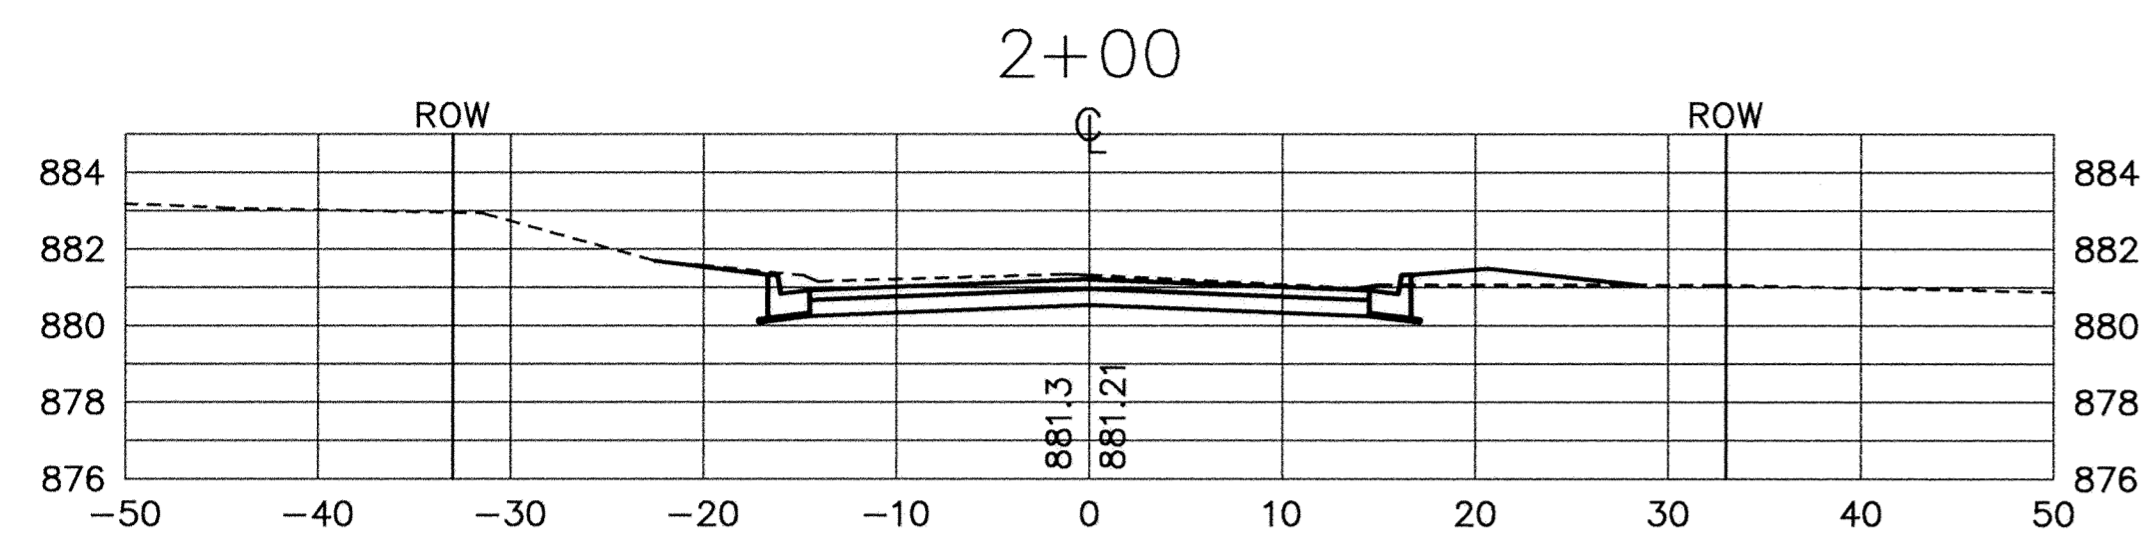

RECORD DRAWING
OCTOBER 1997

I HEREBY CERTIFY THAT THIS PLAN, SPECIFICATION, OR REPORT WAS PREPARED BY ME OR UNDER MY DIRECT SUPERVISION AND THAT I AM A DULY REGISTERED PROFESSIONAL ENGINEER UNDER THE LAWS OF THE STATE OF MINNESOTA.

James J. Mauer

DATE 12/9/96 REG. NO. 15316



1326 ENERGY PARK DRIVE
ST. PAUL, MINNESOTA 55108
(612) 644-4389

DATE	DESCRIPTION

DESIGNED	SEE
CHECKED	7/5
DRAWN	RKM
GRAPHIC SCALE	
0	10
0	5
VERT.	

CITY OF ELK RIVER ORONO LAKE 3RD ADDITION STREET AND UTILITY IMPROVEMENTS 182ND AVENUE CROSS SECTIONS		0+00 TO 4+00
DATE NOV. 1996	SHEET 13 OF 31 SHEETS	PROJECT NO. 230-320